


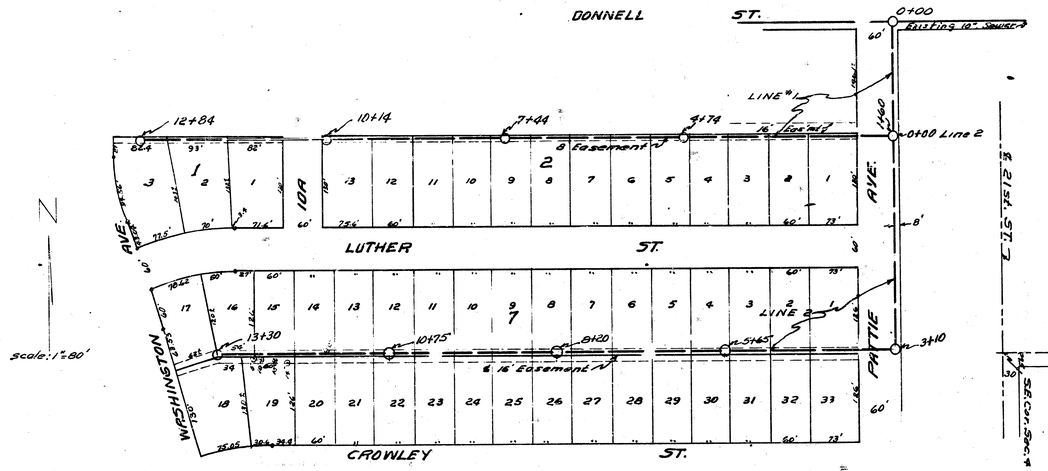


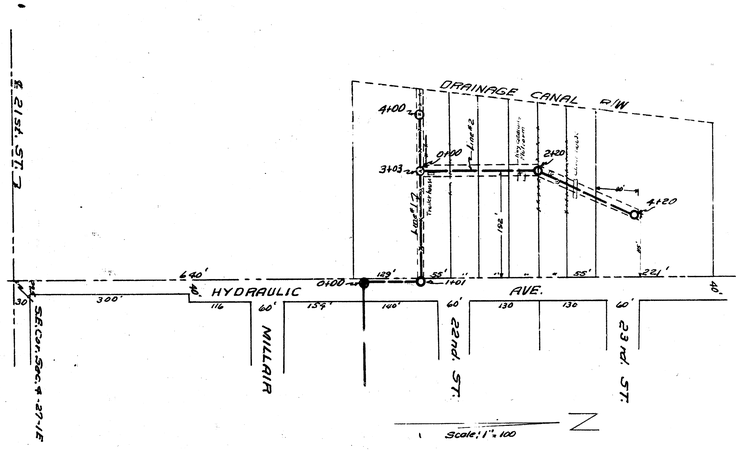

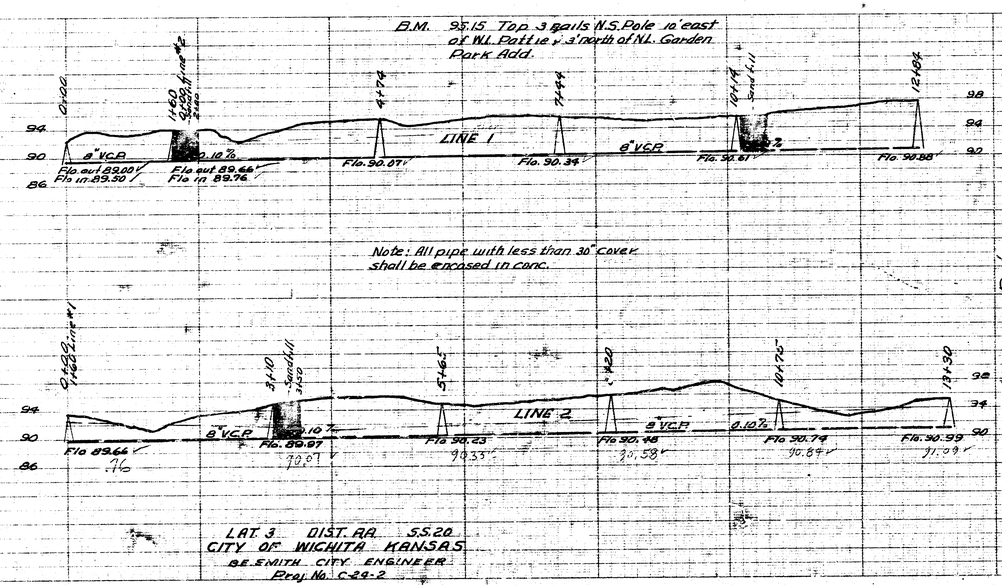

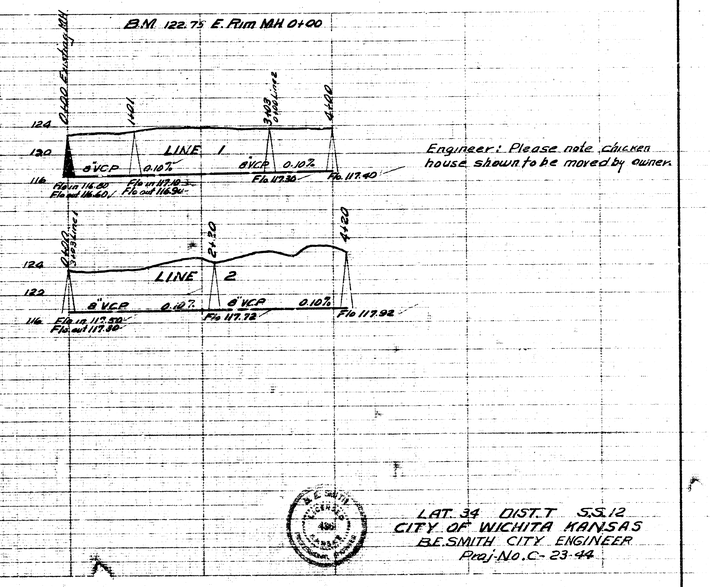

Date 2-9-54
Drawn by McClain
Checked by
Book No. 94

Date
Drawn by McClain
Checked by
Book No.