



Doc 115

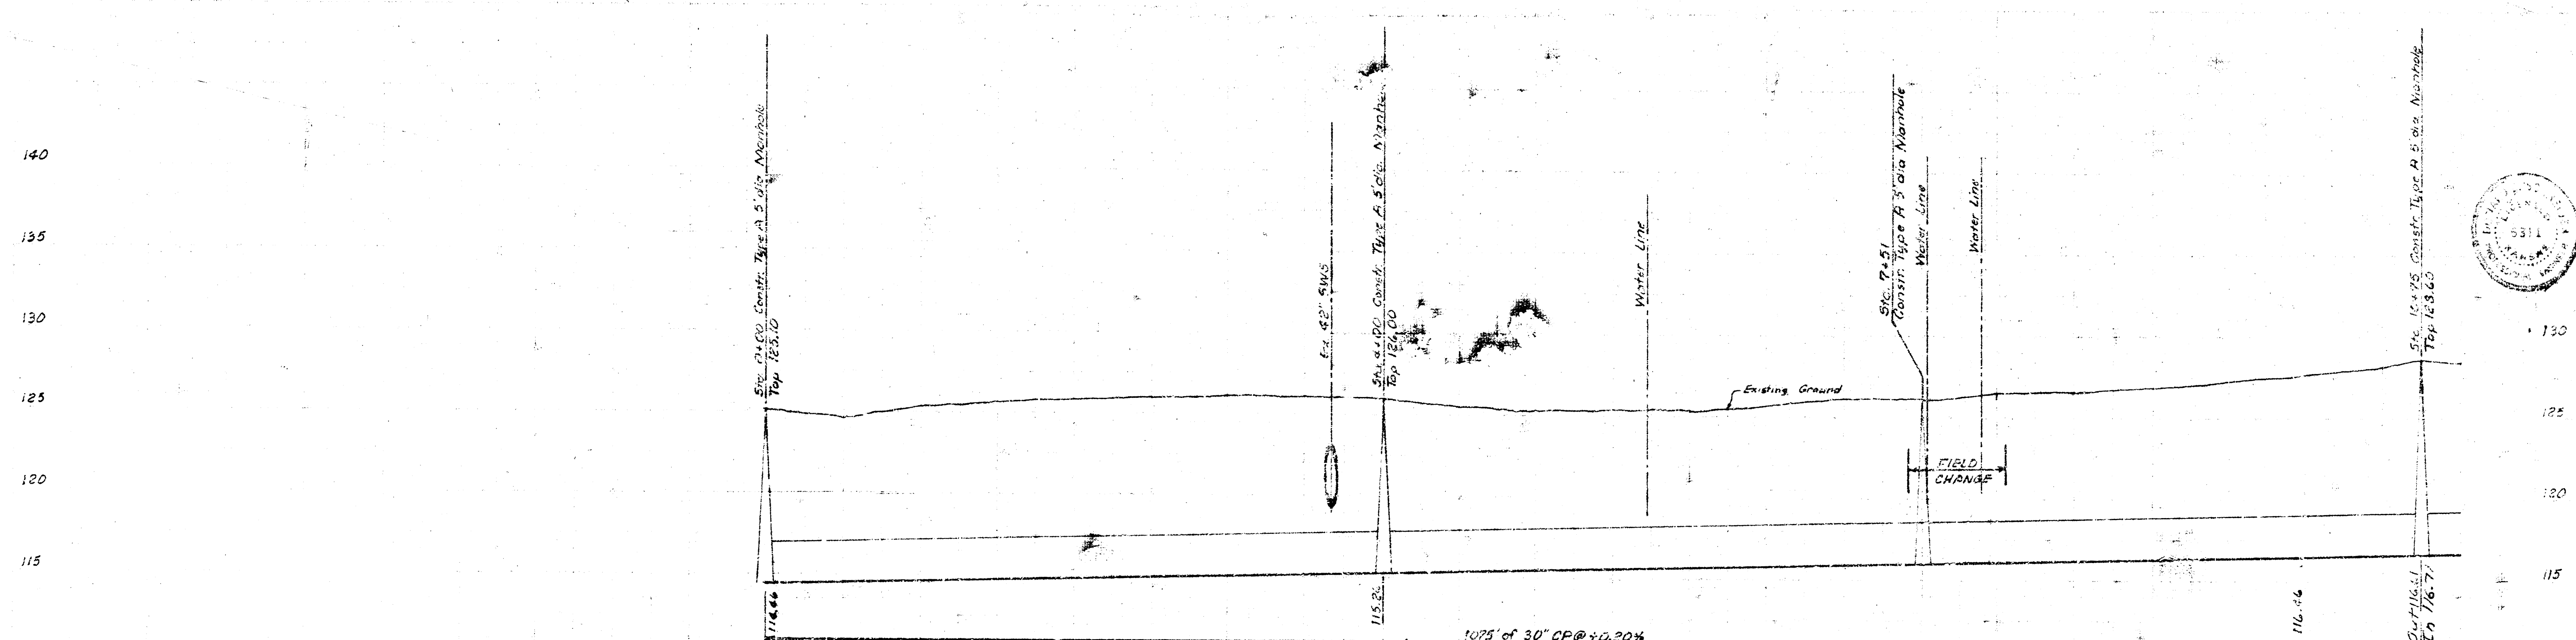

Rev. 1-21-15
SUPPLEMENT DRY CREEK SUBMAIN 1 &
DRY CREEK SUBMAIN 2, SANITARY SEWER
18, ALONG DRY CREEK FROM 230' NORTH
OF N.W. VERNON TO 500' NORTH OF MEADOWLAND
CITY OF WICHITA, KANSAS
R. W. LINN, CITY ENGINEER
DATE: 11/15/14
Project No. DSHM 574084 Sheet 1 of 3

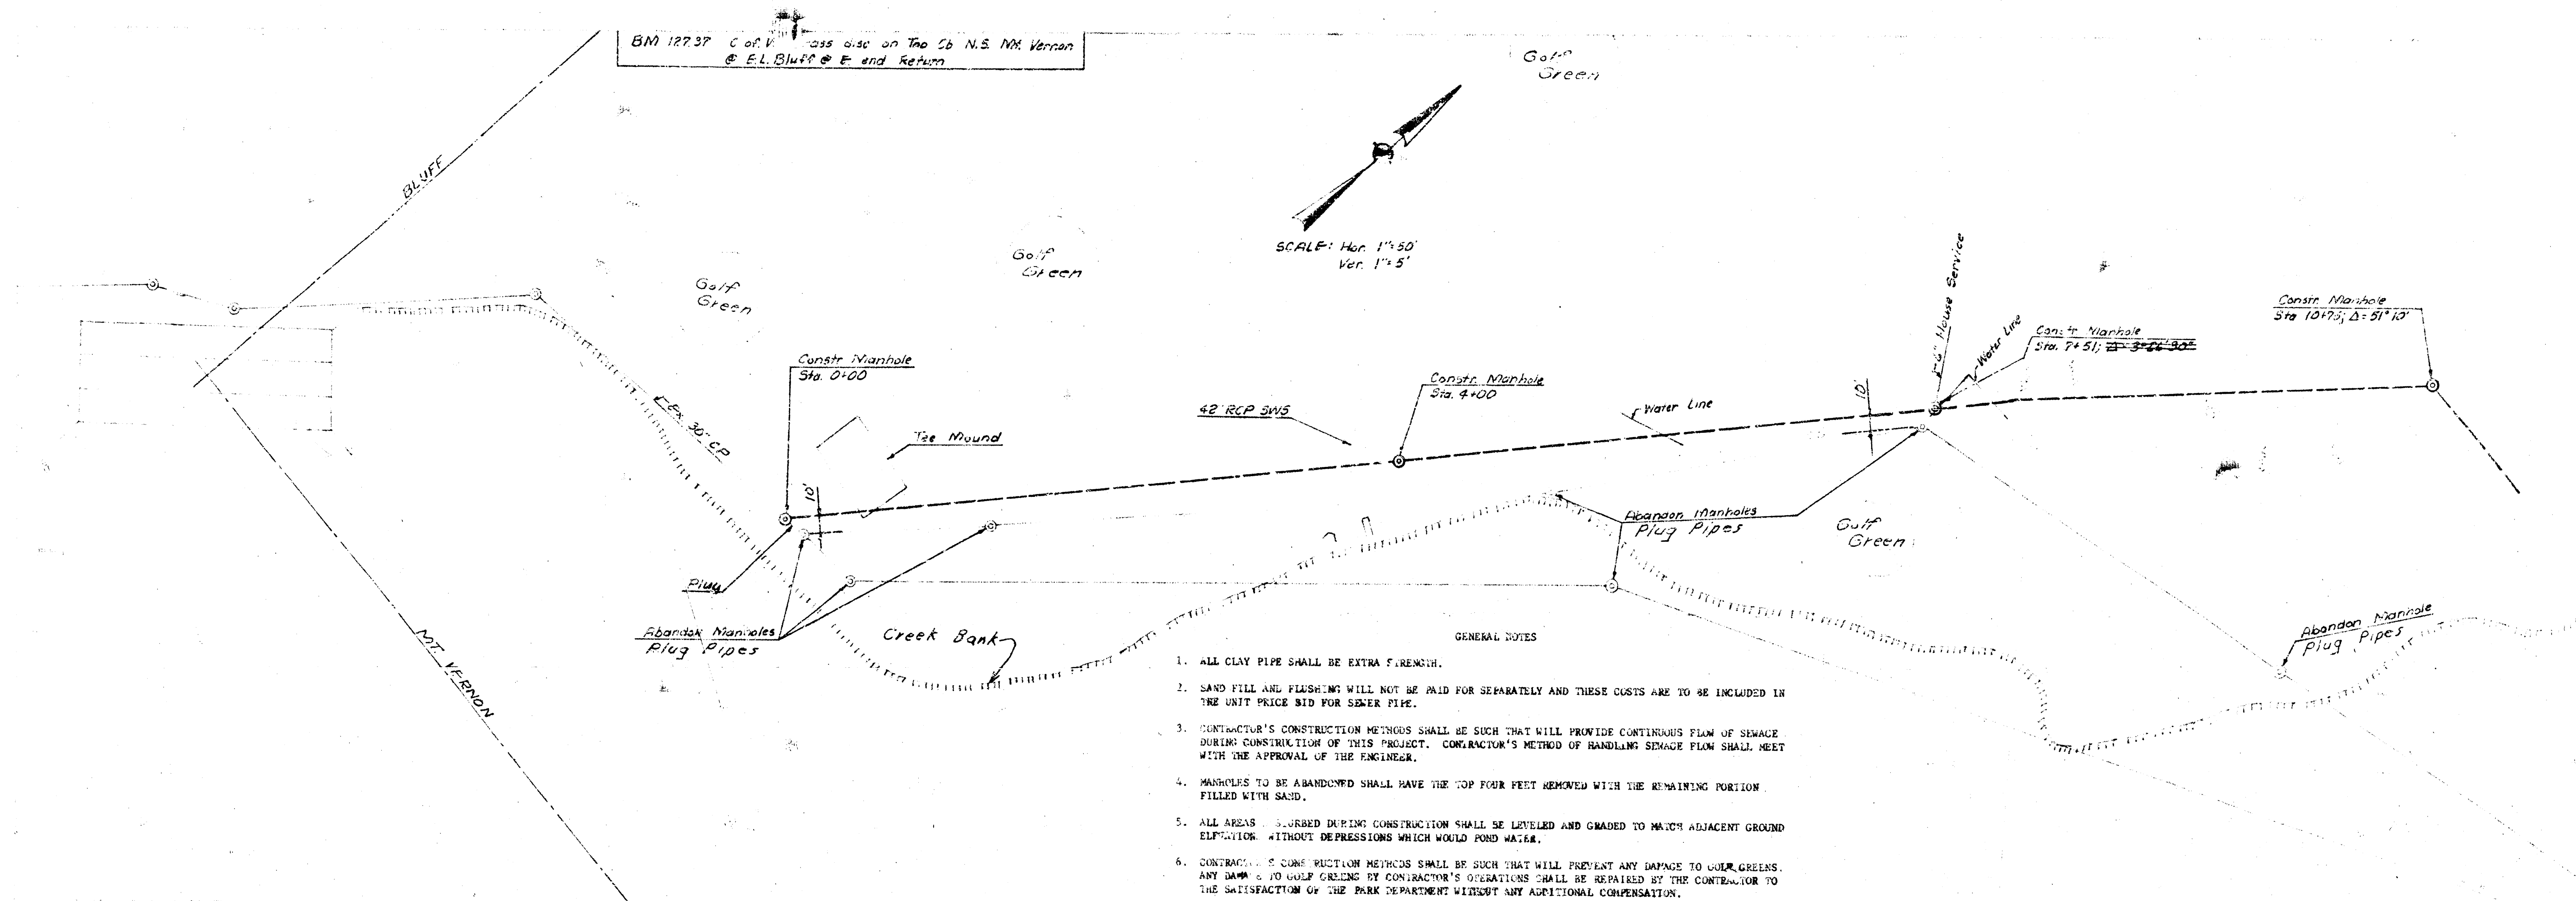