



Doc 115

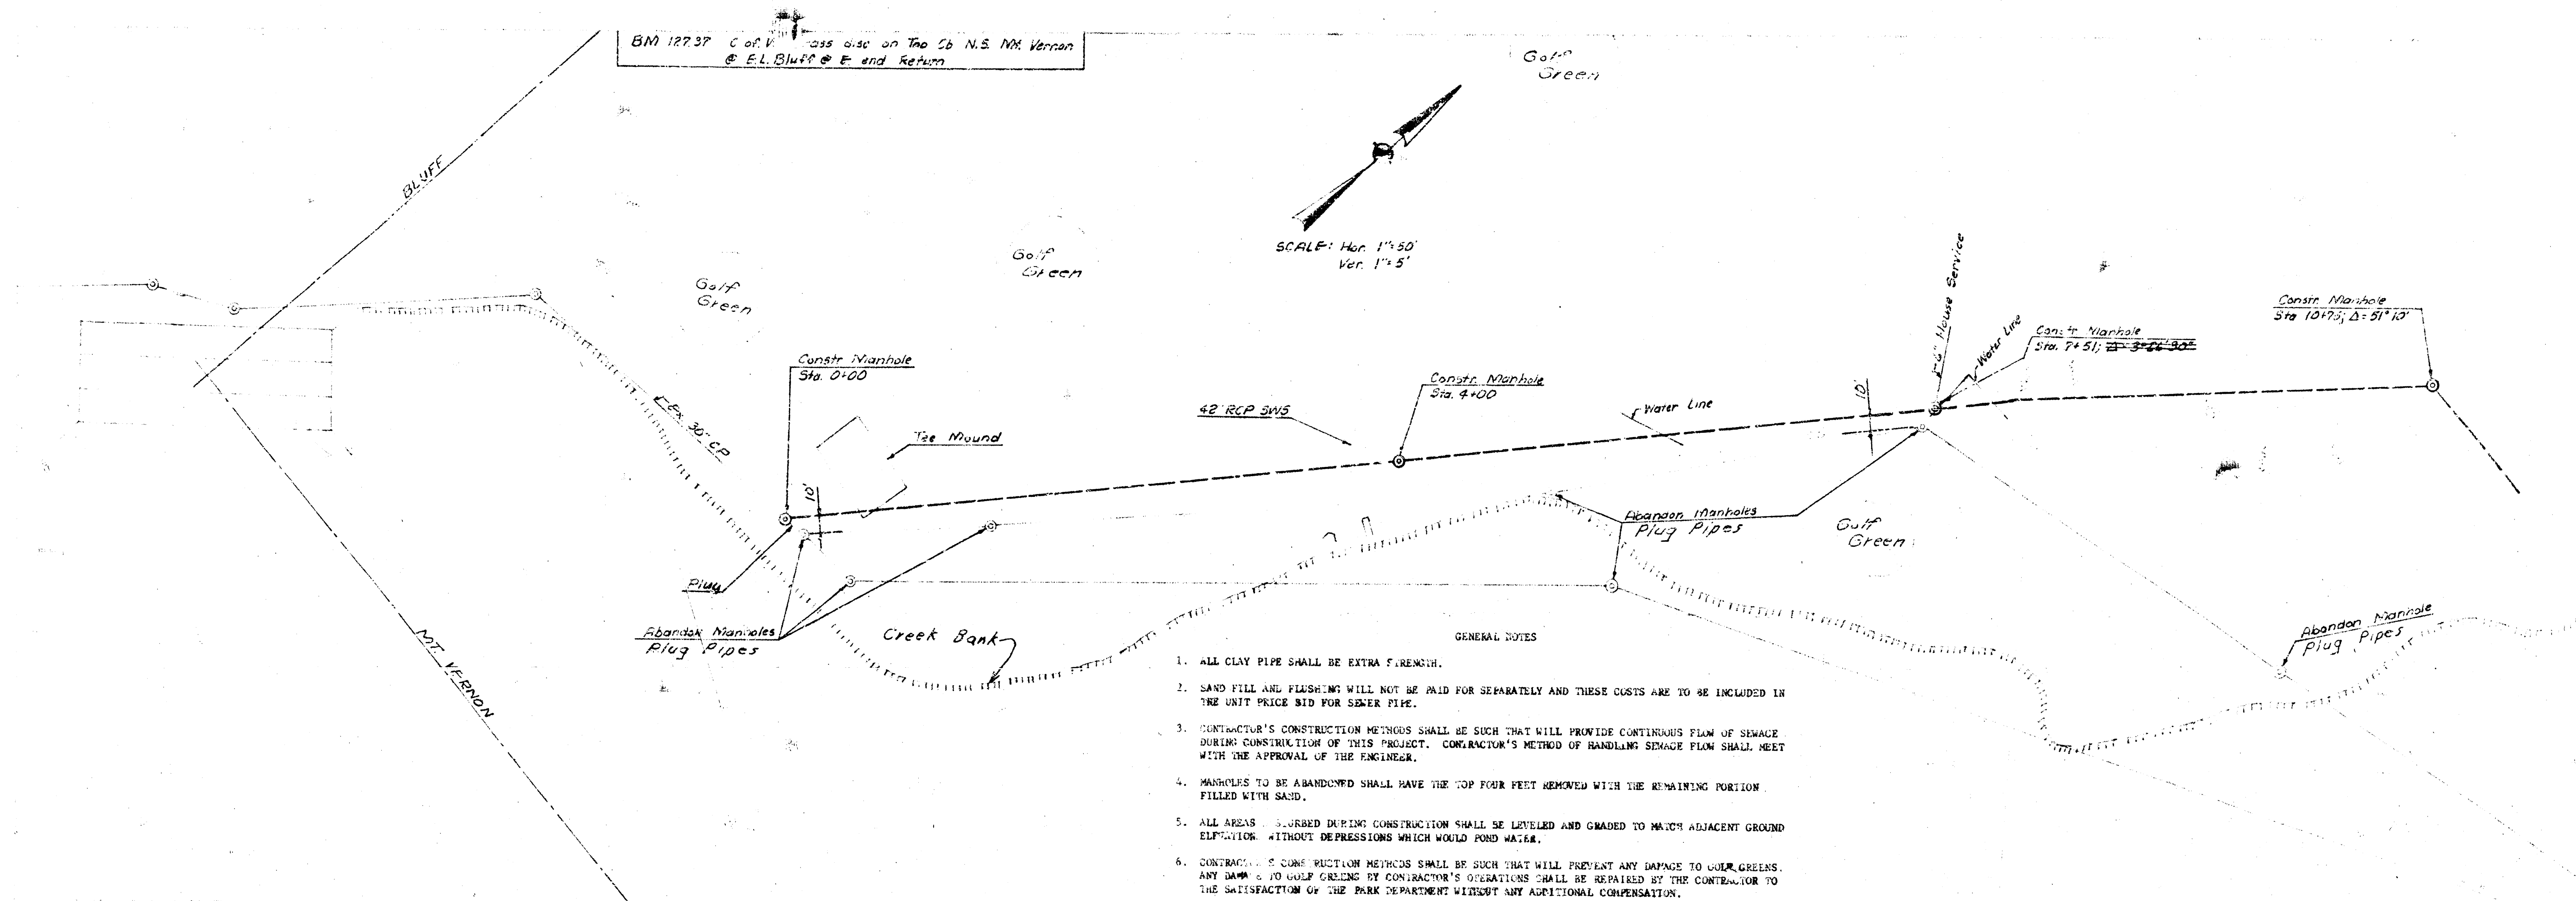

- GENERAL NOTES
1. ALL CLAY PIPE SHALL BE EXTRA STRENGTH.
 2. SAND FILL AND FLASHINGS WILL NOT BE PAID FOR SEPARATELY AND THESE COSTS ARE TO BE INCLUDED IN THE UNIT PRICE BID FOR SEWER PIPE.
 3. CONTRACTOR'S CONSTRUCTION METHODS SHALL BE SUCH THAT WILL PROVIDE CONTINUOUS FLOW OF SEWAGE DURING CONSTRUCTION OF THIS PROJECT. CONTRACTOR'S METHOD OF HANDLING SEWAGE PLAN SHALL MEET WITH THE APPROVAL OF THE ENGINEER.
 4. MANHOLES TO BE ABANDONED SHALL HAVE THE TOP FOUR FEET REMOVED WITH THE REMAINING PORTION FILLED WITH SAND.
 5. ALL AREAS EXPOSED DURING CONSTRUCTION SHALL BE LEVELLED AND GRADED TO MATCH ADJACENT GROUND ELEVATION. WITHOUT DEPRESSIONS WHICH WOULD FORD WATER.

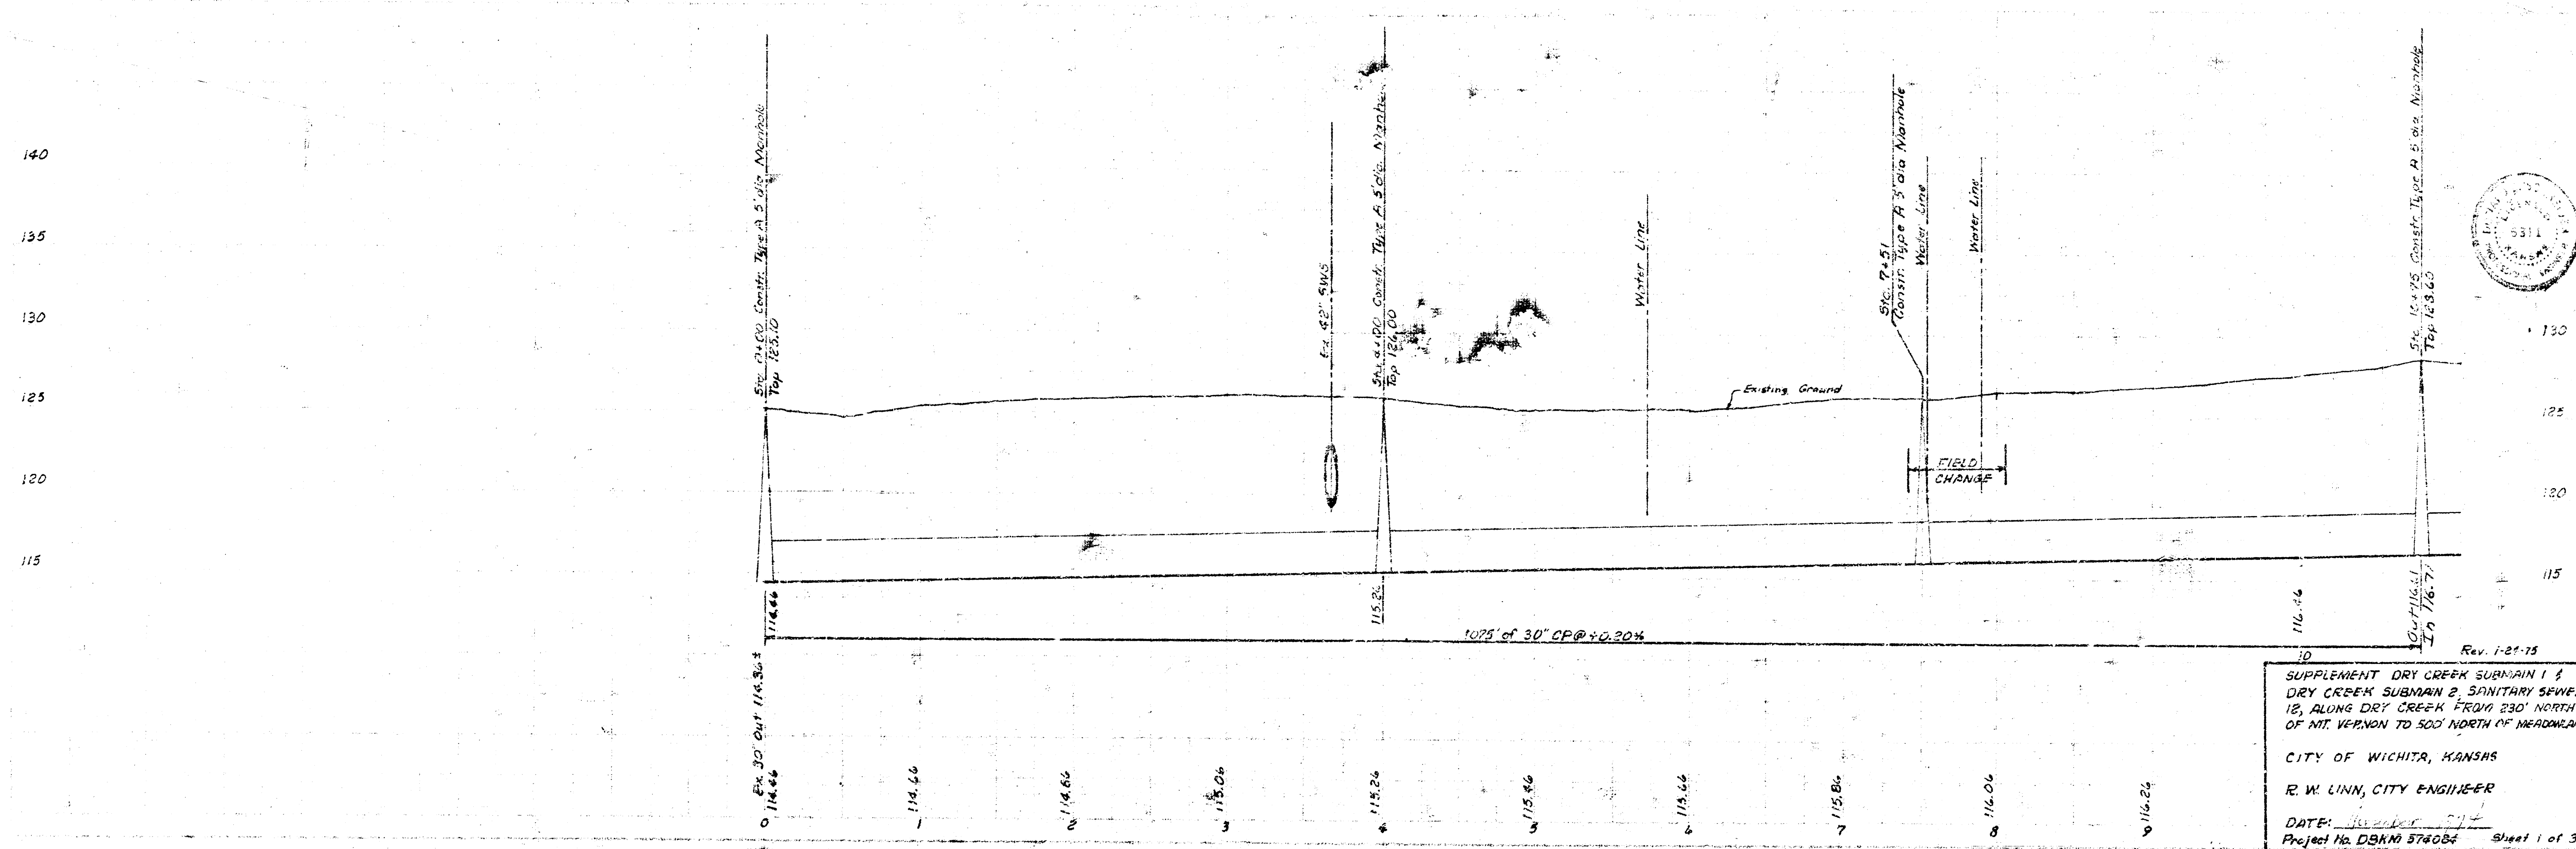

Rev. 1-21-15

SUPPLEMENT DRY CREEK SUBMAIN 1 & DRY CREEK SUBMAIN 2, SANITARY SEWER 18" ALONG DRY CREEK FROM 230' NORTH OF N. VERNON TO 500' NORTH OF MEADOWLAND

CITY OF WICHITA, KANSAS

R. W. LINN, CITY ENGINEER


Project No. DSHM 574084 Sheet 1 of 3

