








PLAT SHOWING LOCATION OF DRY CREEK SUB-MAIN TO S.S.NO.12. AND THE INTERCEPTING LINES.







SHEET #1 4 SHEETS


N


Scale 1"=50'

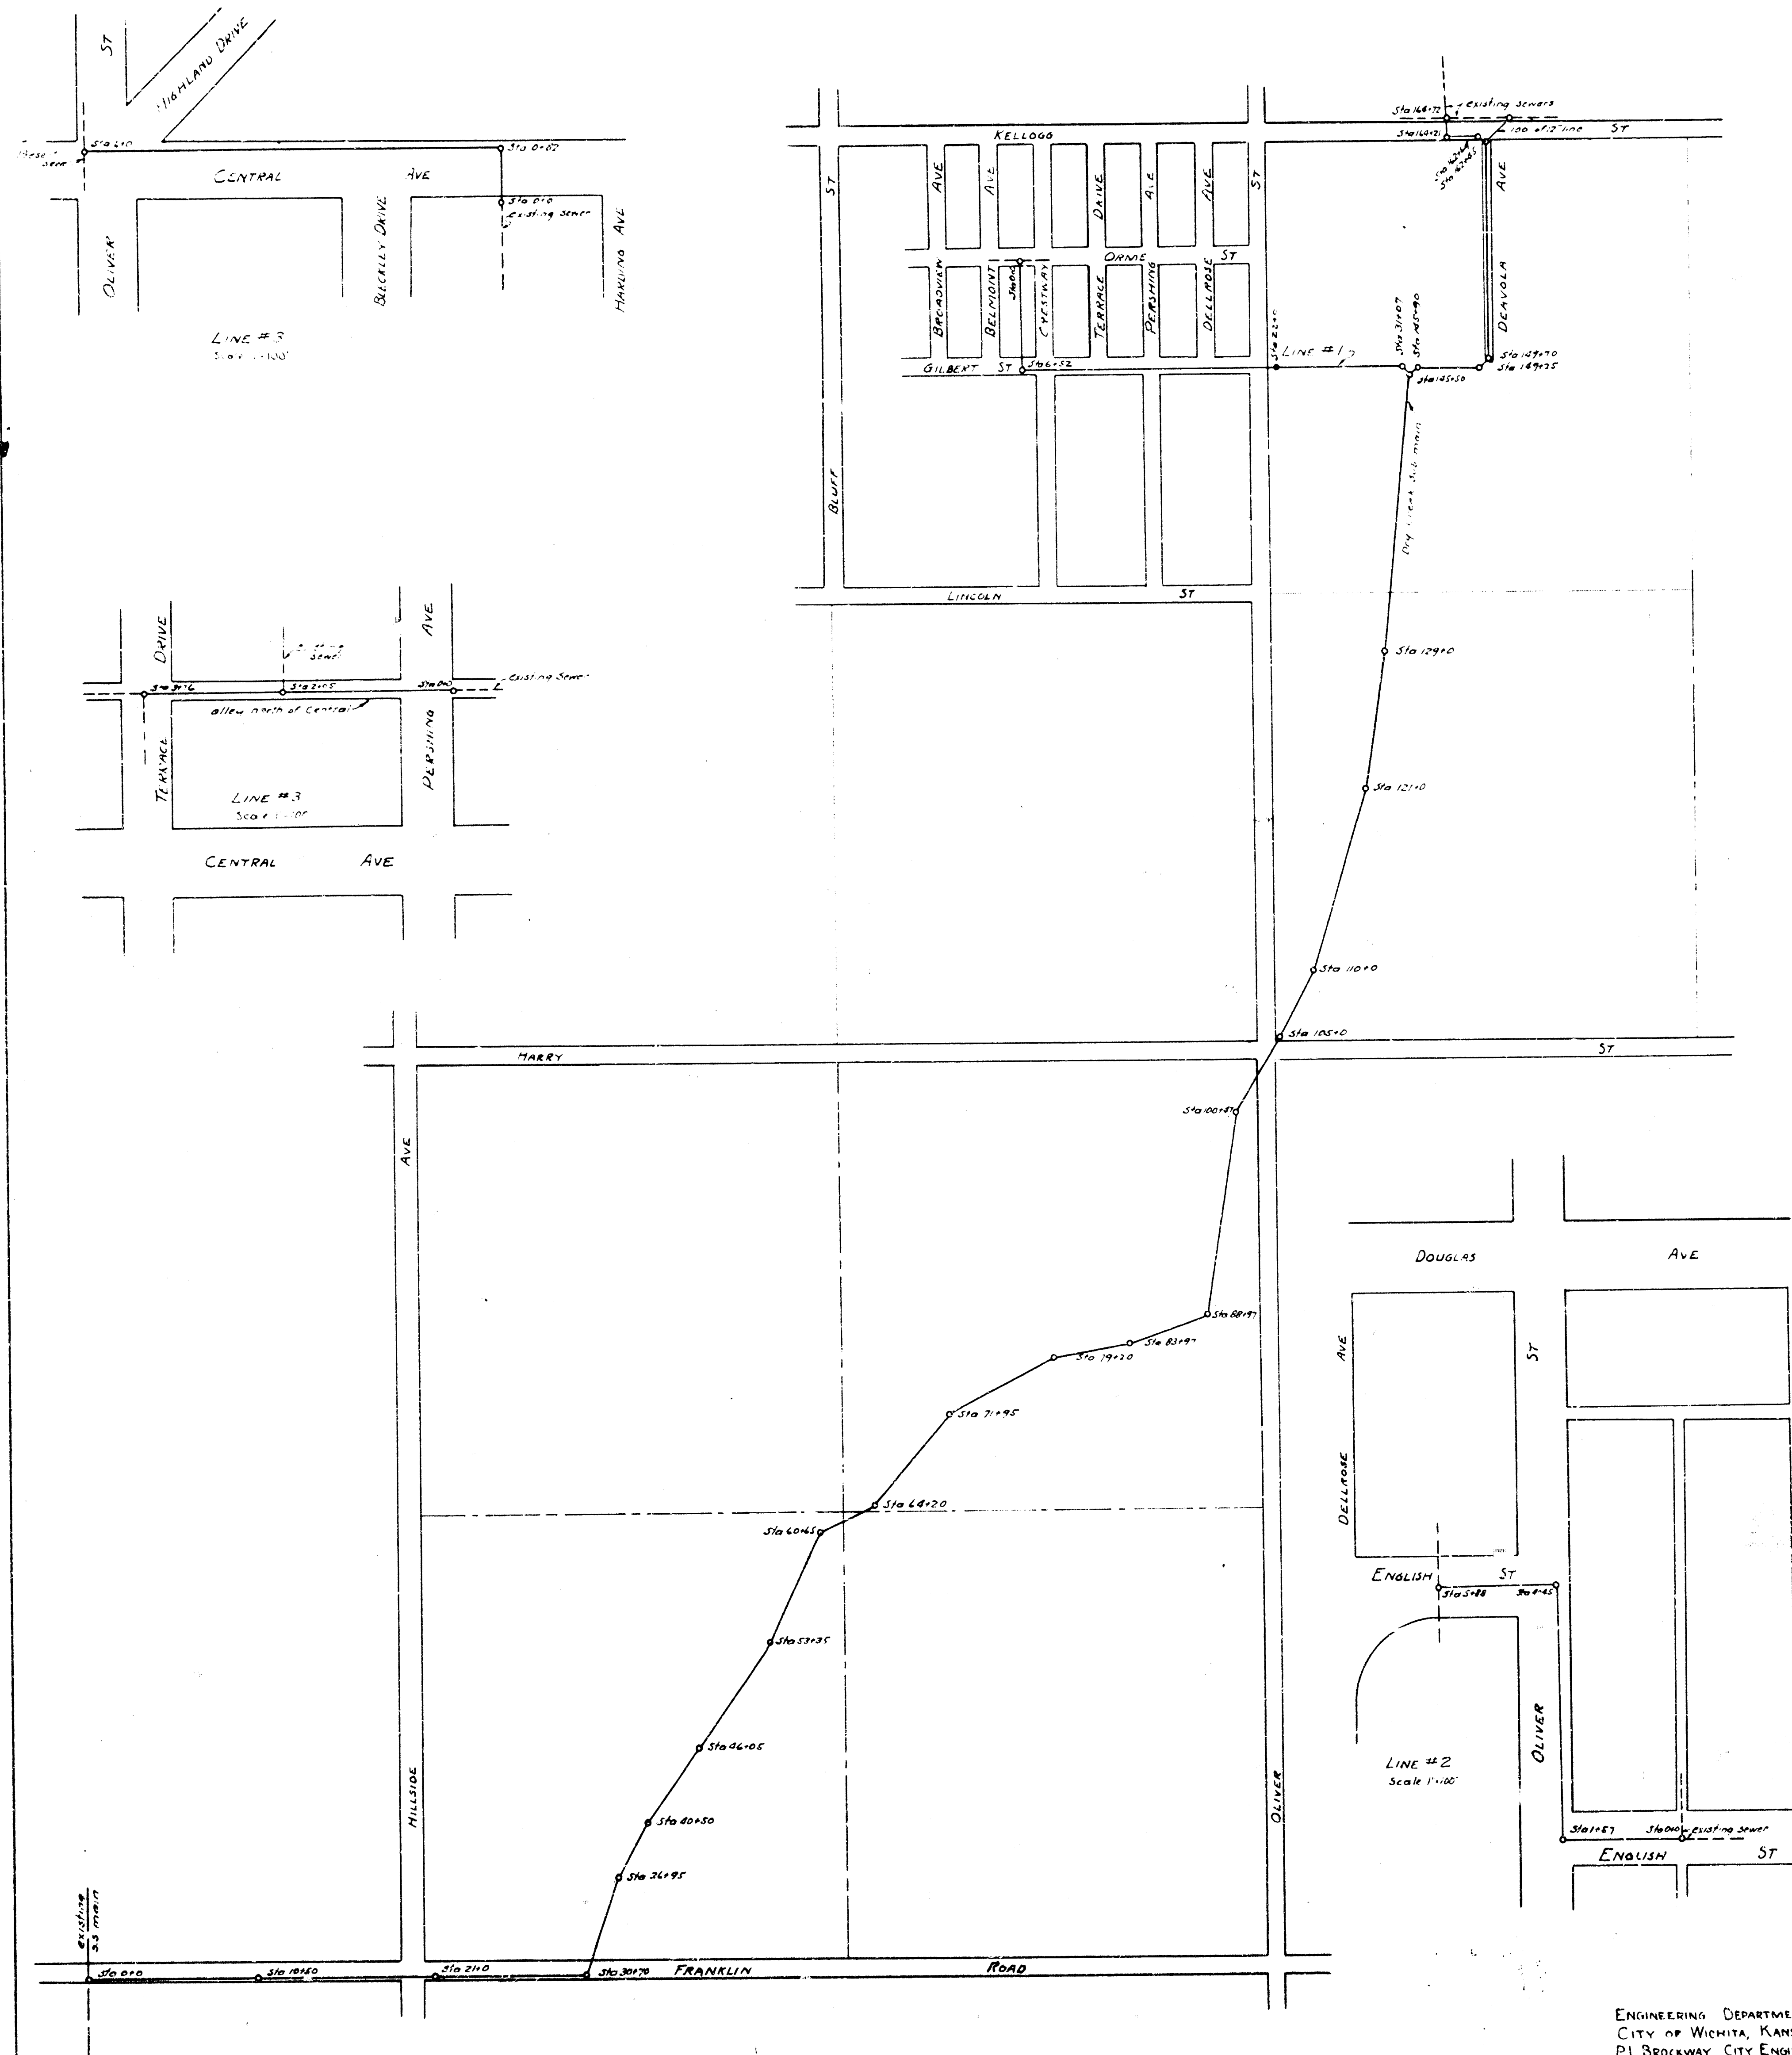

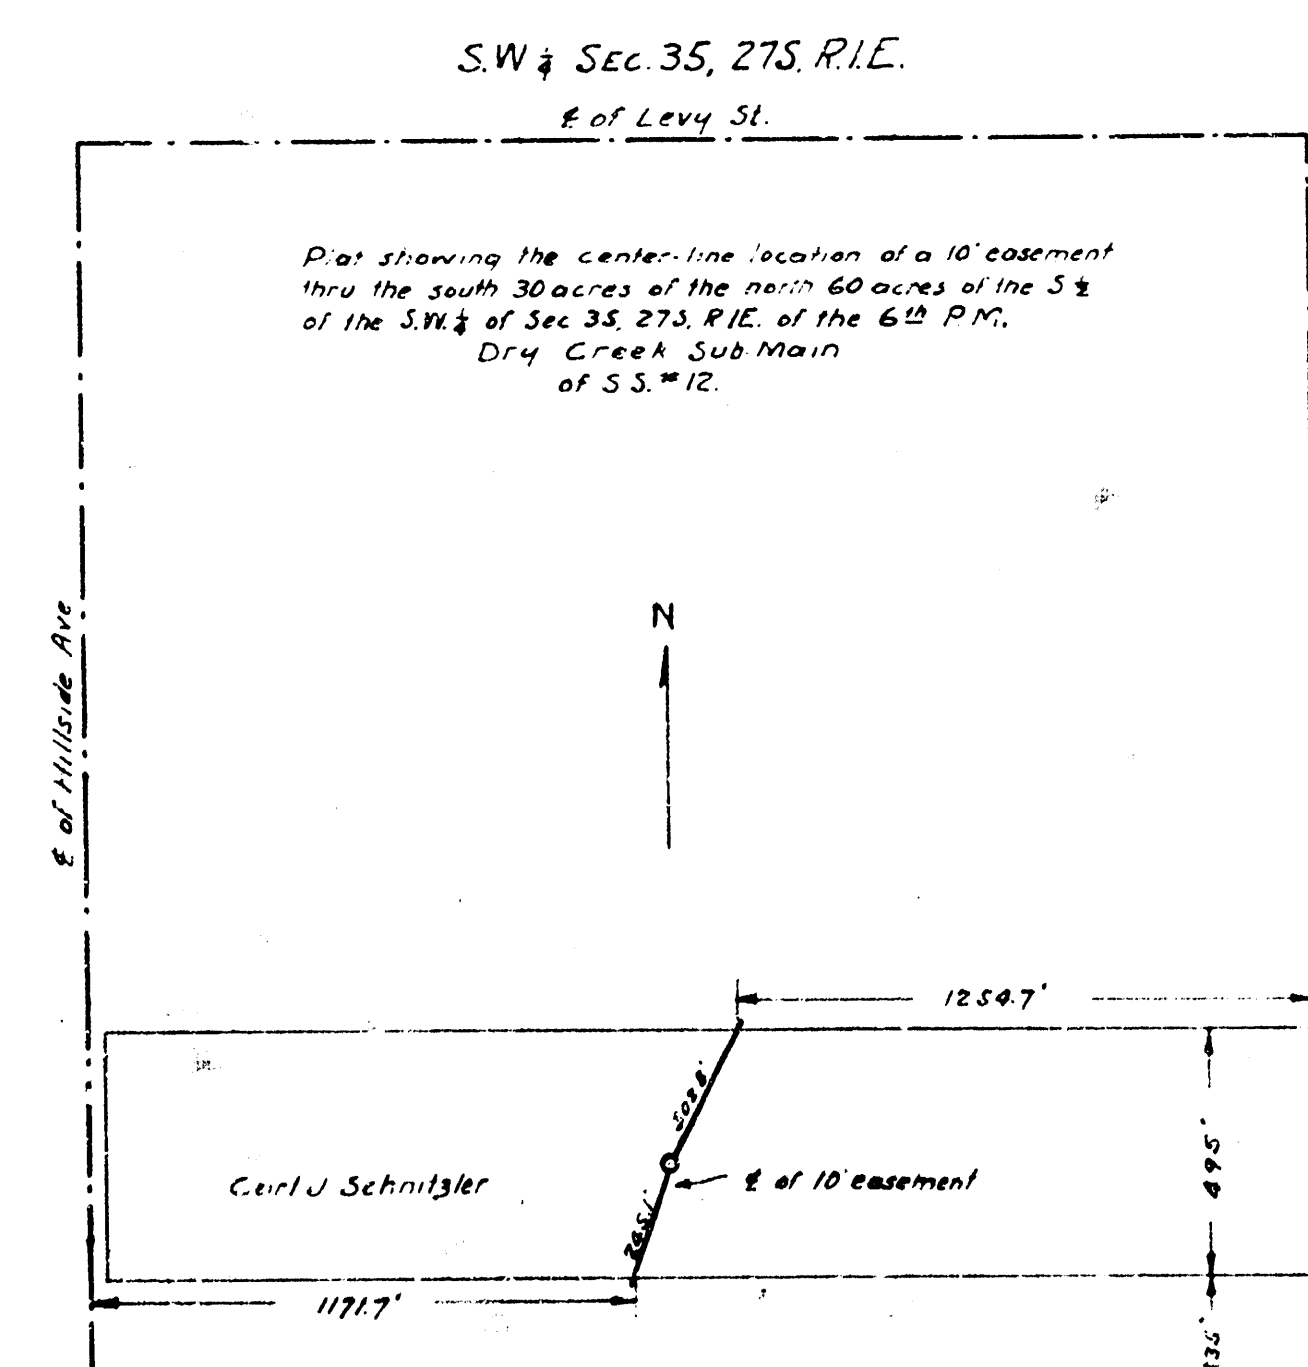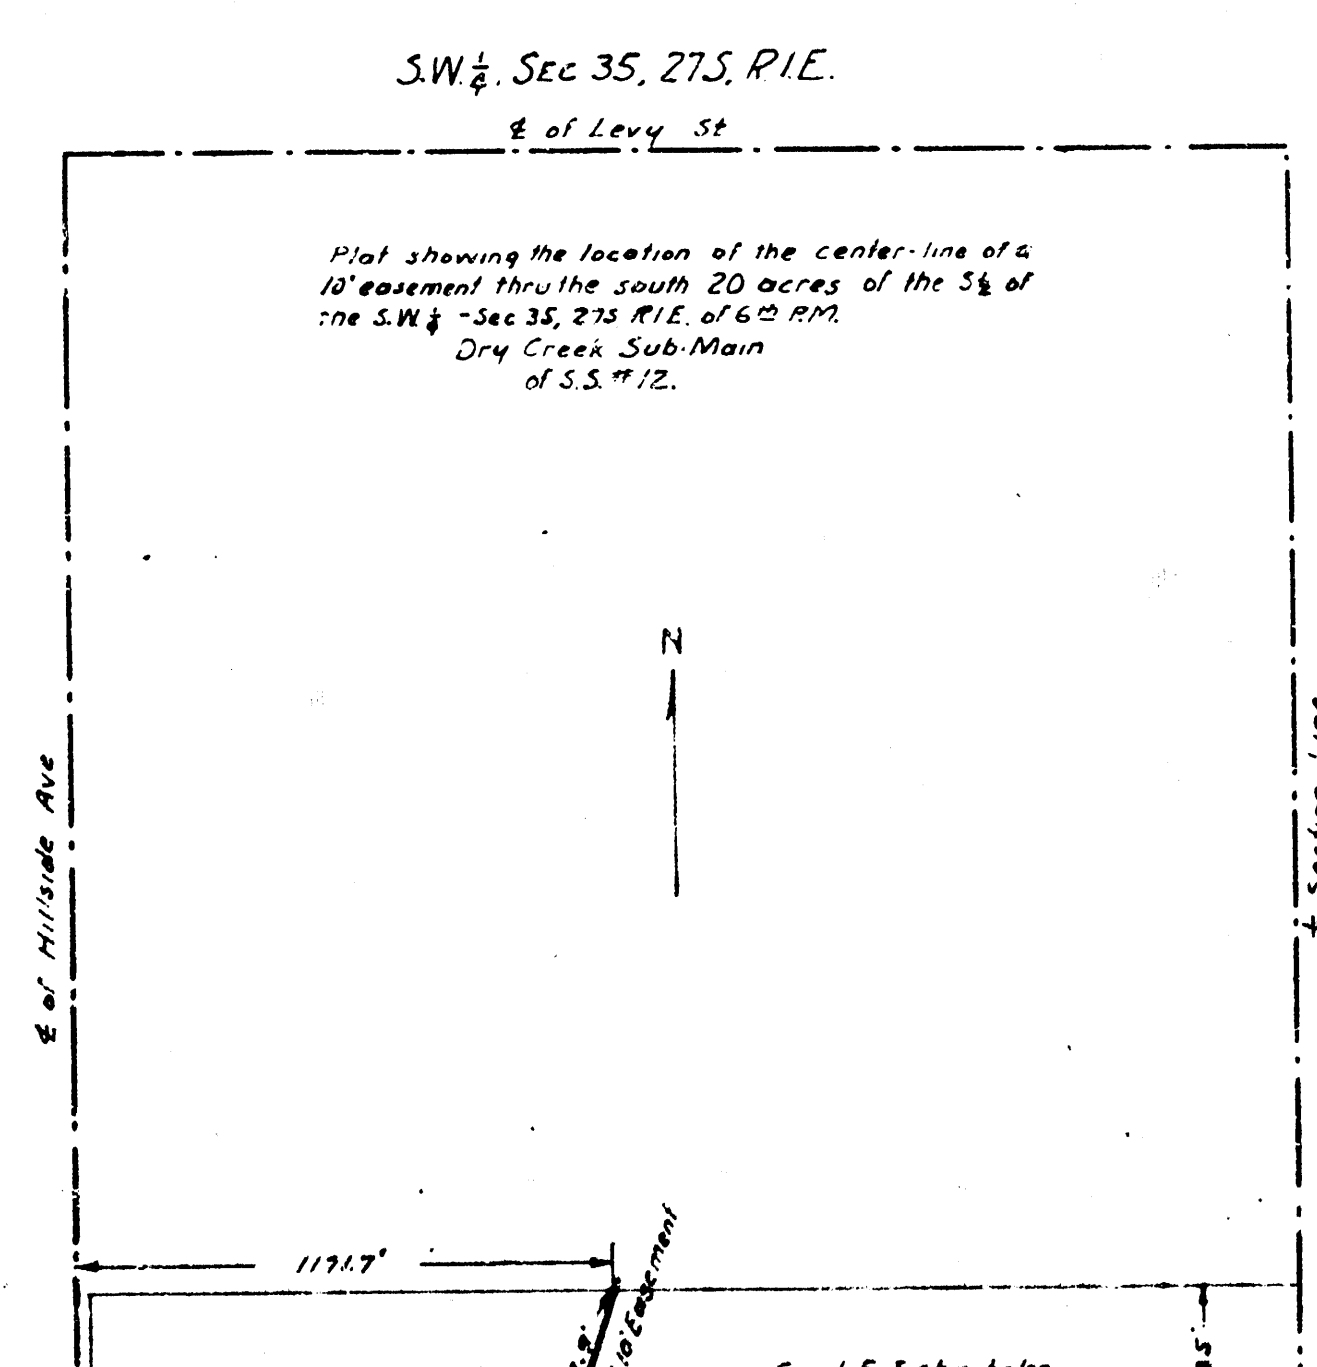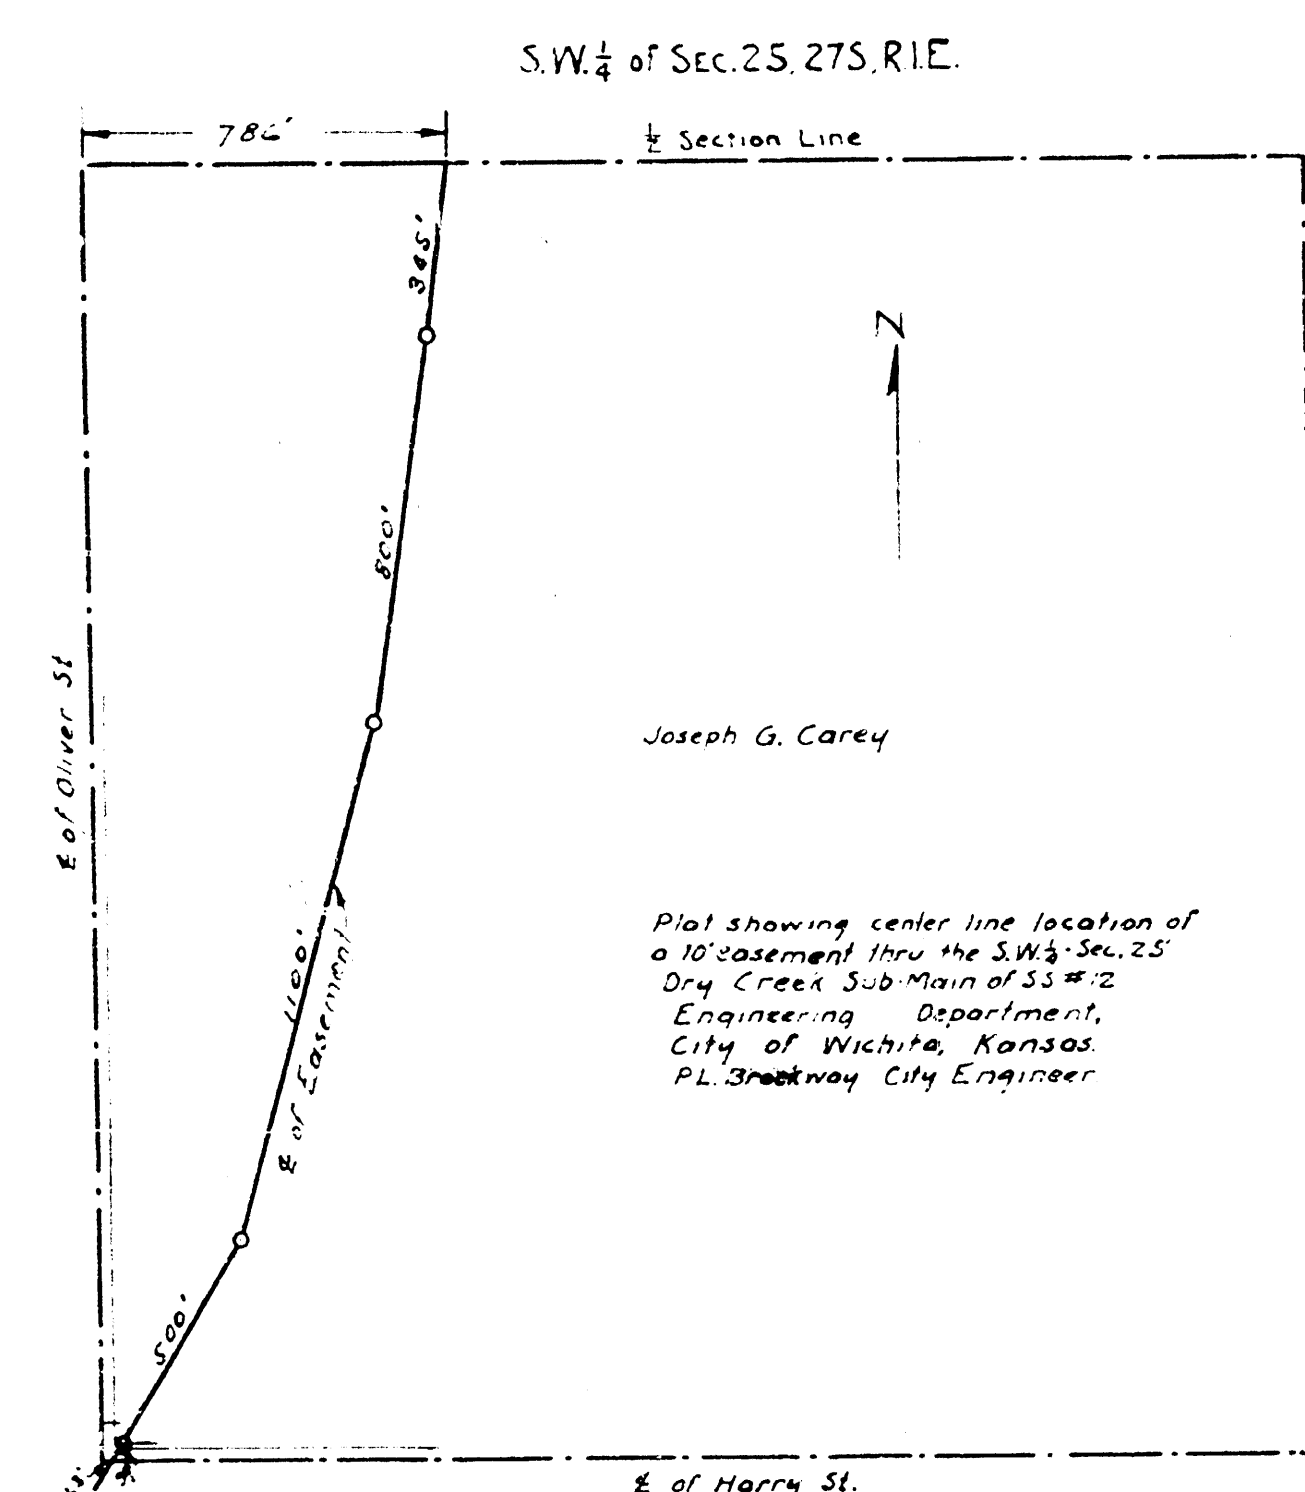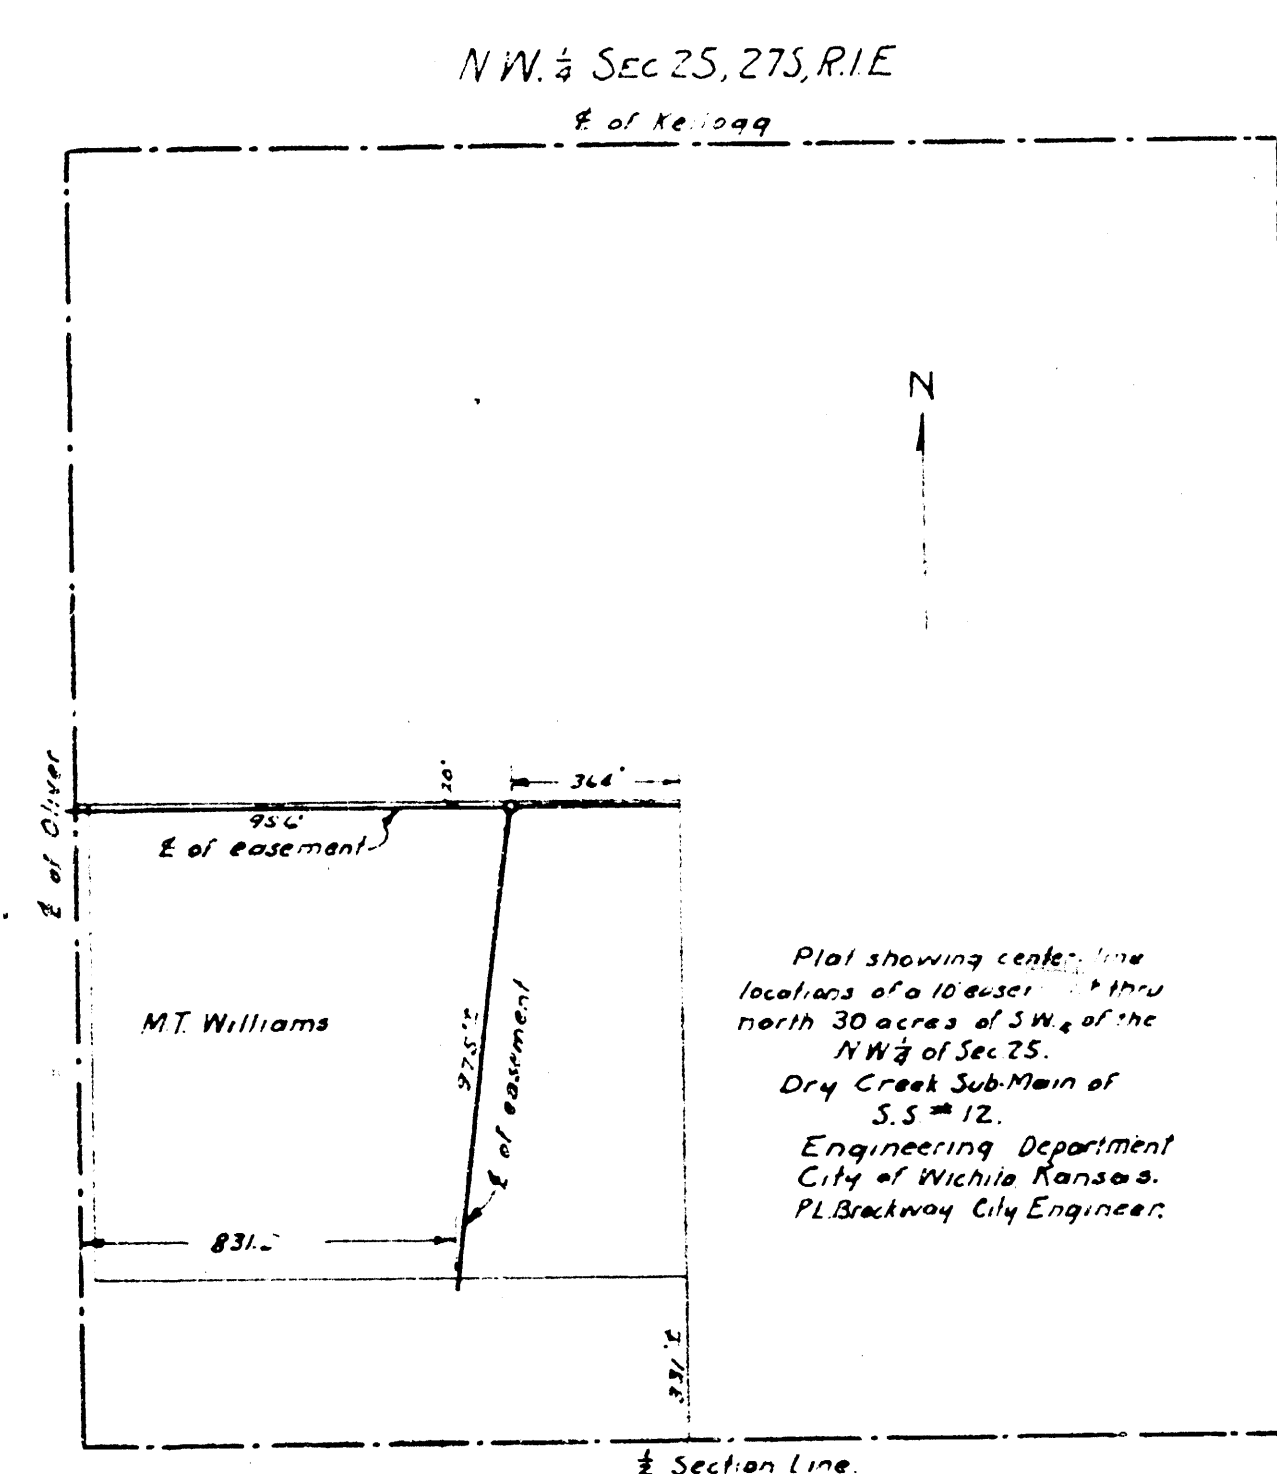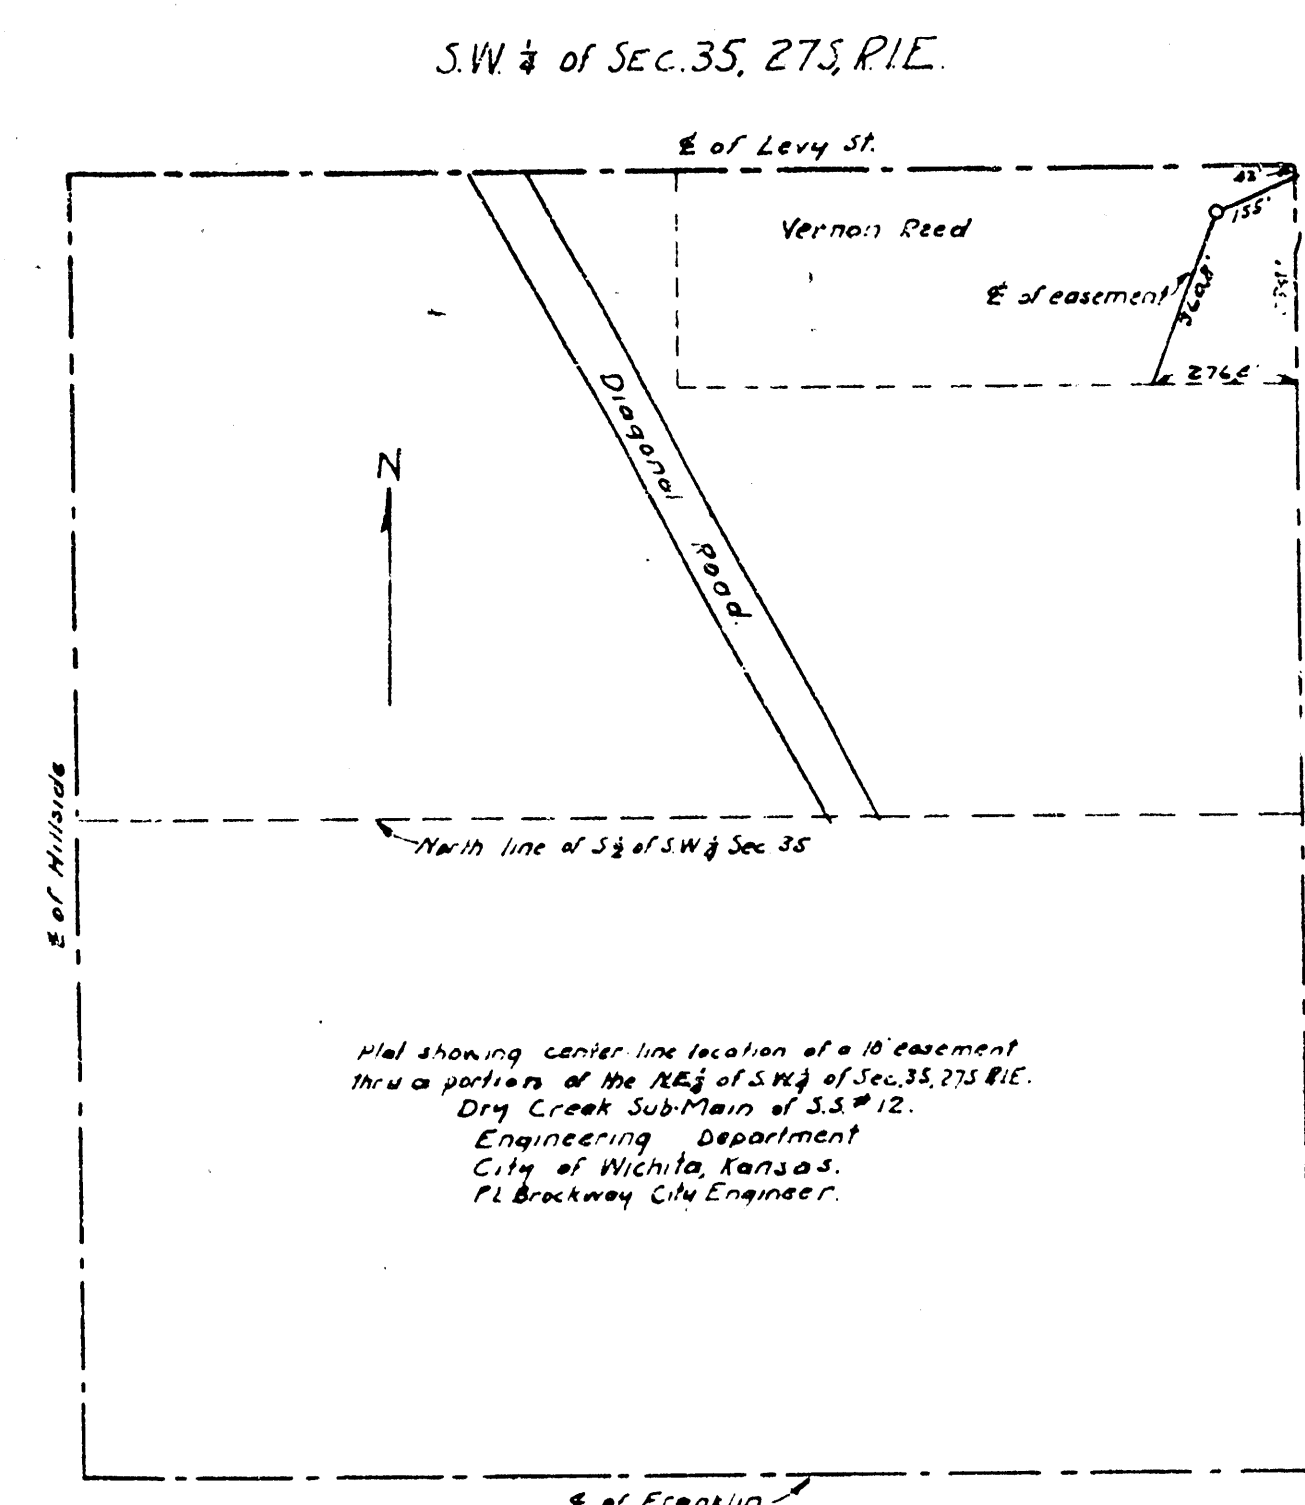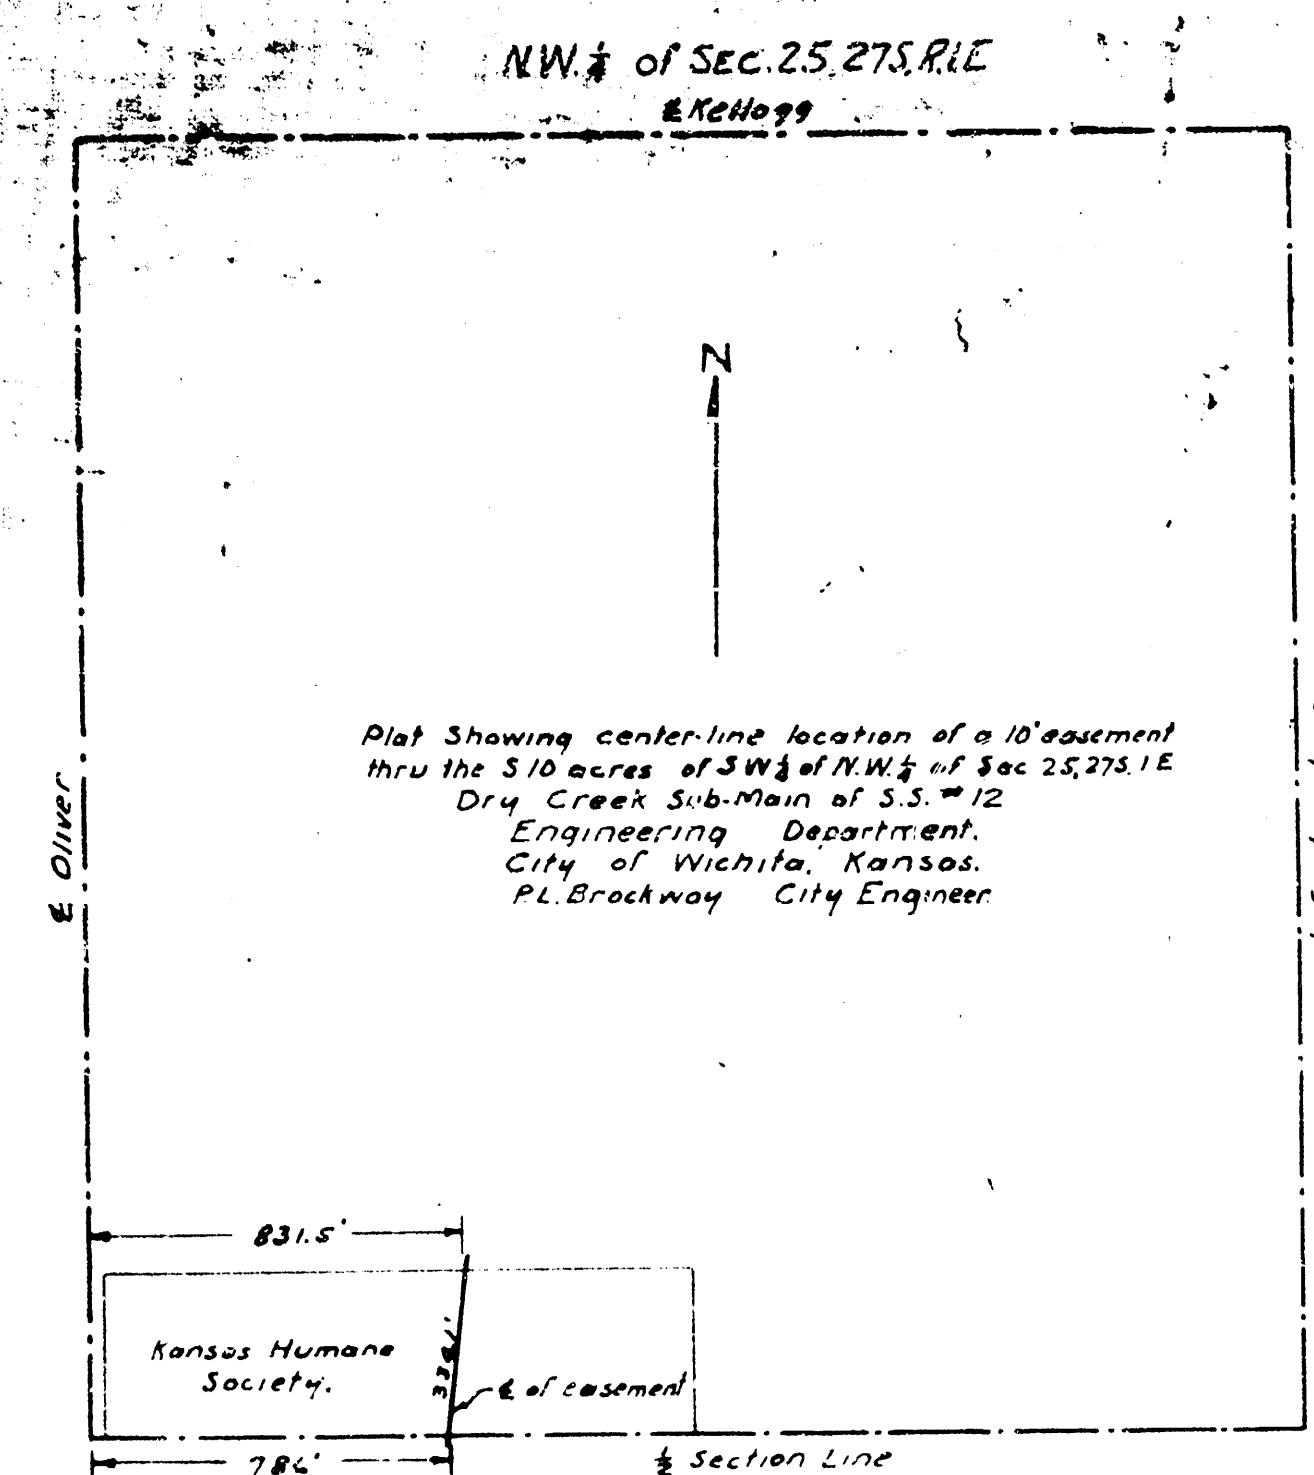

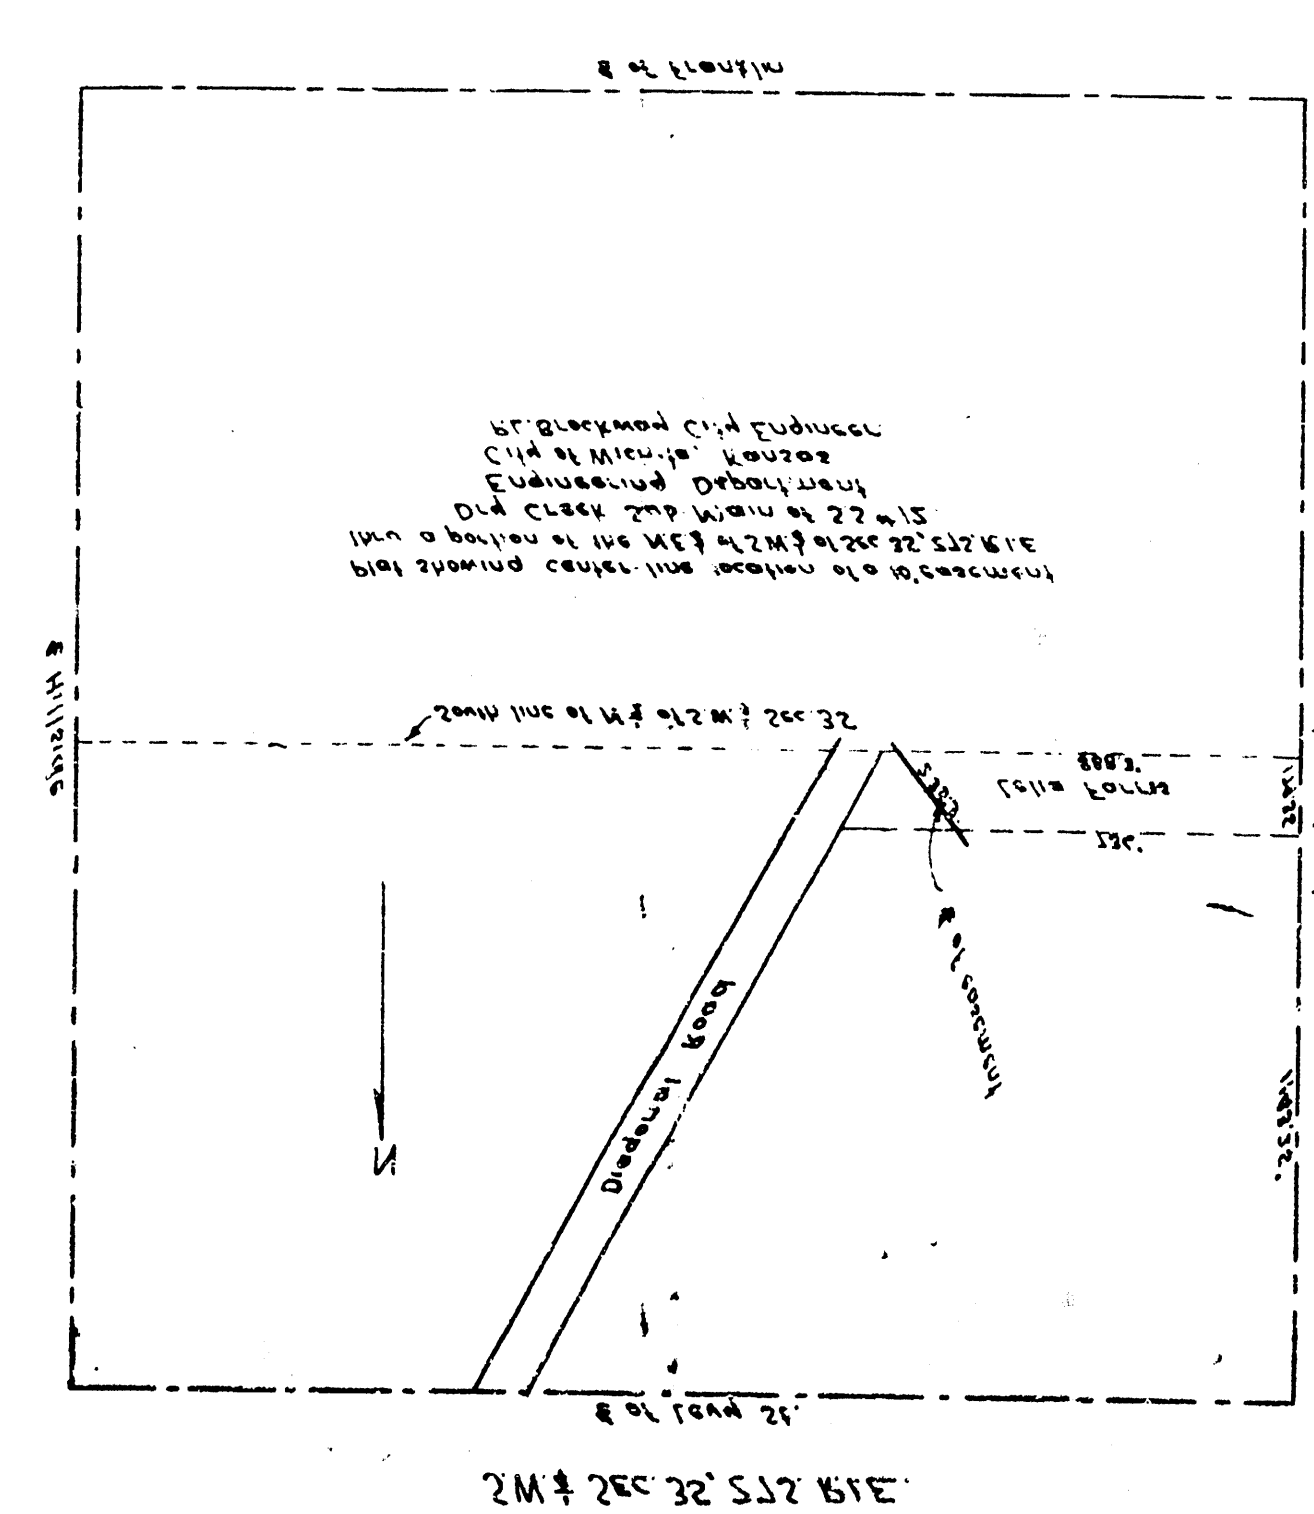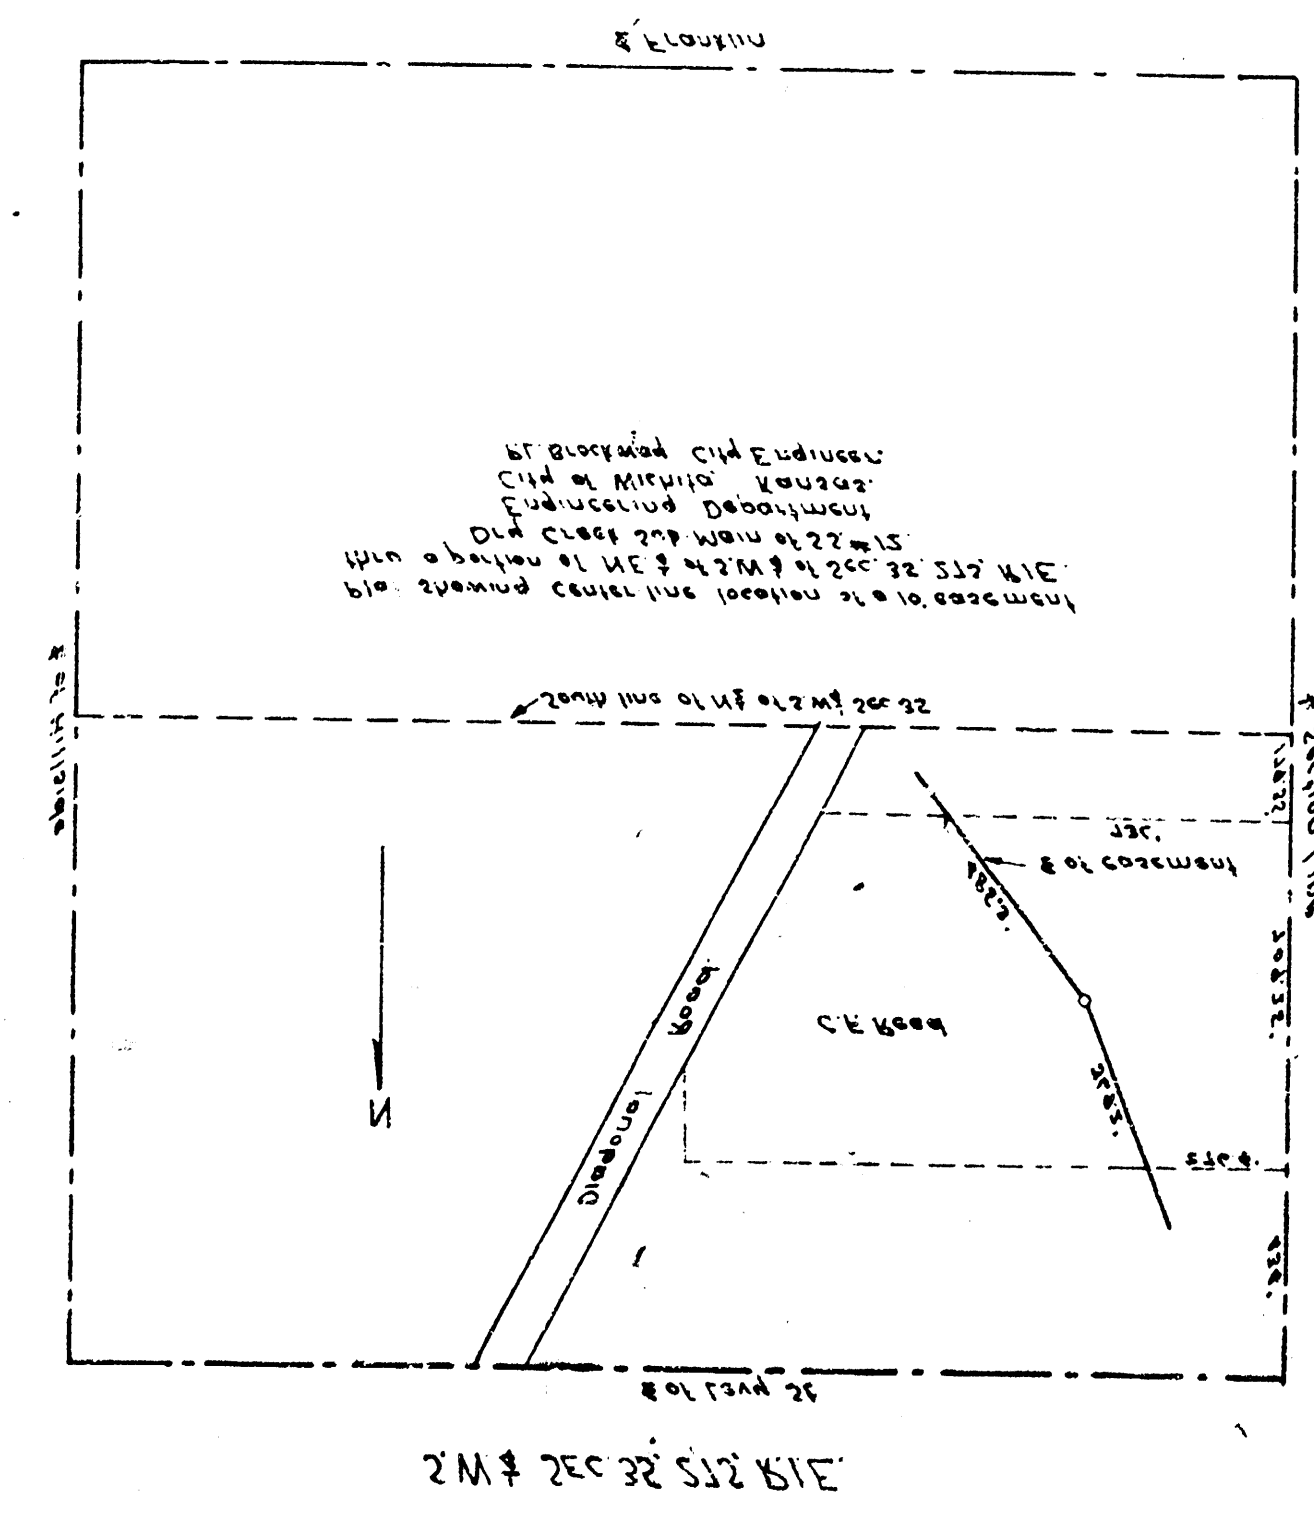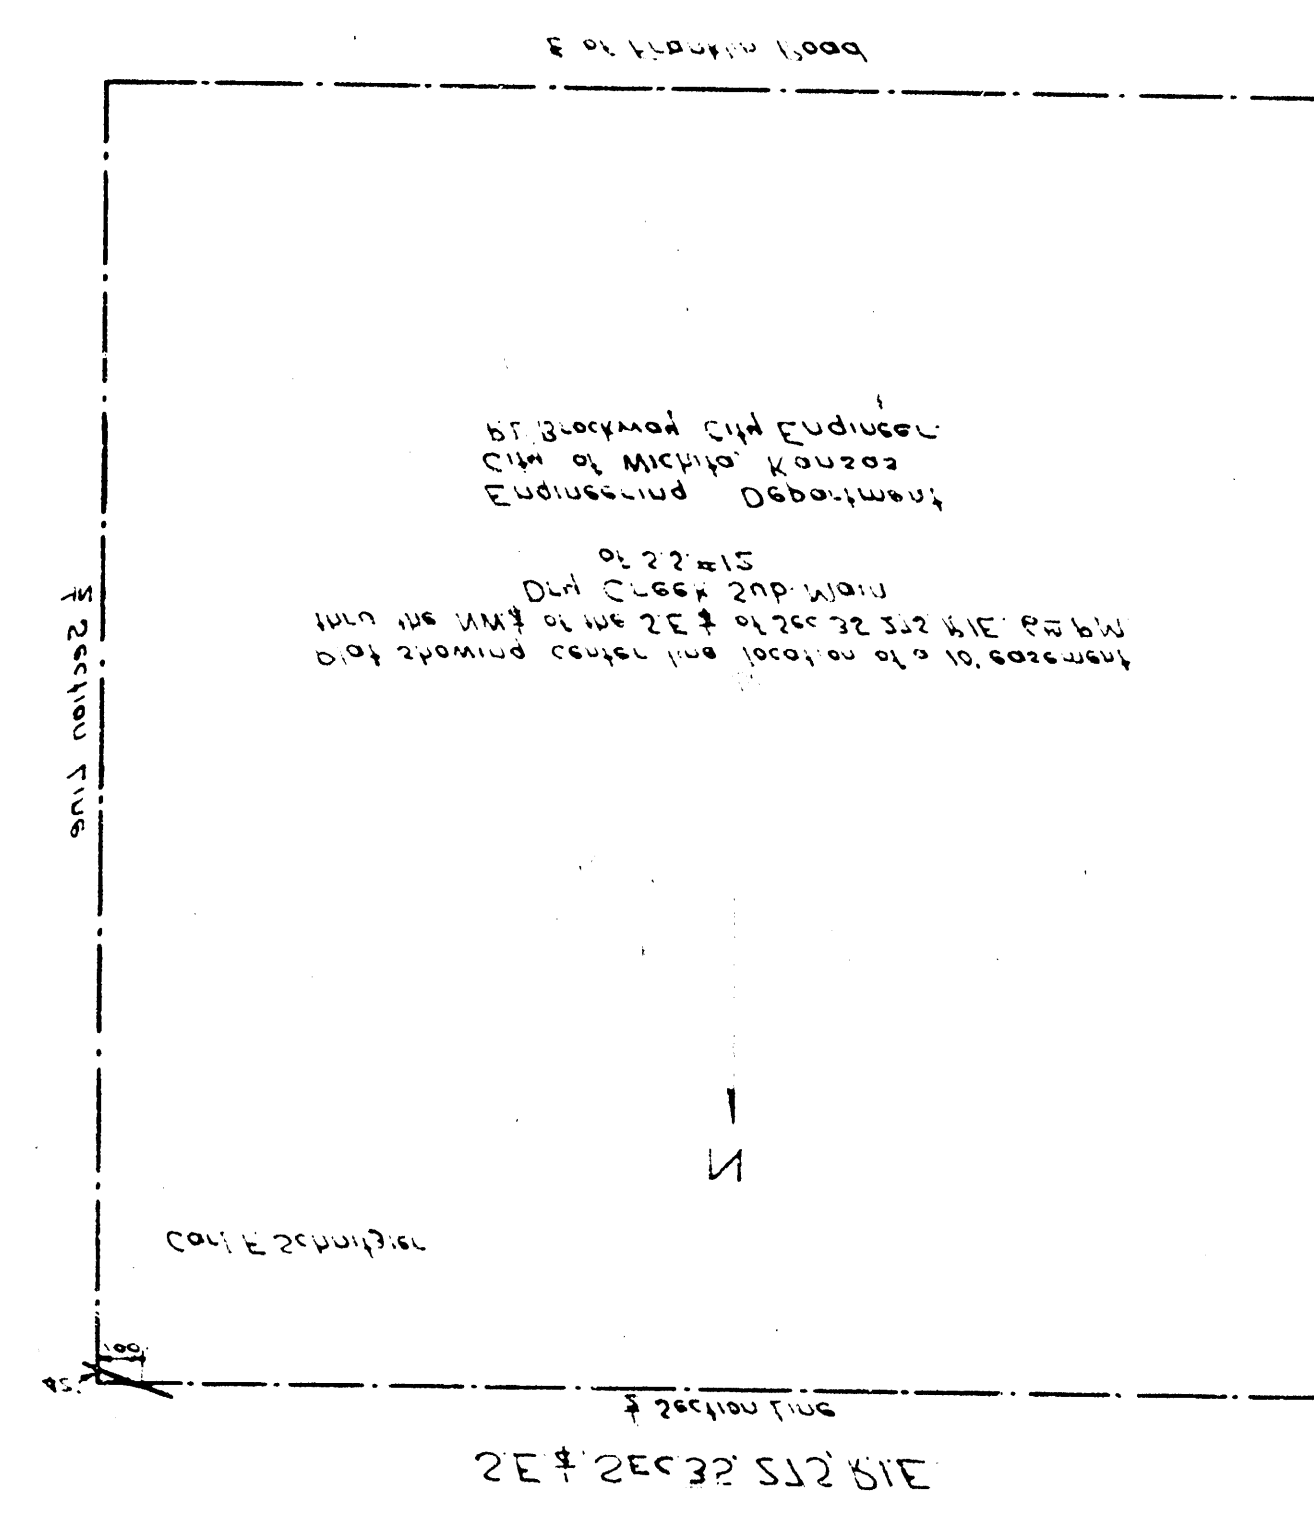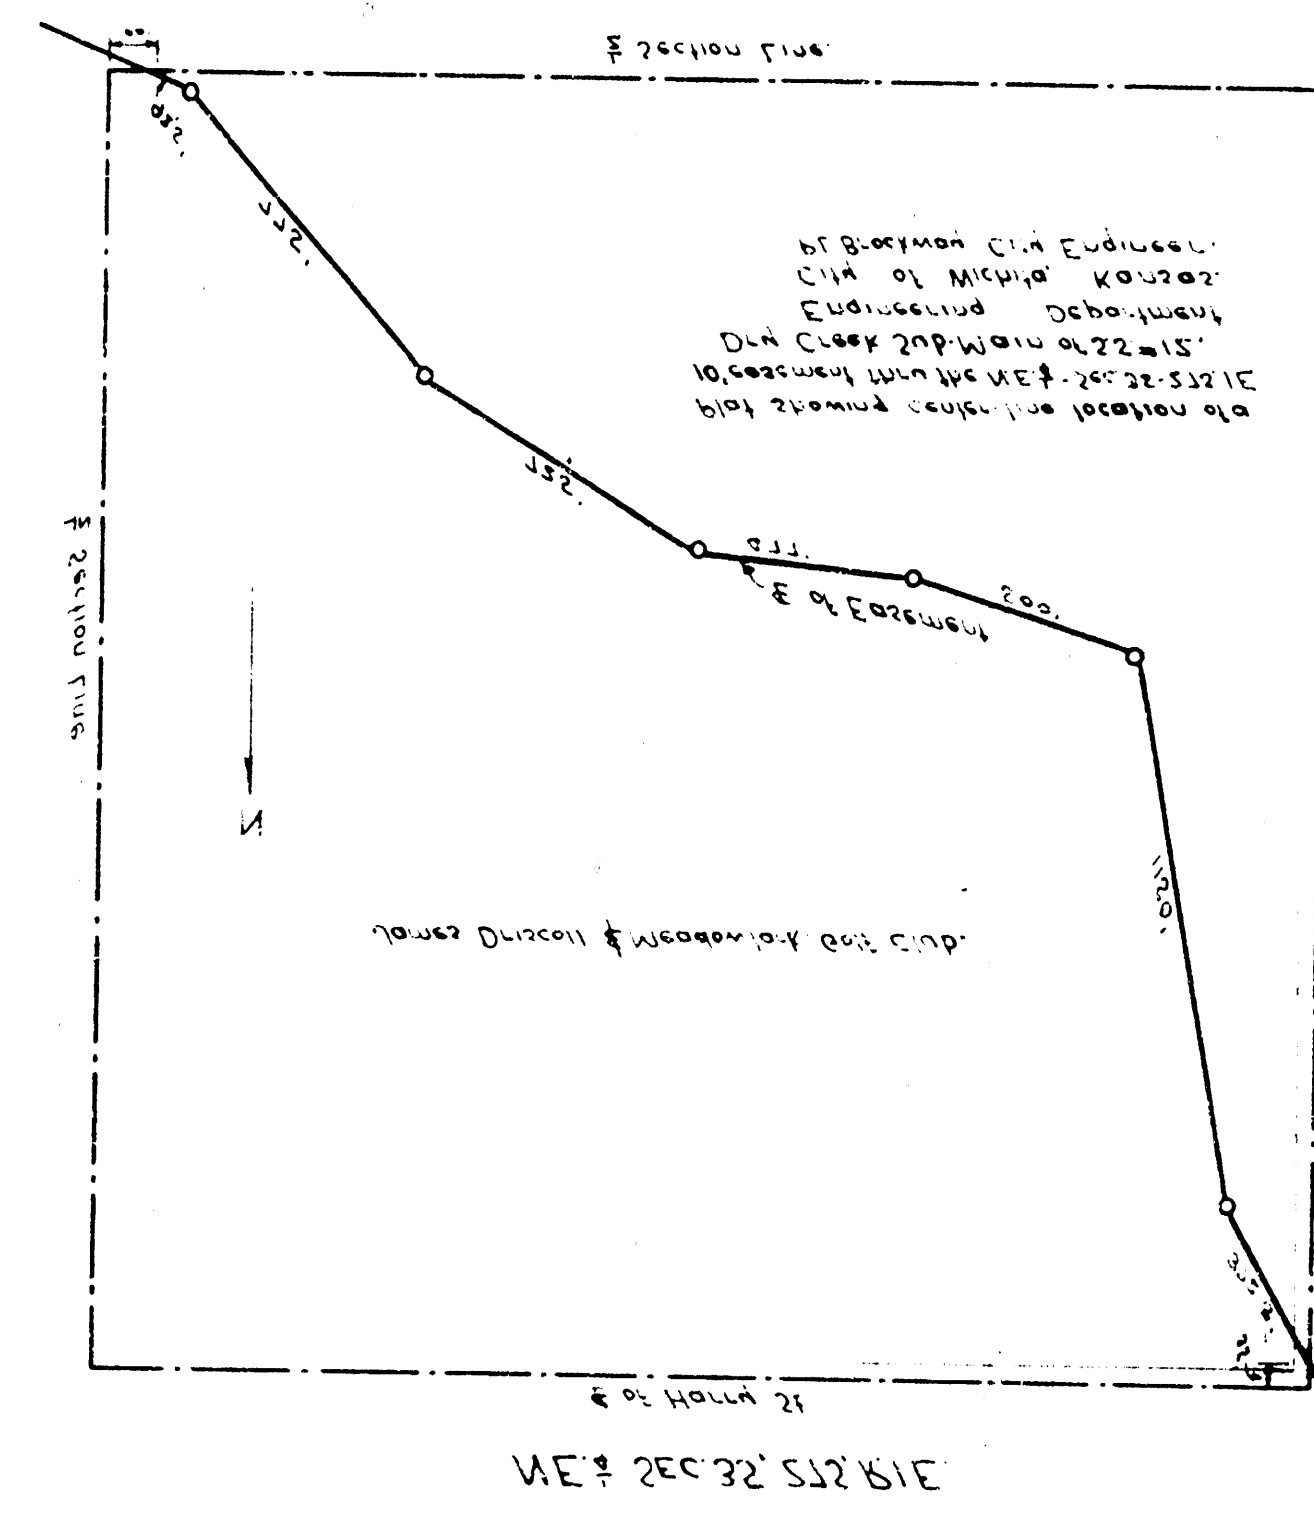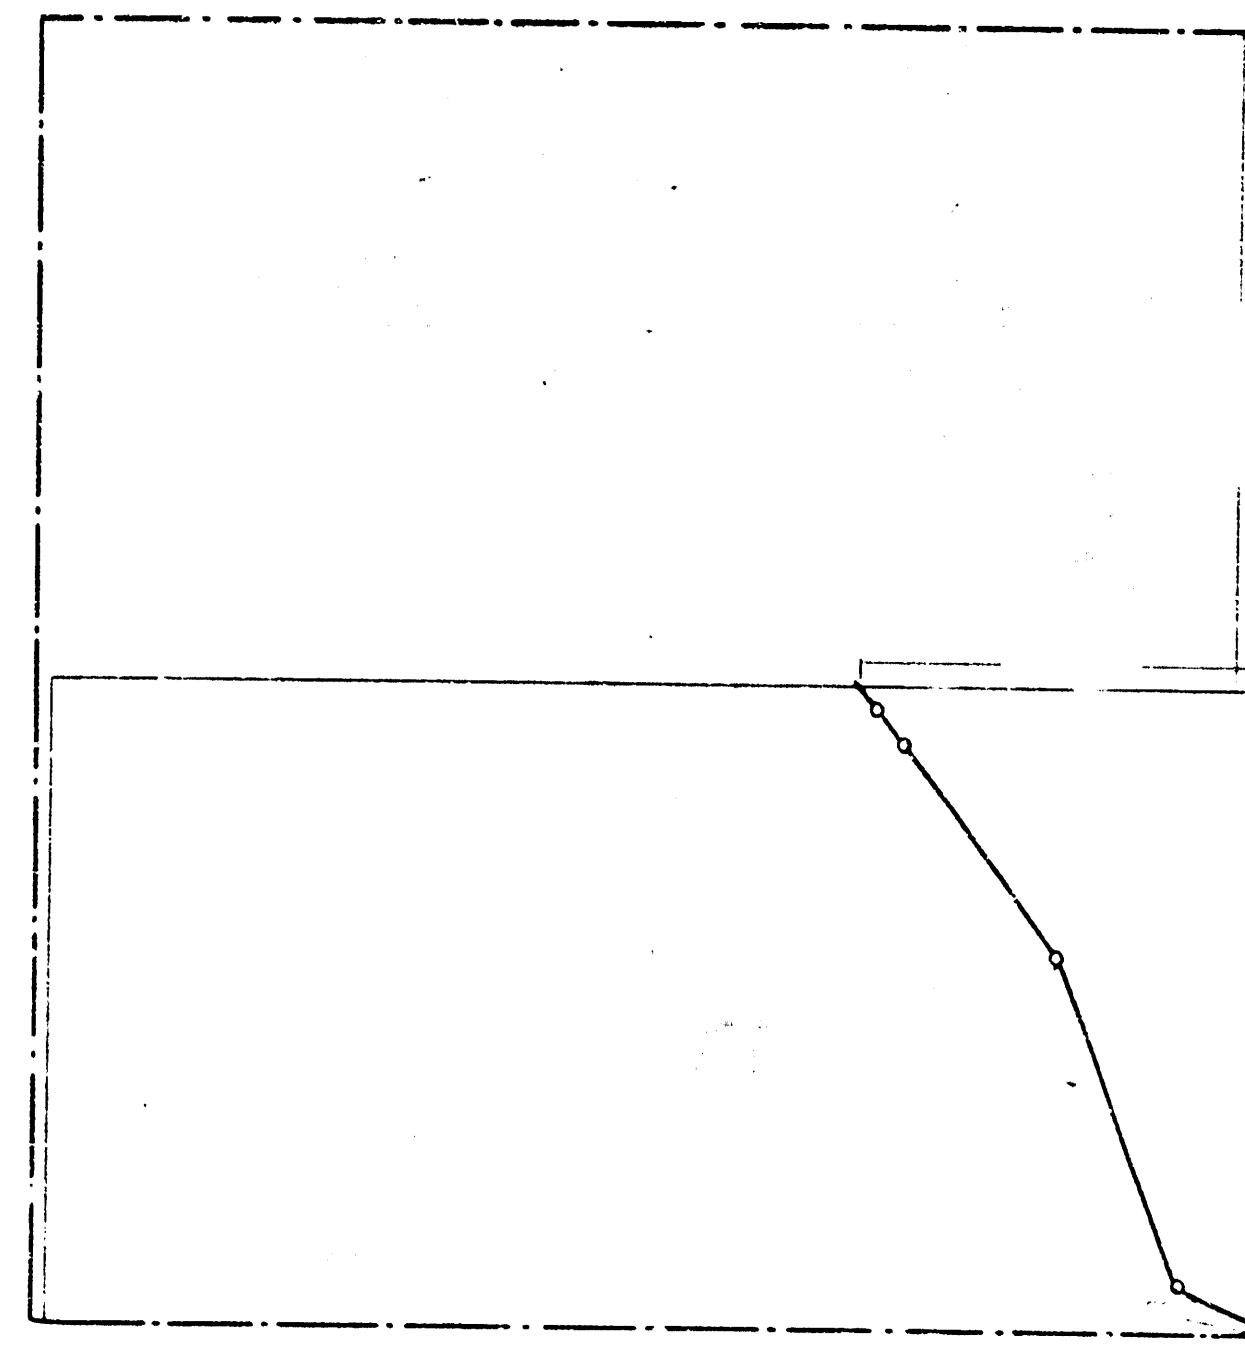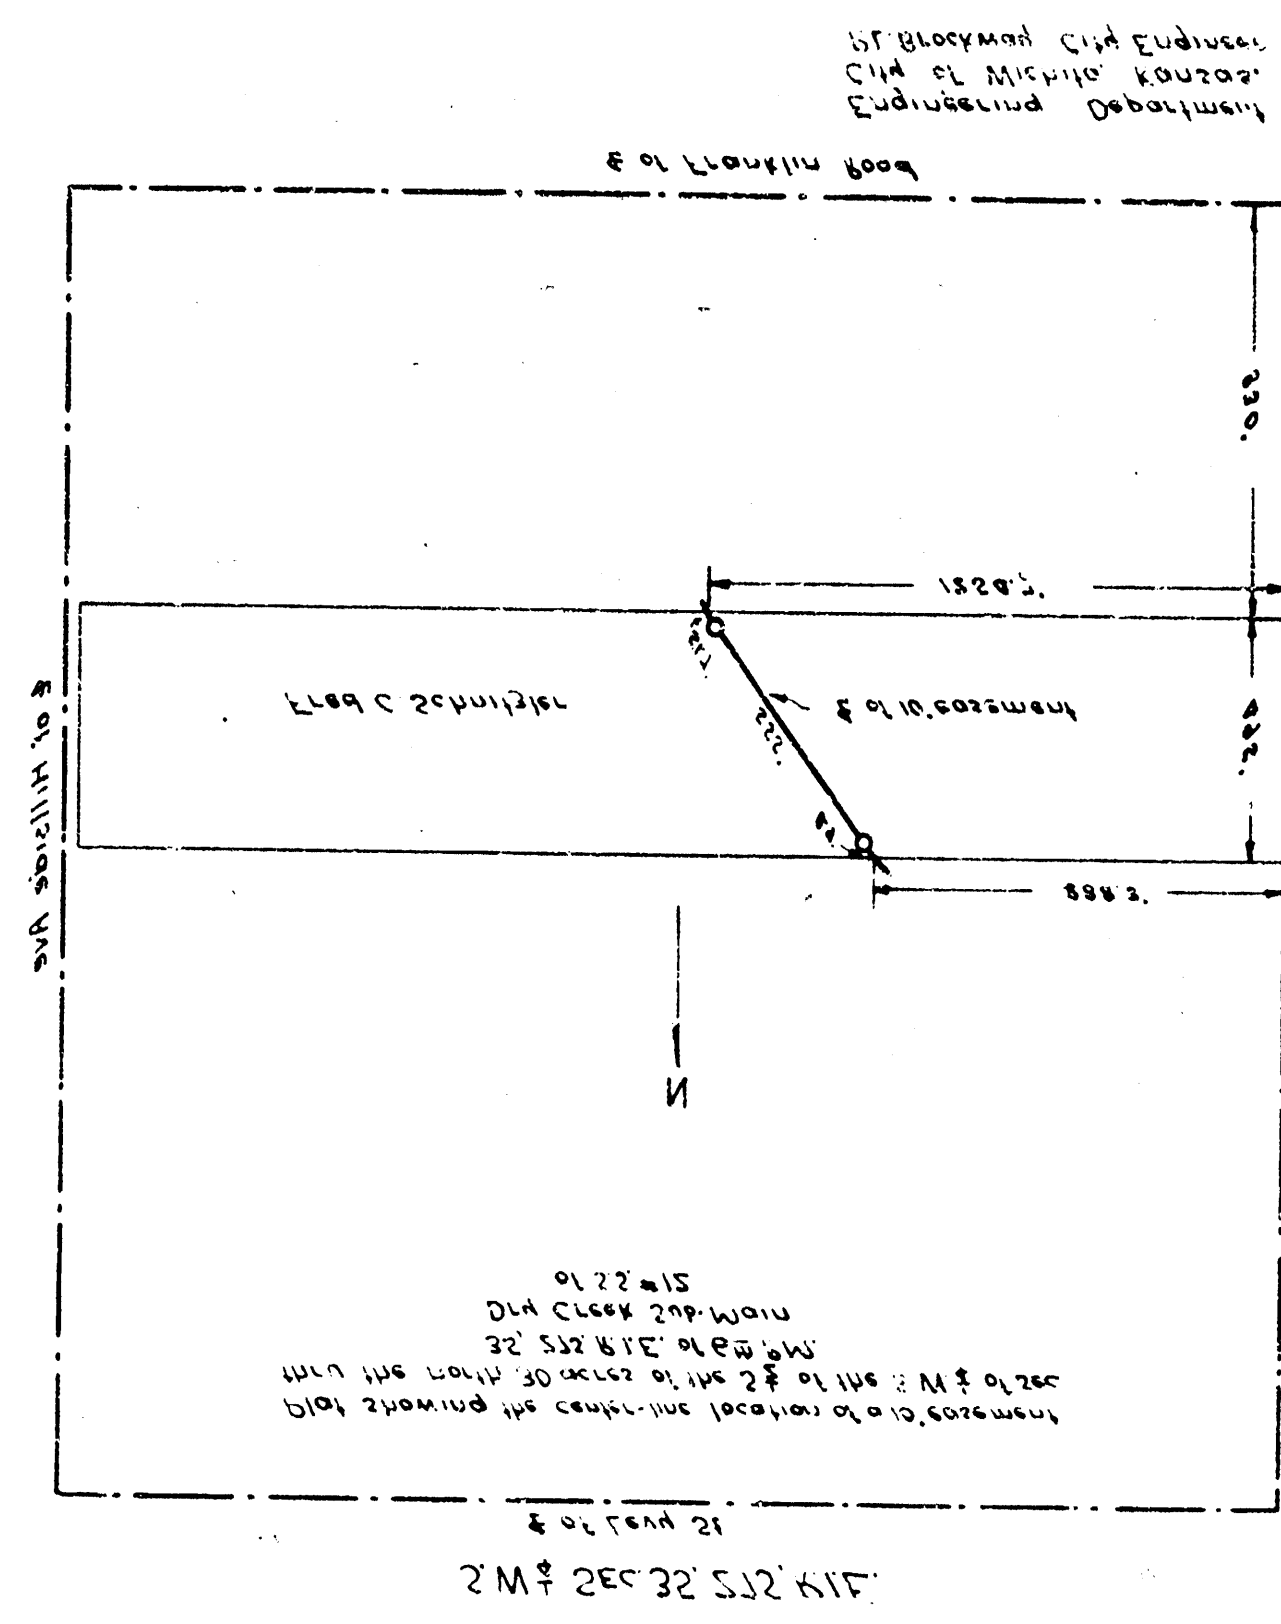

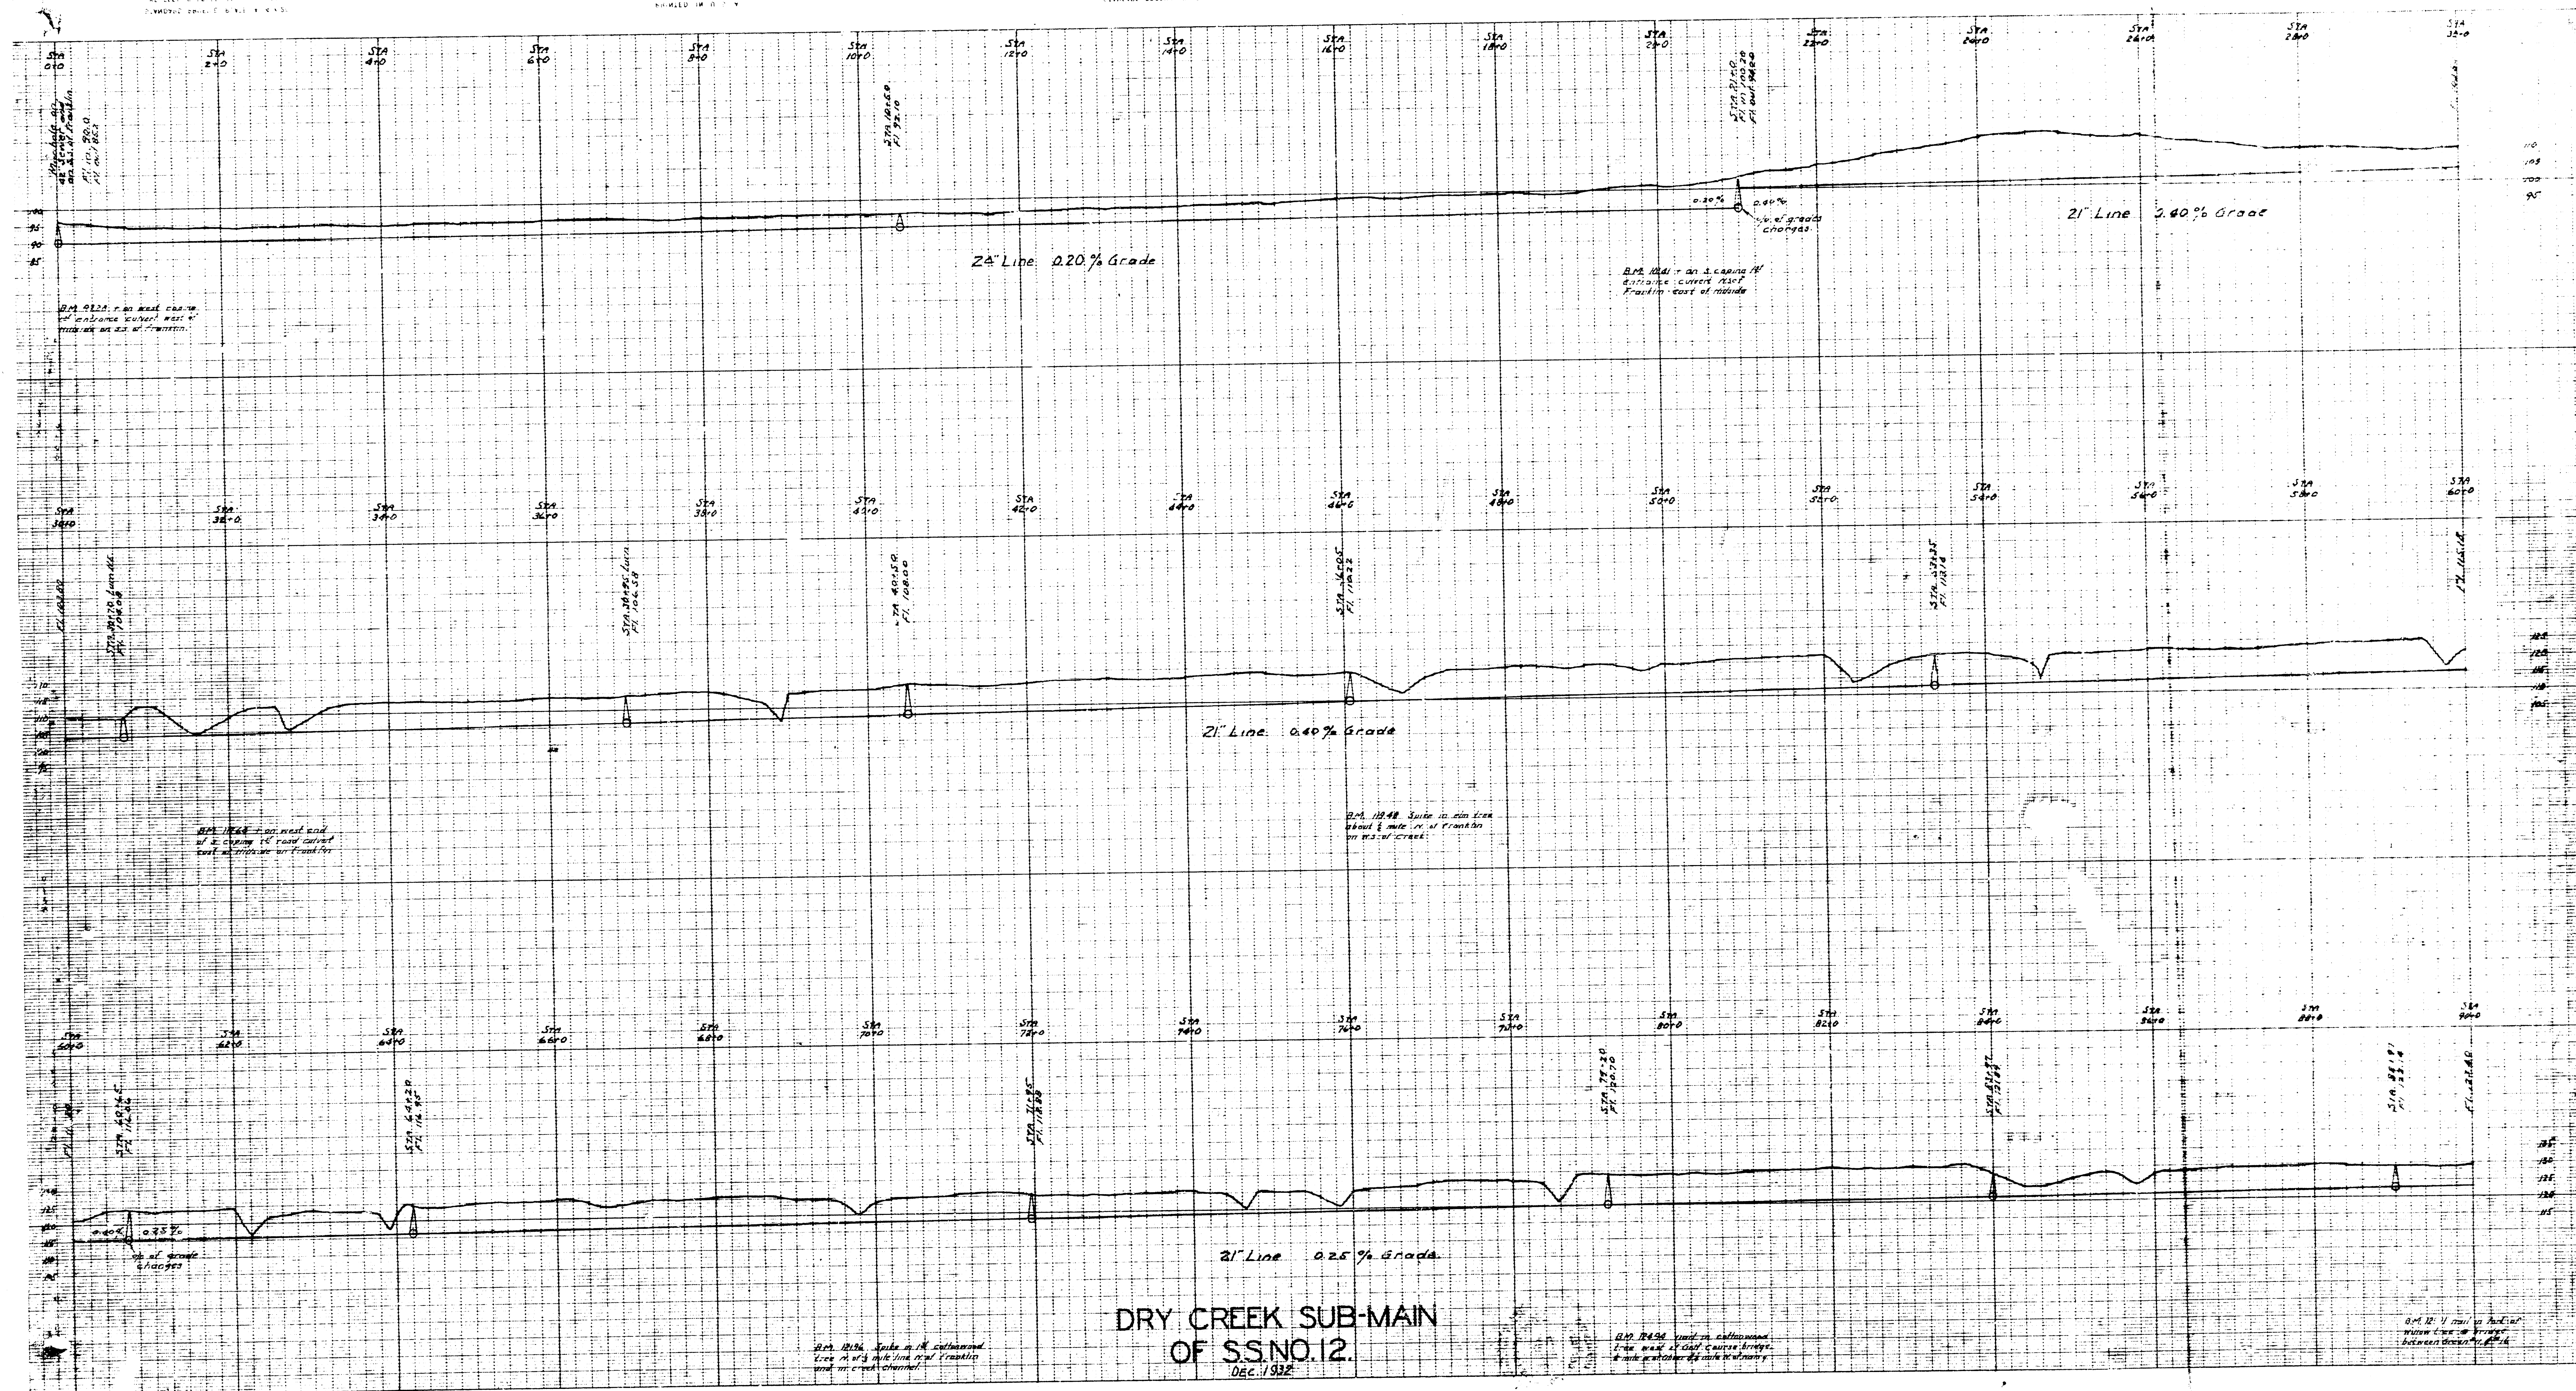

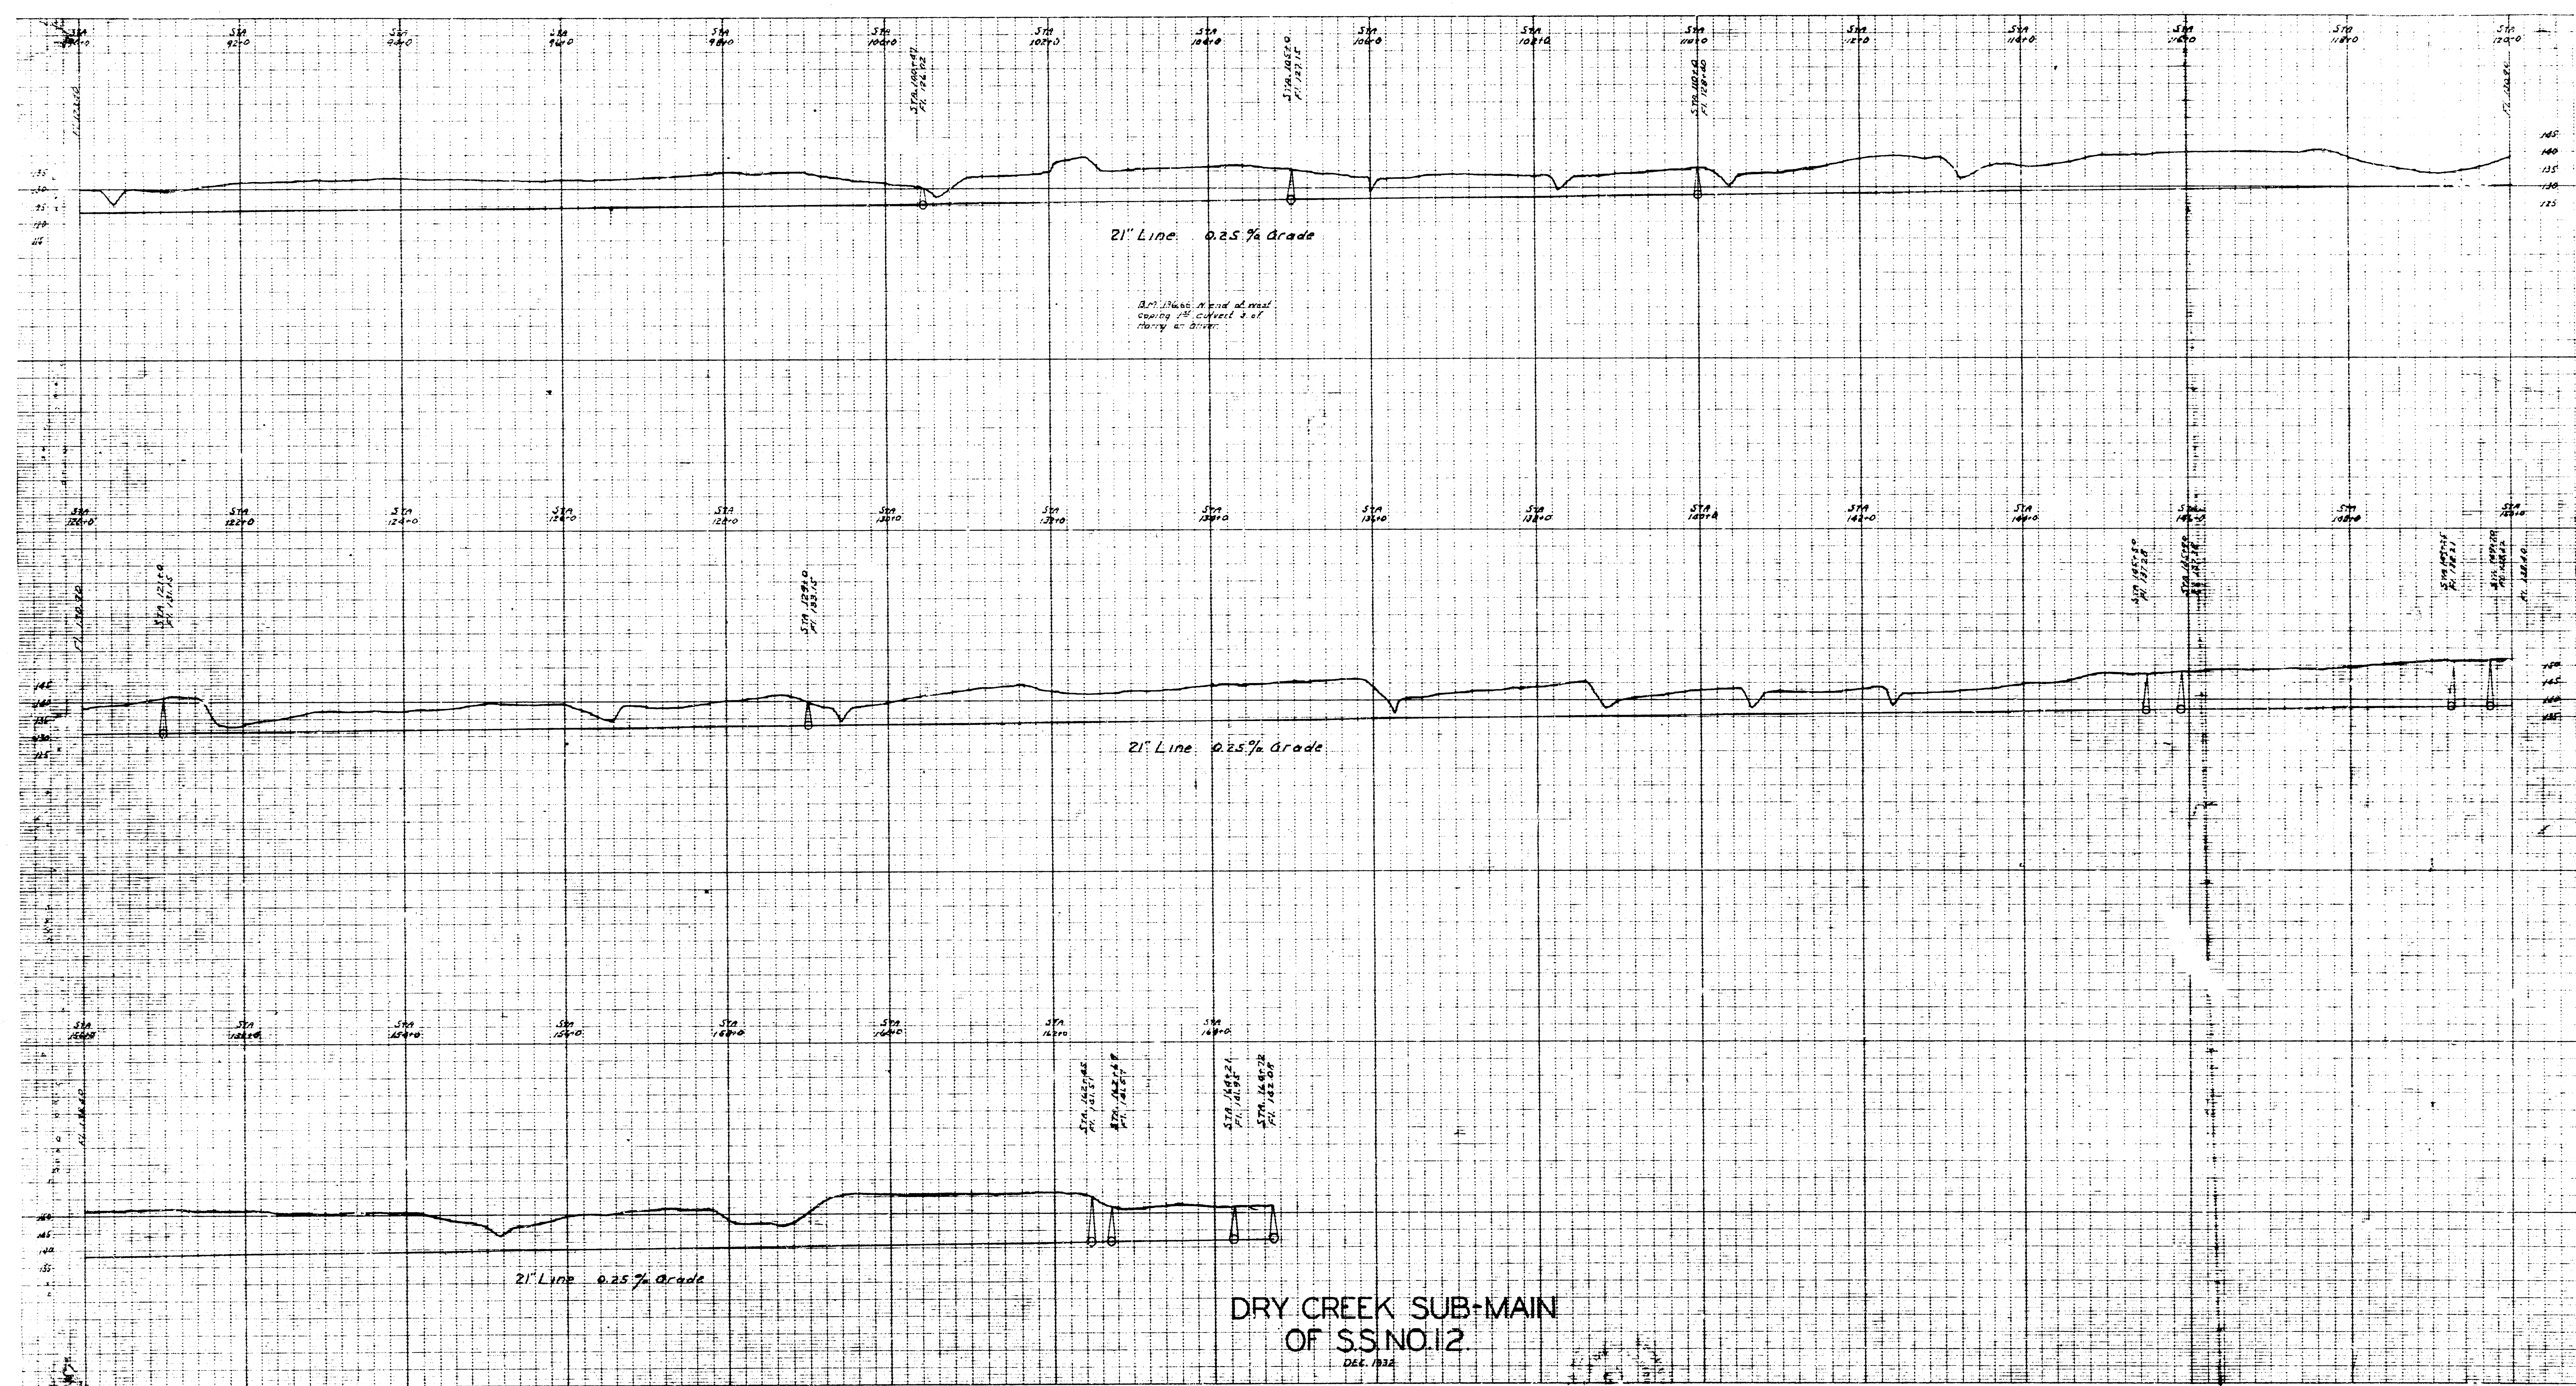

SCALE 1" = 20' HORIZONTAL
SCALE 1" = 10' VERTICAL

DESIGNED BY: J. W. BROWN
CHECKED BY: J. W. BROWN

DATE: 10/1/54
BY: J. W. BROWN

SCALE 1" = 20' HORIZONTAL
SCALE 1" = 10' VERTICAL

SCALE 1" = 20' HORIZONTAL
SCALE 1" = 10' VERTICAL

