






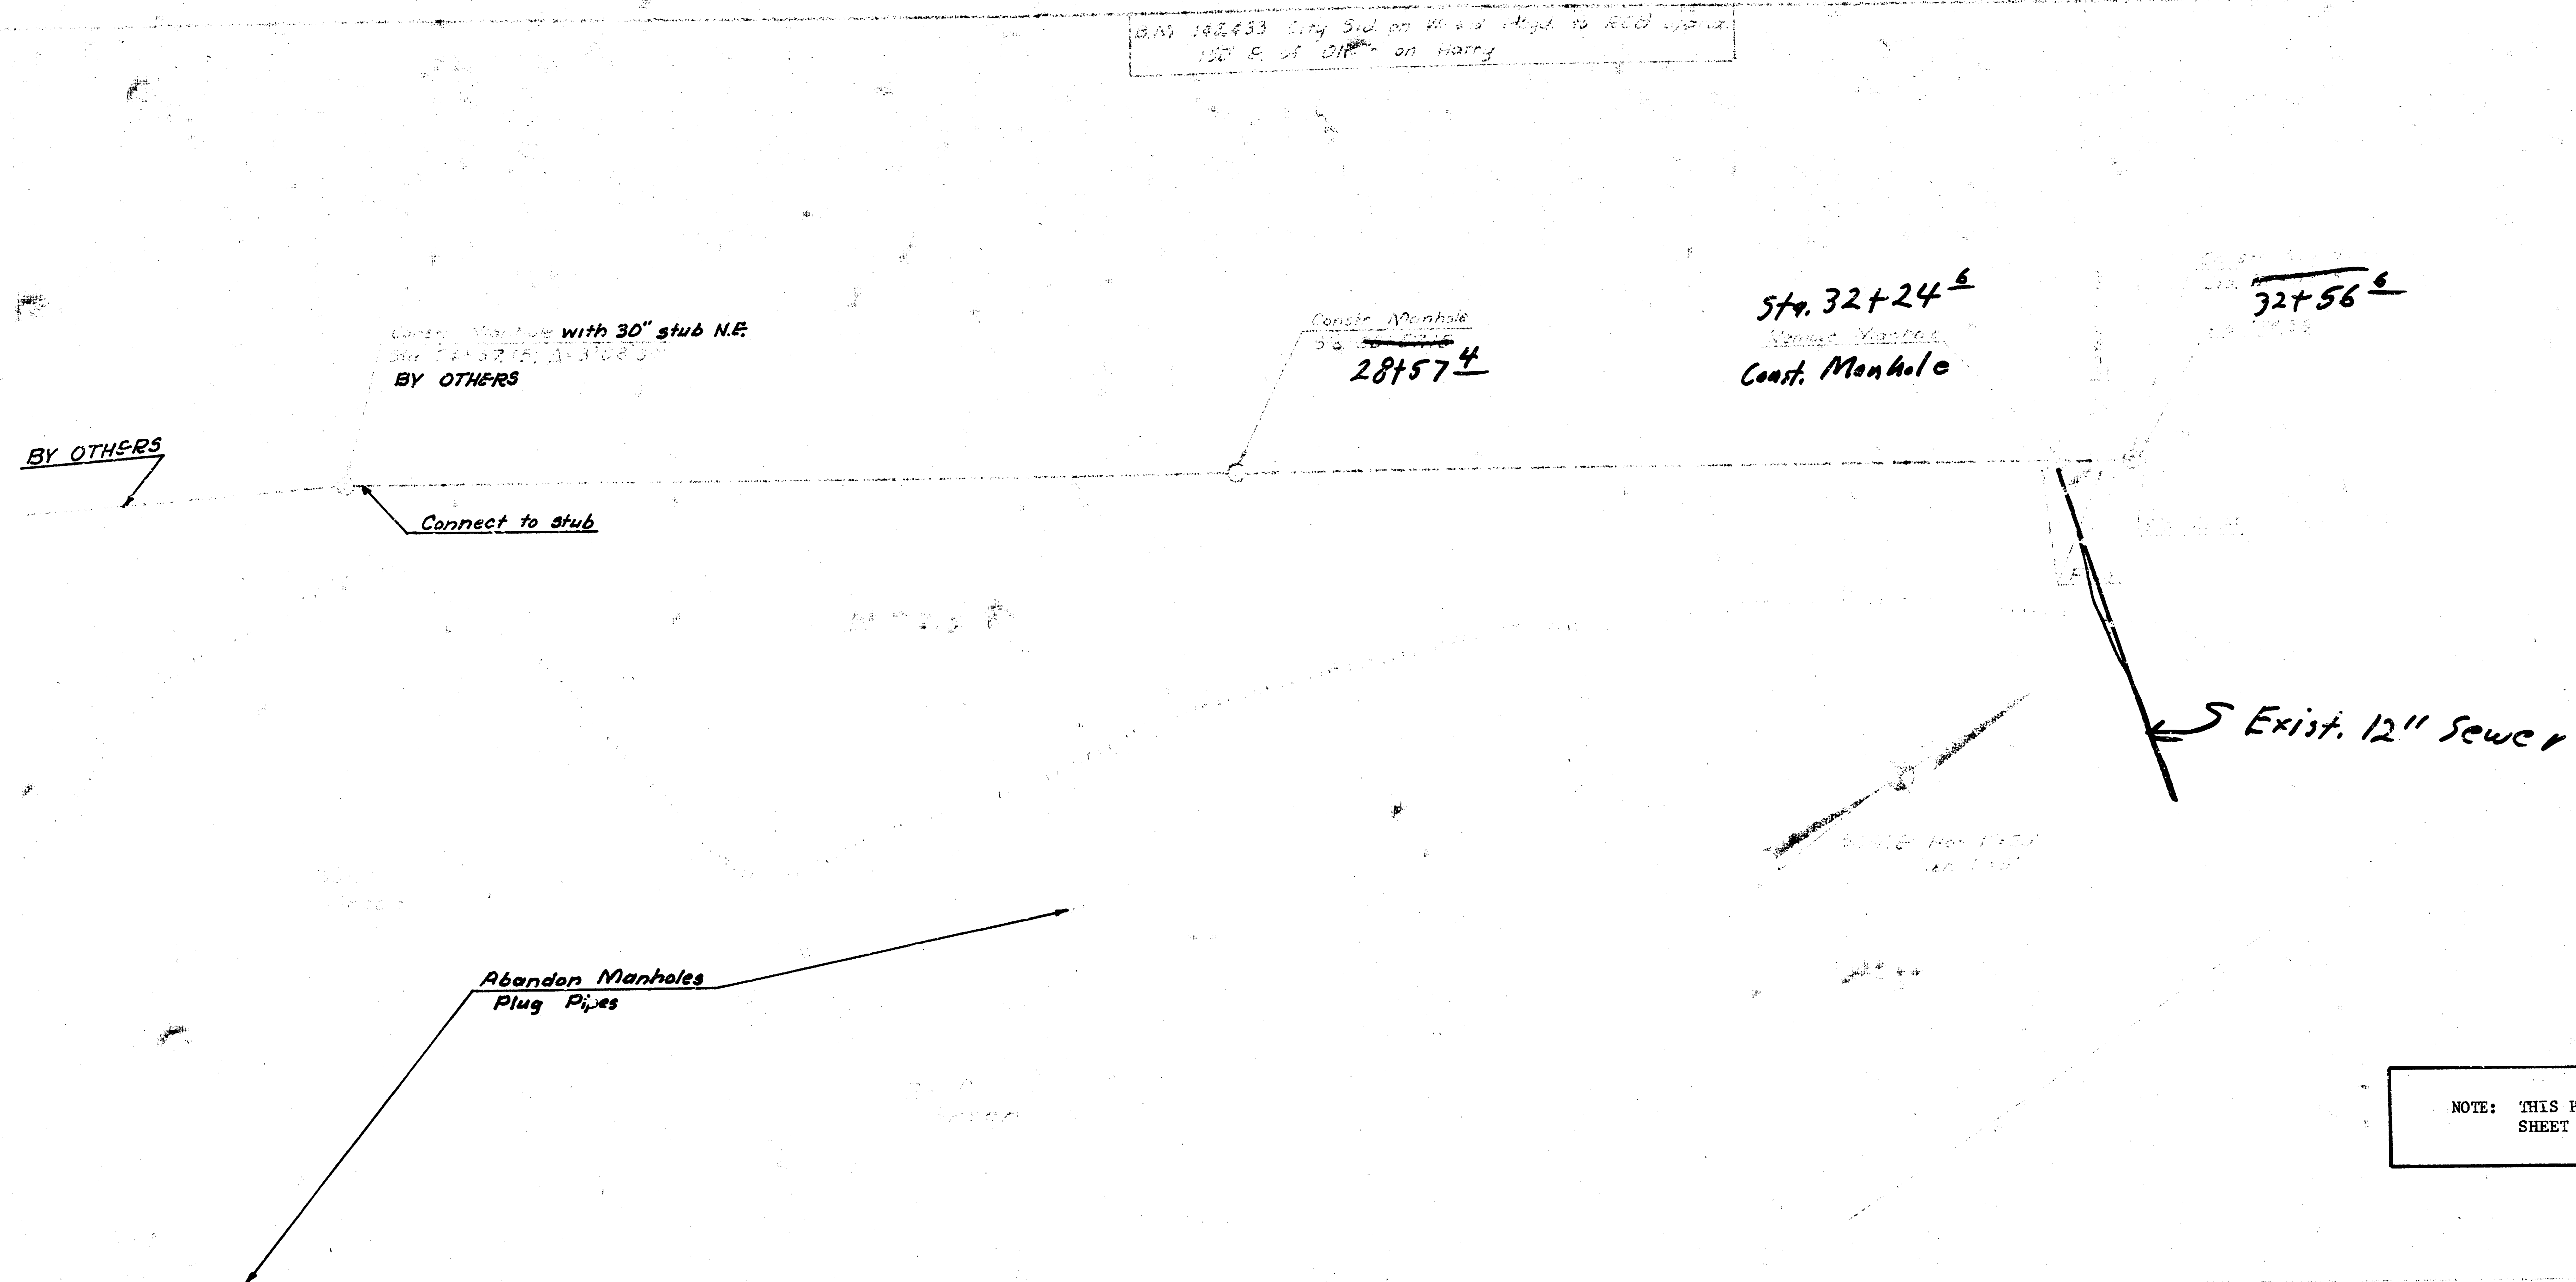

NOTE: THIS PROJECT INCLUDES ALL WORK ON THIS SHEET EXCEPT AS OTHERWISE NOTED.

