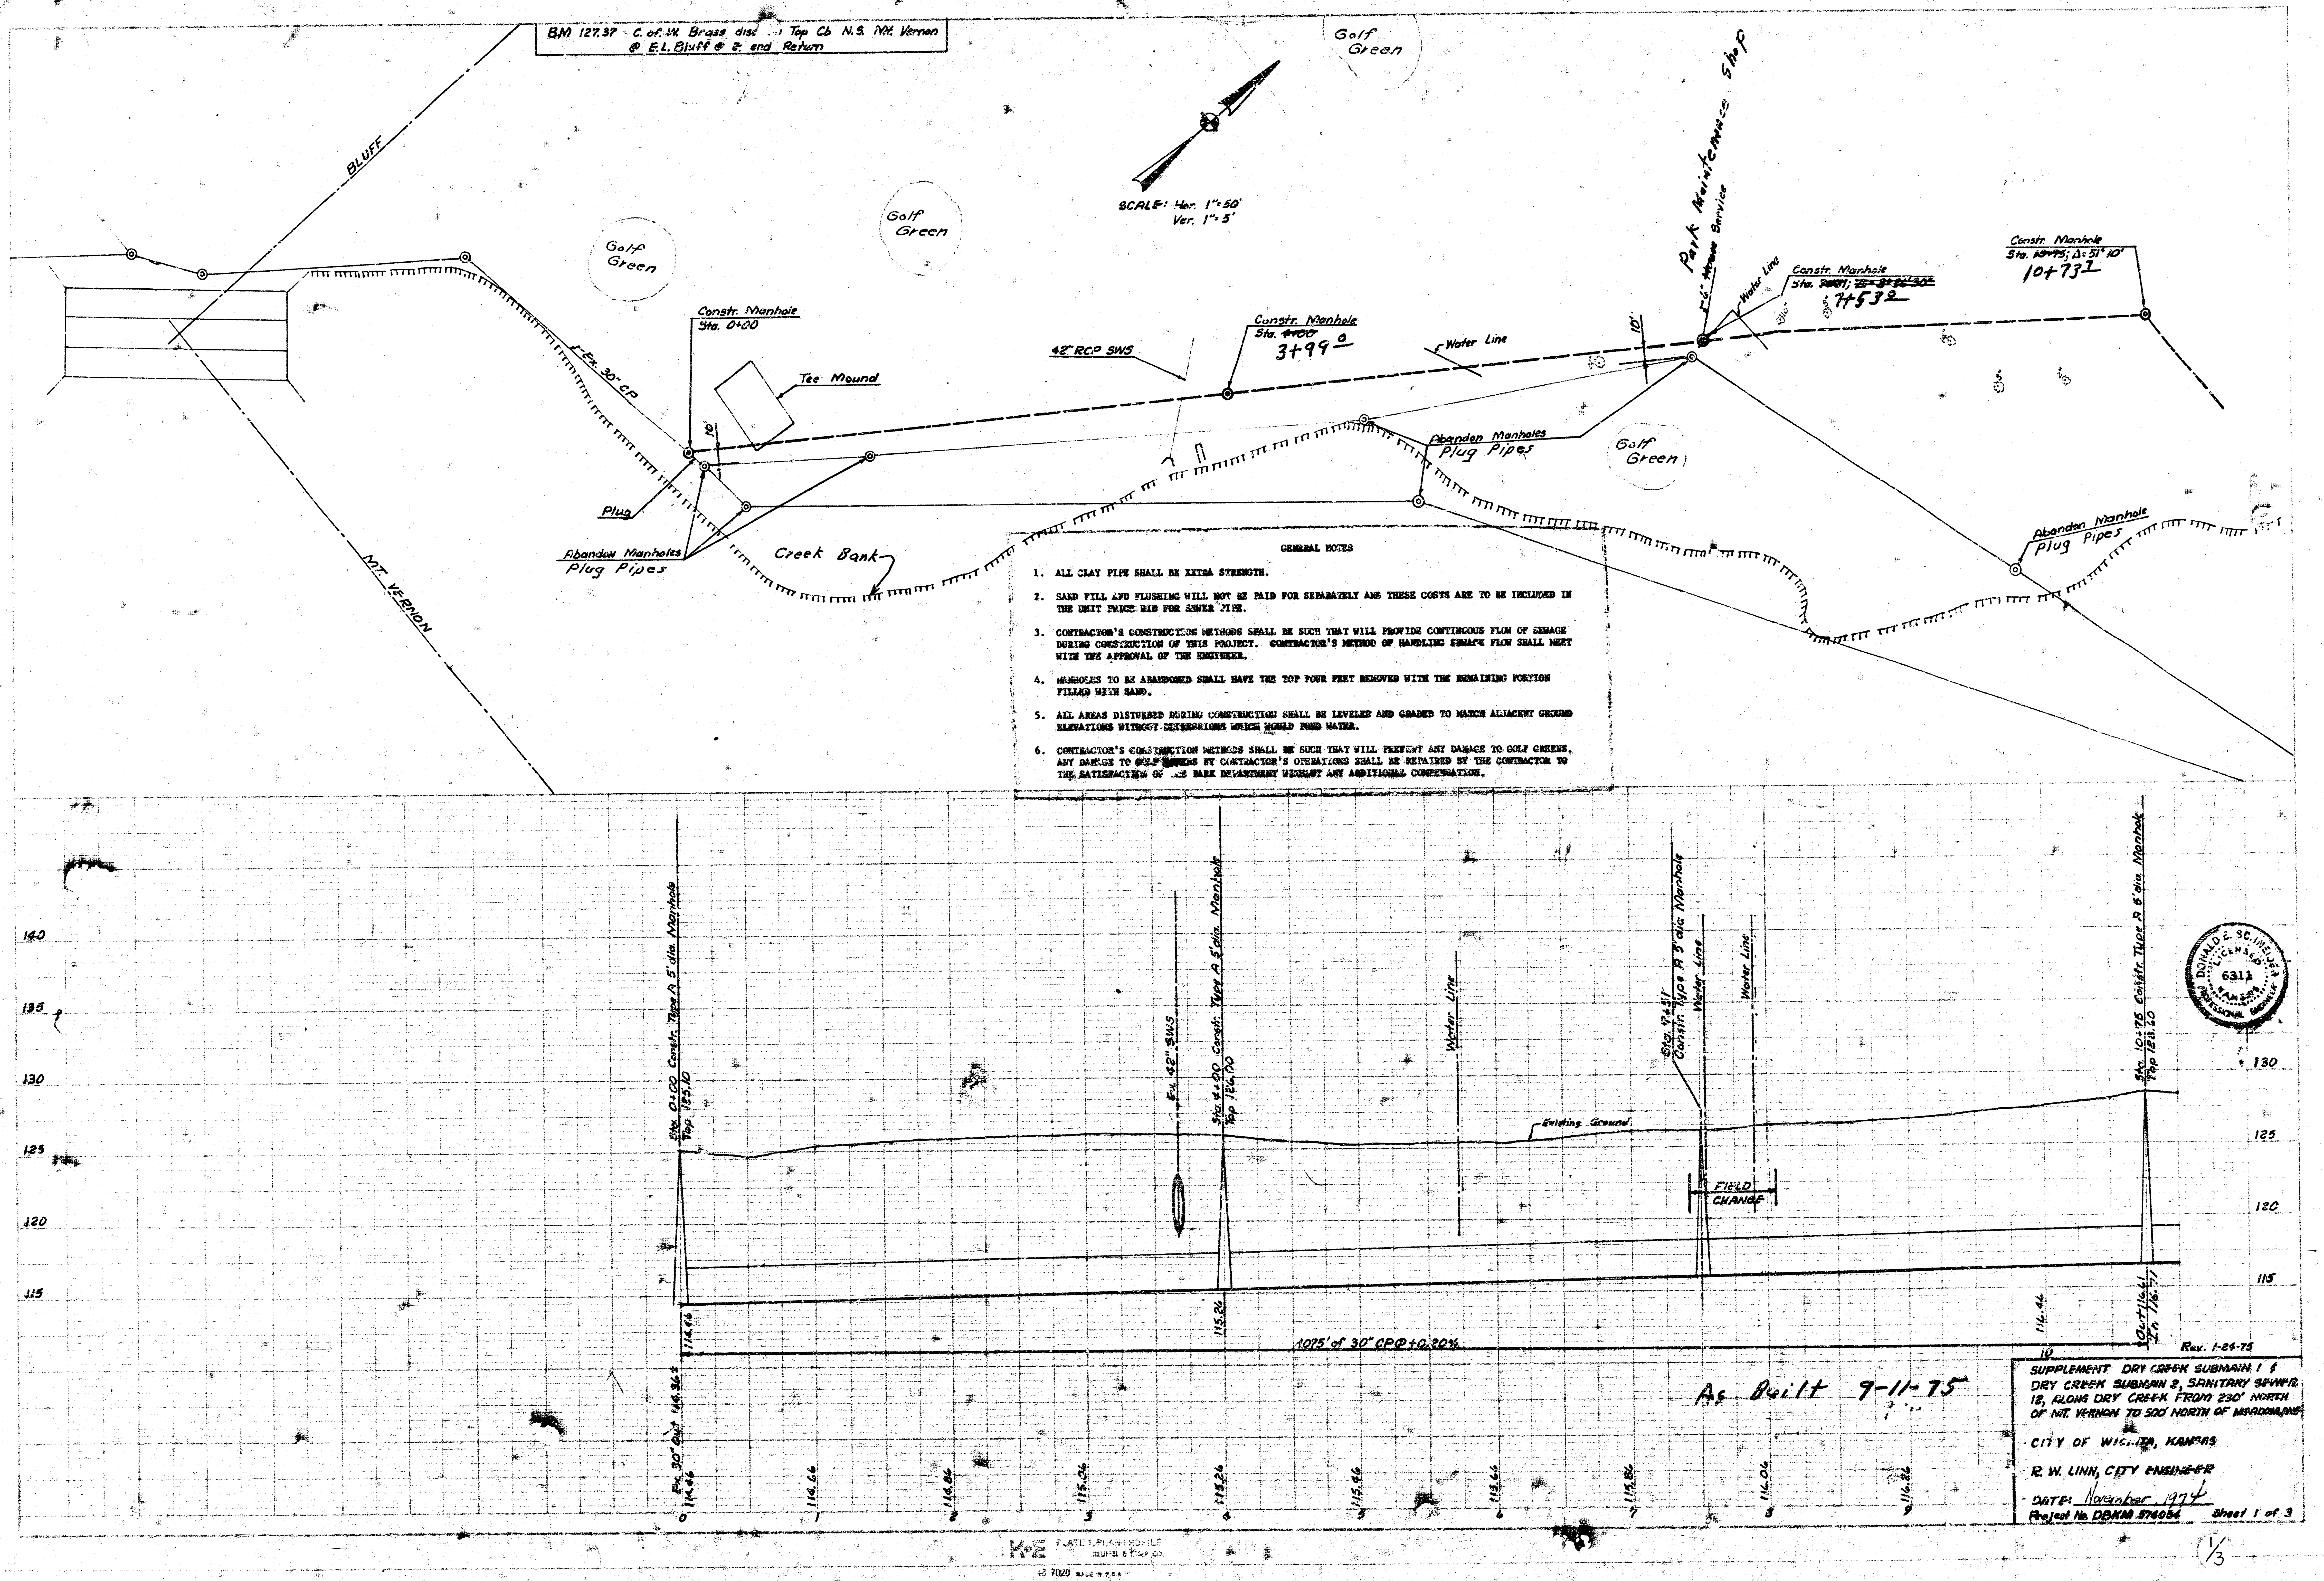

GENERAL NOTES

1. ALL CLAY PIPE SHALL BE EXTRA STRENGTH.
2. SAND FILL AND FLUSHING WILL NOT BE PAID FOR SEPARATELY AND THESE COSTS ARE TO BE INCLUDED IN THE UNIT PRICE BID FOR SEWER PIPE.
3. CONTRACTOR'S CONSTRUCTION METHODS SHALL BE SUCH THAT WILL PROVIDE CONTINUOUS FLOW OF SEWAGE DURING CONSTRUCTION OF THIS PROJECT. CONTRACTOR'S METHOD OF HANDLING SEWAGE FLOW SHALL MEET WITH THE APPROVAL OF THE ENGINEER.
4. MANHOLES TO BE ABANDONED SHALL HAVE THE TOP FOUR FEET REMOVED WITH THE REMAINING PORTION FILLED WITH SAND.
5. ALL AREAS DISTURBED DURING CONSTRUCTION SHALL BE LEVELED AND GRADED TO MATCH ADJACENT GROUND ELEVATIONS WITHOUT DEPRESSIONS WHICH WOULD POND WATER.
6. CONTRACTOR'S CONSTRUCTION METHODS SHALL BE SUCH THAT WILL PREVENT ANY DAMAGE TO GOLF GREENS. ANY DAMAGE TO GOLF GREENS BY CONTRACTOR'S OPERATIONS SHALL BE REPAIRED BY THE CONTRACTOR TO THE SATISFACTION OF THE PARK DEPARTMENT WITHOUT ANY ADDITIONAL COMPENSATION.

As Built 9-11-75

Rev. 1-24-75

SUPPLEMENT DRY CREEK SUBMAIN 1 &
DRY CREEK SUBMAIN 2, SANITARY SEWER
12, ALONG DRY CREEK FROM 230' NORTH
OF MT. VERNON TO 500' NORTH OF MEADOWLANE

CITY OF WICHITA, KANSAS

R. W. LINN, CITY ENGINEER

DATE: November, 1974
Project No. DBKM 574054 Sheet 1 of 3

1/3

K+E PLATE 1, PLAN-PROFILE KEUFFEL & ESSER CO.
46 7020 MADE IN U.S.A.

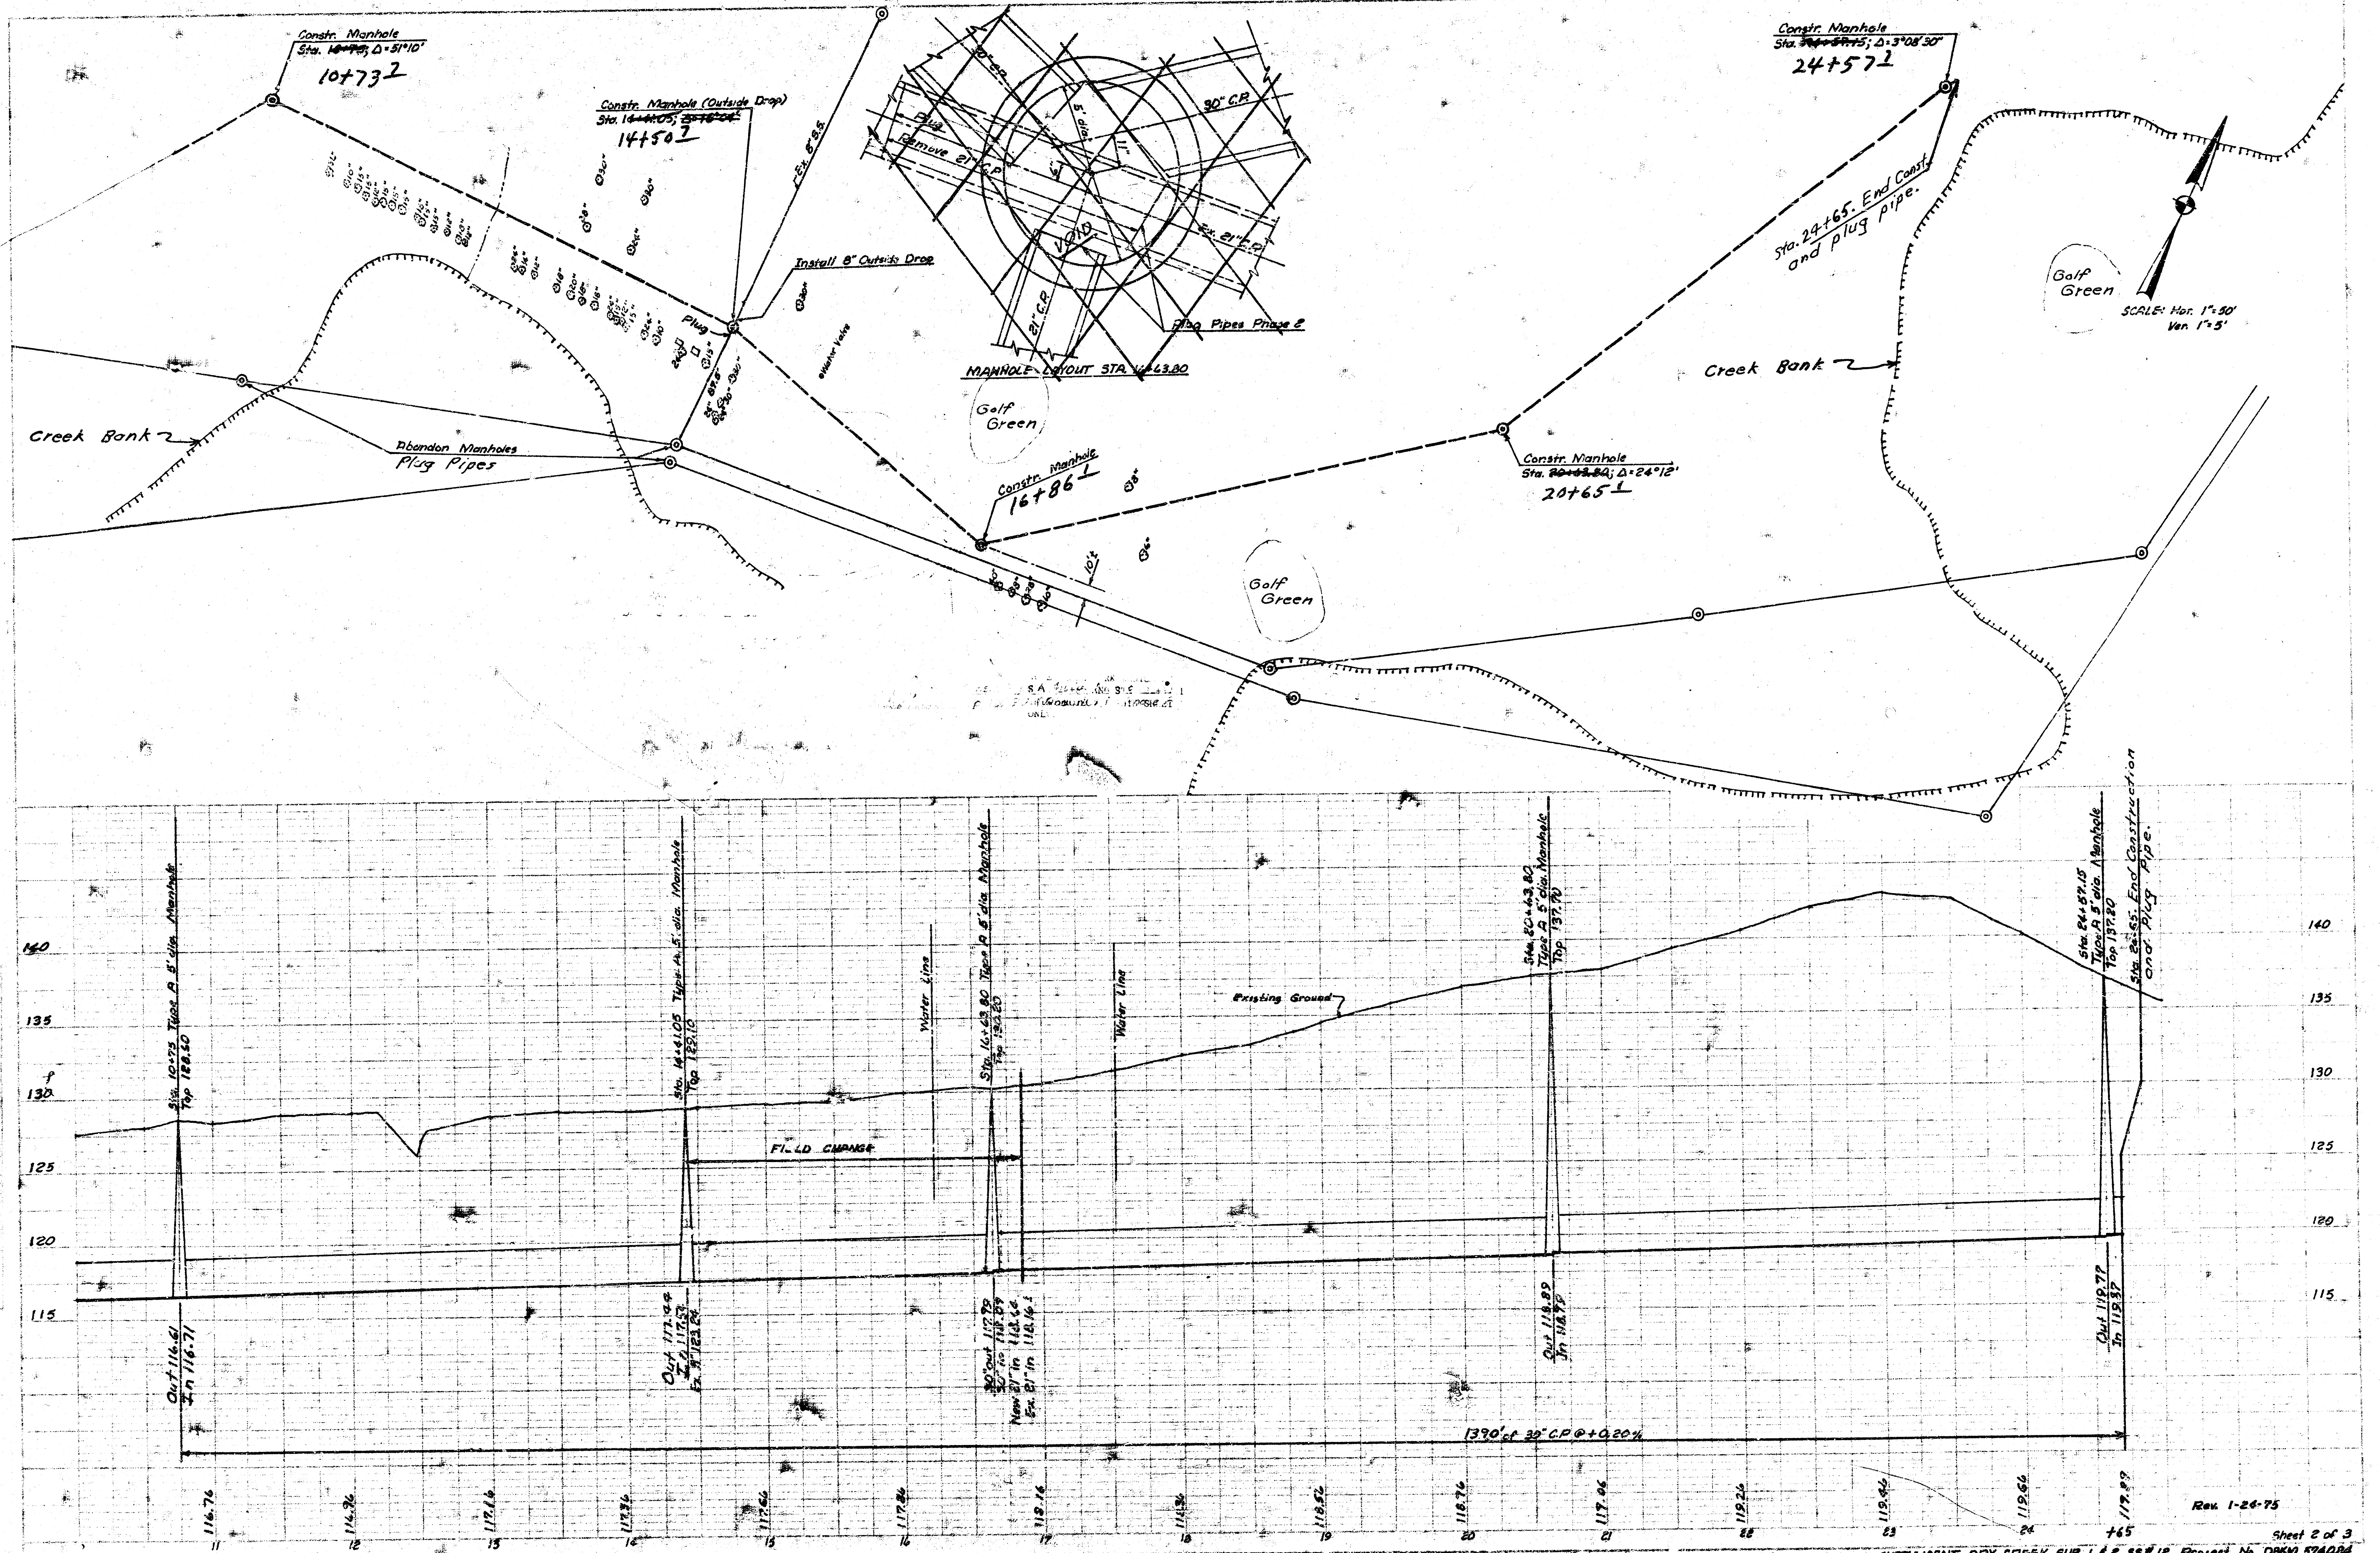

Sheet 2 of 3

SUPPLEMENT DRY CREEK SUB. 1 & 2, SS# 12, Project No. DBKN 574084

2/3

FILMED FROM THE BEST

1

DCD 115

B.M. 142.433 City Std. on W. and Hbgd. to RCB approx.
150' E. of Oliver on Harry

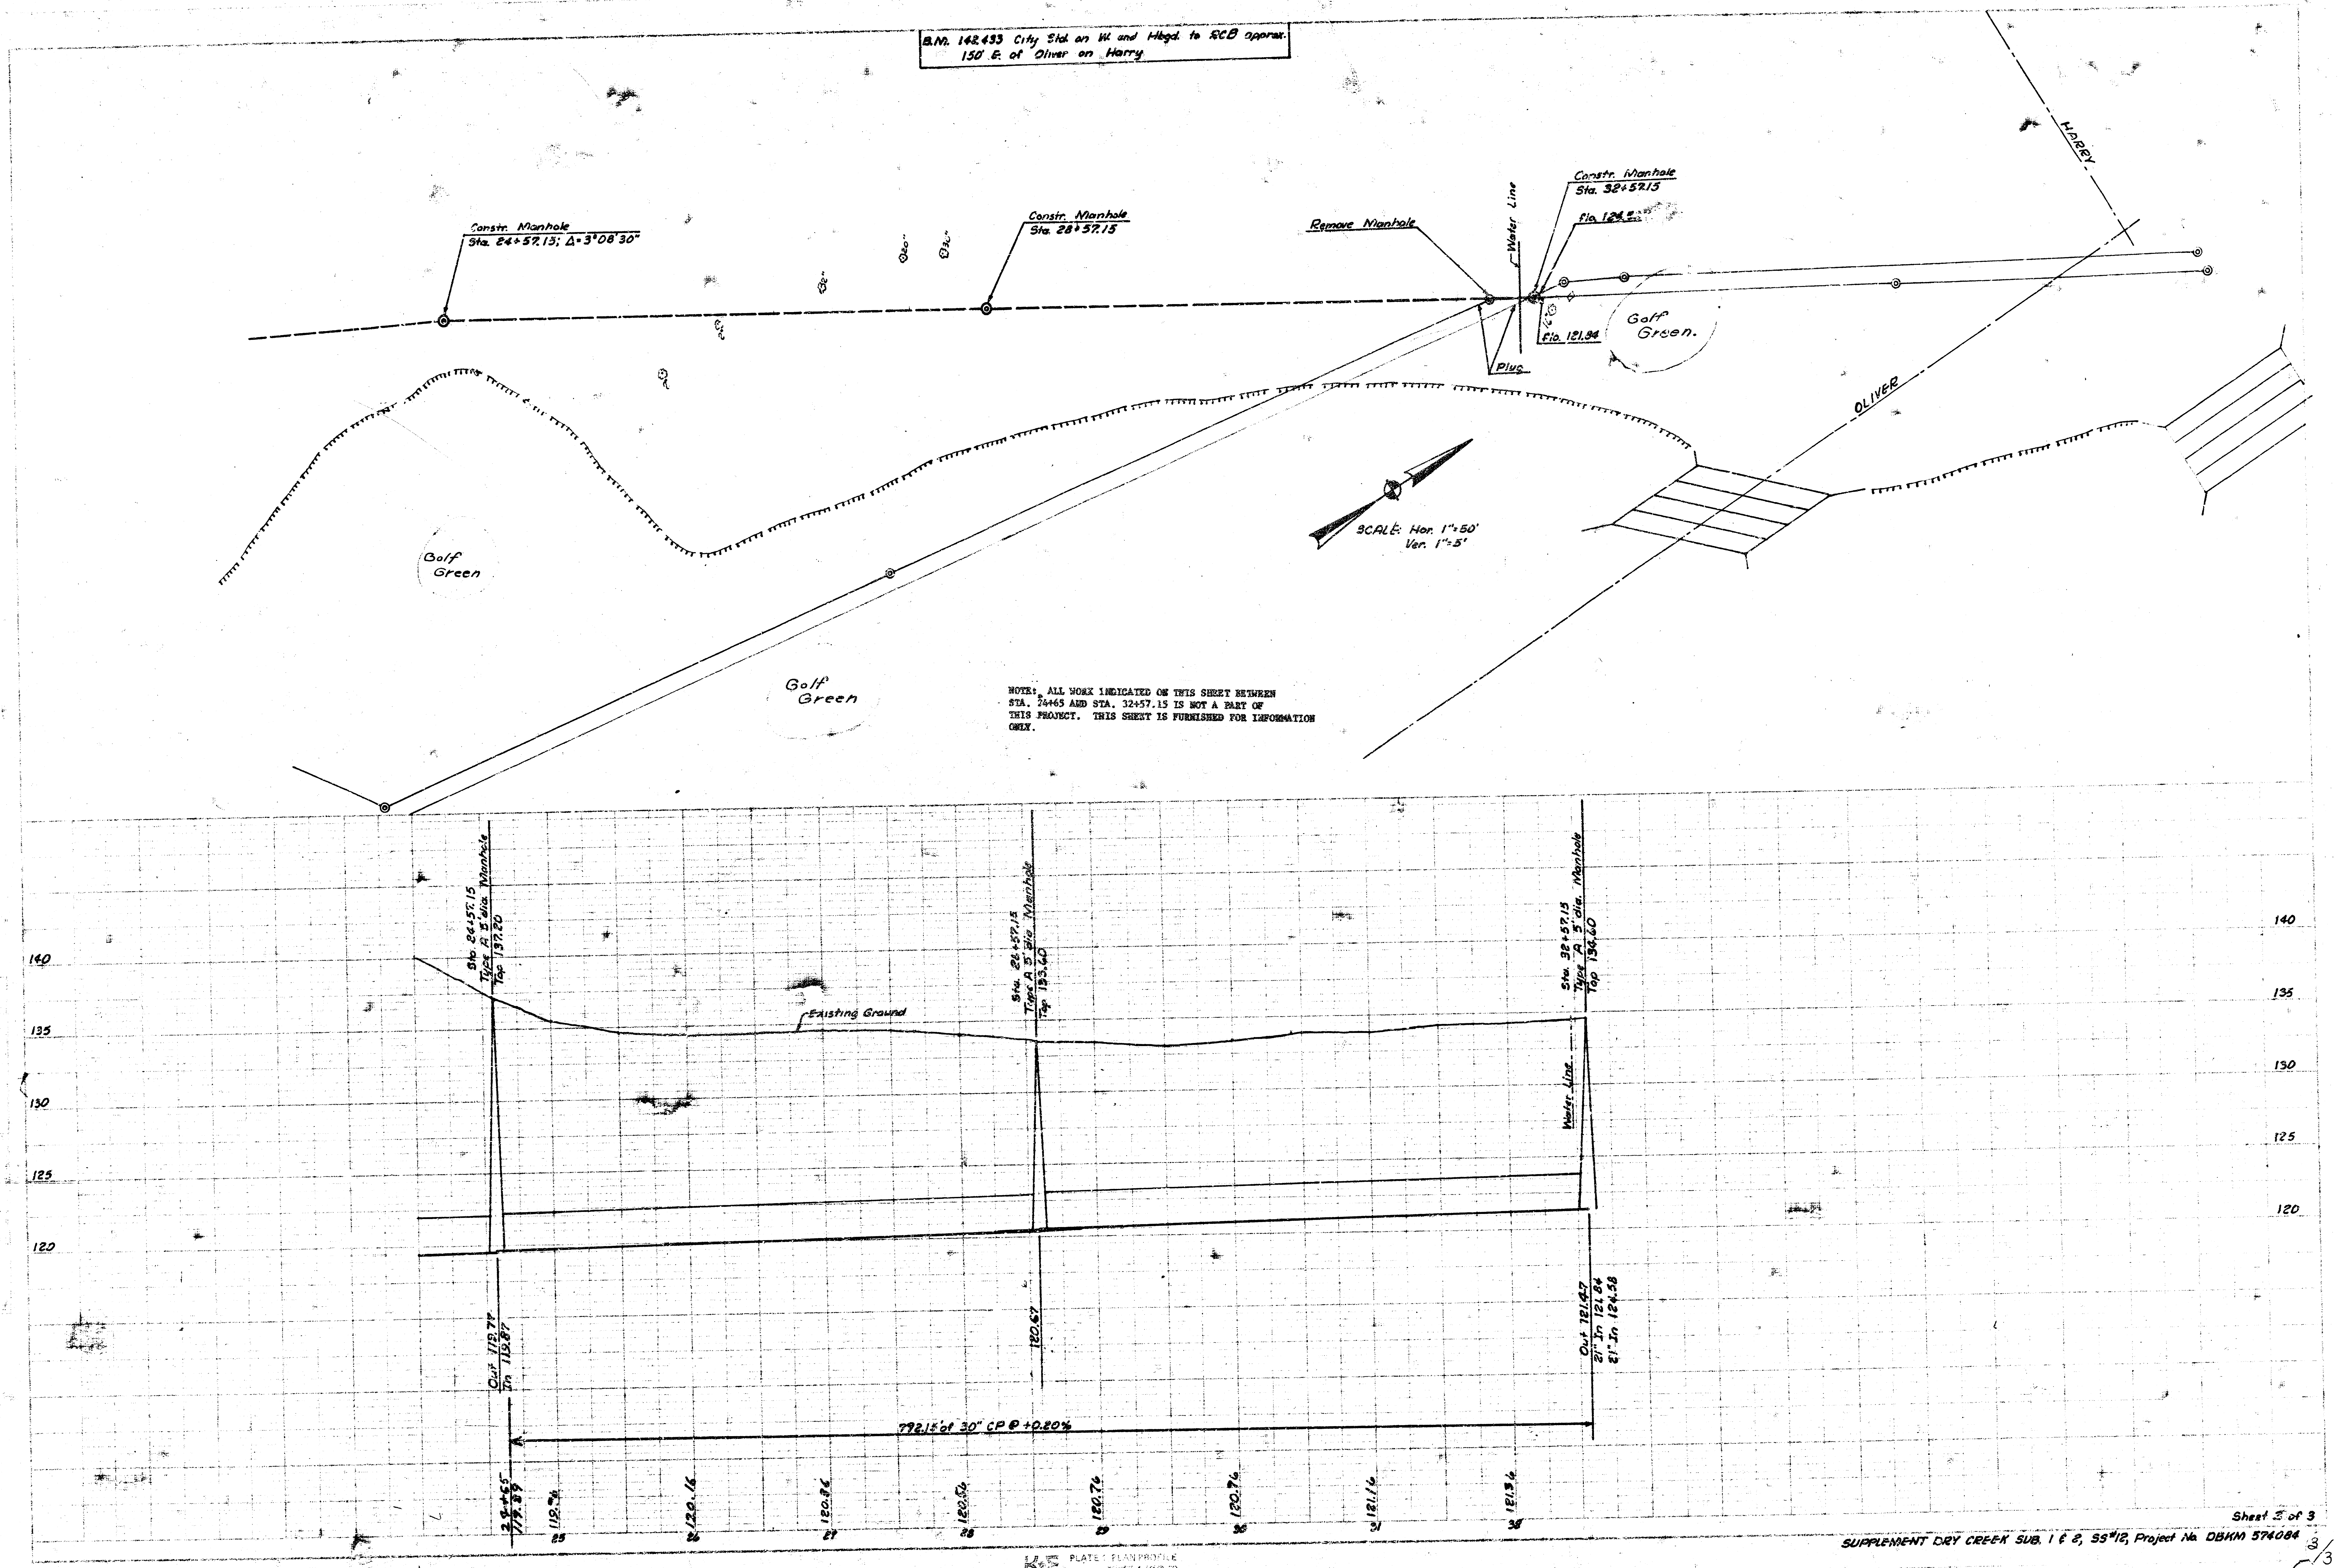

NOTE: ALL WORK INDICATED ON THIS SHEET BETWEEN STA. 24+65 AND STA. 32+57.15 IS NOT A PART OF THIS PROJECT. THIS SHEET IS FURNISHED FOR INFORMATION ONLY.

Sheet 3 of 3

SUPPLEMENT DRY CREEK SUB. 1 & 2, SS#12, Project No. DBKM 574084

K+E PLATE PLAN PROFILE KEUFFEL & ESSER CO.
48 1020 MADE IN U.S.A.

3/3

14 7 5 (15)

FILMED FROM THE BEST
AVAILABLE COPY