

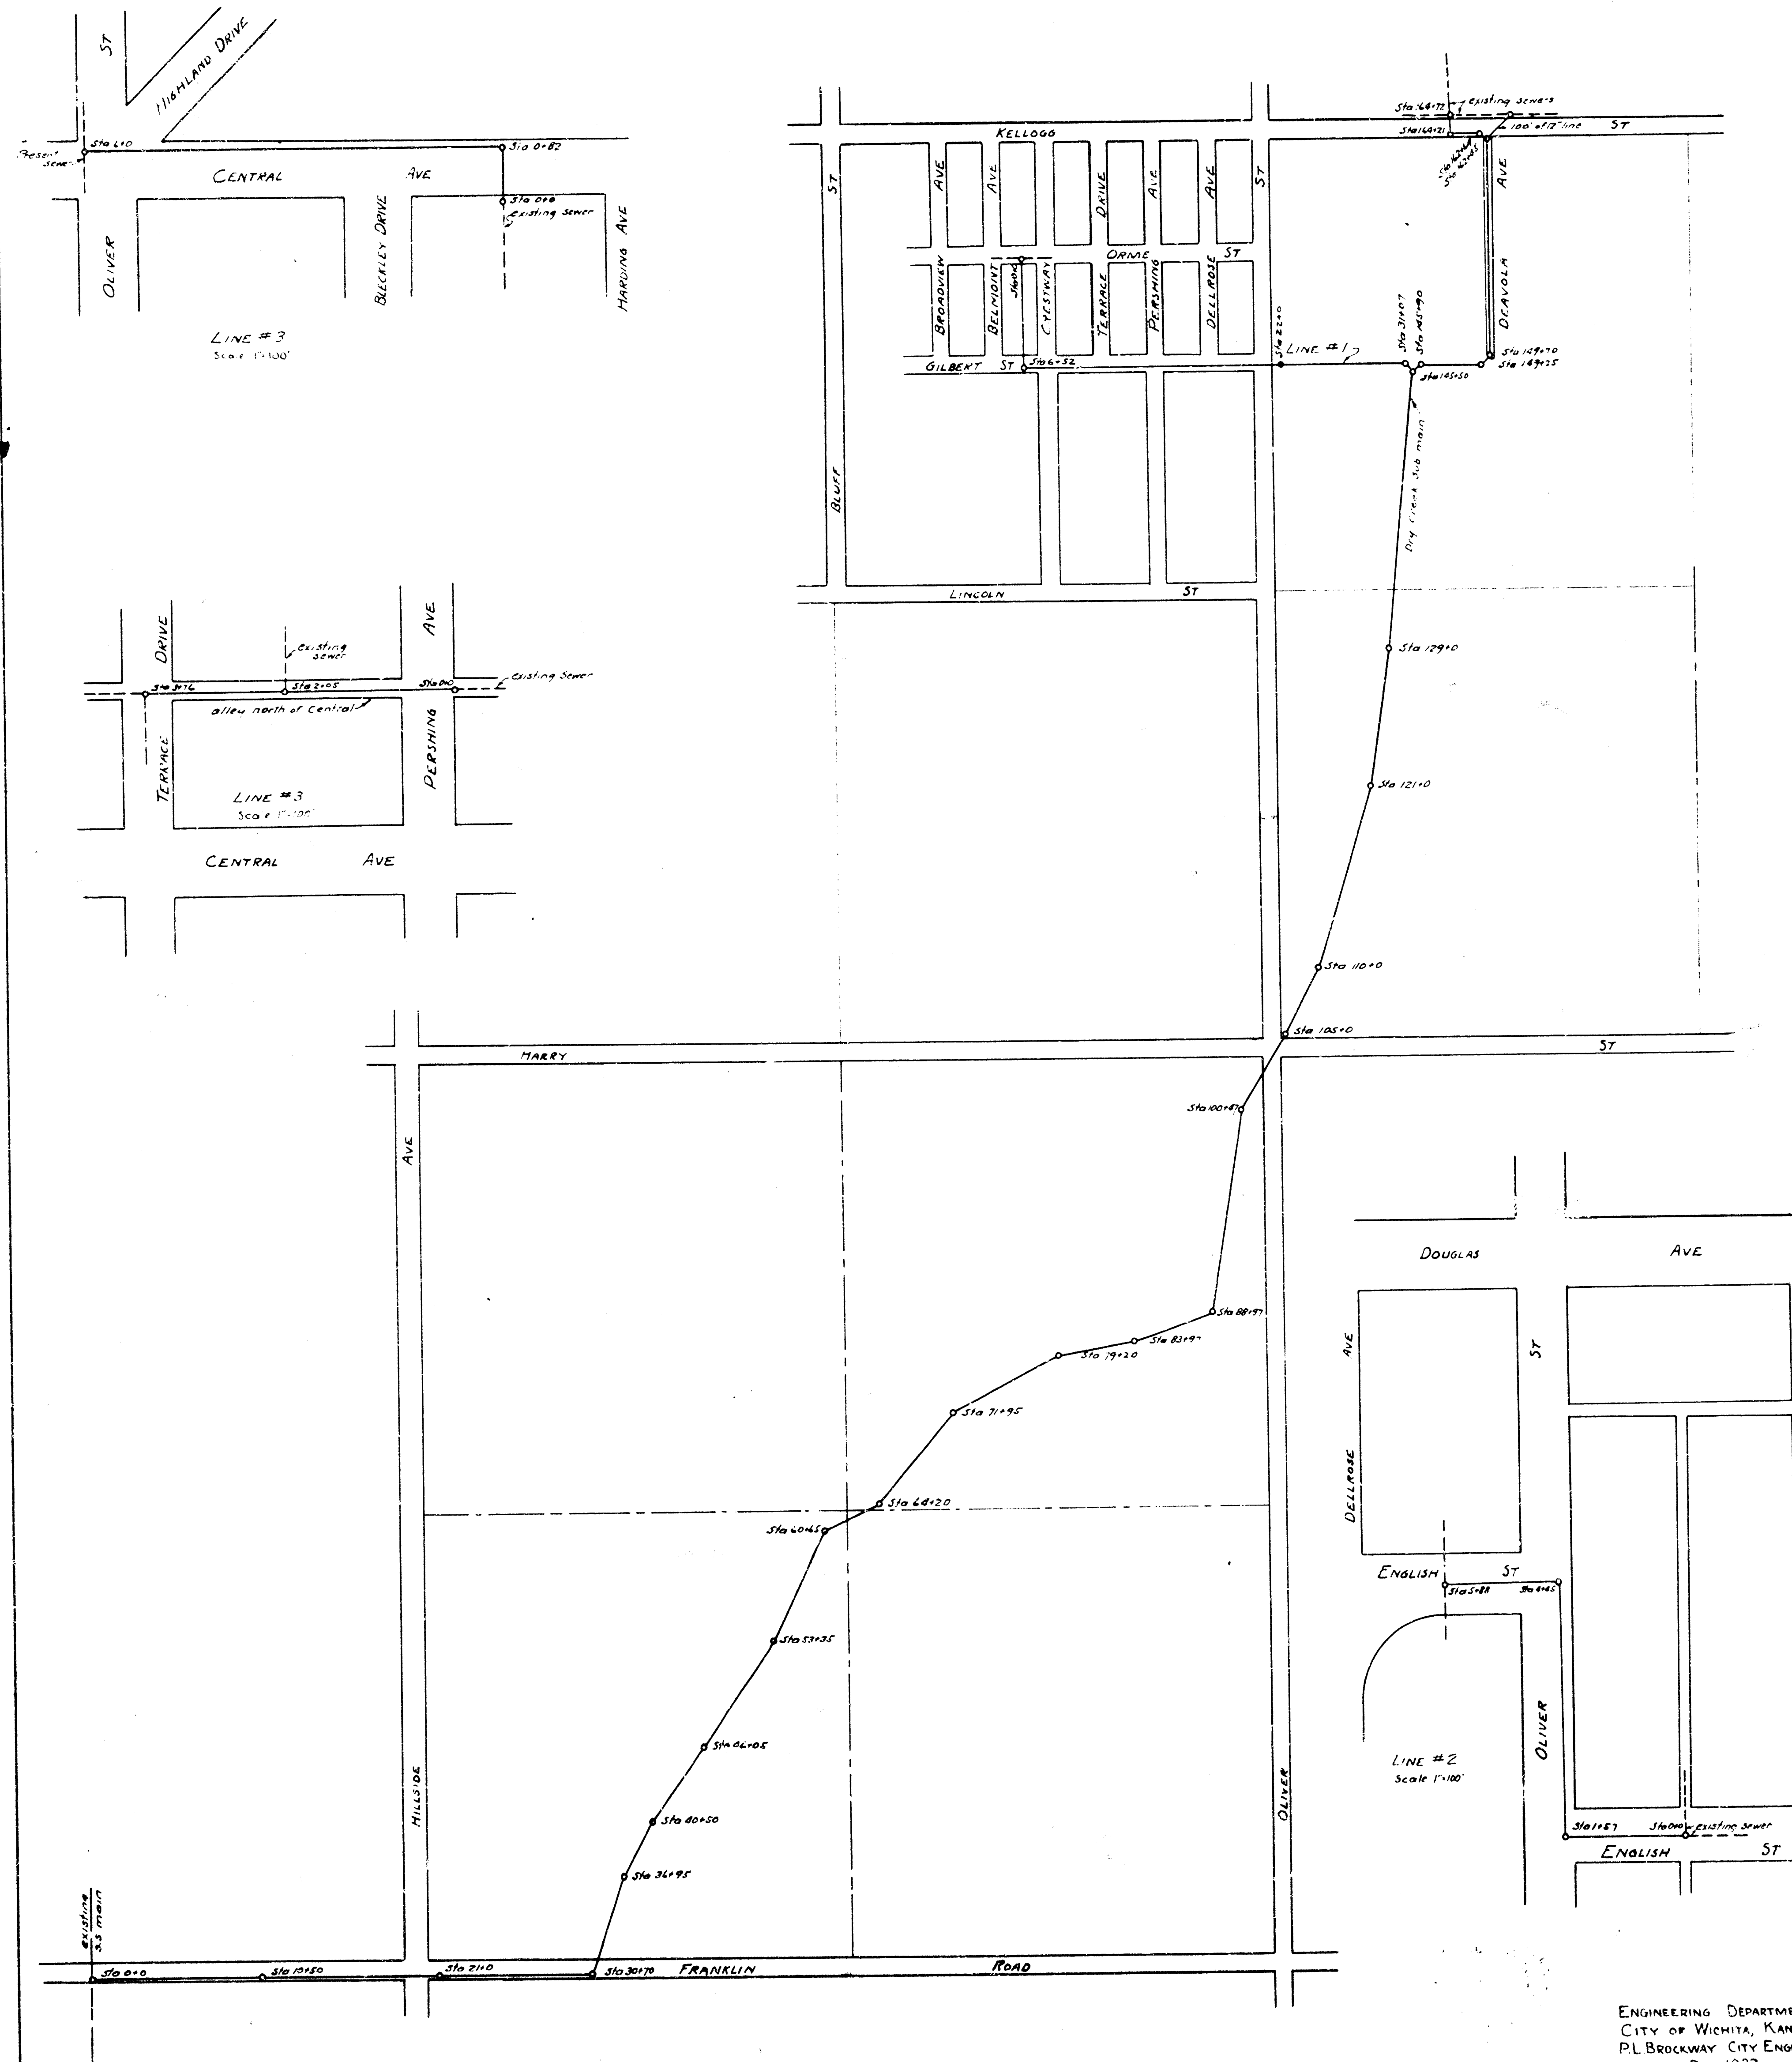
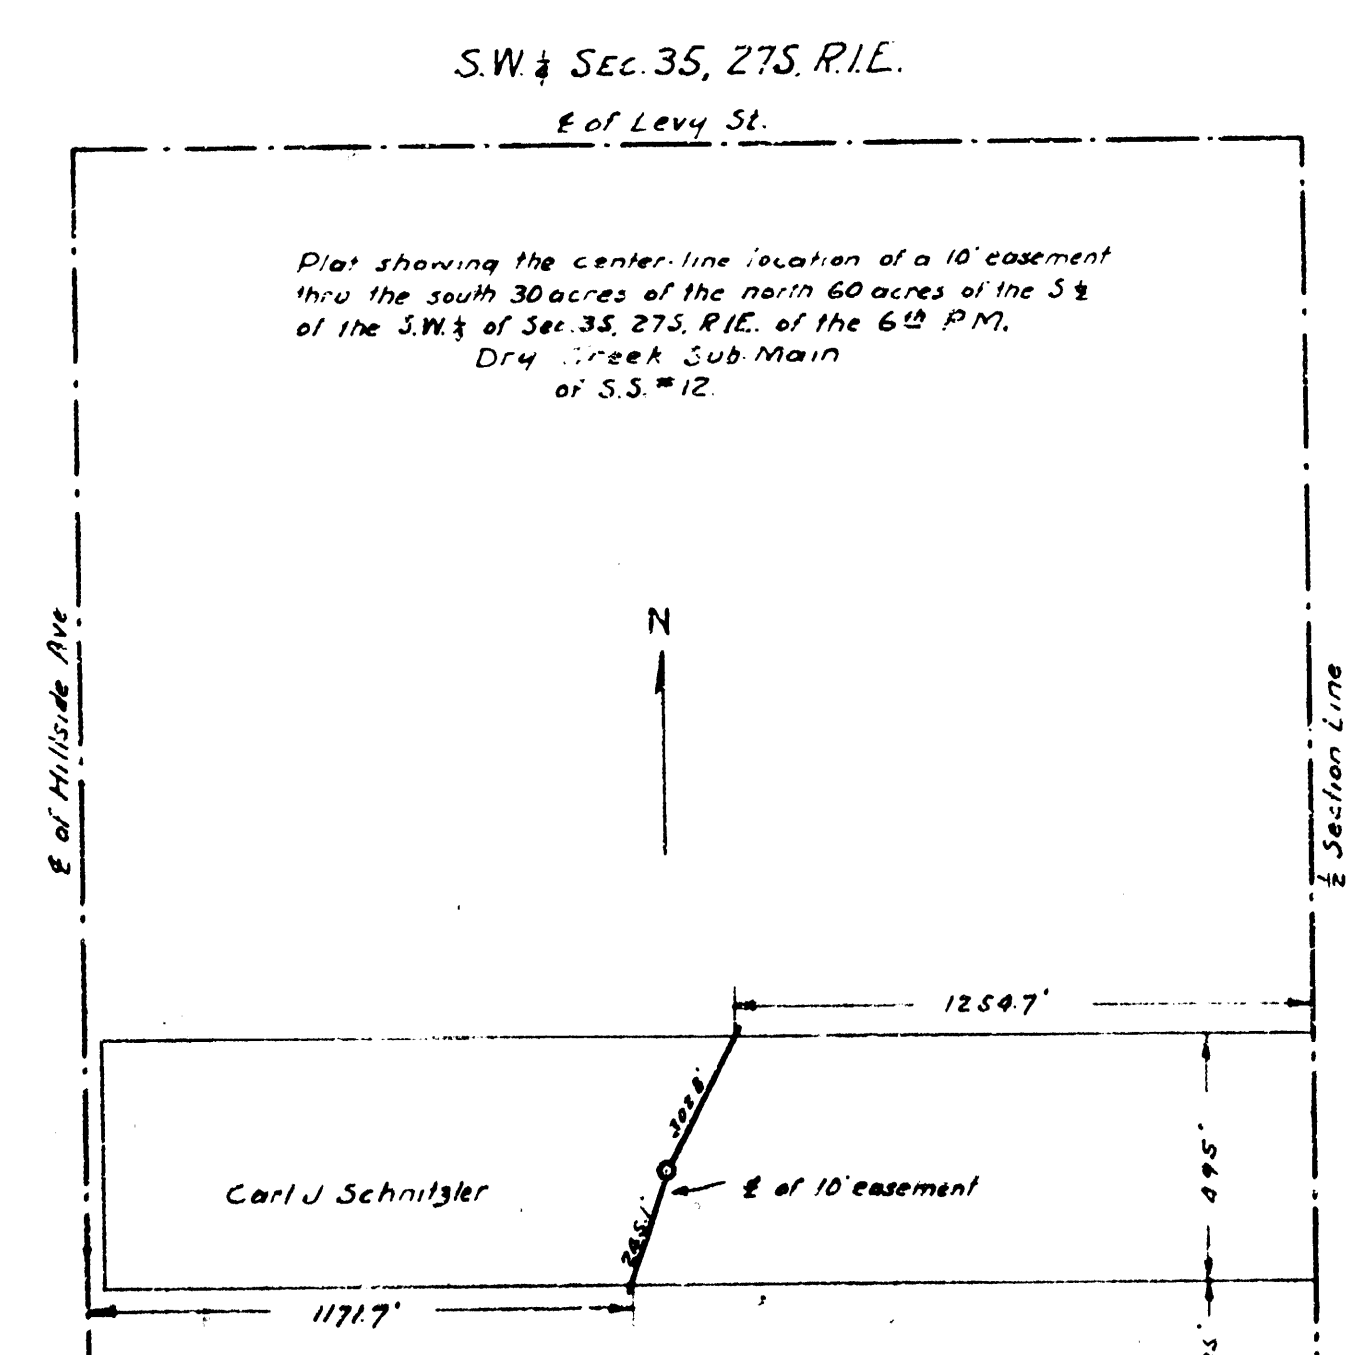
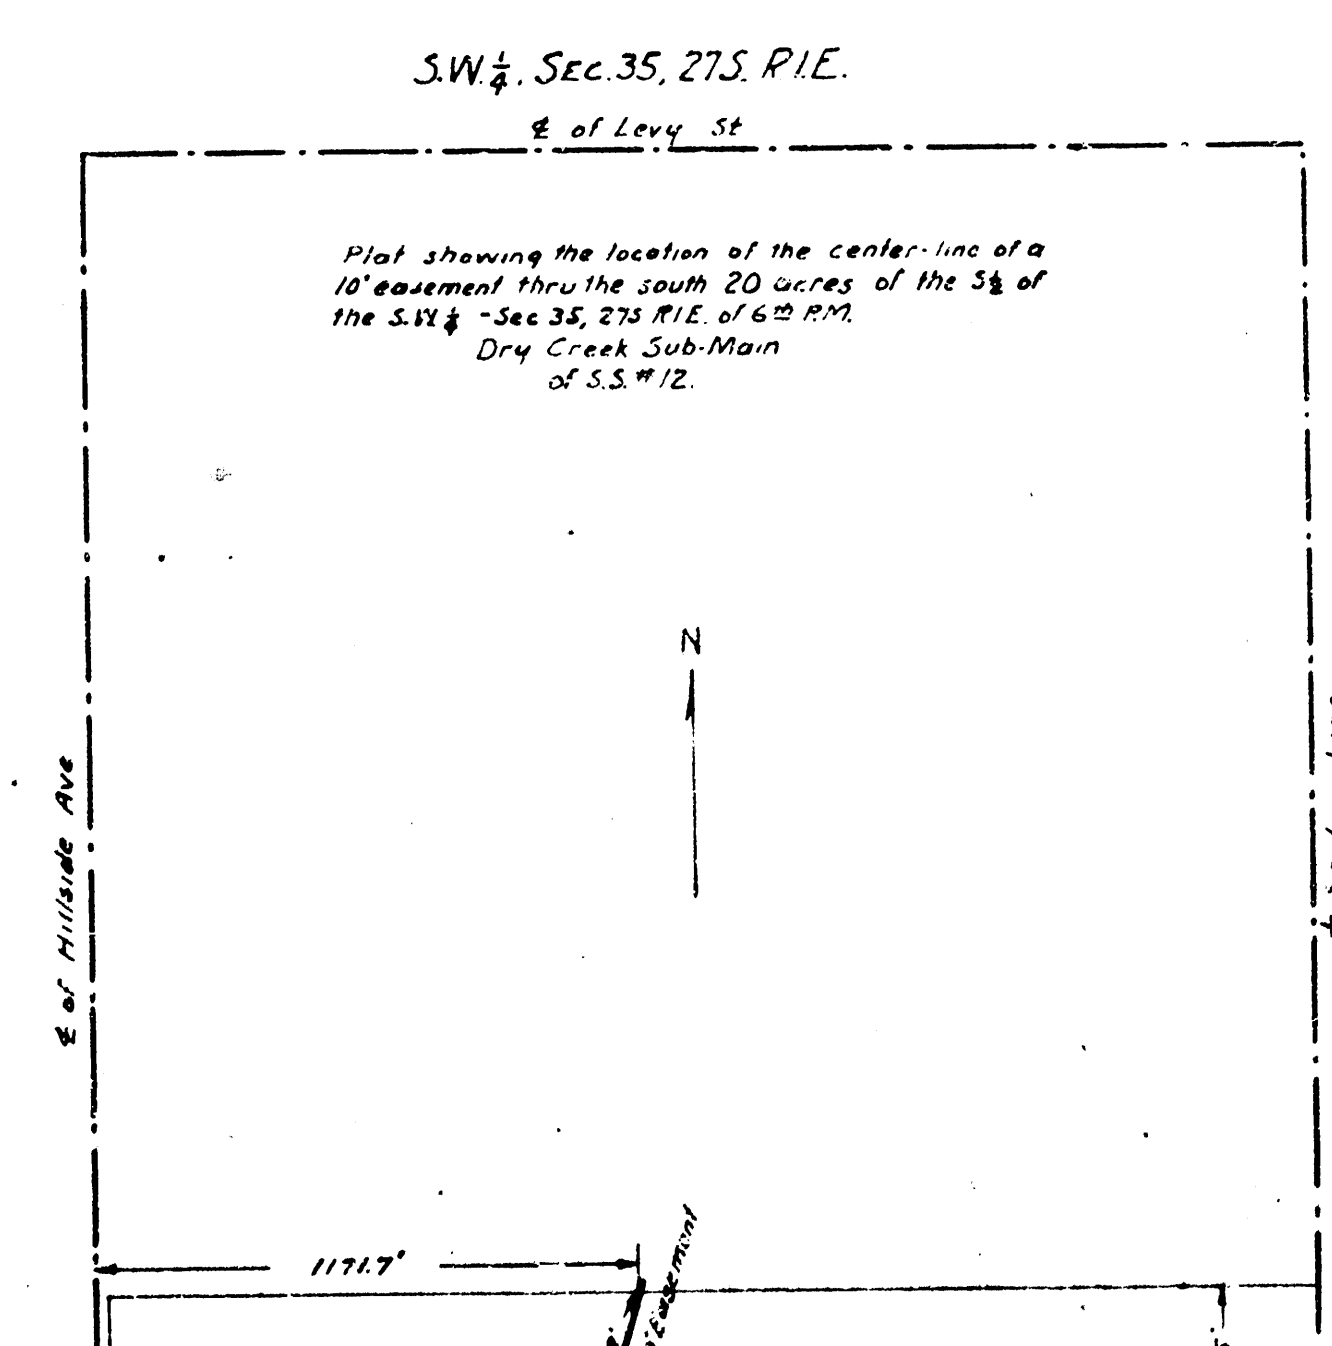
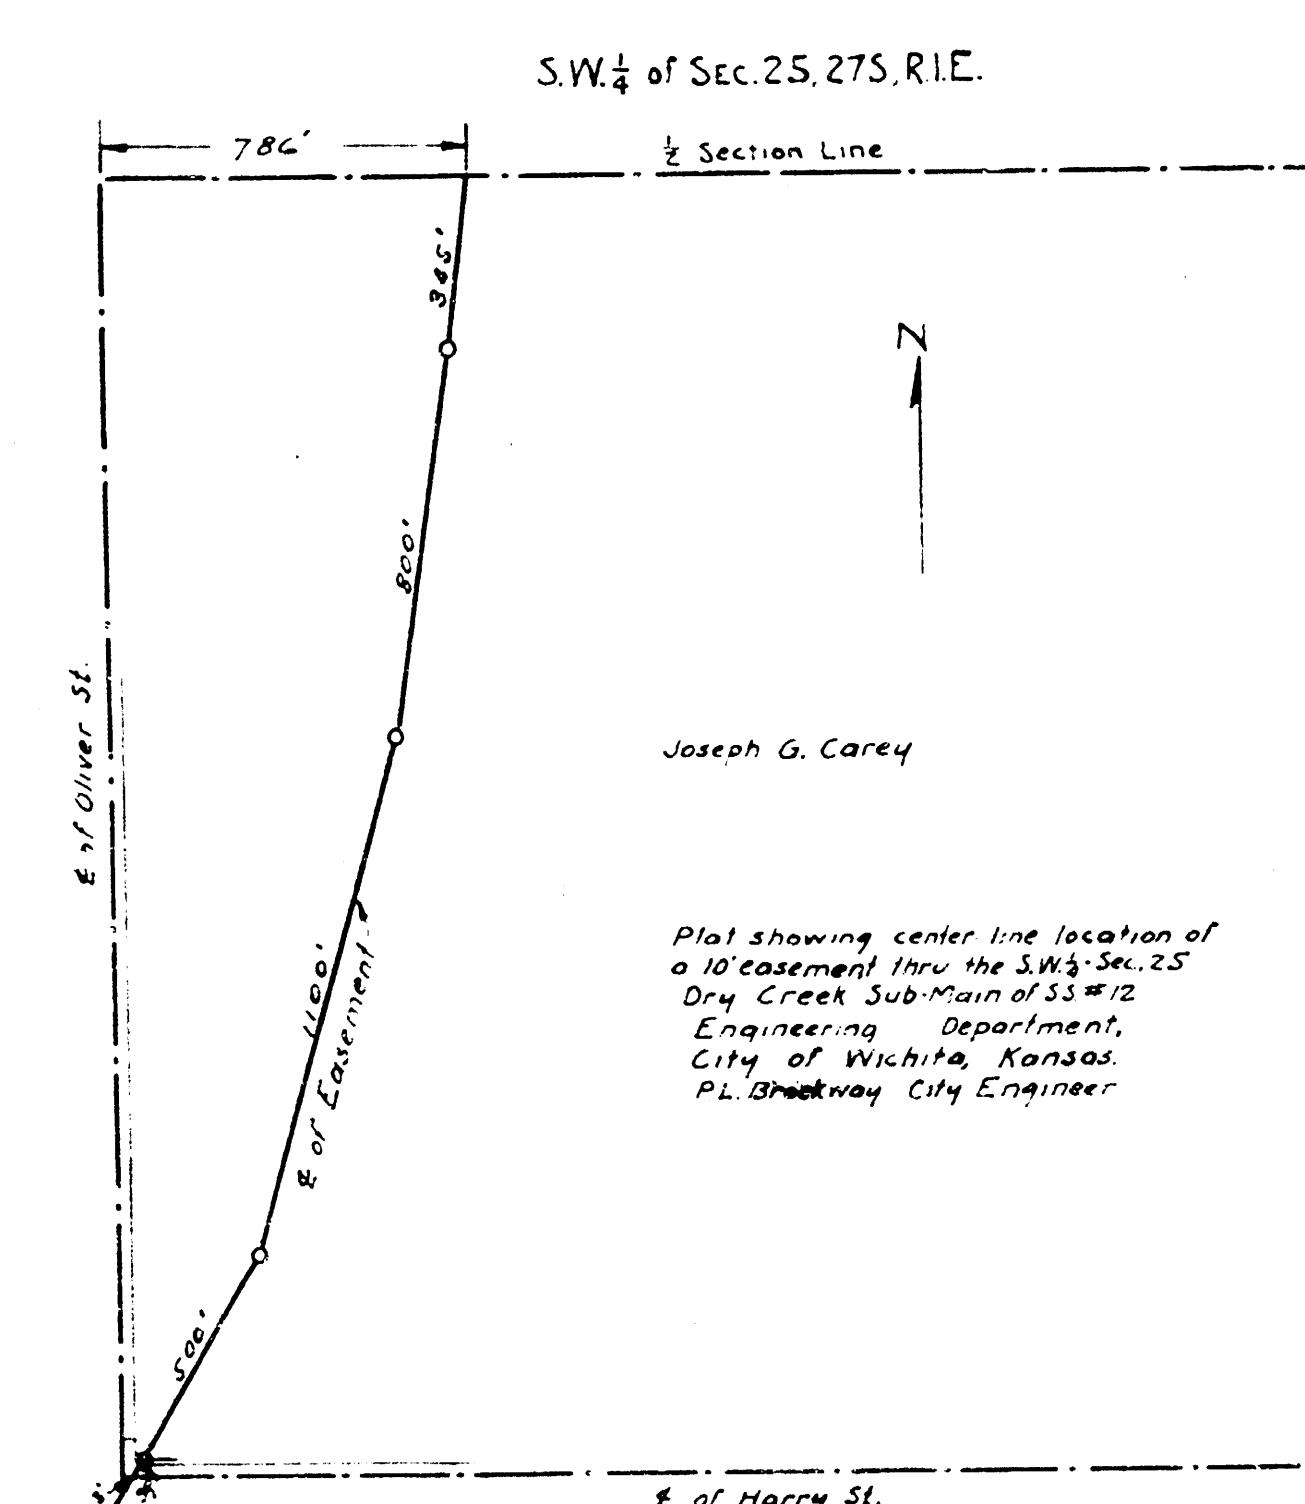
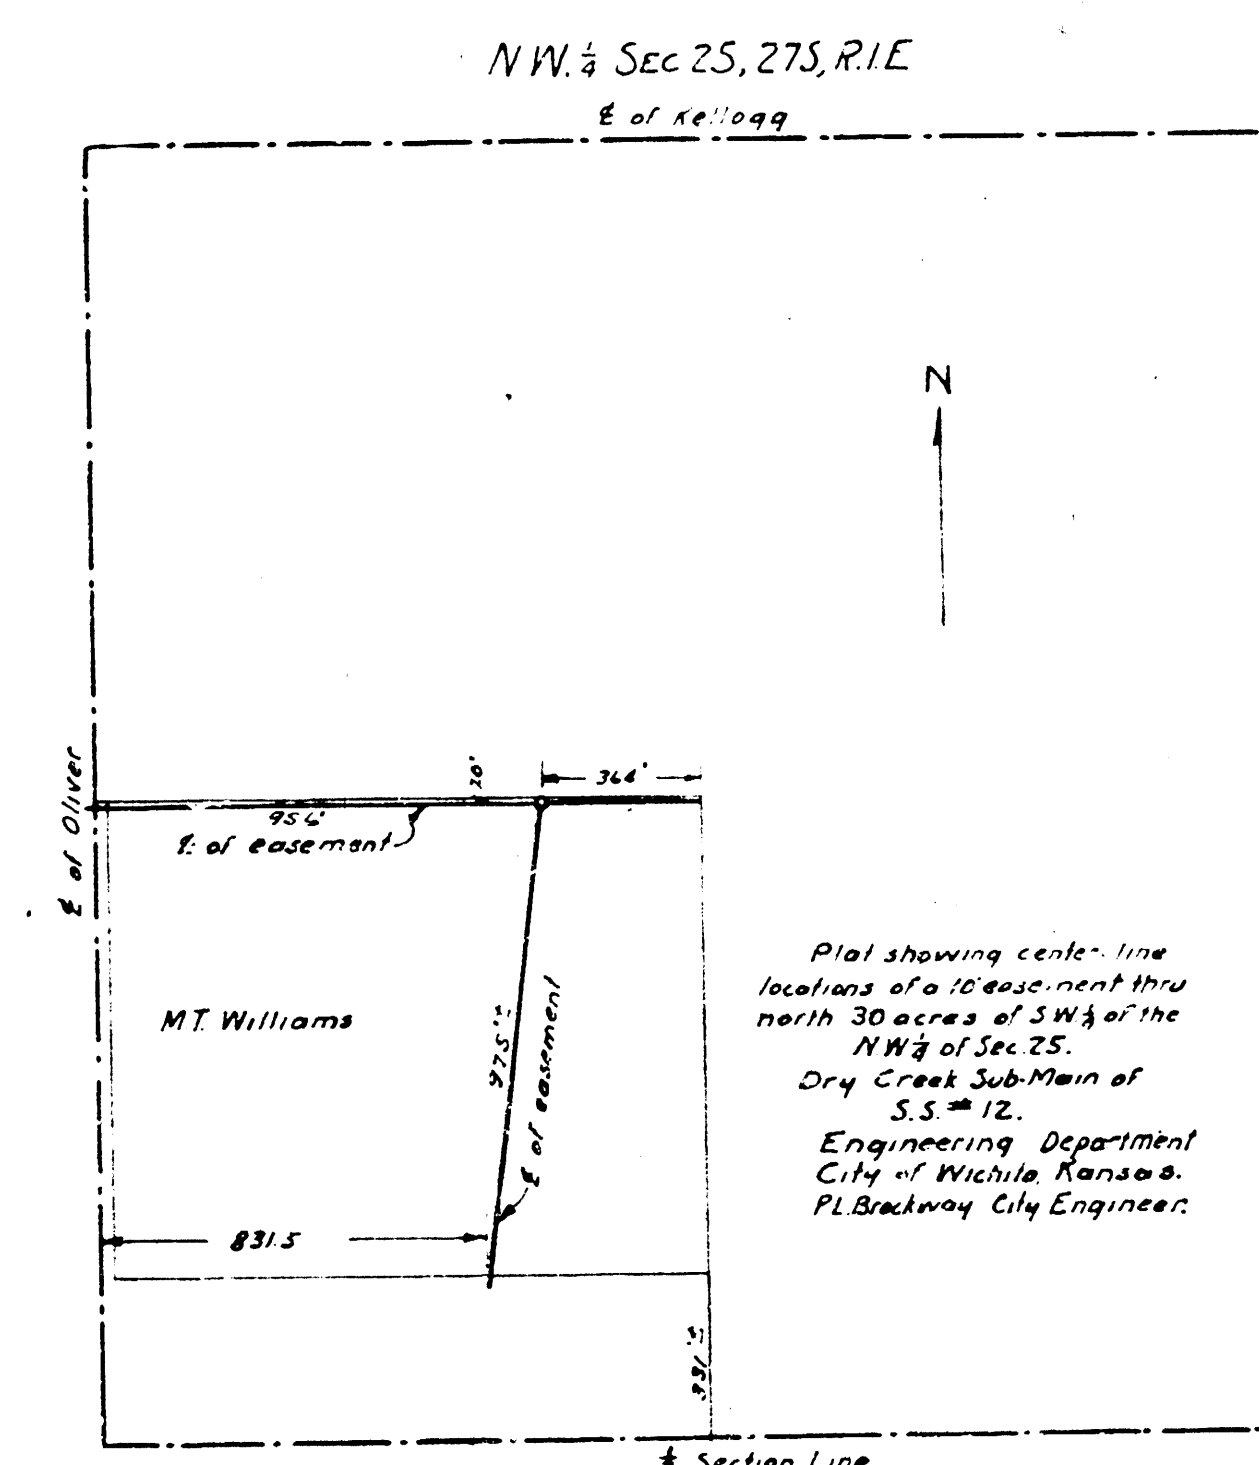



PLAT SHOWING LOCATION OF DRY CREEK SUB-MAIN TO S.S.NO.12. AND THE INTERCEPTING LINES.

SHEET #1 4 SHEETS.

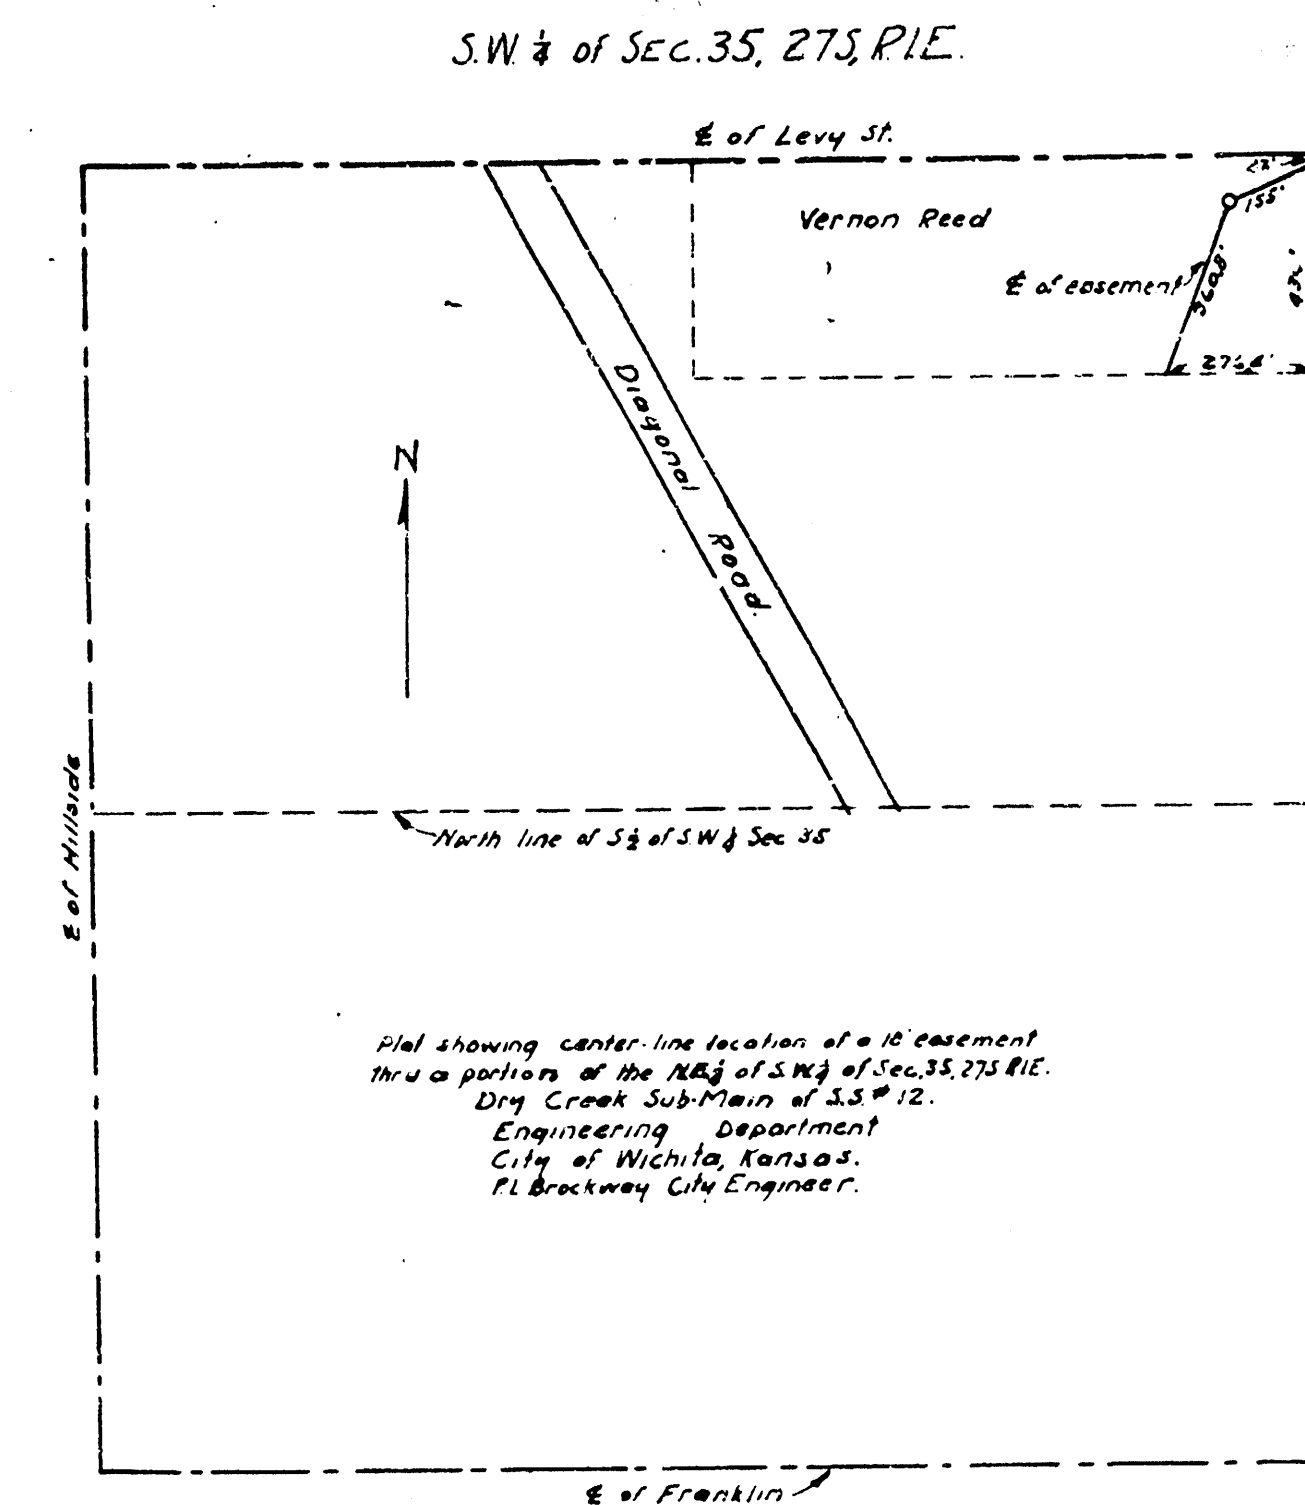


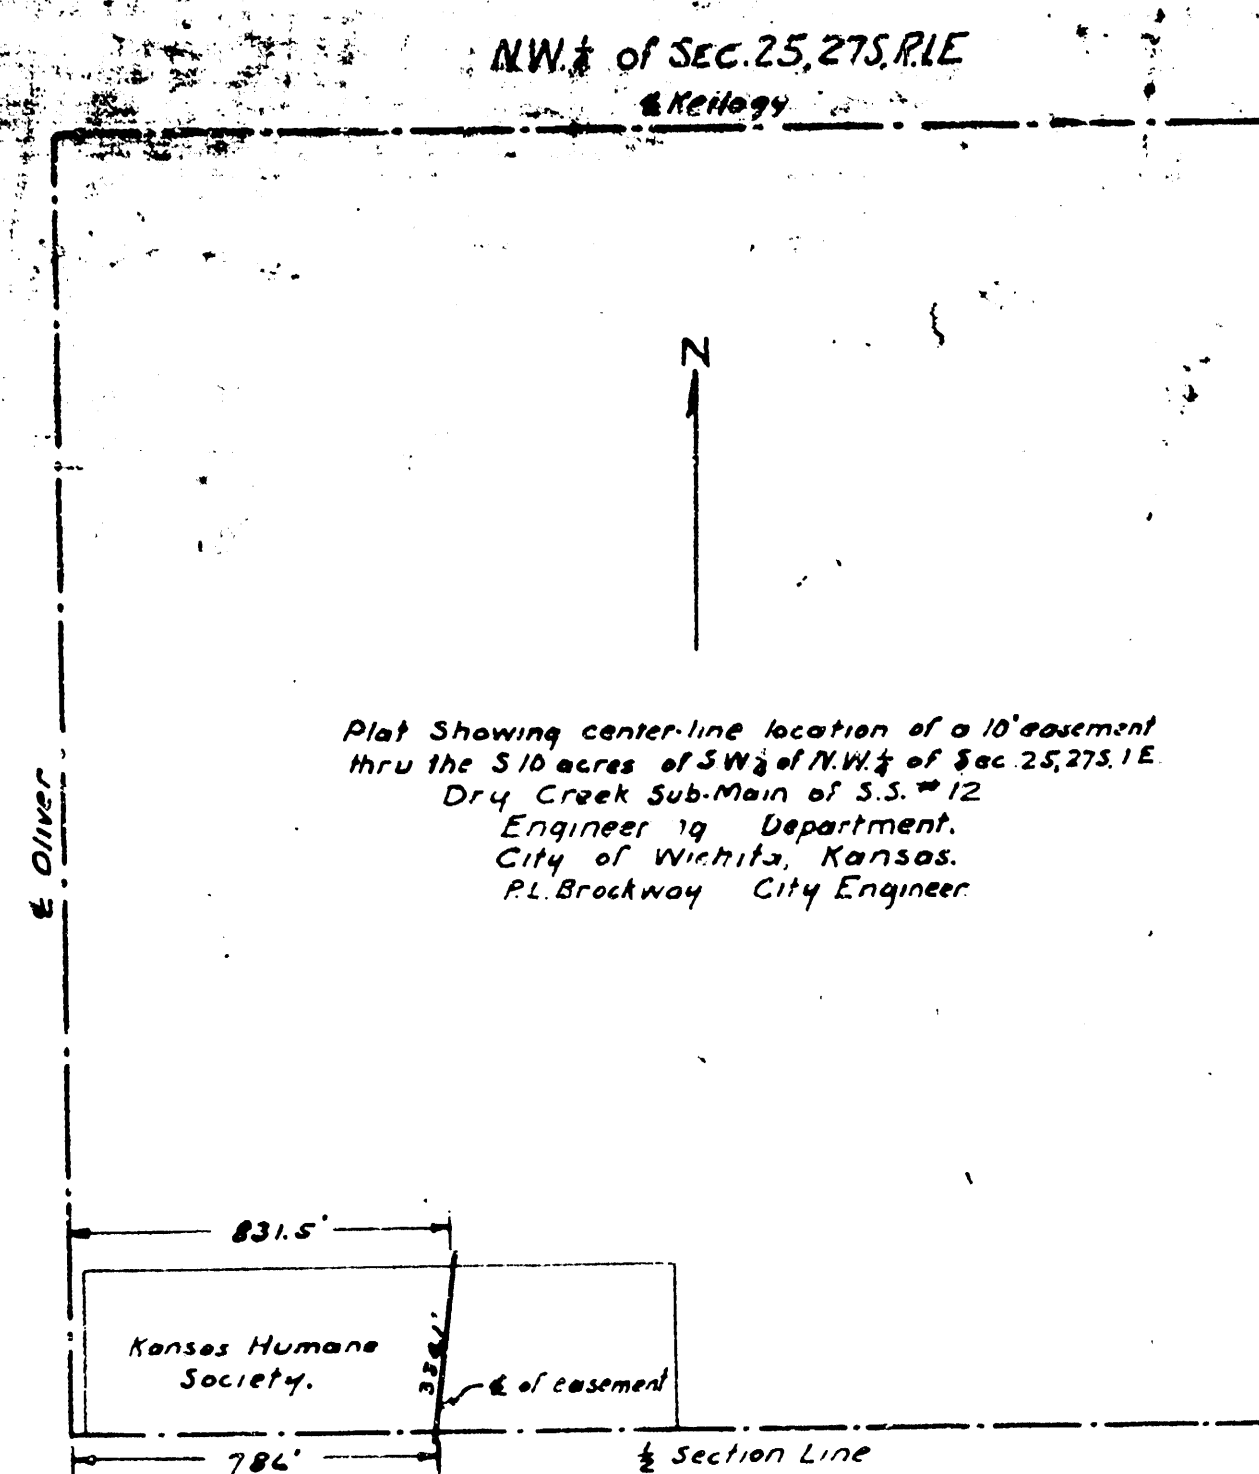


SW 1/4 Sec. 35, 27S, R1E.

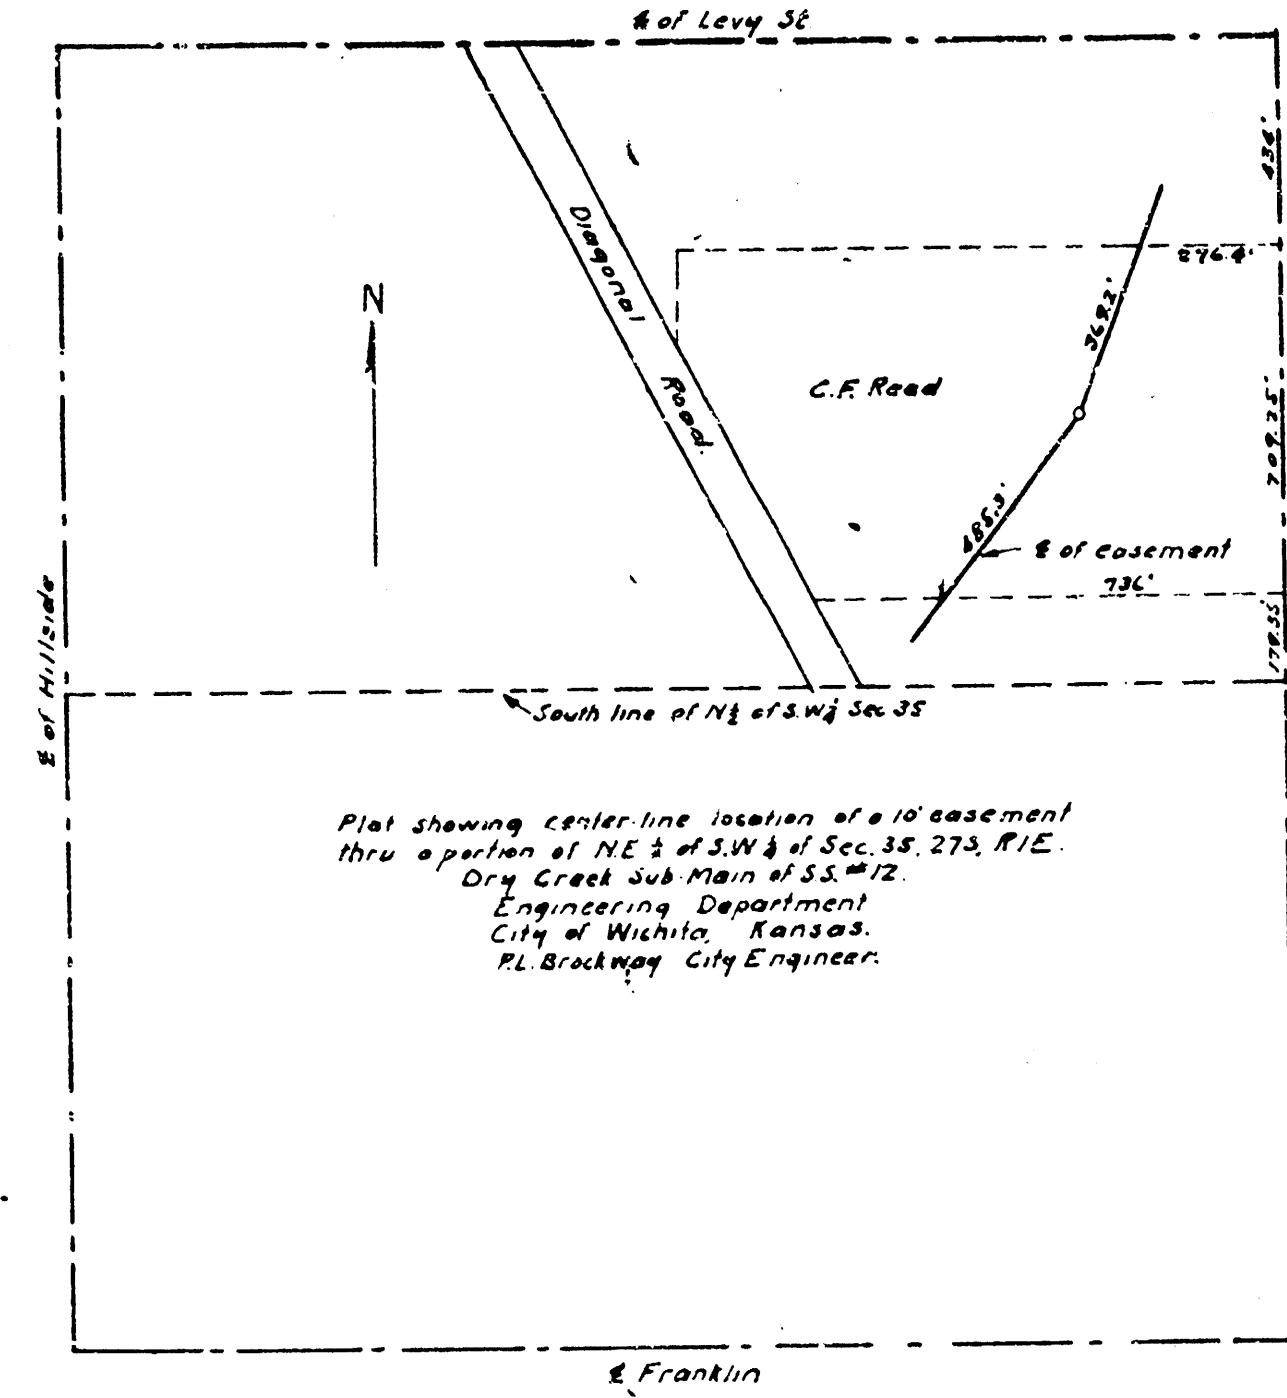


SW 1/4 Sec. 35, 27S, R1E.

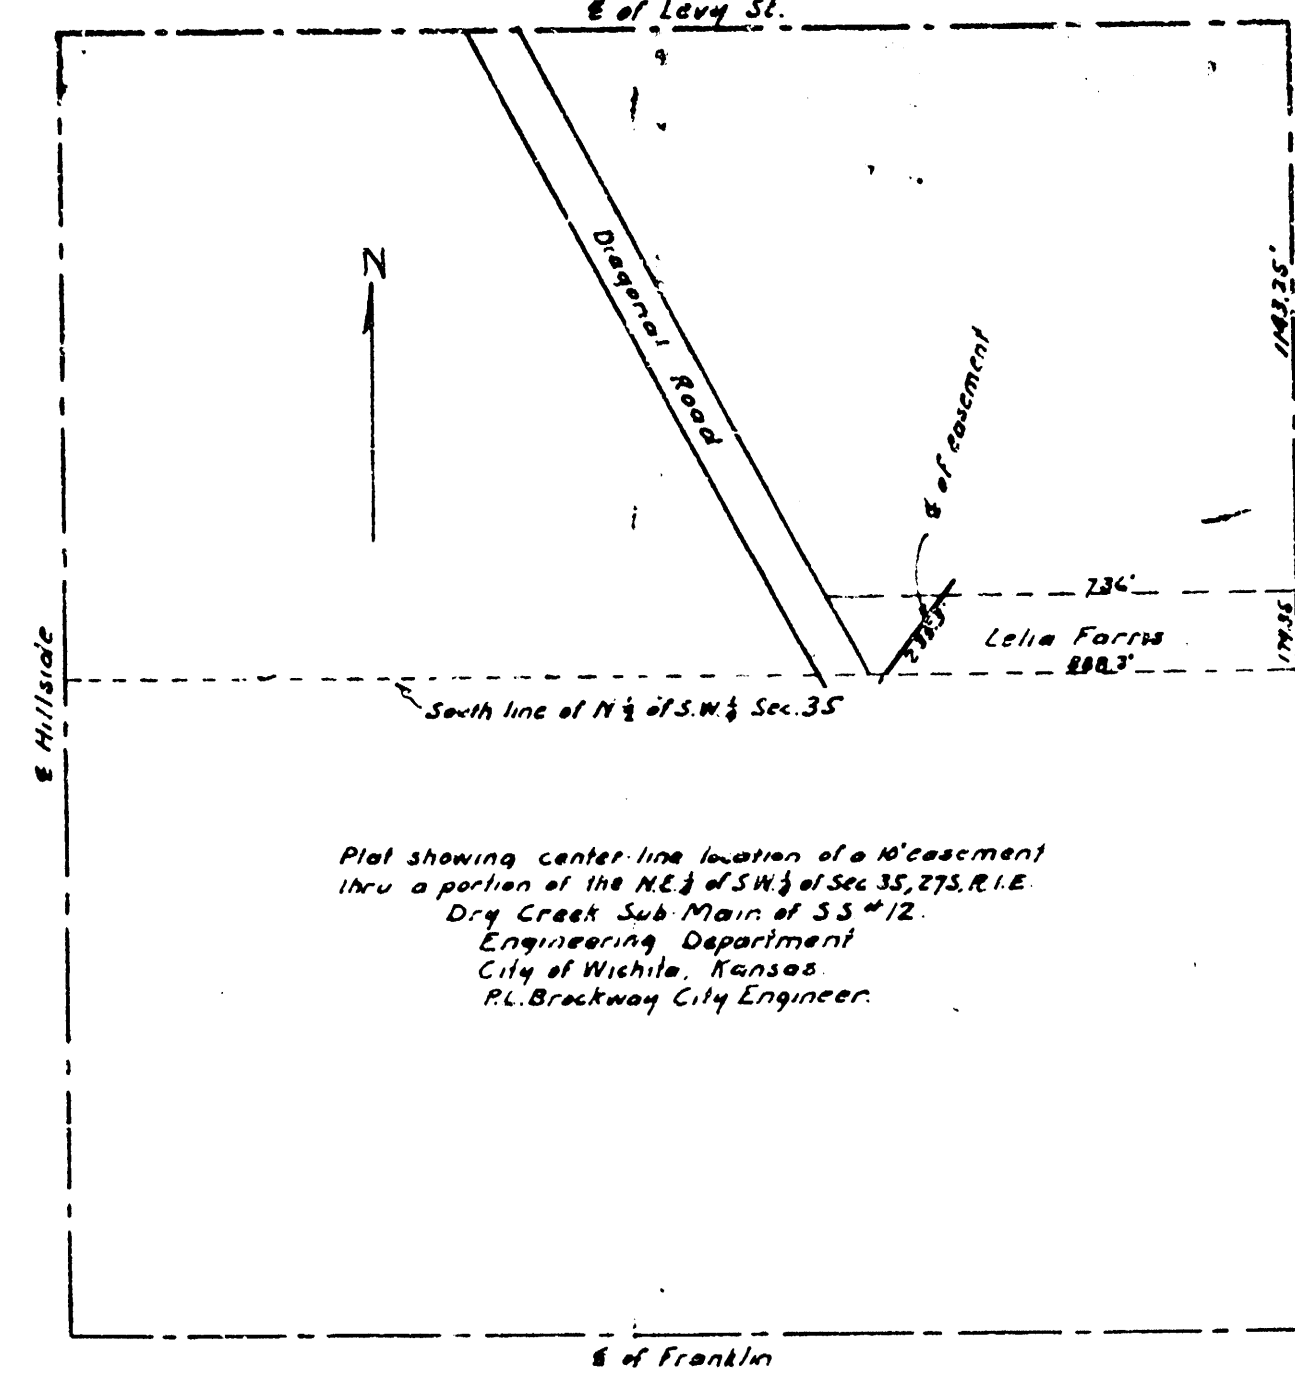

NE 1/4 Sec. 35, 27S, R1E.

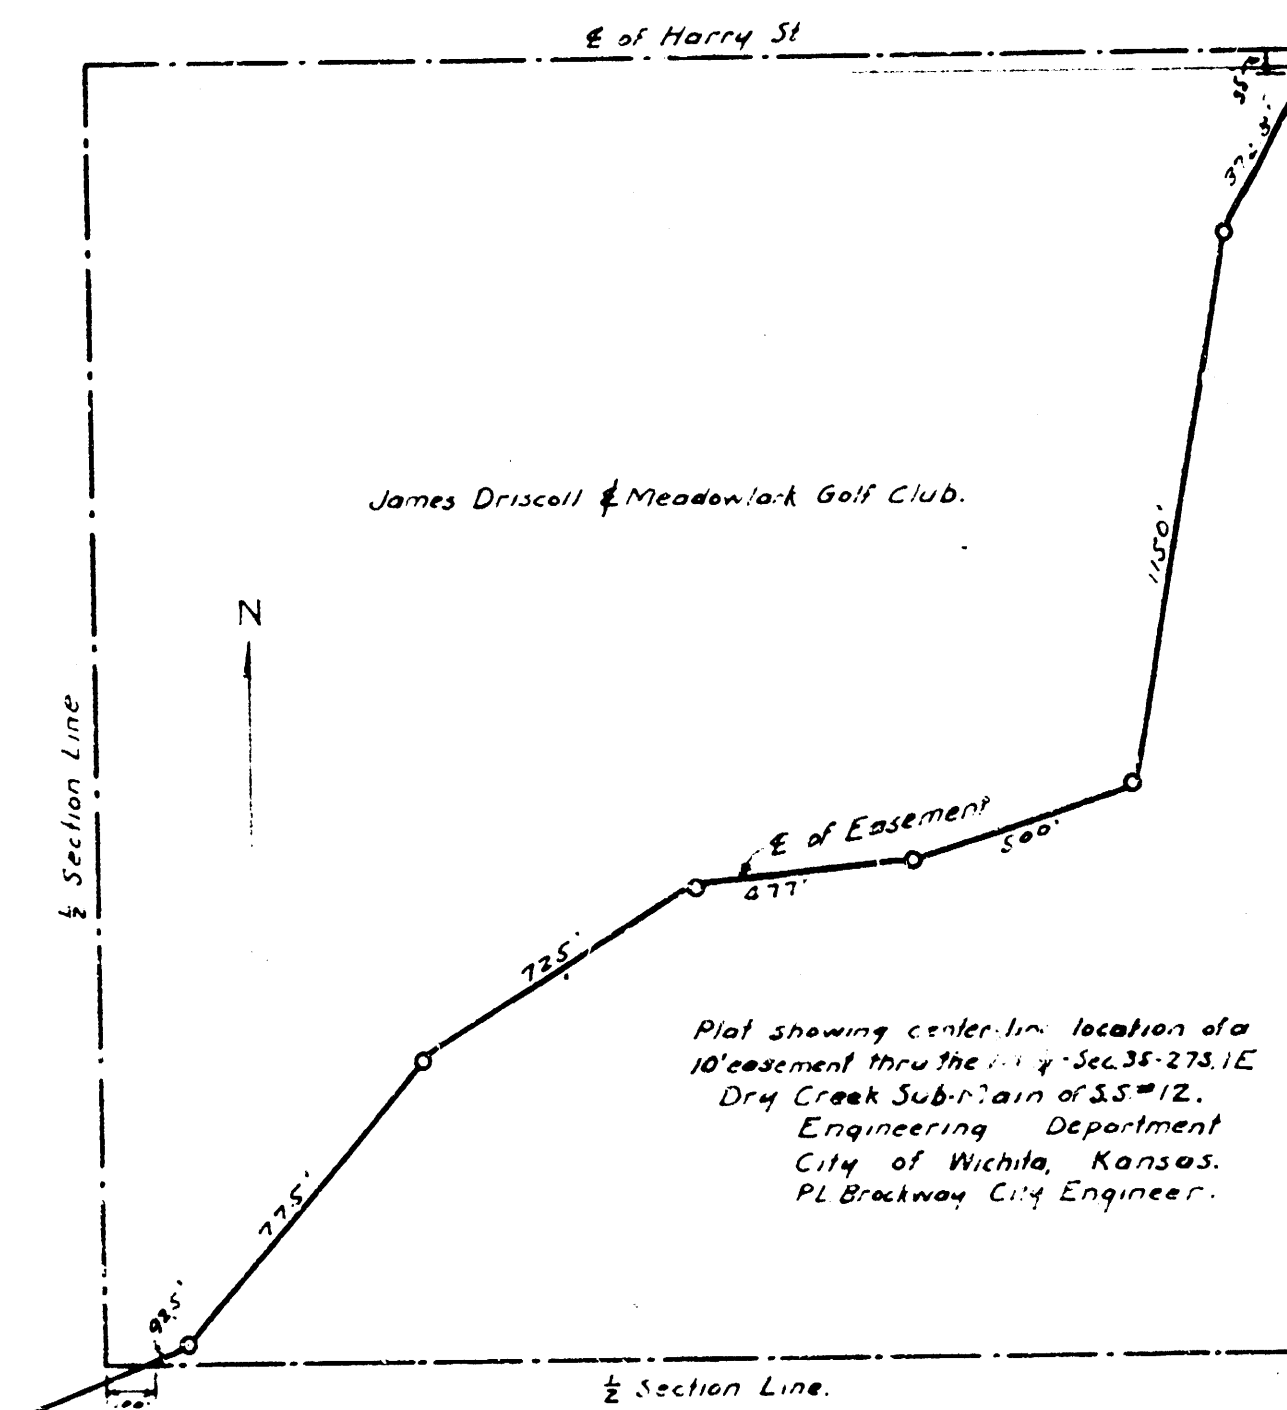

SE 1/4 Sec. 35, 27S, R1E.

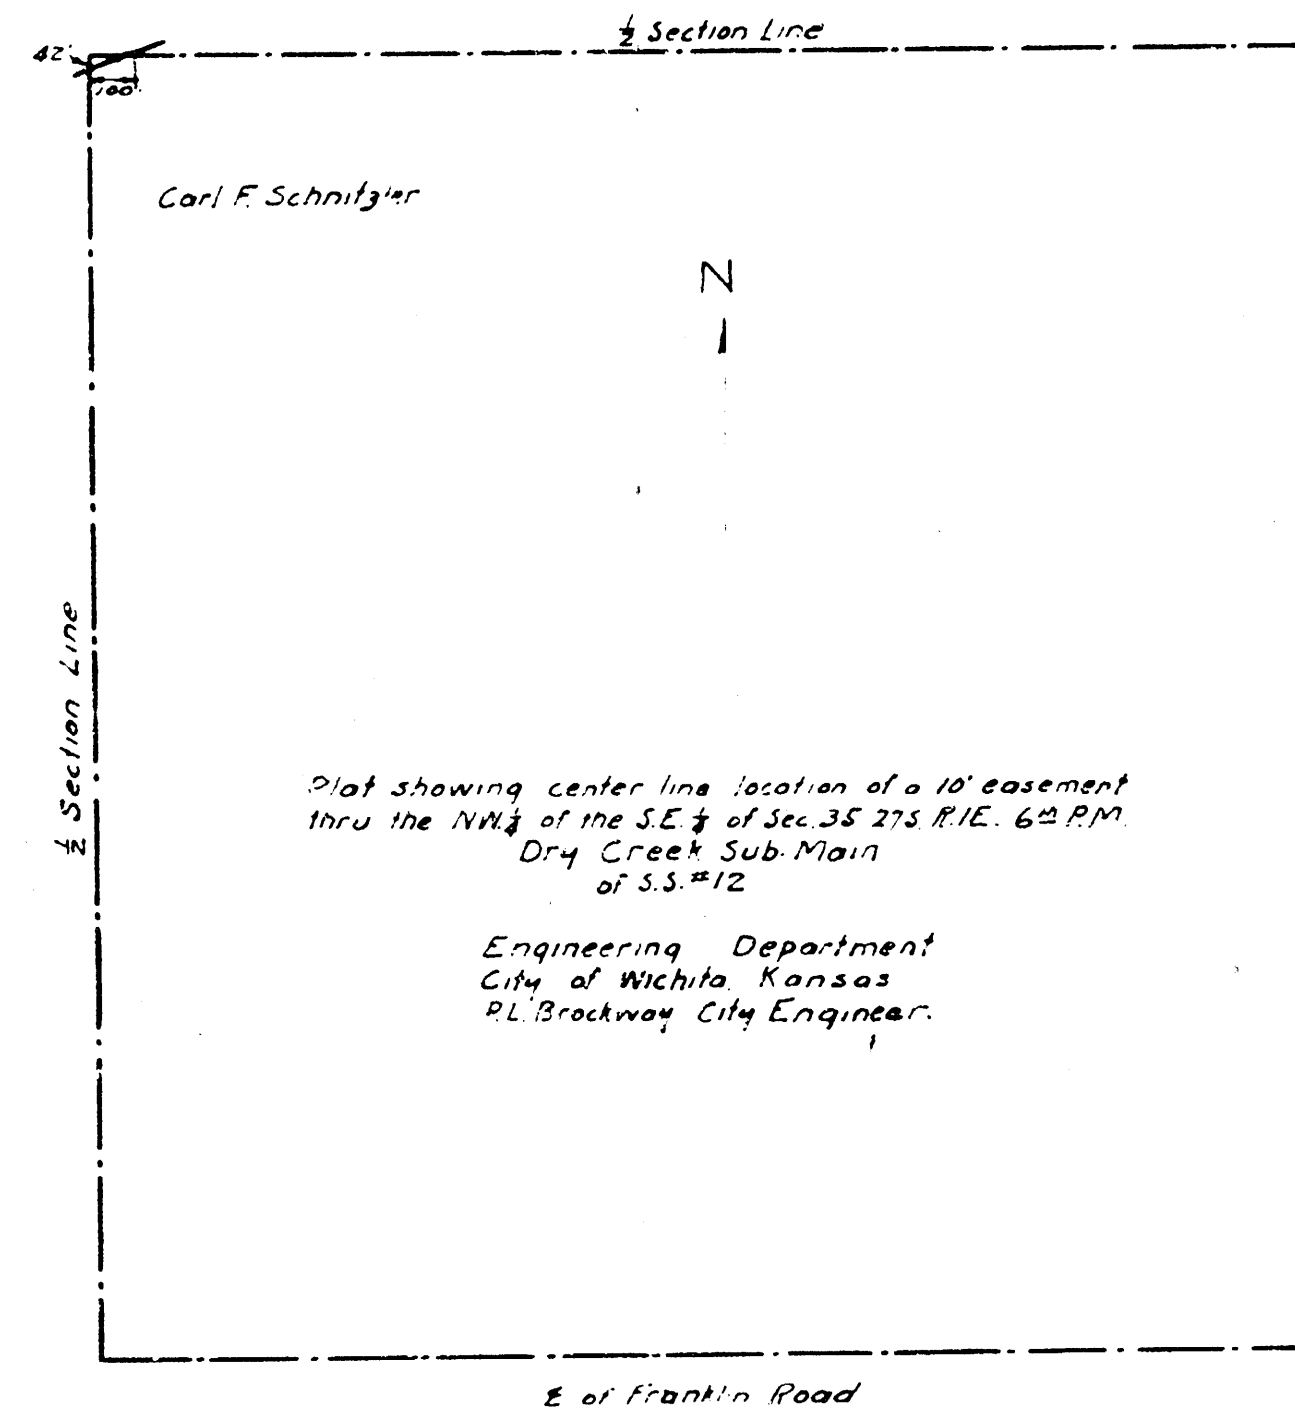

SW 1/4 Sec. 35, 27S, R1E.

