
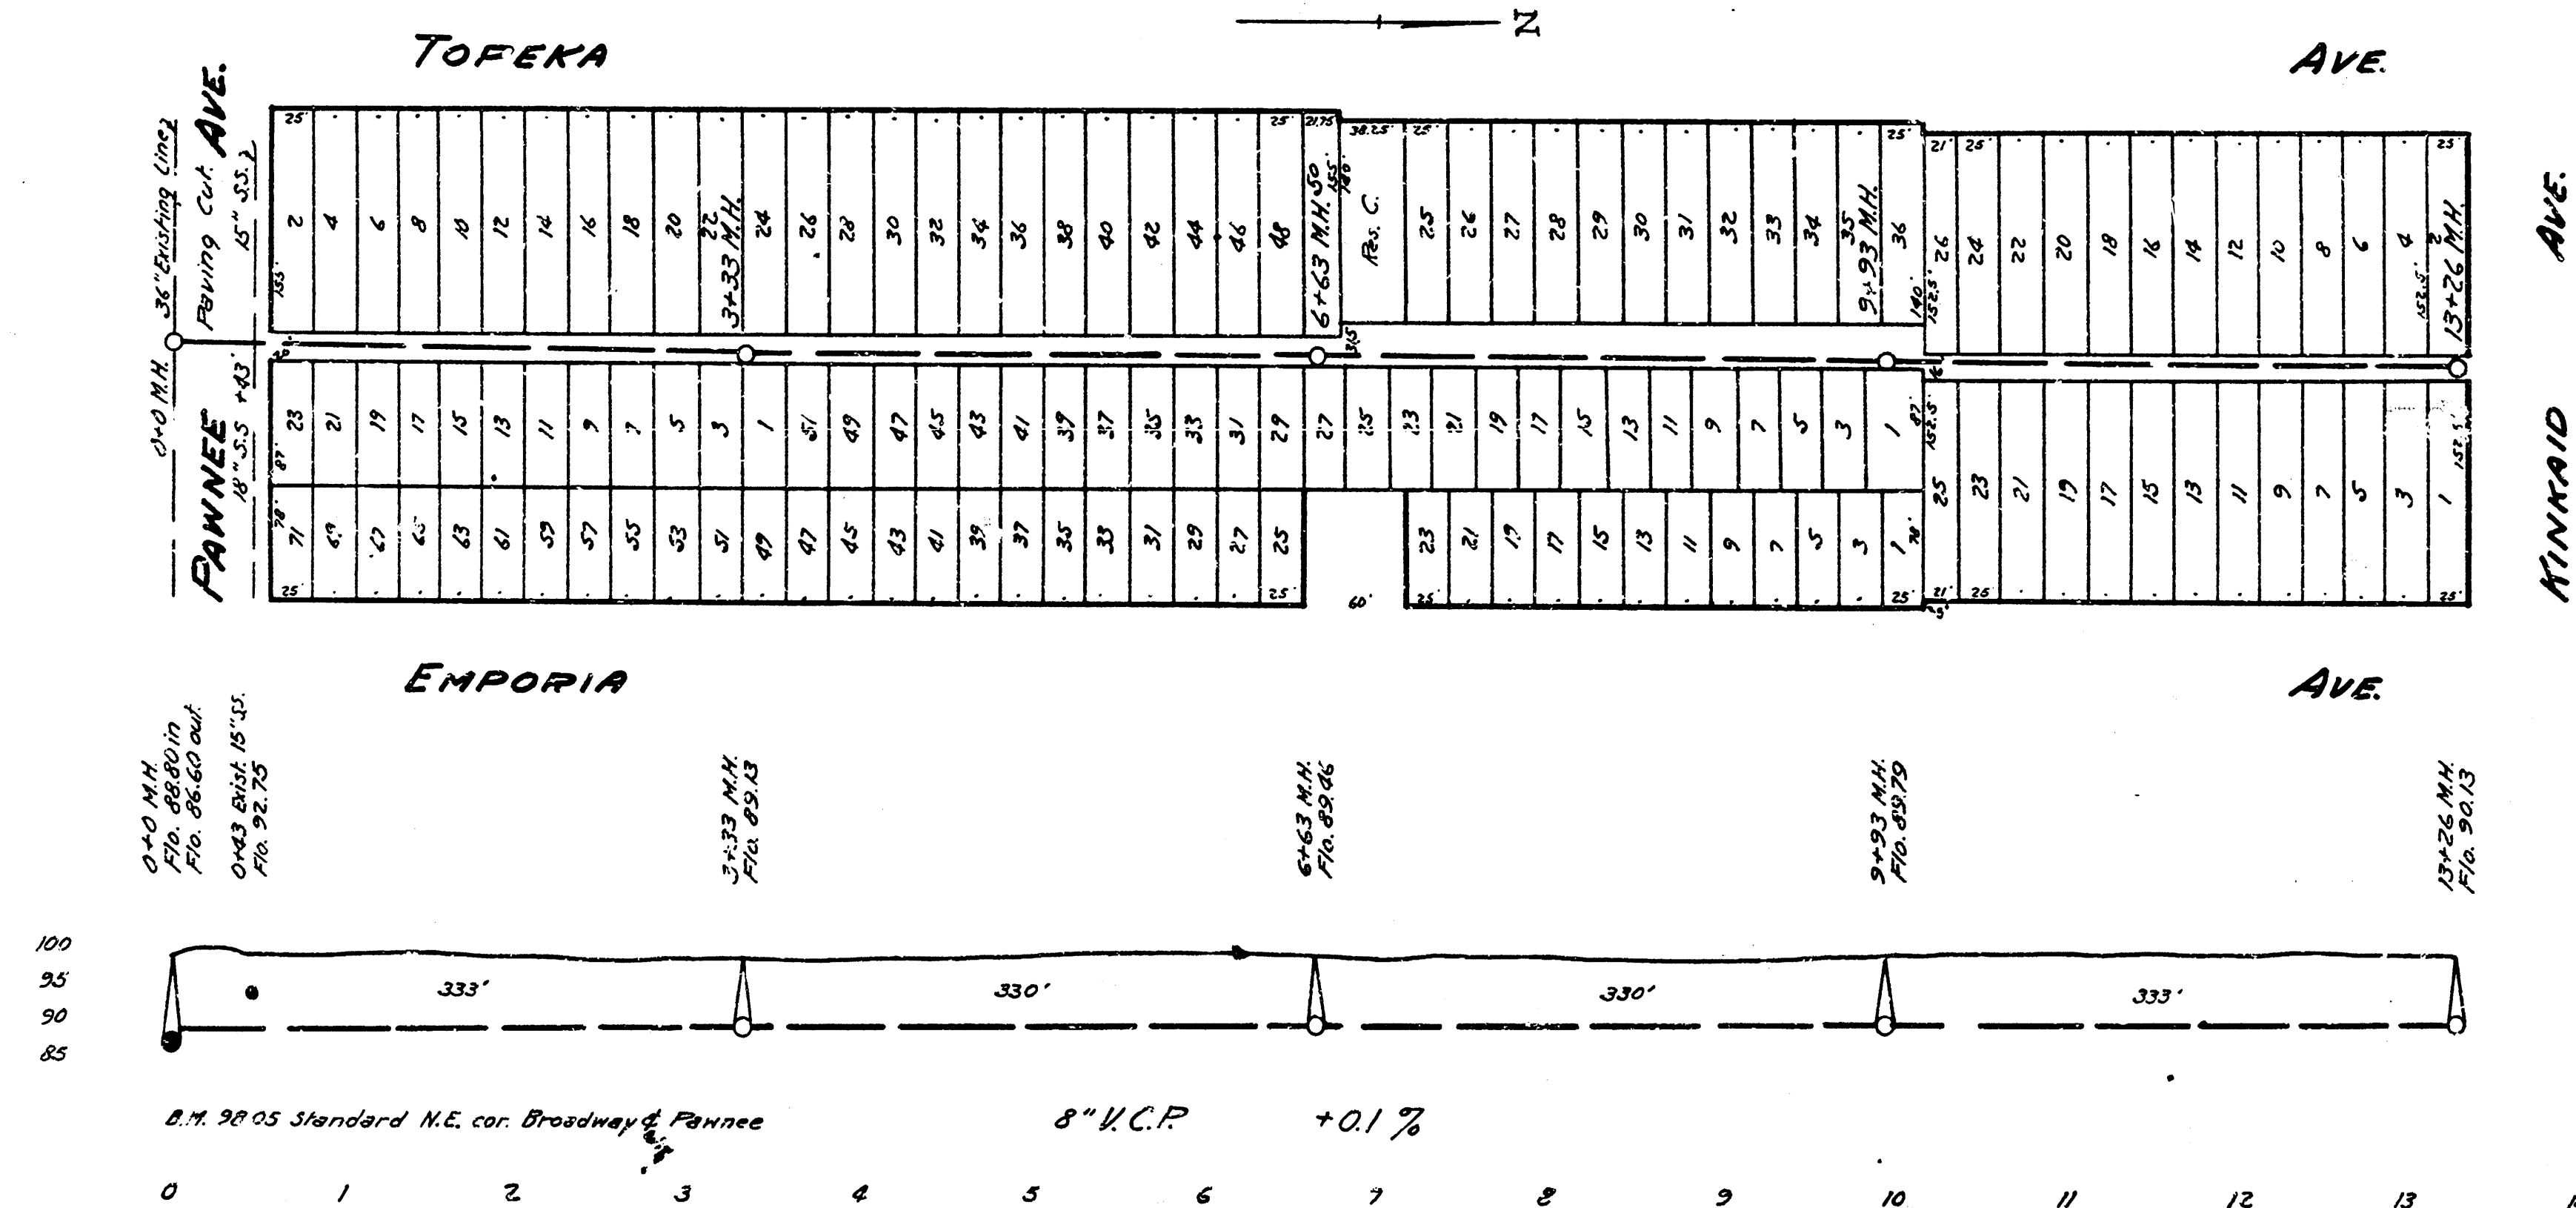
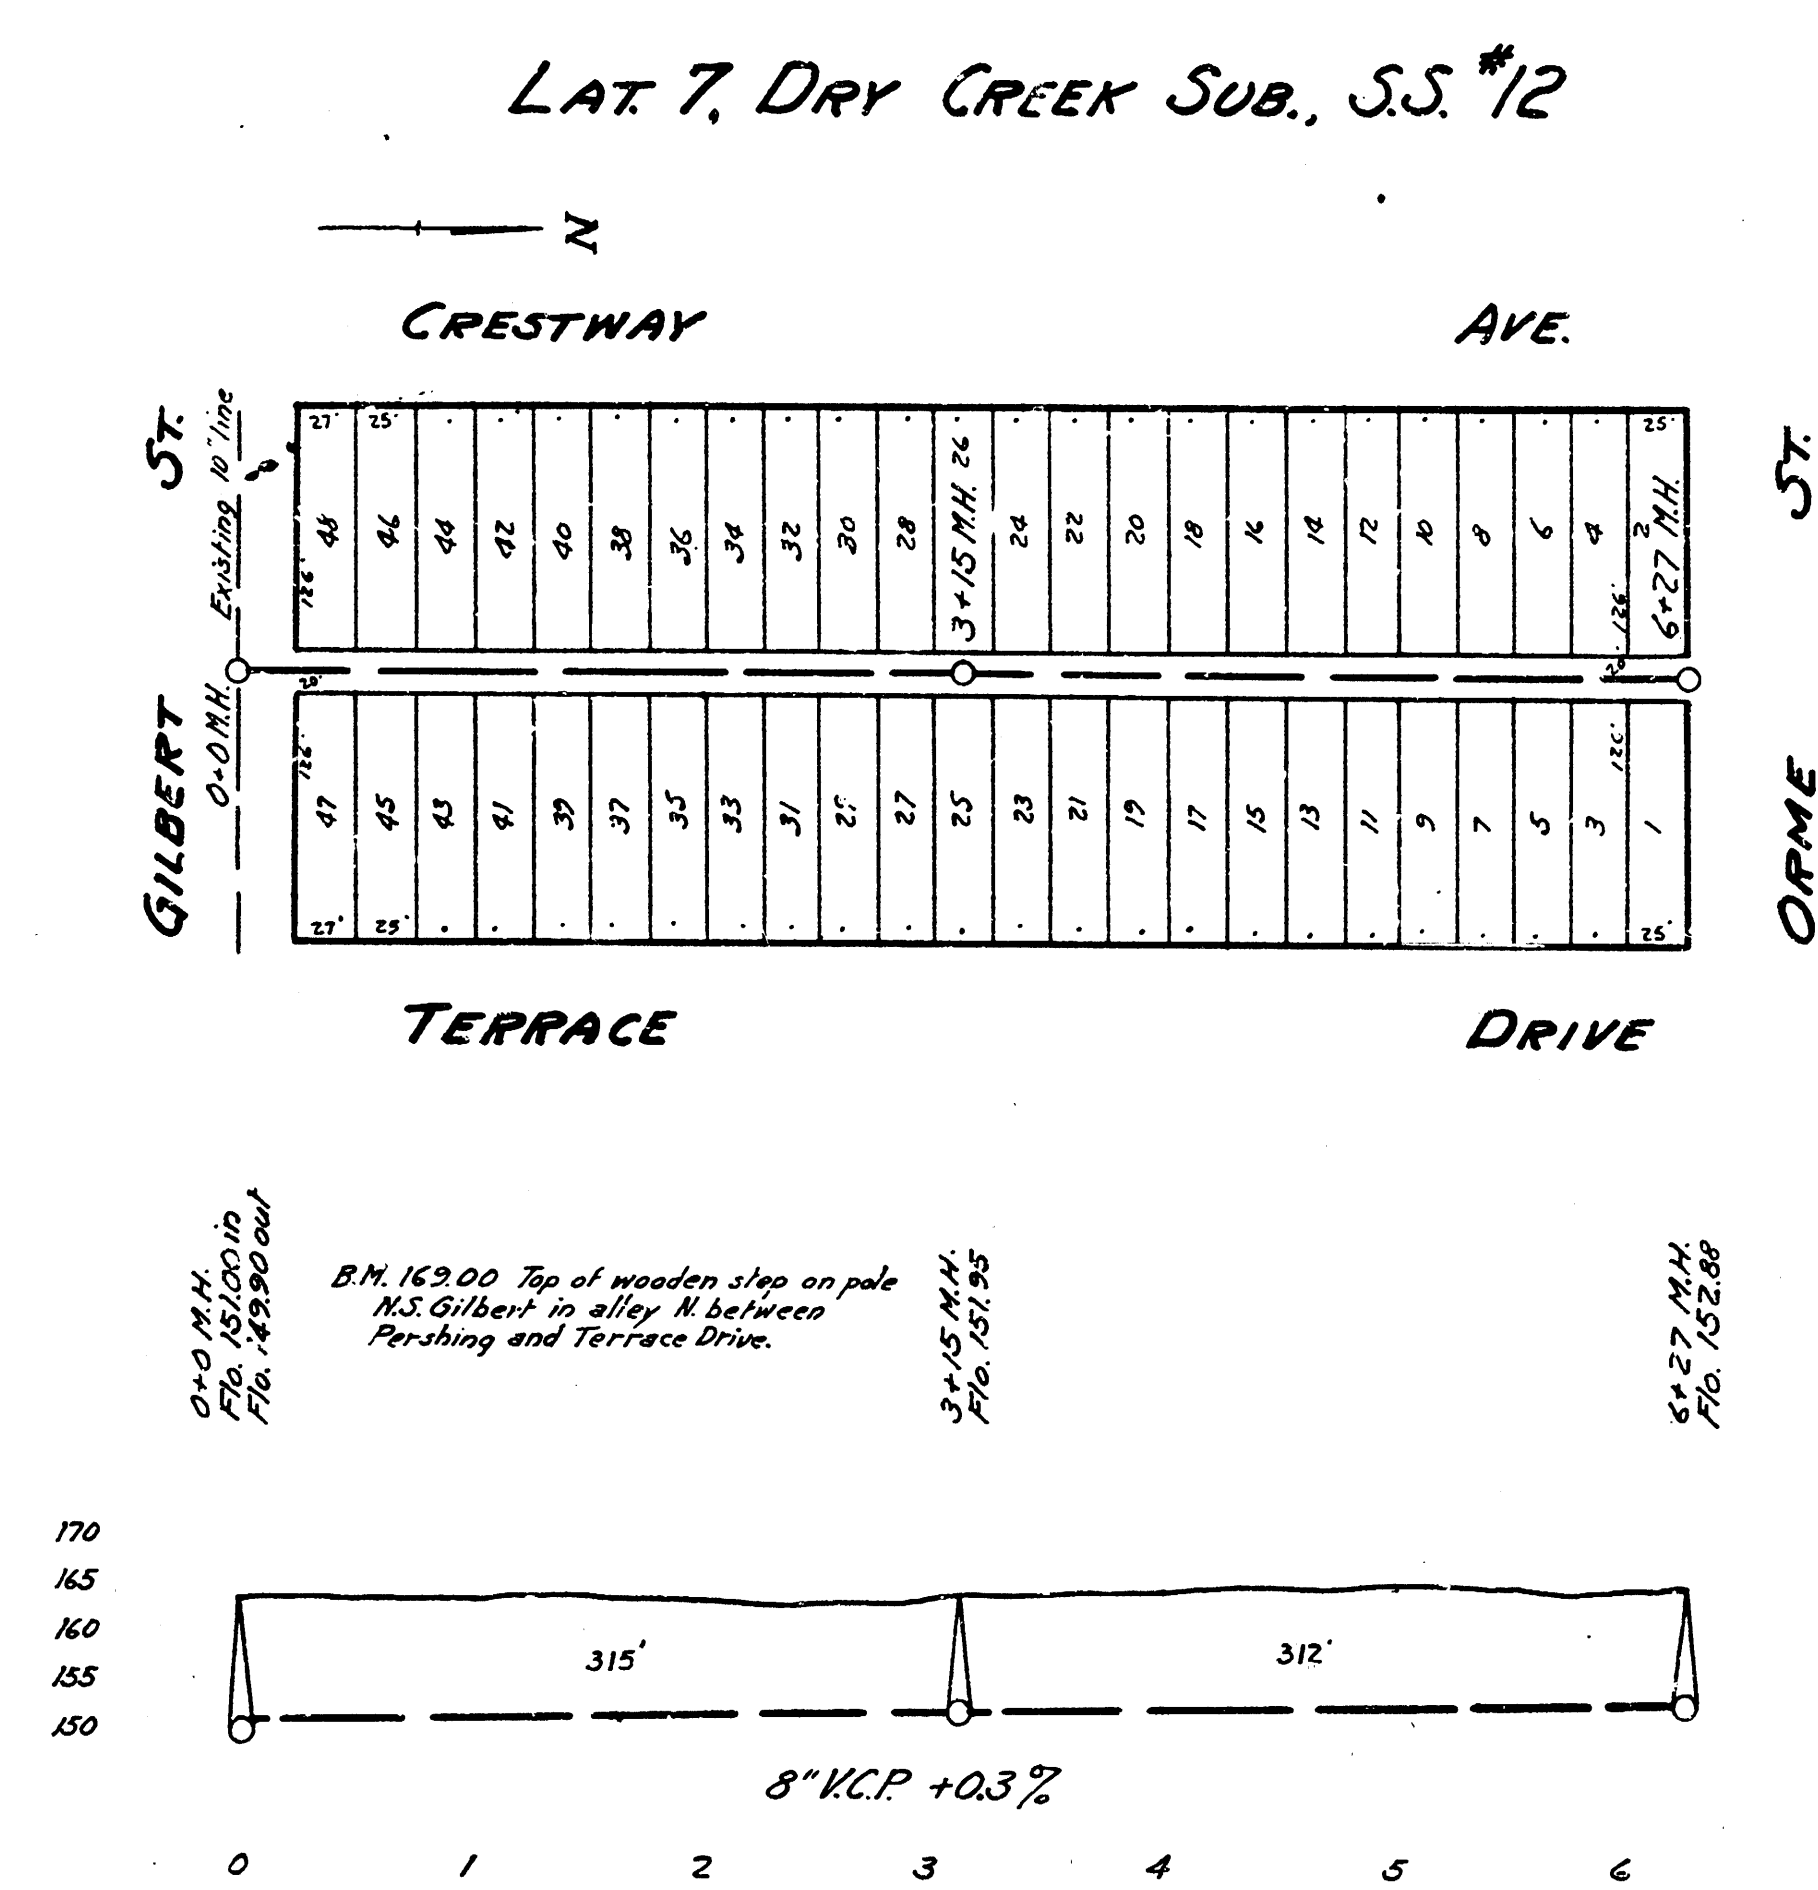


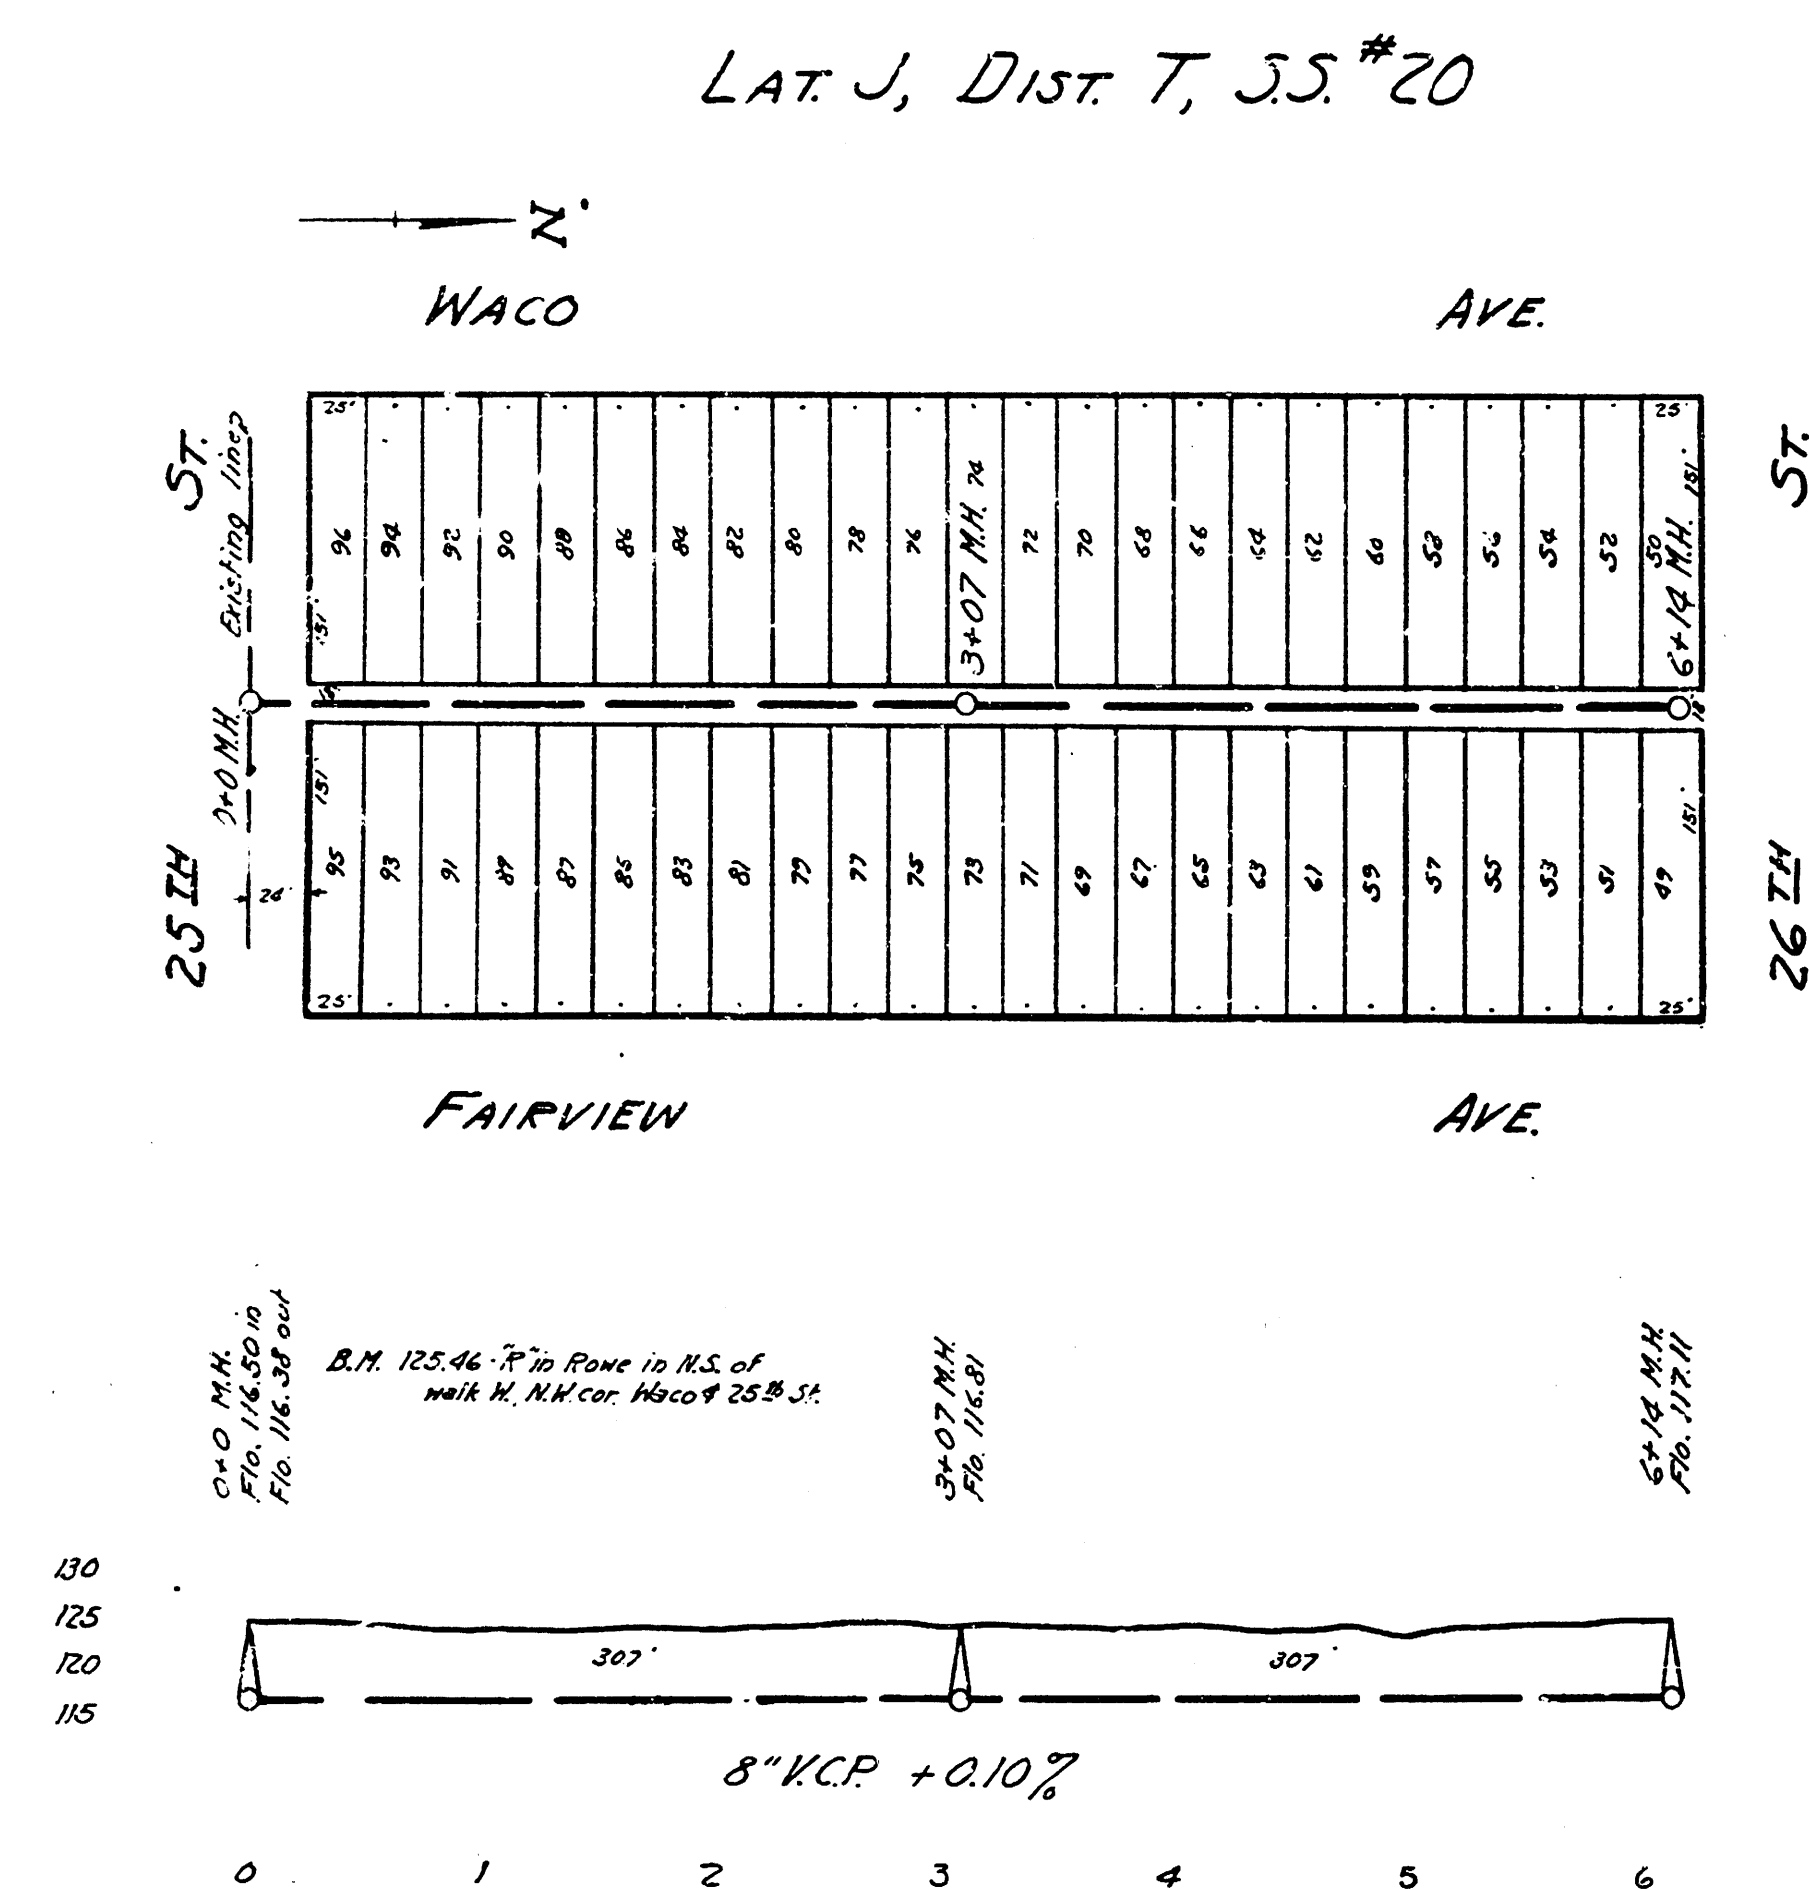

LAT. N, DIST. B, S.S. #20

ENGINEERING DEPARTMENT  
CITY OF WICHITA, KANSAS  
P.L. BROCKWAY CITY ENGINEER  
SCALE 1"=80' MARCH 1942