

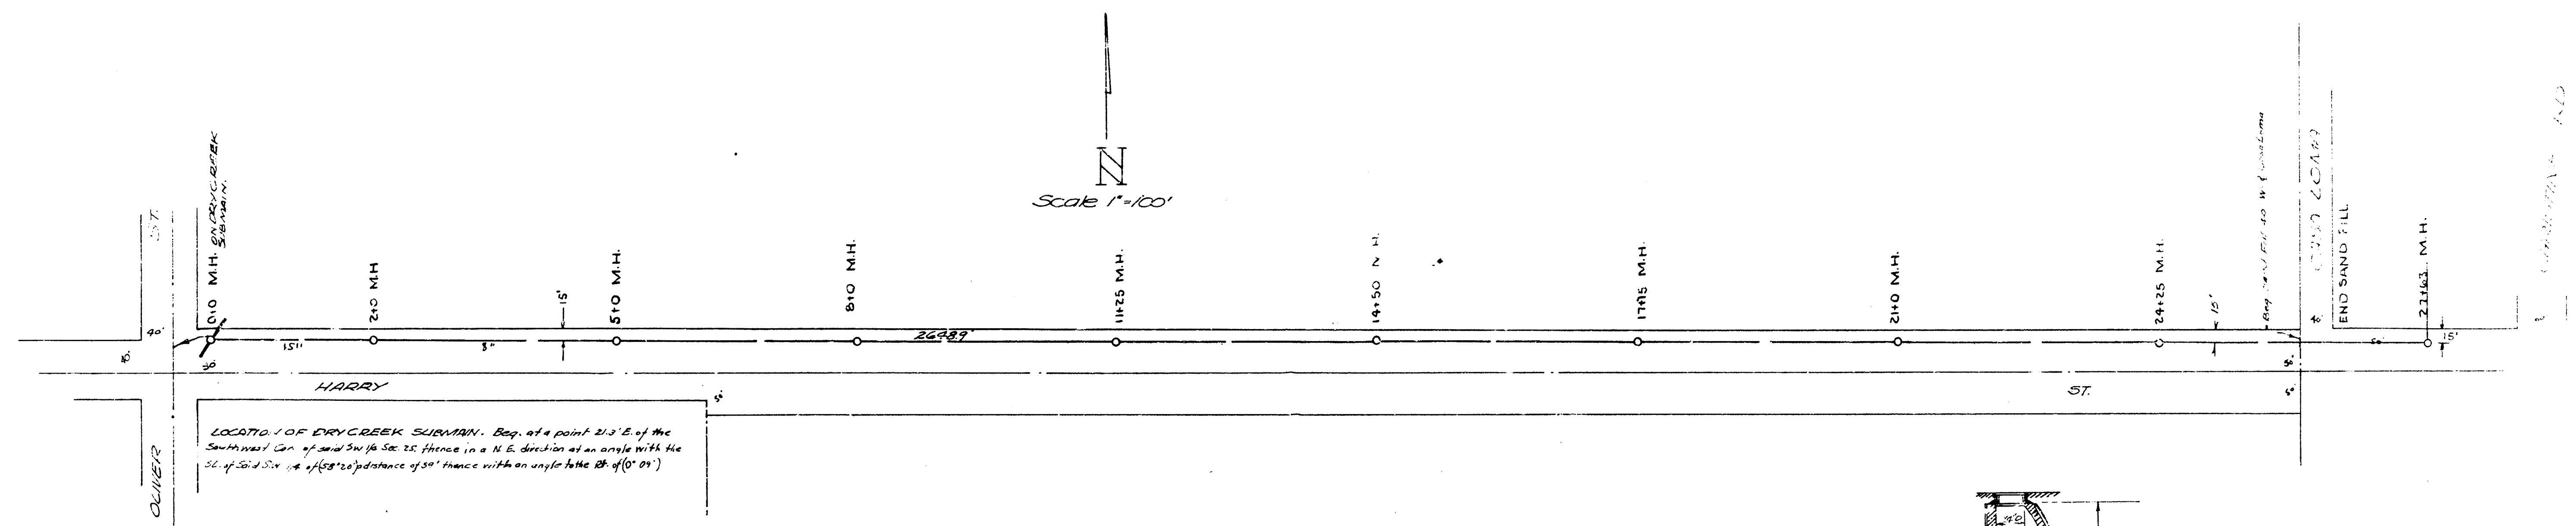
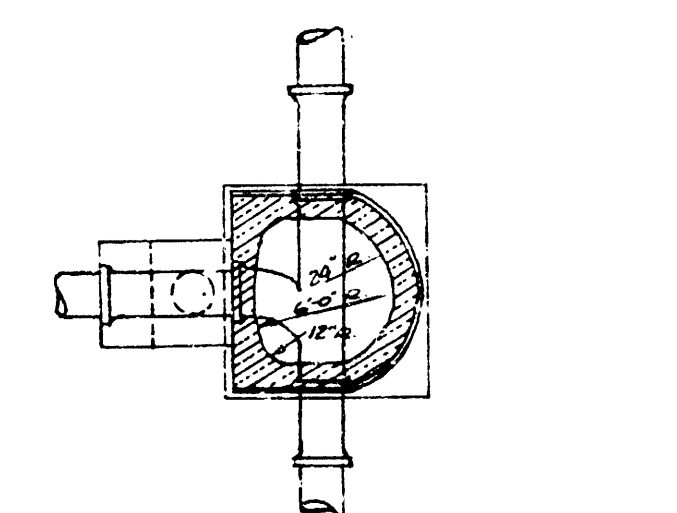


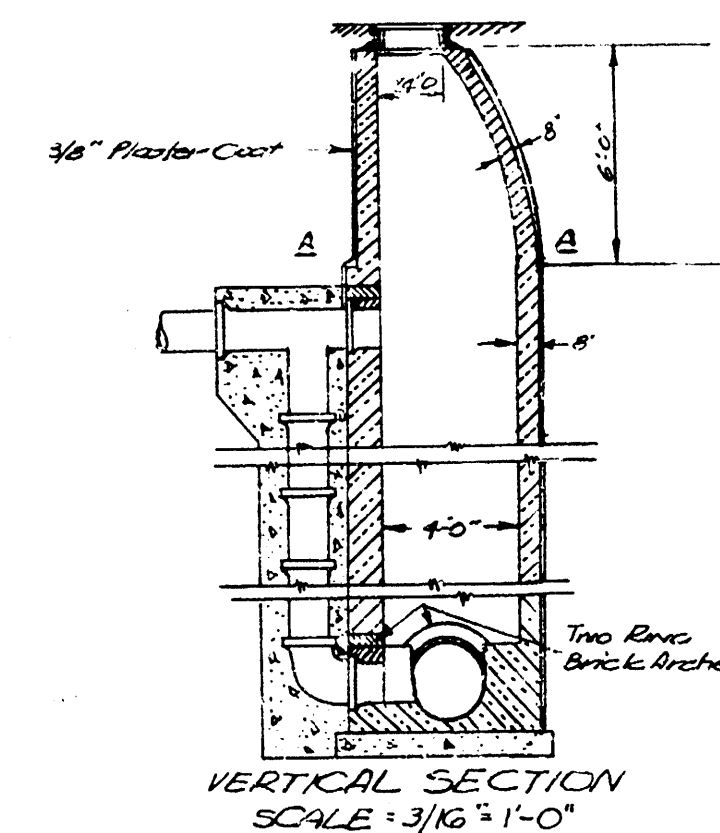





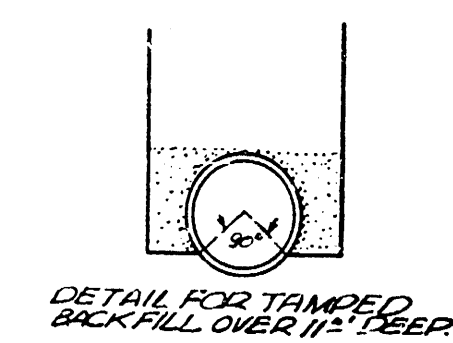


DETAIL OF SPECIAL MANHOLE

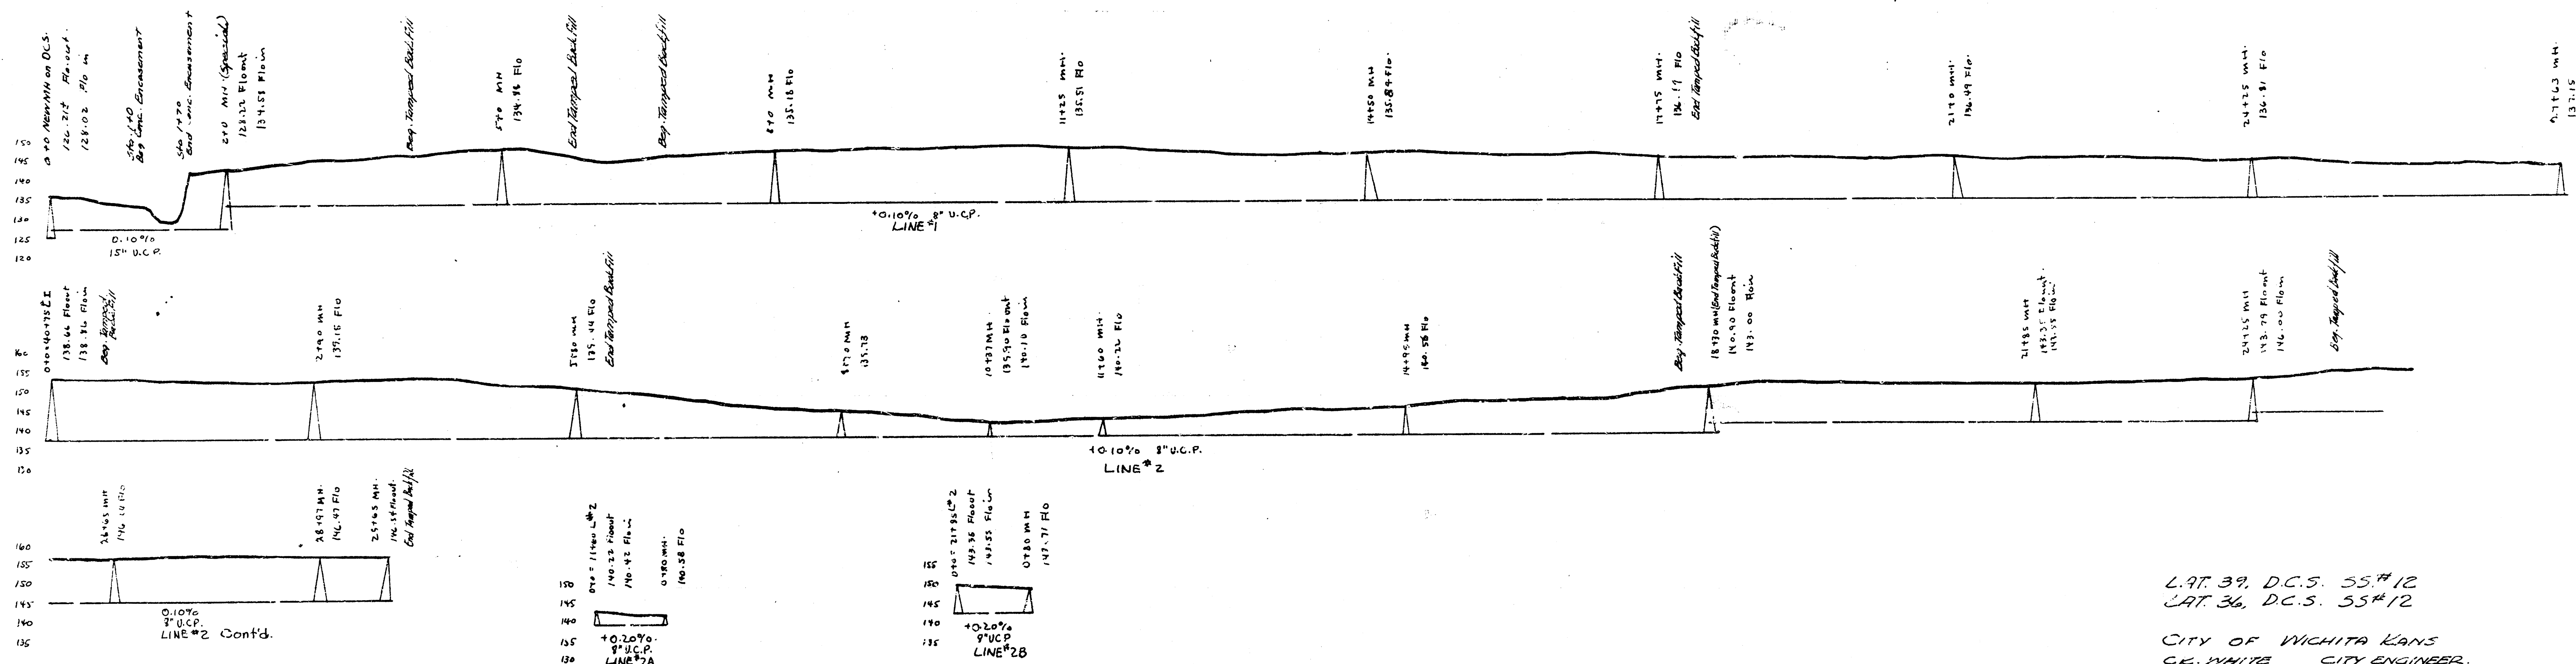

 CITY OF WICHITA KANS.
 C.E. WHITE CITY ENGINEER.
 DATE 7-10-29 REV. NO. 229-17
 229-31

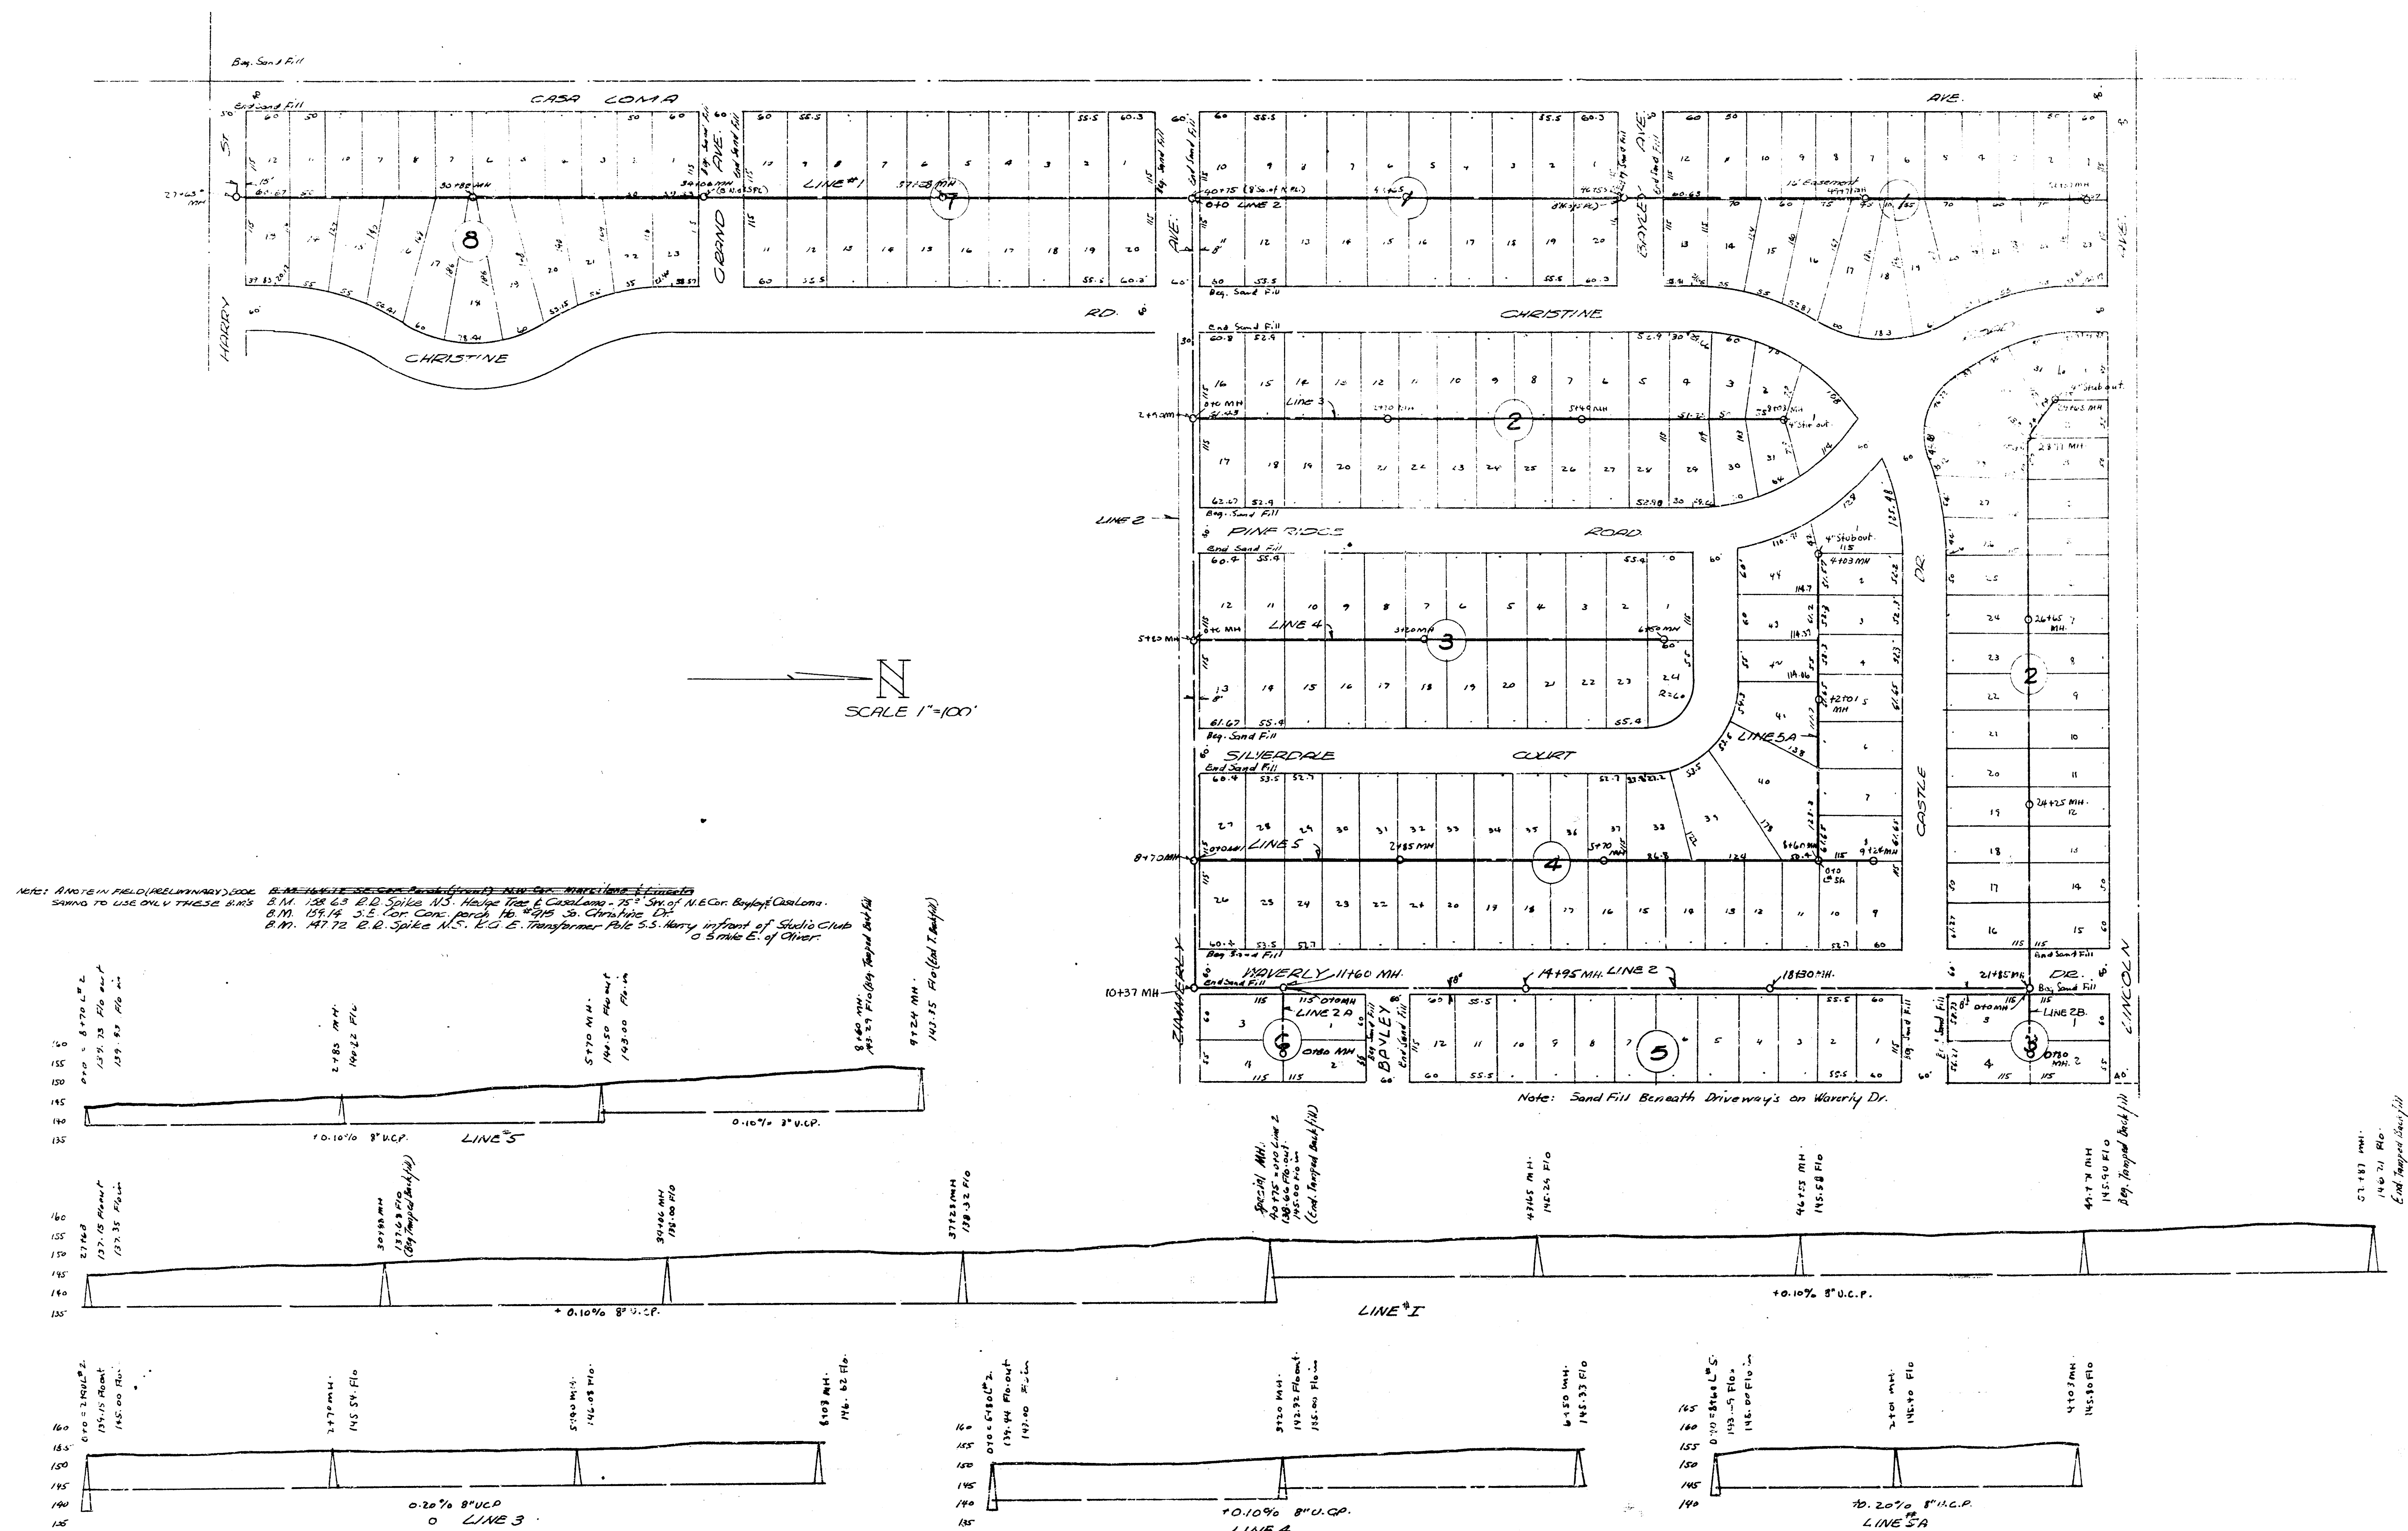

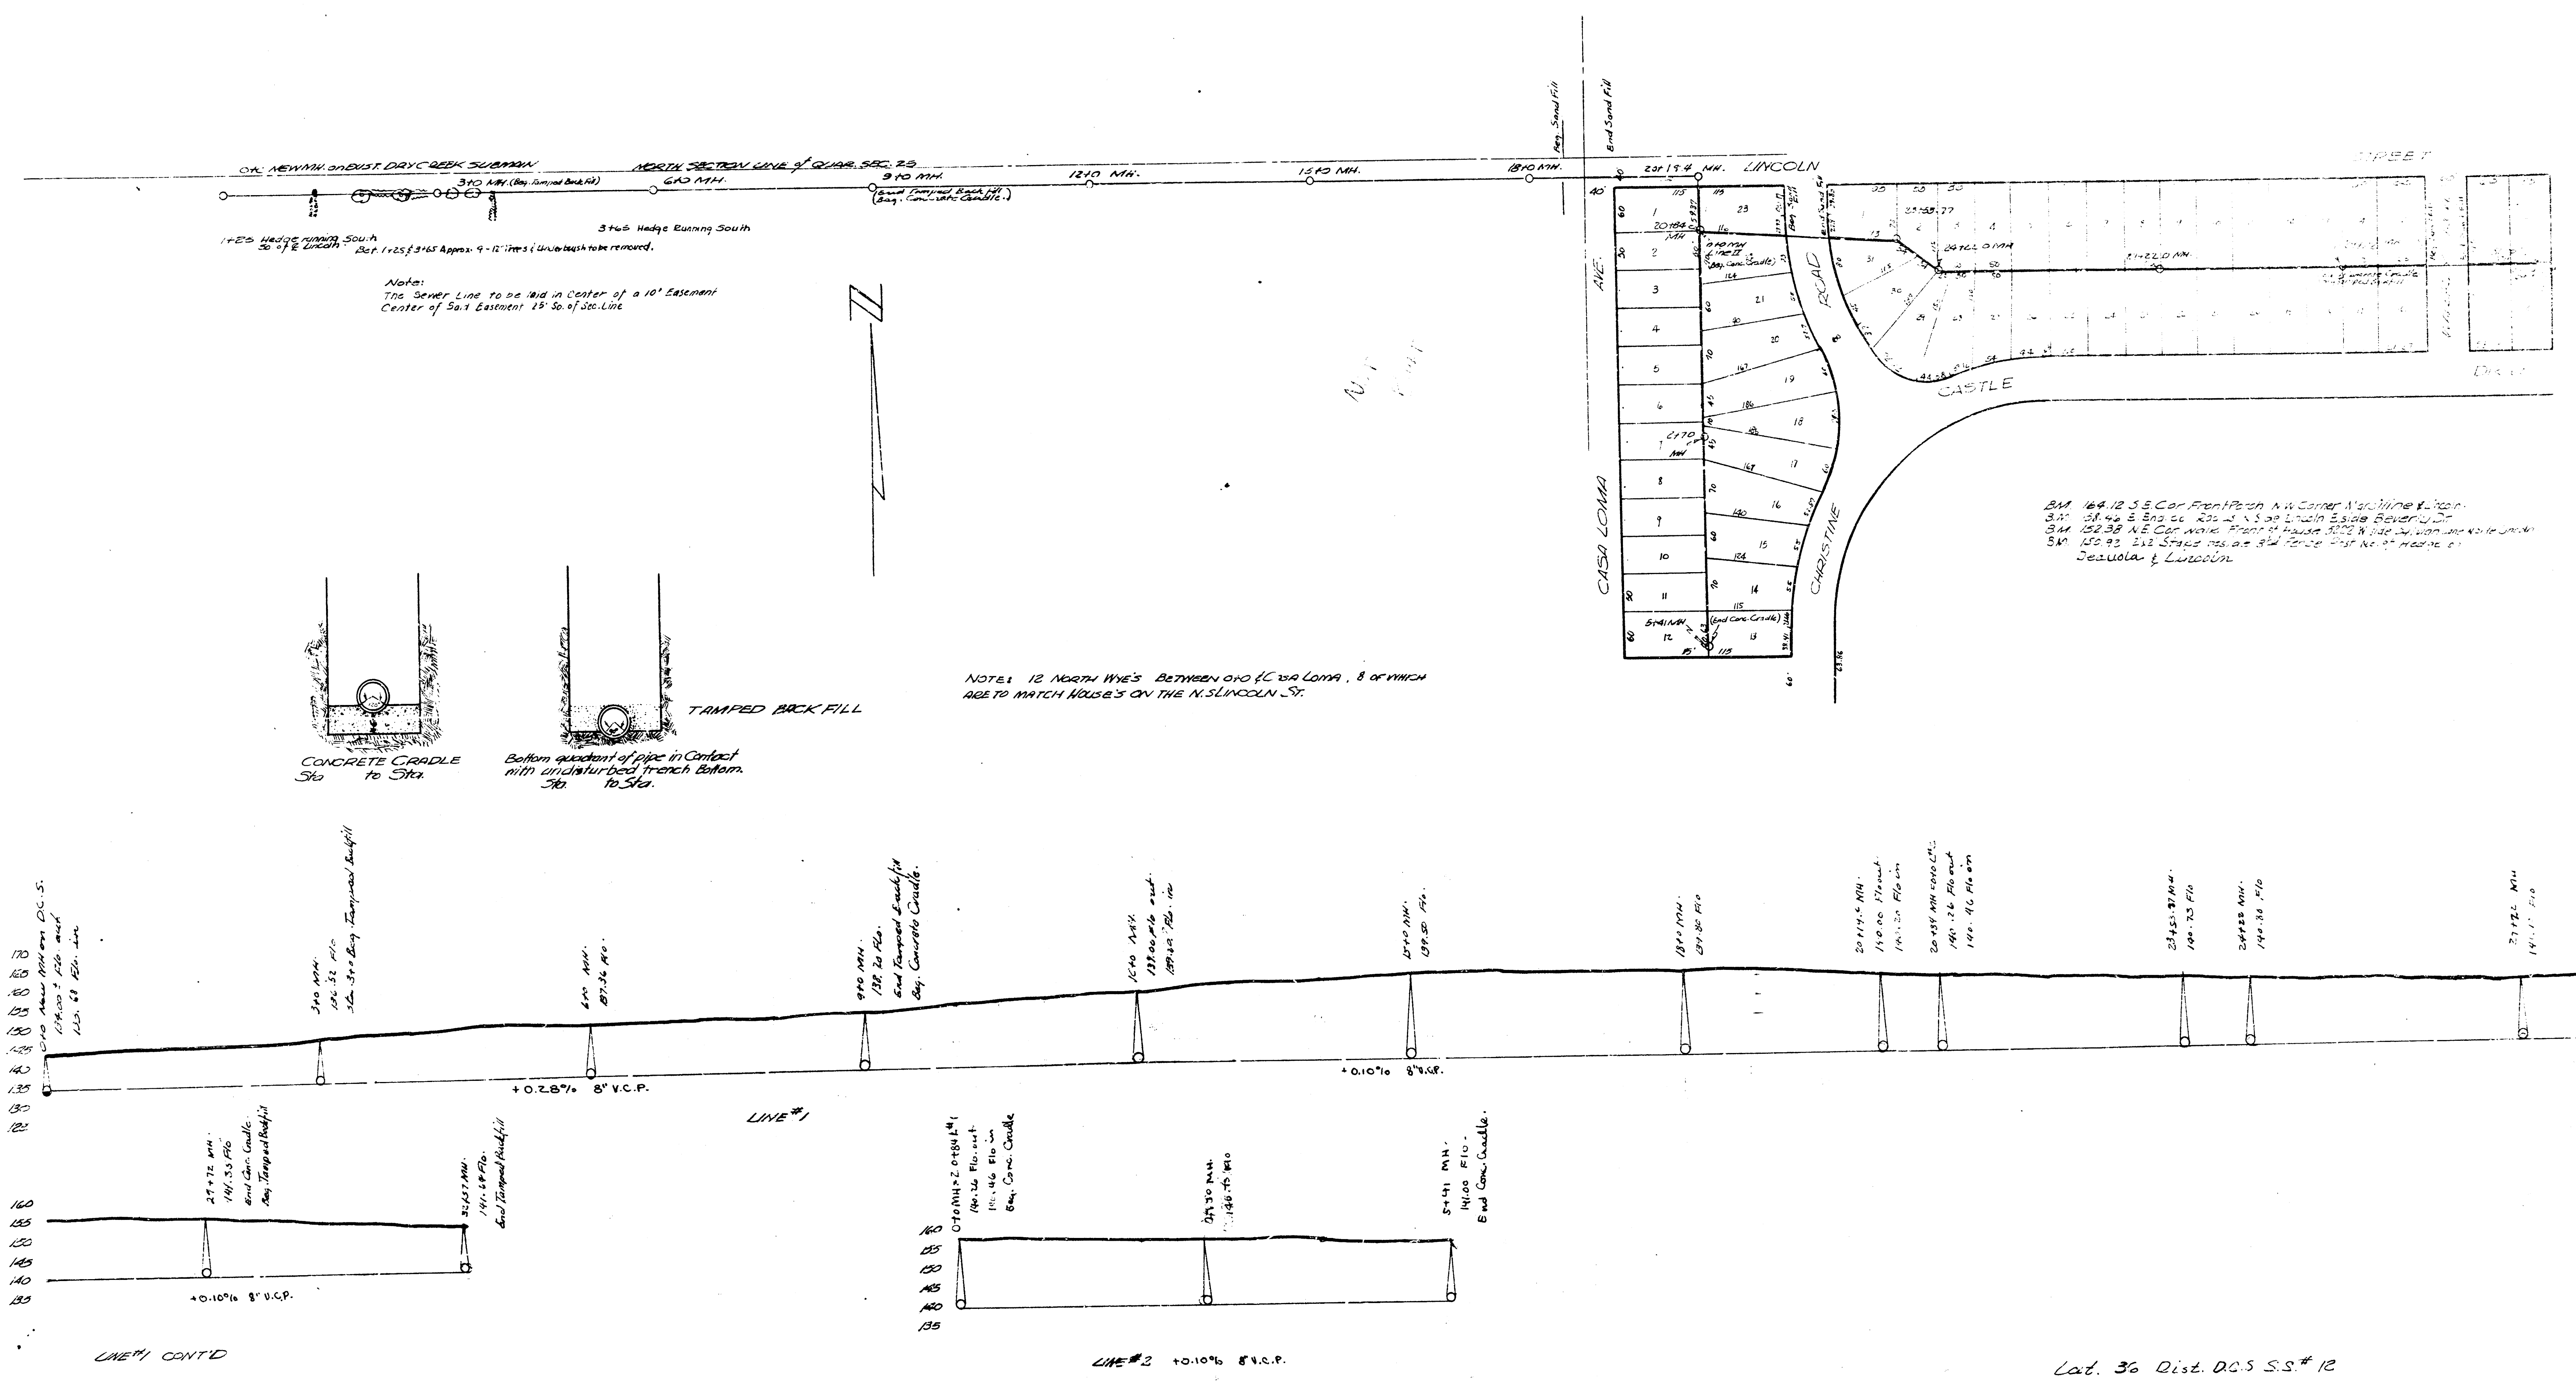

Lat. 36 Dist. D.C.S. S.S. # 12
City of Wichita, Kansas
L.R. White City Engineer
date 7-49 Proj. No. C29-19