

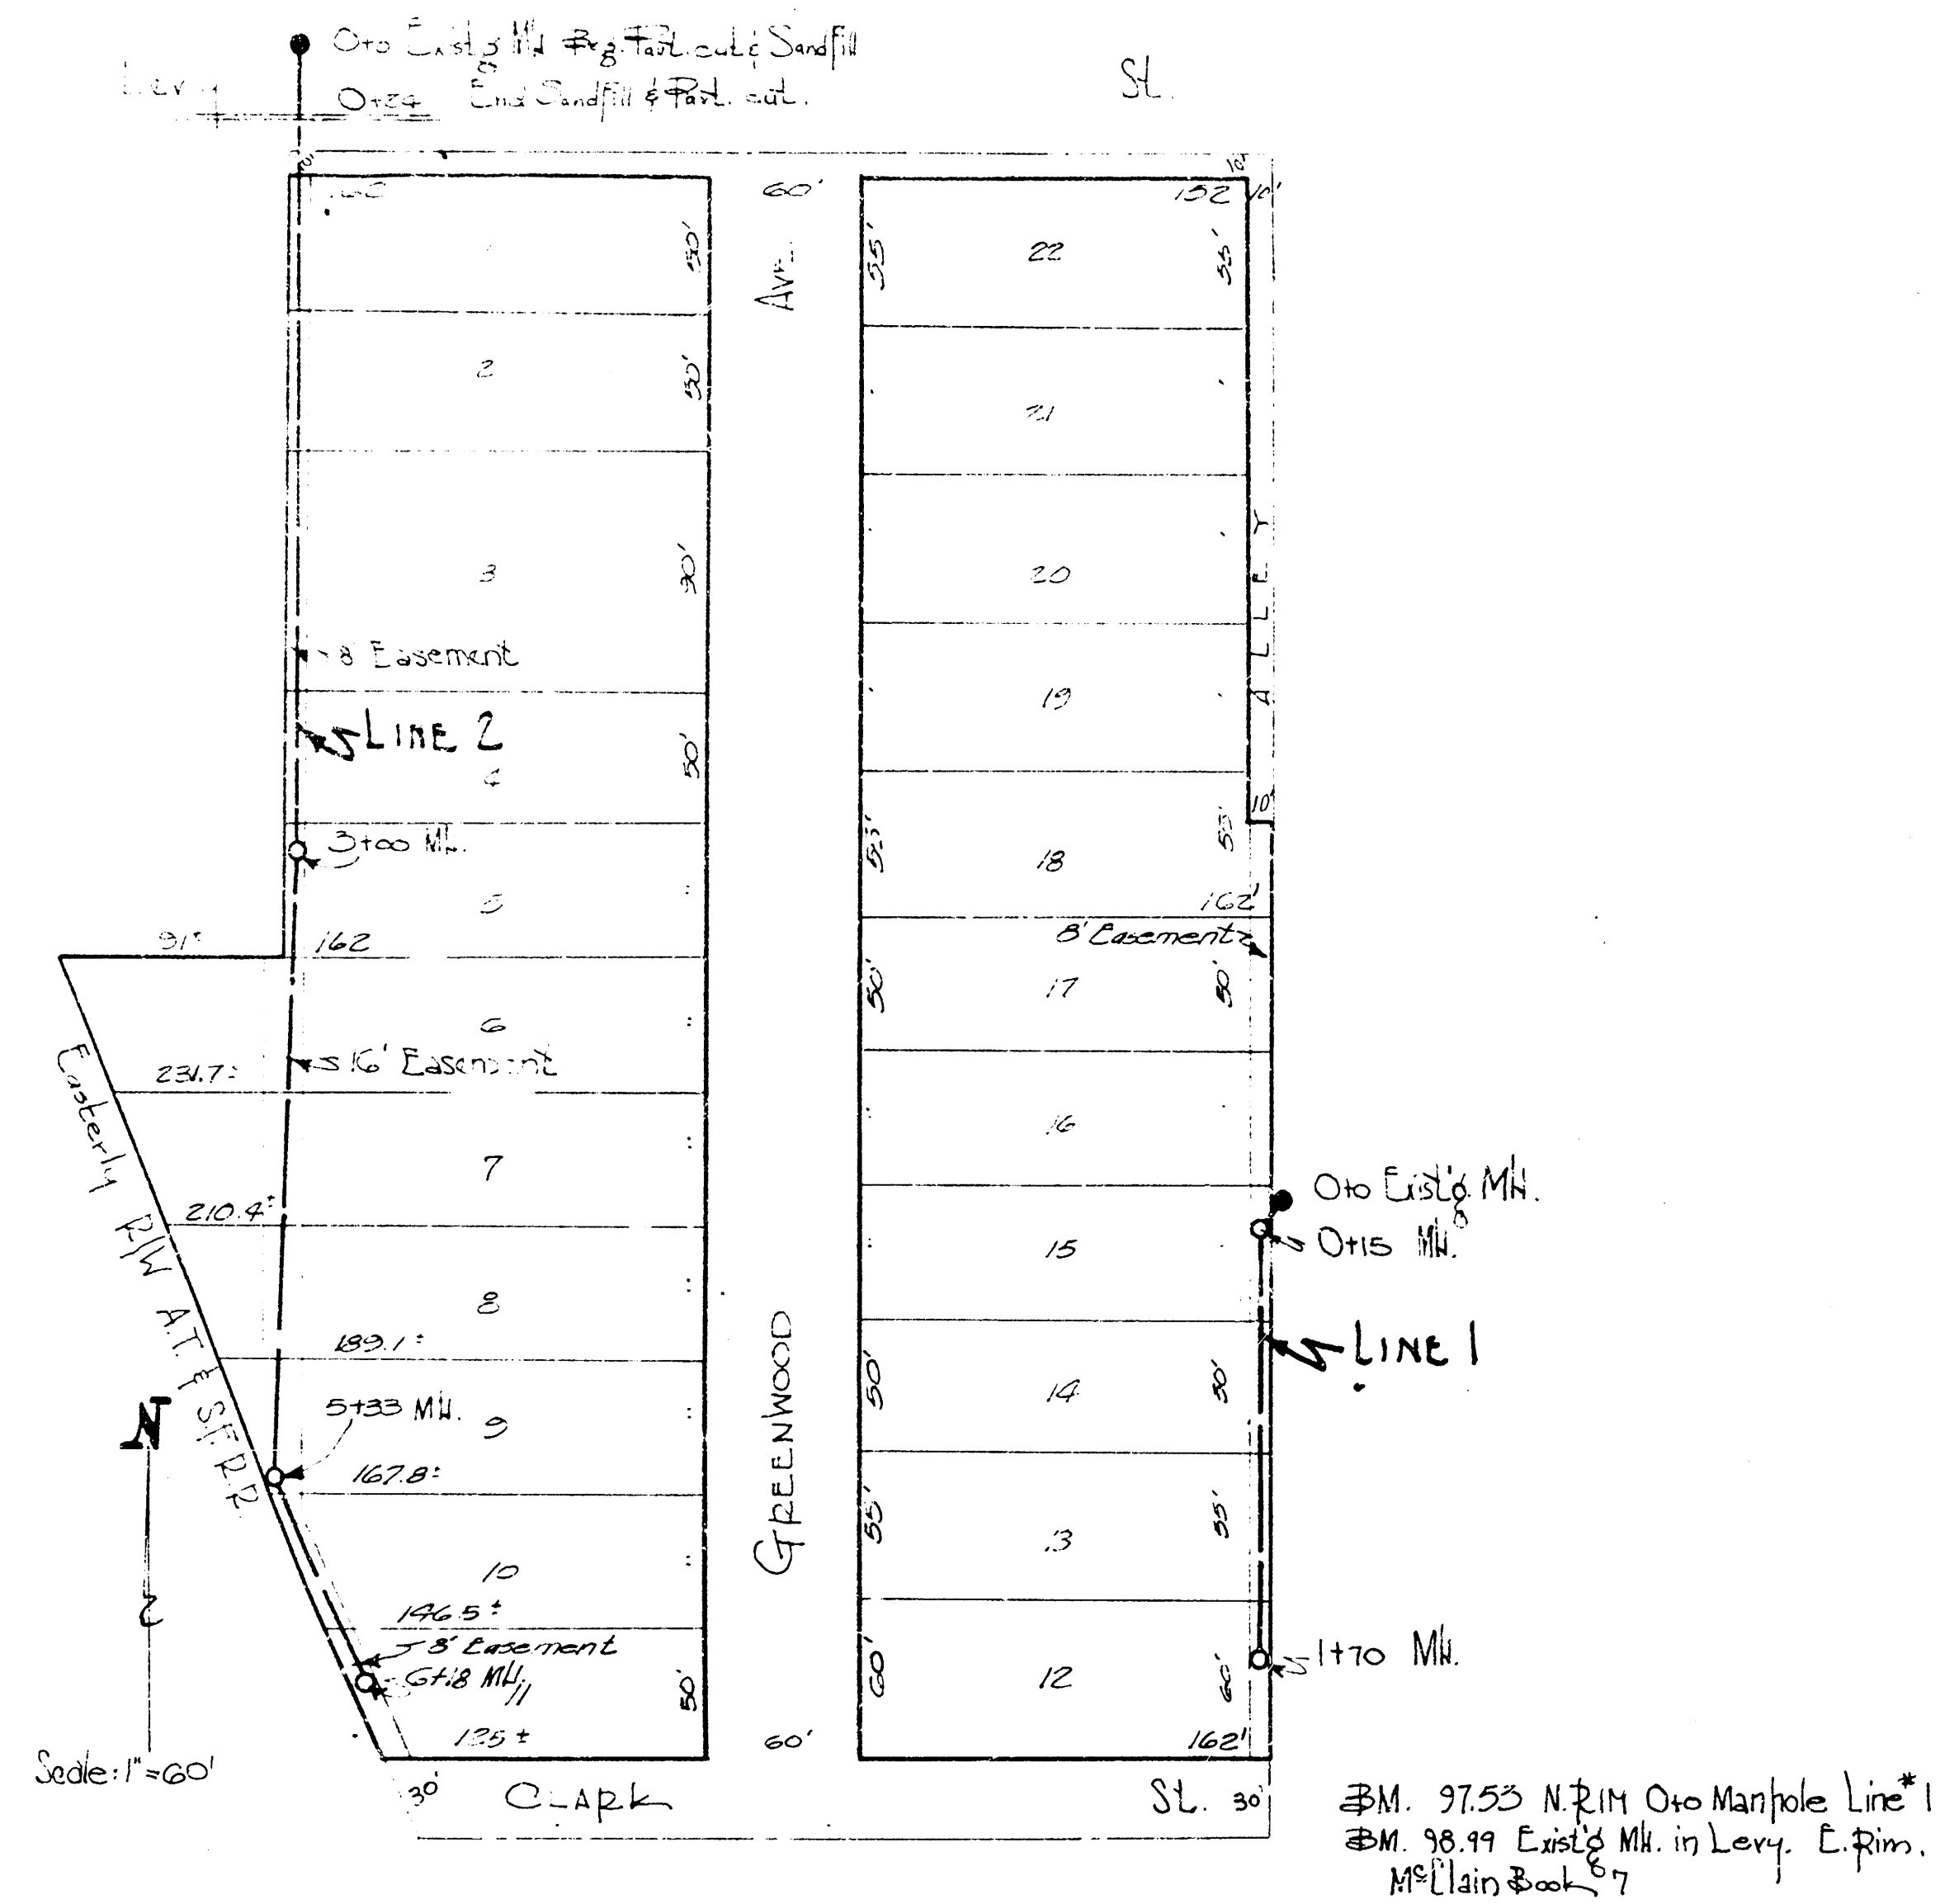
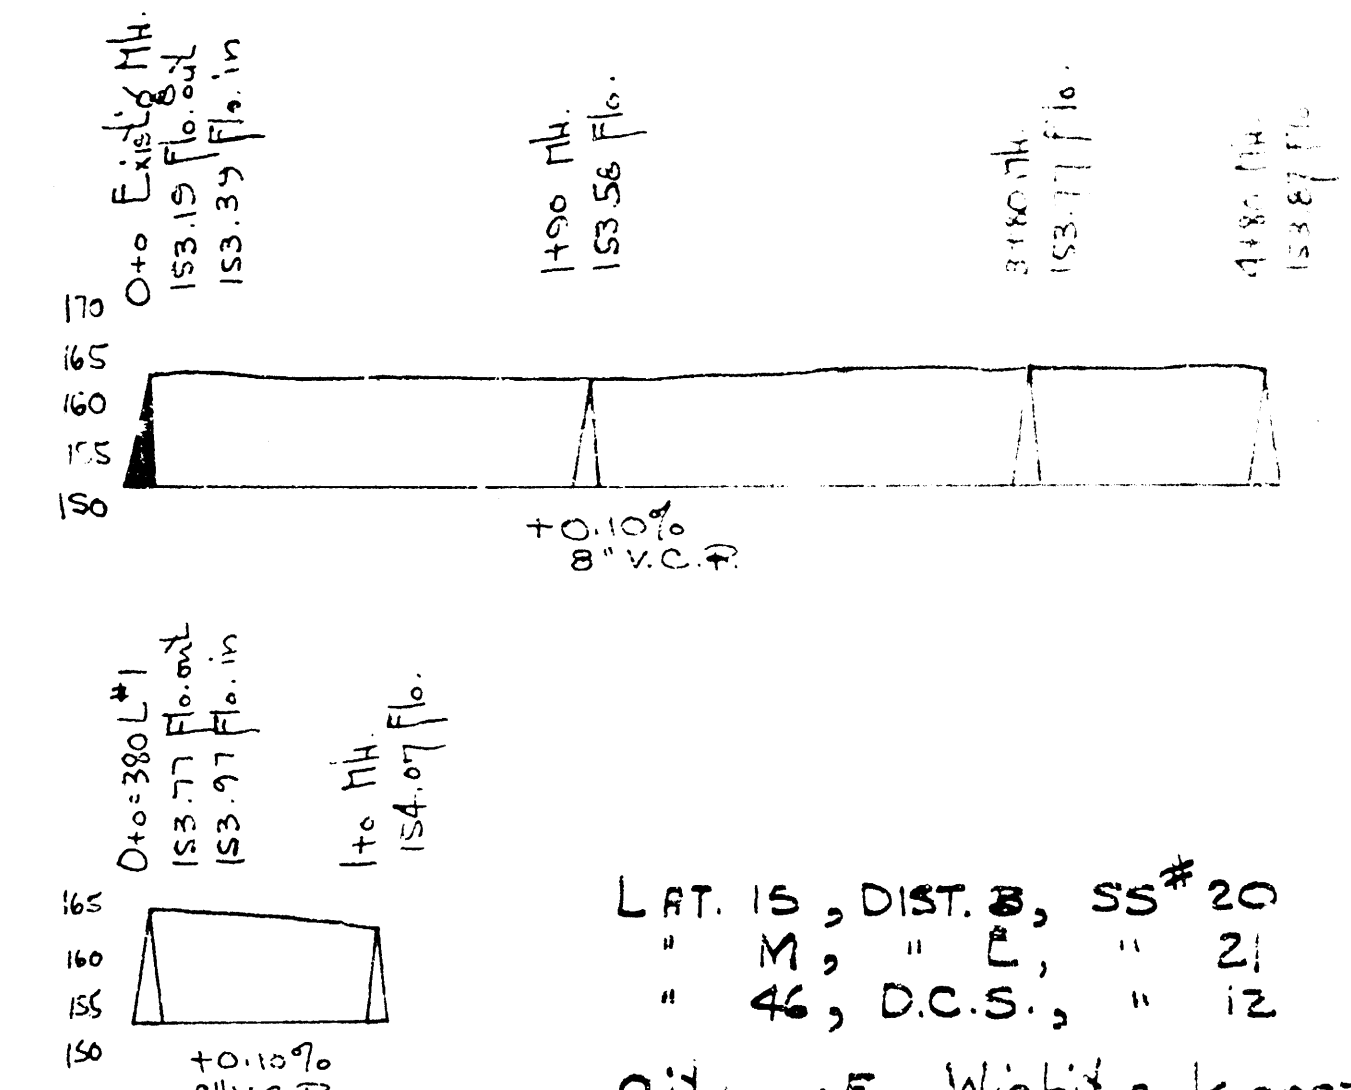
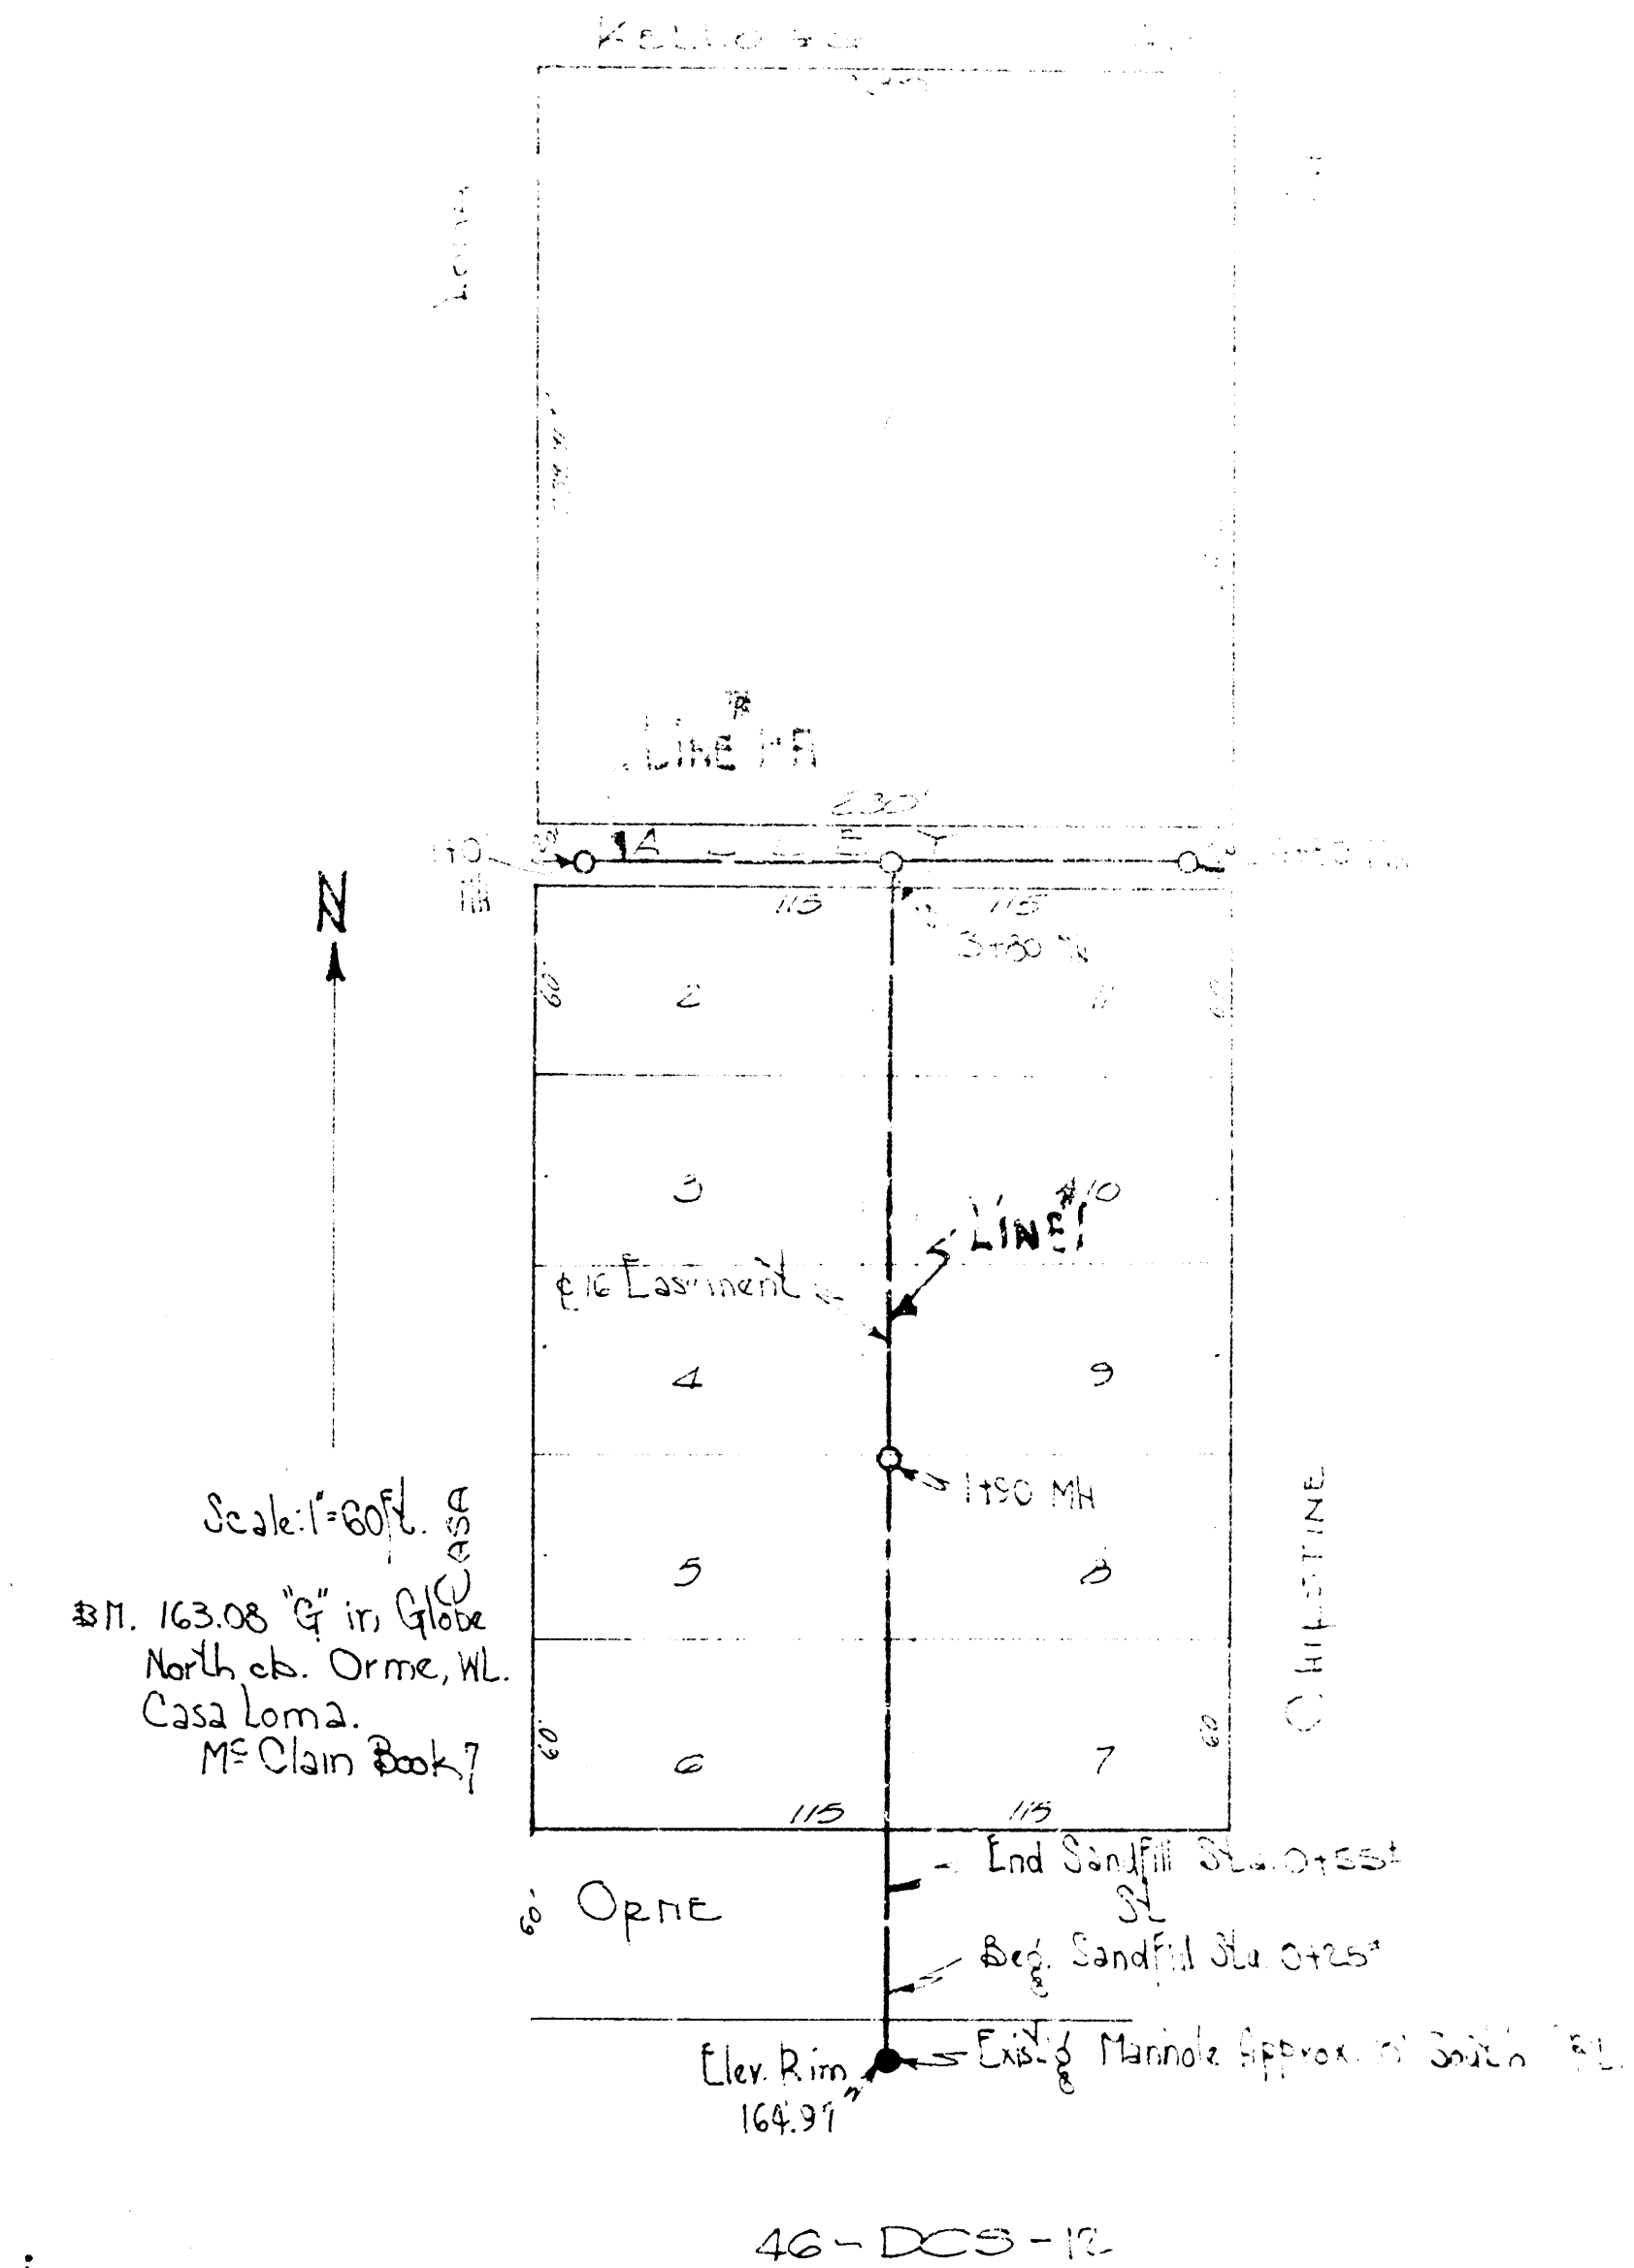
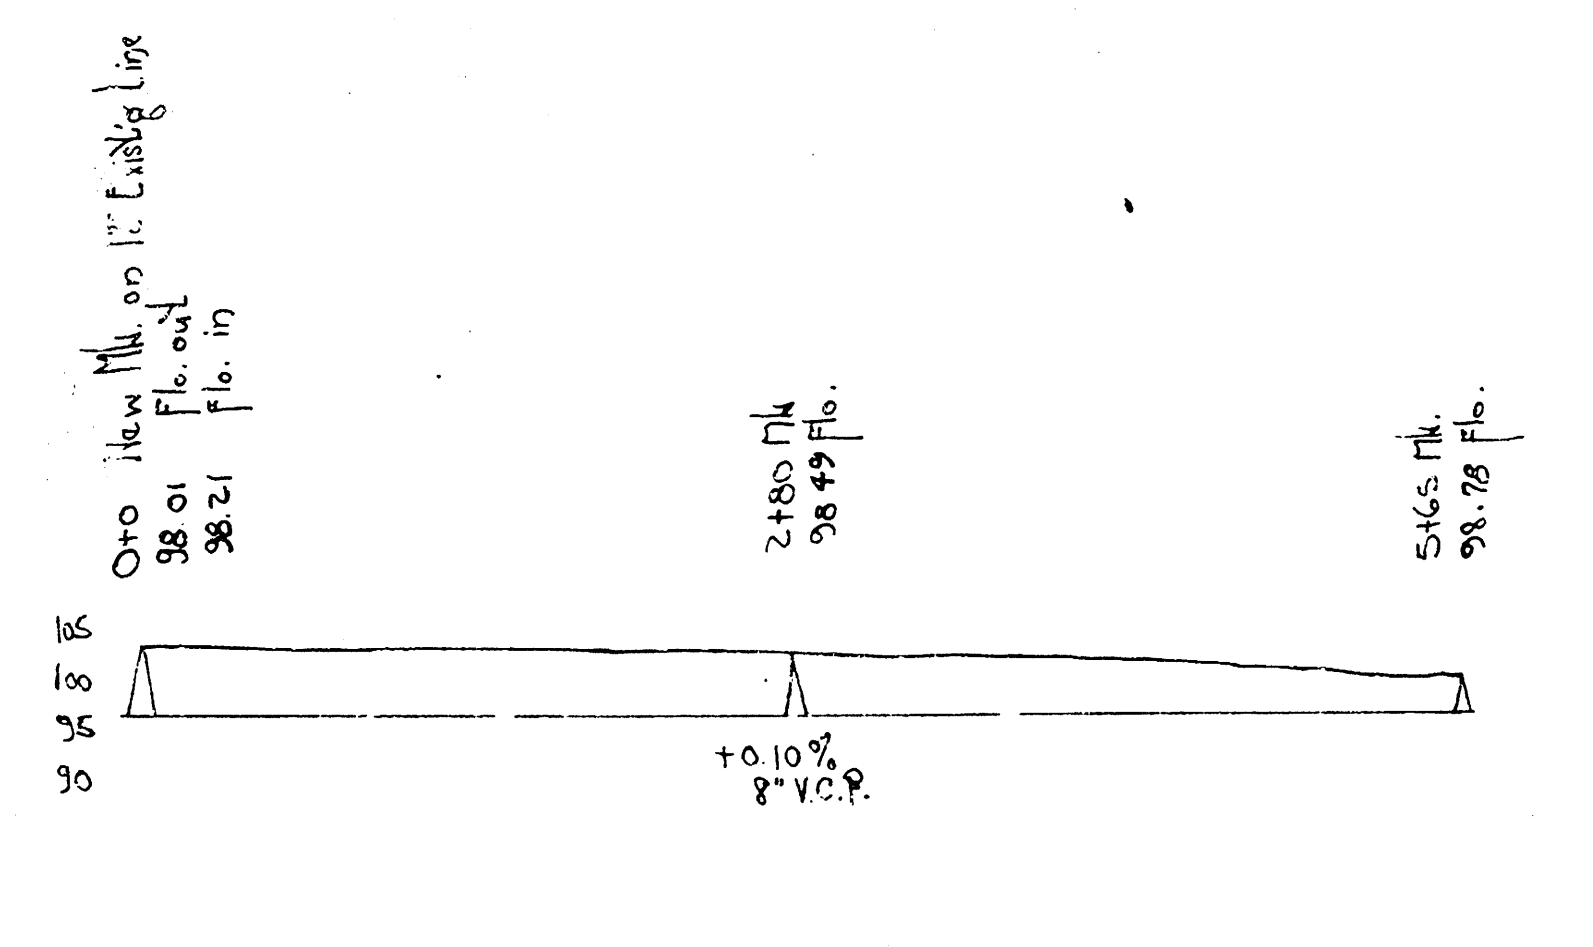
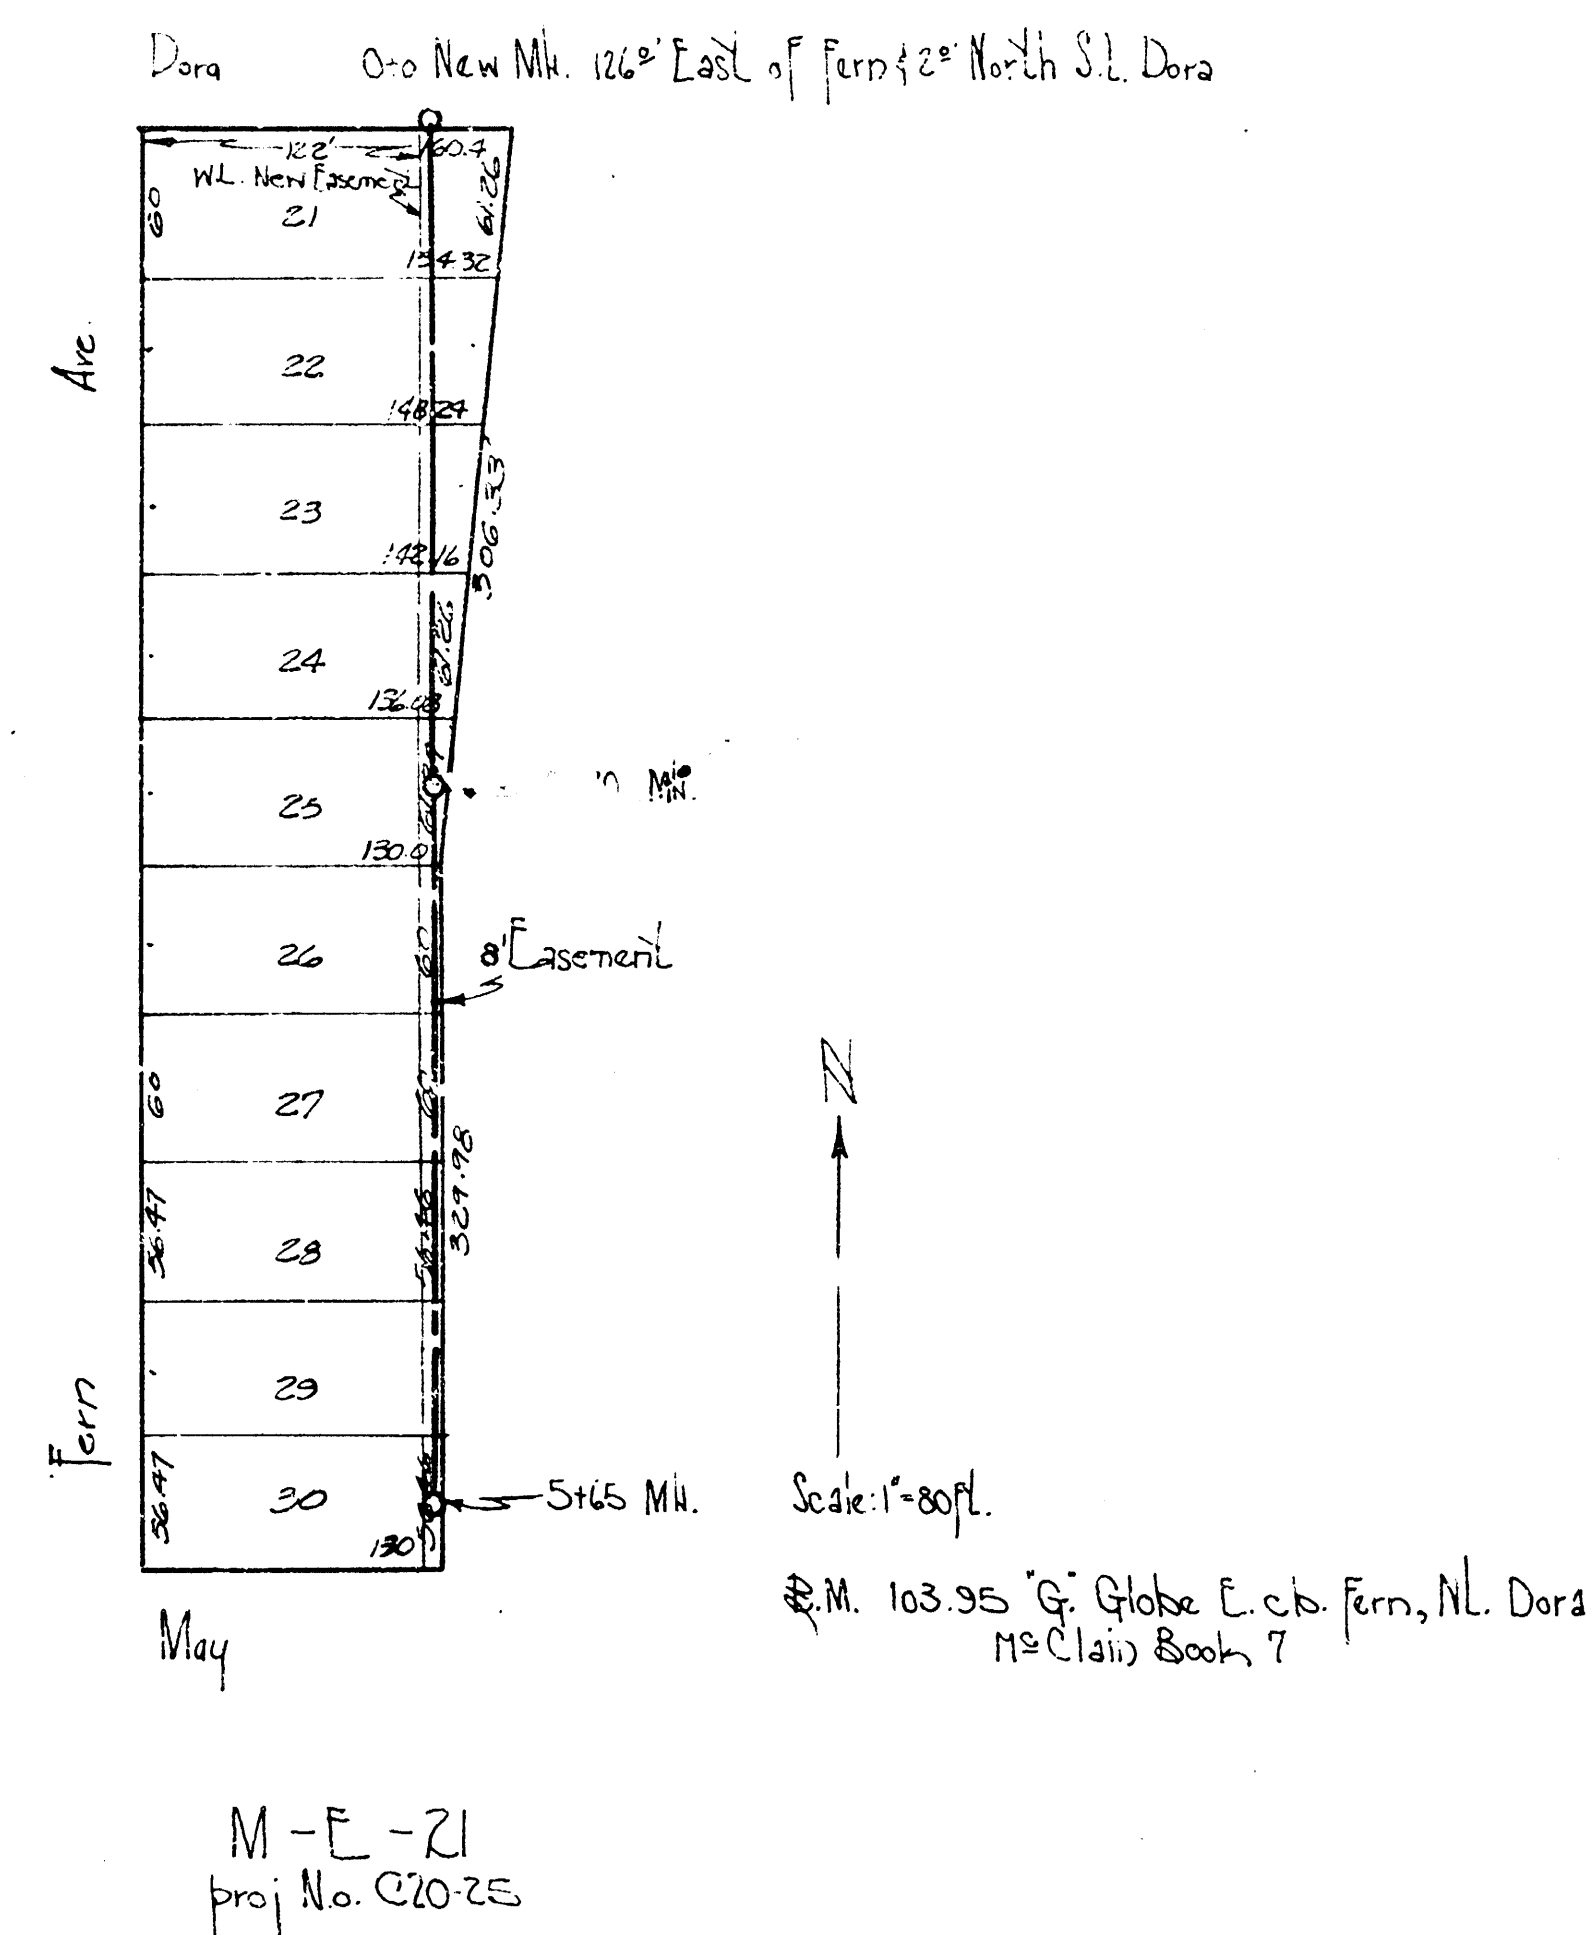


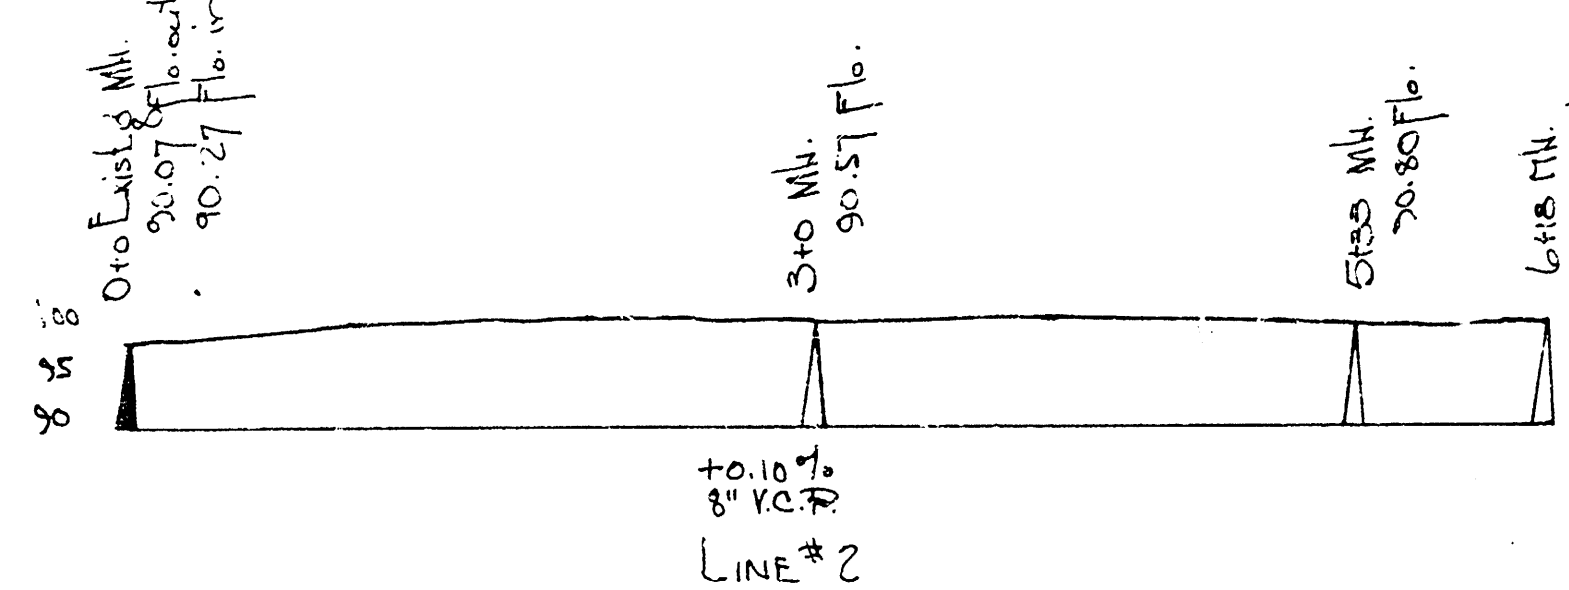

15 - E - 20  
C20-34

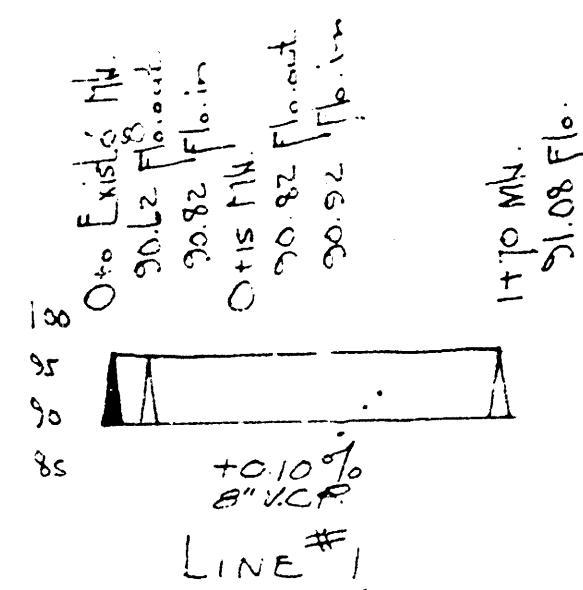

LAT. 15, DIST. 2, SS# 20  
" M, " E, " 21  
" 42, D.C.S., " 12  
City of Wichita, Kansas  
L.W. White - City Engineer  
Date 5-25-50