
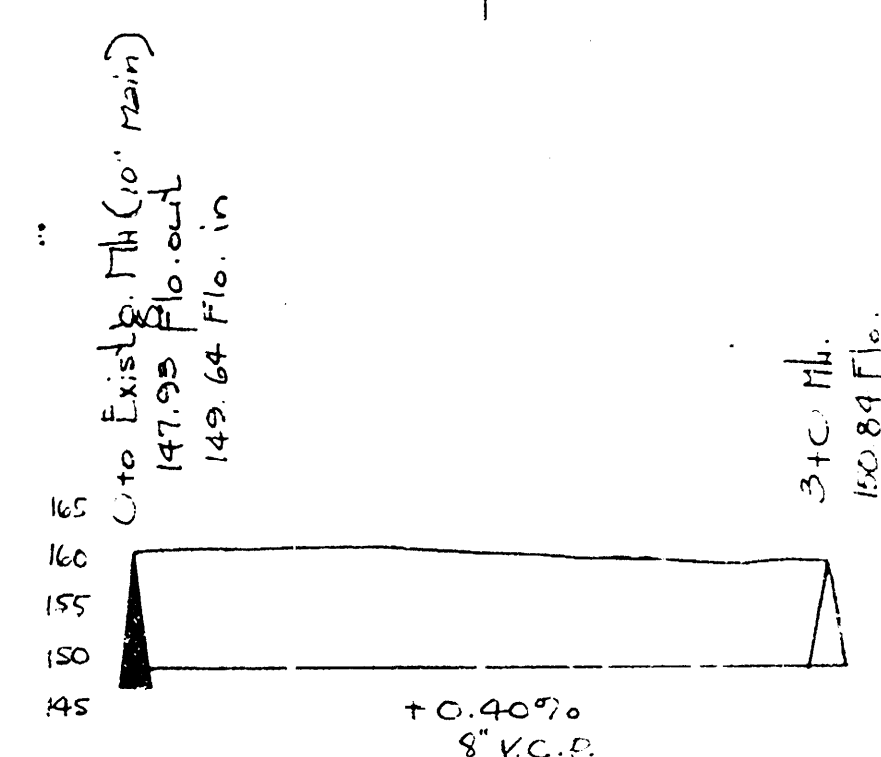
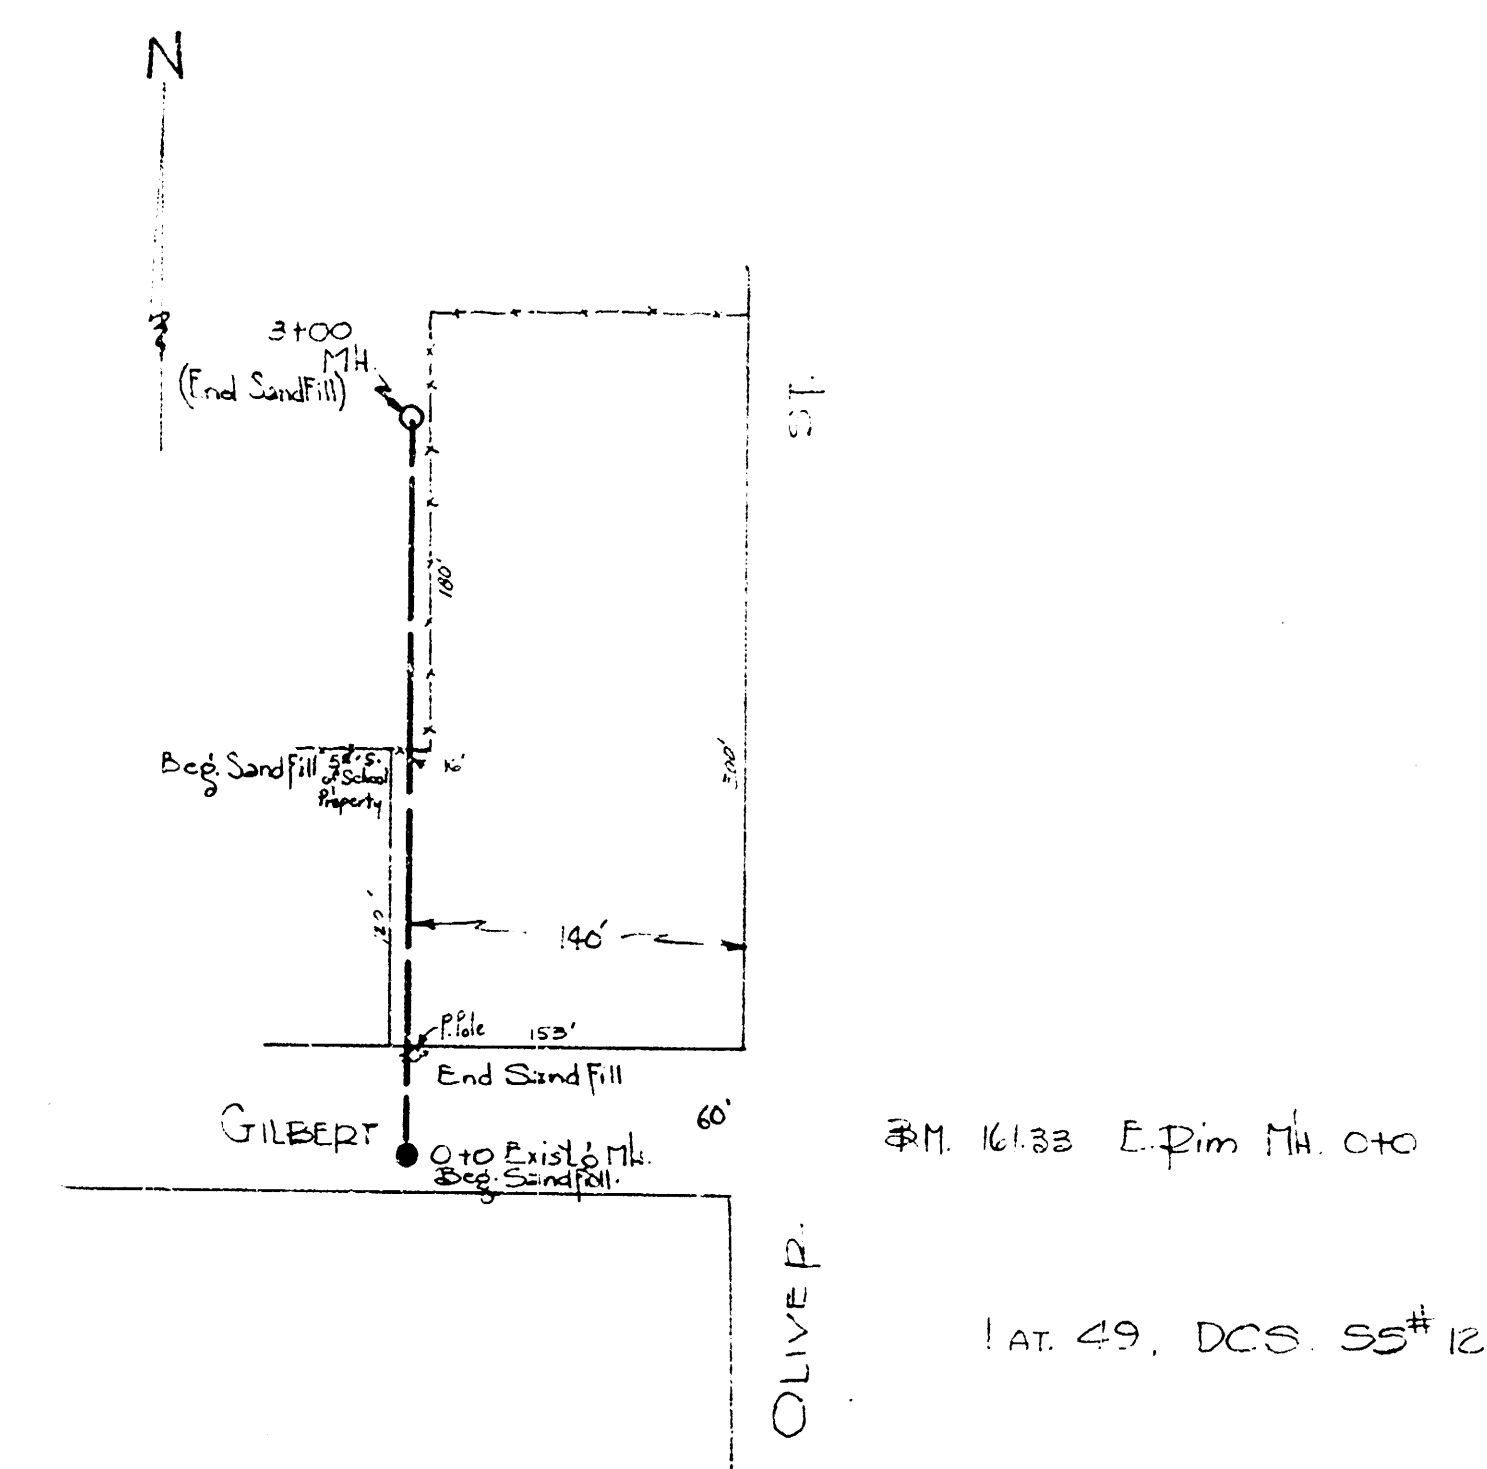
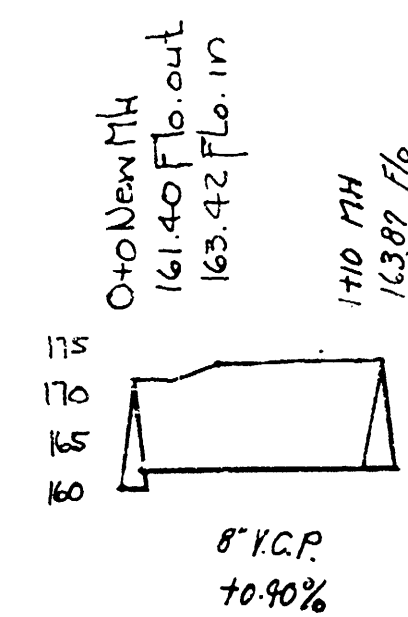
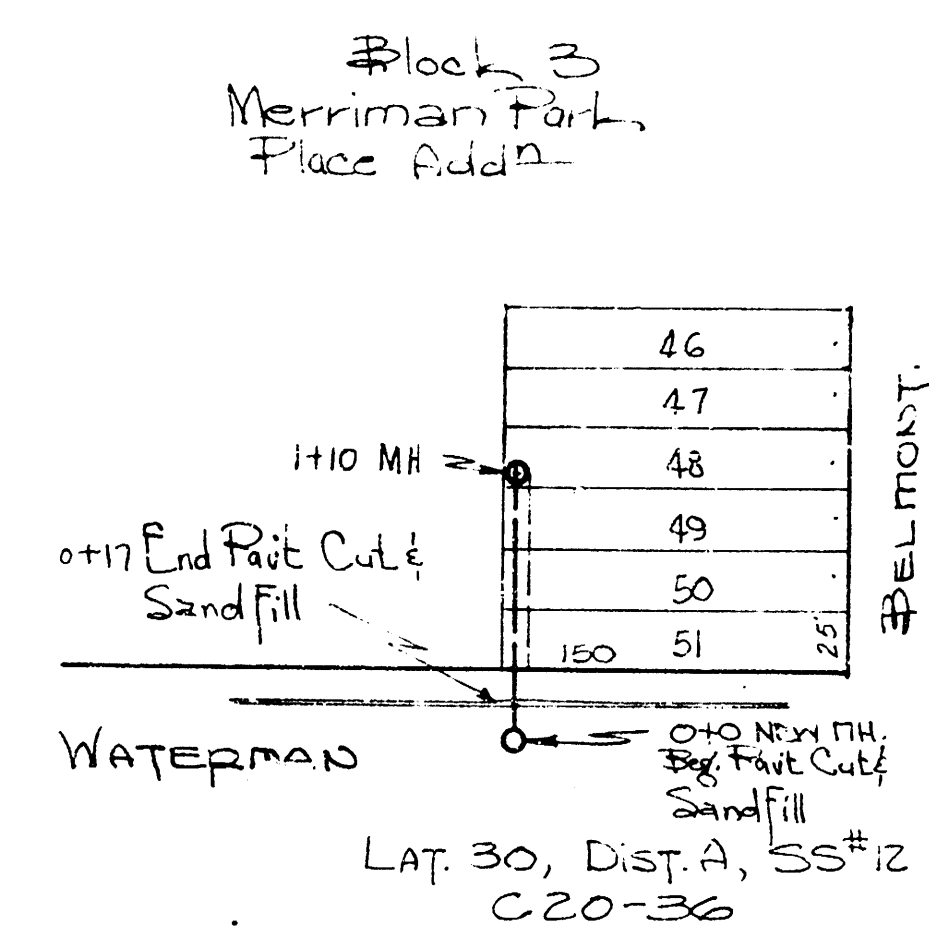
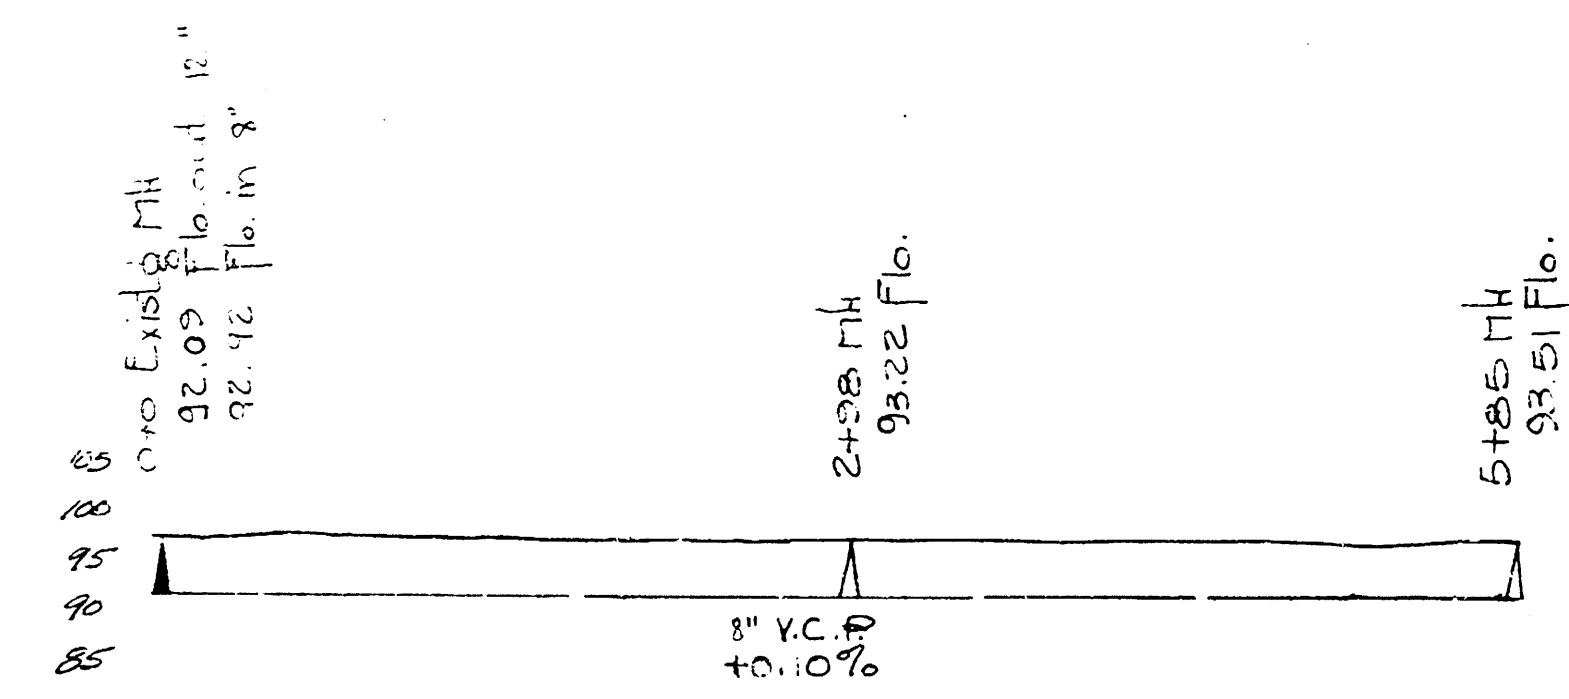


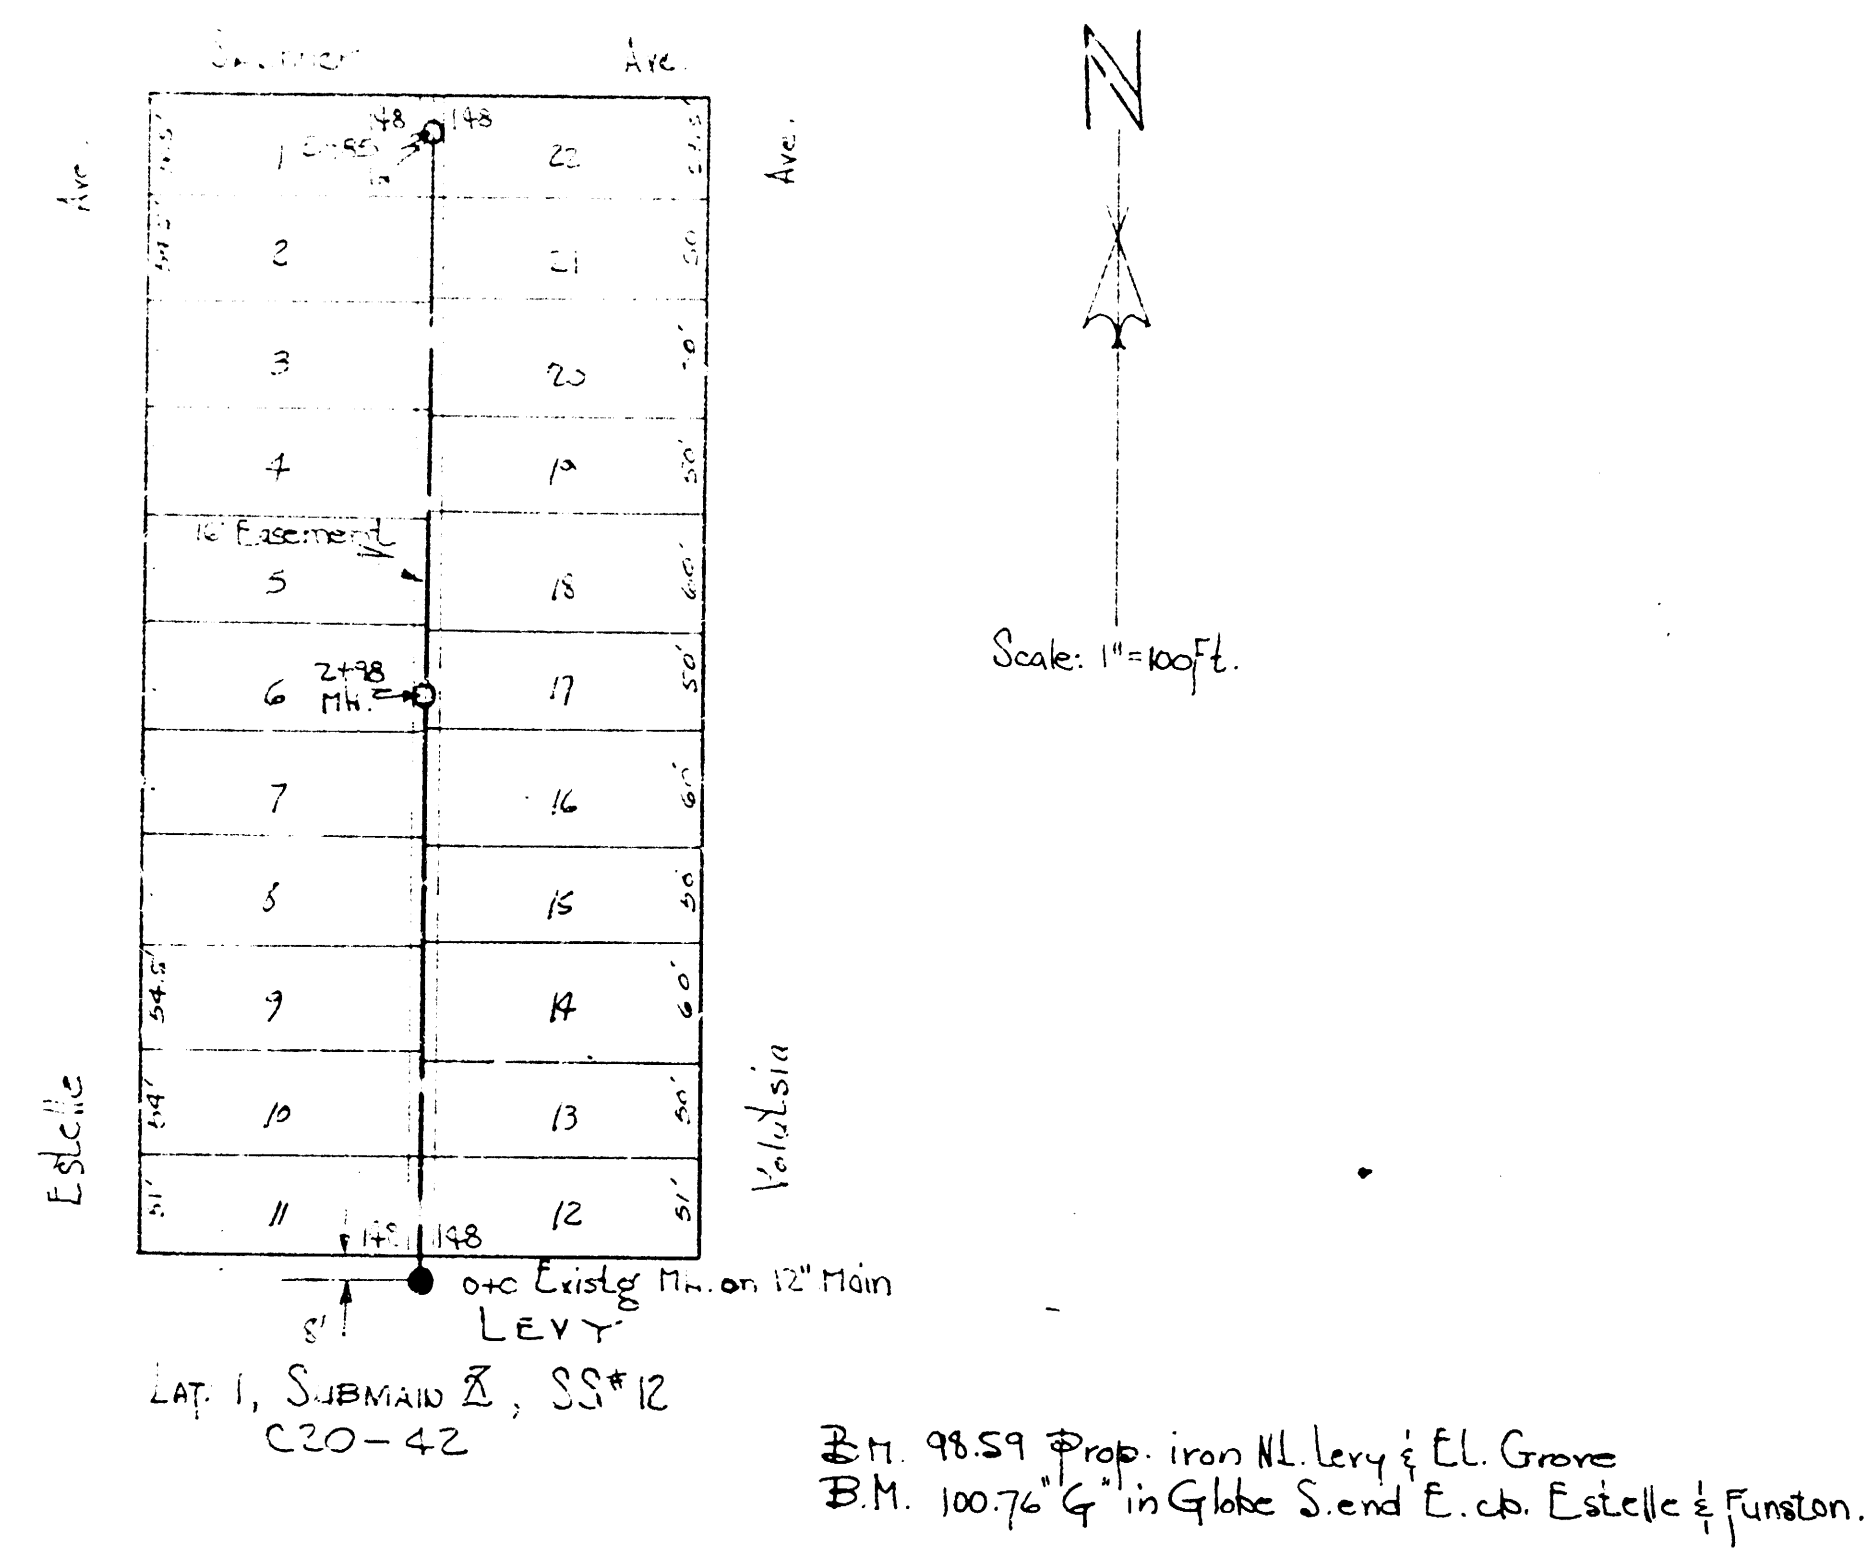

LAT. 49, D.C.S. SS#12
LAT. 30, DISTRICT A, SANITARY SEWER #12
LAT. 1, SUBMAIN Z, SANITARY SEWER #12
CITY OF NICHITA, KANSAS
L.K. White City Engineer
DATE 5-24-50 Proj. No. C20