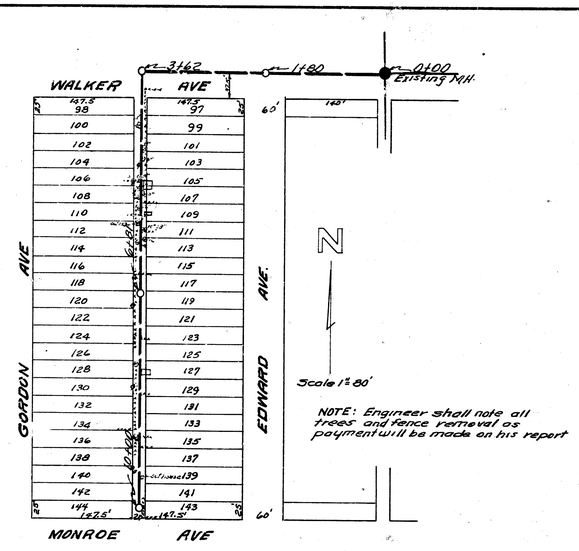
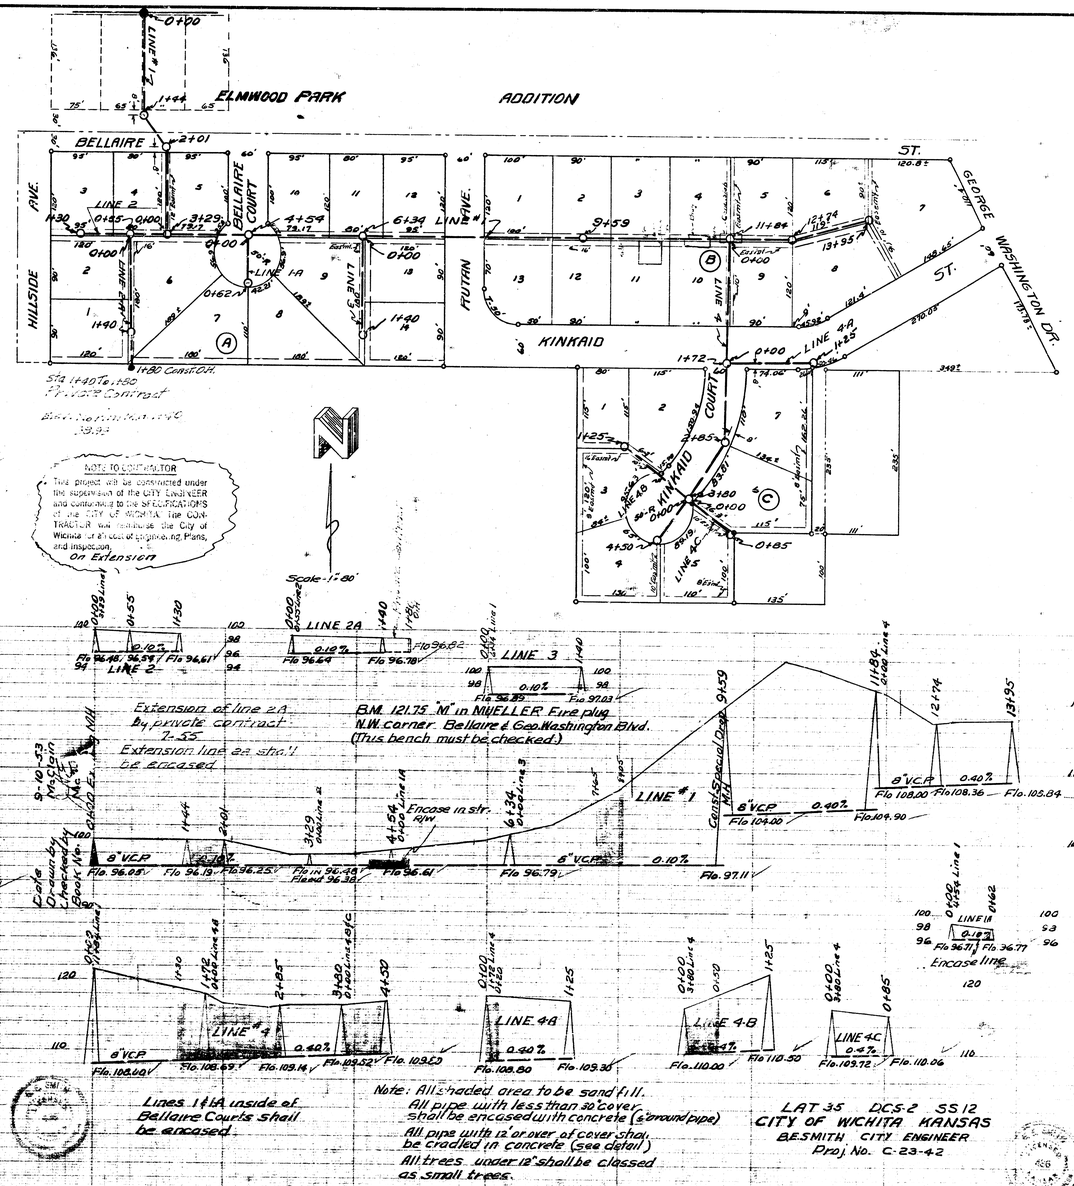

WALKER AVE
MONROE AVE
GORDON AVE
EDWARD AVE
3+62
1+80
0+00
Existing MH.
Scale 1"=80'
NOTE: Engineer shall note all trees and fence removal as payment will be made on his report


ELMWOOD PARK ADDITION
BELLAIRE AVE.
BELLAIRE COURT
HILLSIDE AVE.
FUTAN AVE.
KINKAID
GEORGE WASHINGTON DR.
ST.
LINE 1
LINE 2
LINE 1A
LINE 2A
LINE 3
LINE 4
LINE 4A
LINE 4B
LINE 4C
LINE 1B
COURT
Scale 1"=80'
NOTE TO CONTRACTOR
This project will be constructed under the supervision of the CITY ENGINEER and conformance to the SPECIFICATIONS of the CITY OF WICHITA. The CONTRACTOR will reimburse the City of Wichita for all cost of engineering, Plans, and inspection.
On Extension
Extension of line 2A by private contract 7-55
Extension line 2A shall be encased
B.M. 121.75 "M" in MUELLER Fire plug N.W. corner Bellaire & Geo. Washington Blvd. (This bench must be checked.)
Encase in str. row
Encase line
Note: All shaded area to be sand fill.
All pipe with less than 30" cover shall be encased with concrete (4" around pipe)
All pipe with 12' or over of cover shall be cradled in concrete (see detail)
All trees under 12" shall be classed as small trees.
Lines 1 & 1A inside of Bellaire Courts shall be encased.
B.M. 109.01 W. Rim M.H. 0+00
Sandfill
8" V.C.P.
LAT. 10 SUB. B SS 11
CITY OF WICHITA KANSAS
B.E. SMITH CITY ENGINEER
Proj No. C-23-38
LAT. 35 DCS-2 SS 12
CITY OF WICHITA KANSAS
B.E. SMITH CITY ENGINEER
Proj No. C-23-42

1-2