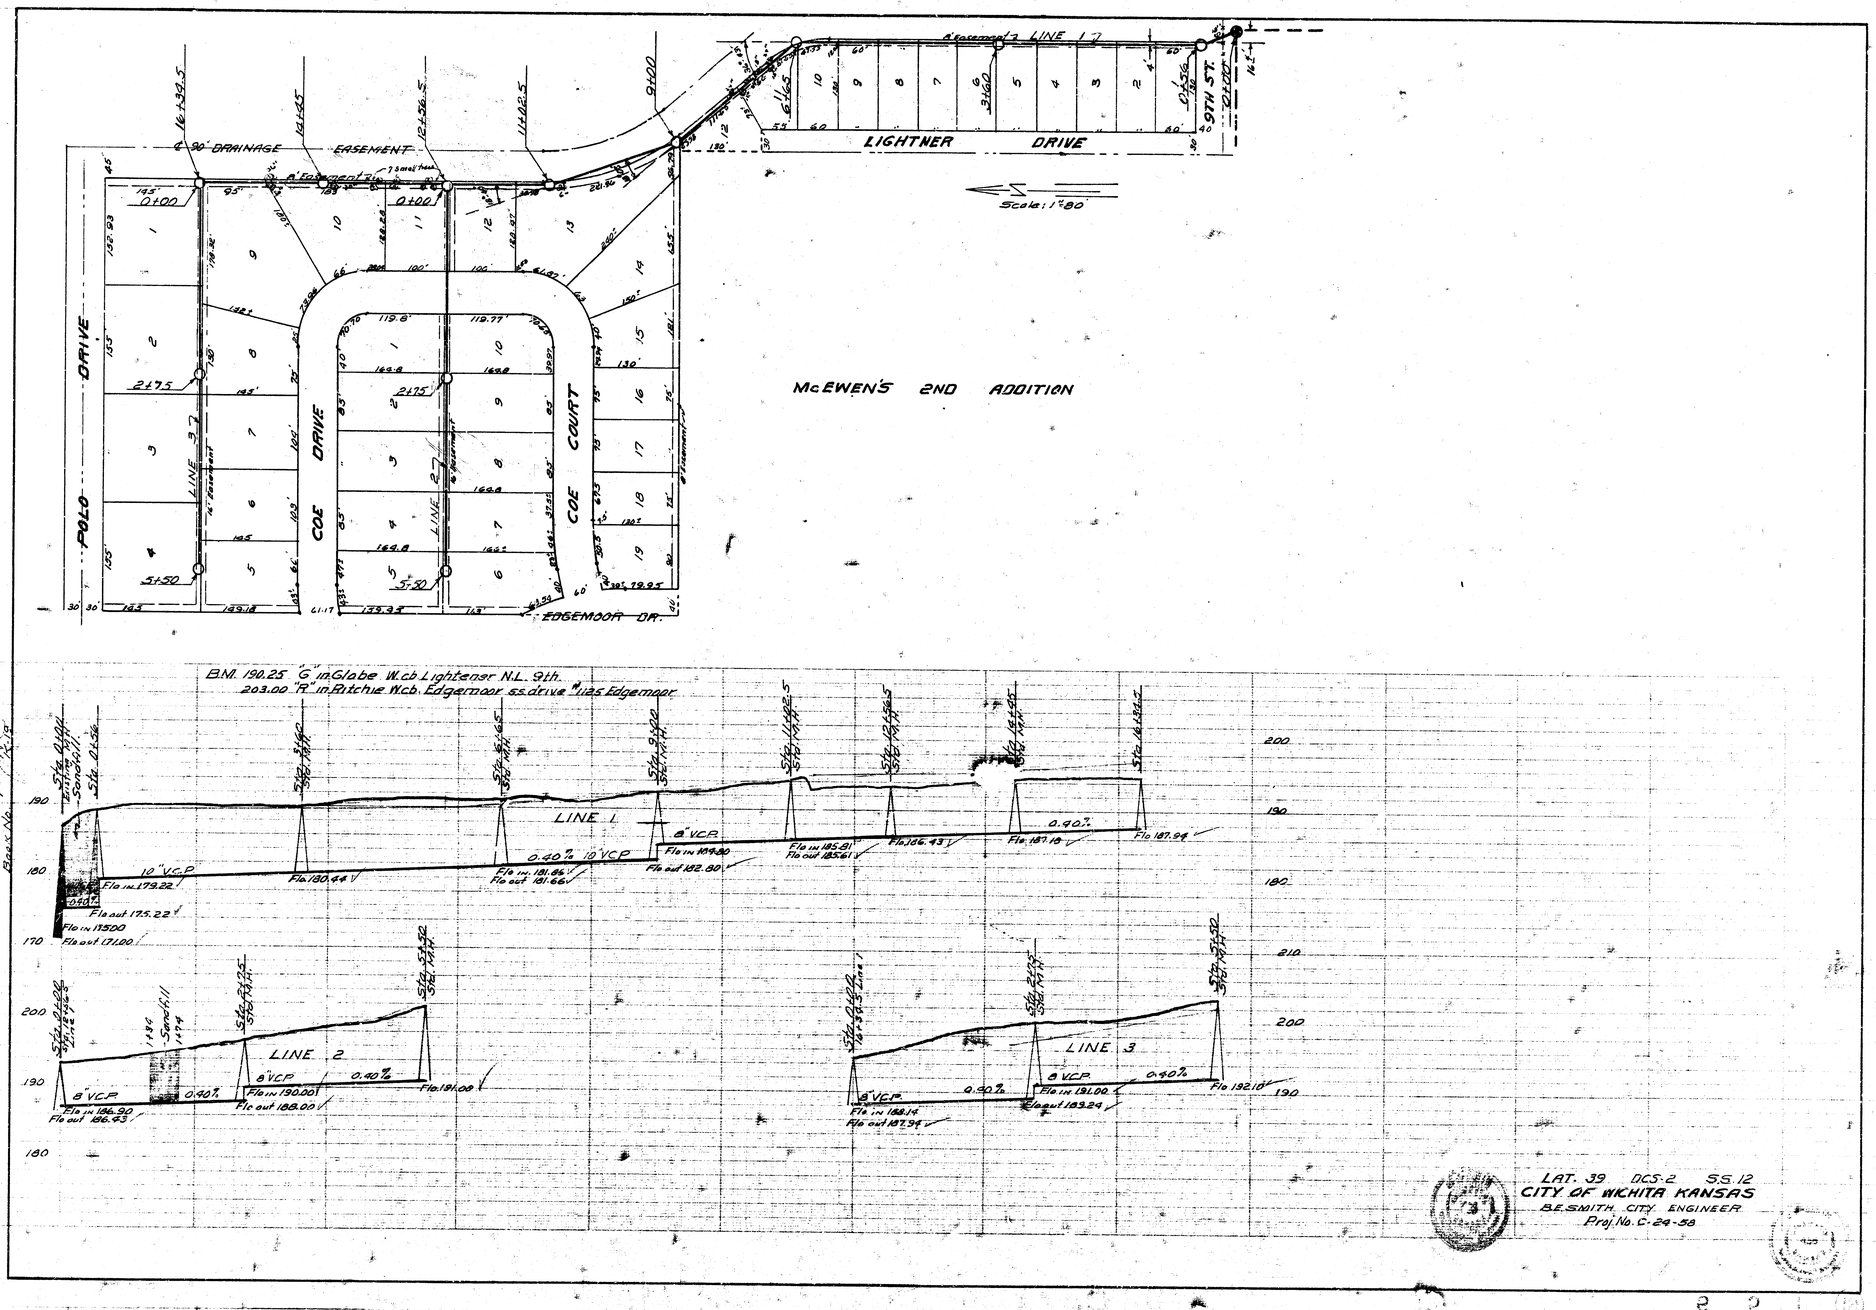

POLO DRIVE
COE DRIVE
COE COURT
EDGEMOOR DR.
LIGHTNER DRIVE
9TH ST.
6' EASEMENT
LINE 1
LINE 2
LINE 3
LINE 27
LINE 37
McEWEN'S 2ND ADDITION
Scale: 1"=80'
B.M. 190.25 "G" in Globe W.cb Lightener N.L. 9th.
203.00 "R" in Ritchie W.cb. Edgemoor s.s. drive N 1125 Edgemoor
10" V.C.P.
8" V.C.P.
0.40%
Sanch.
LAT. 39 DCS: 2 S.S. 12
CITY OF WICHITA KANSAS
B.E. SMITH, CITY ENGINEER
Proj. No. C-24-58