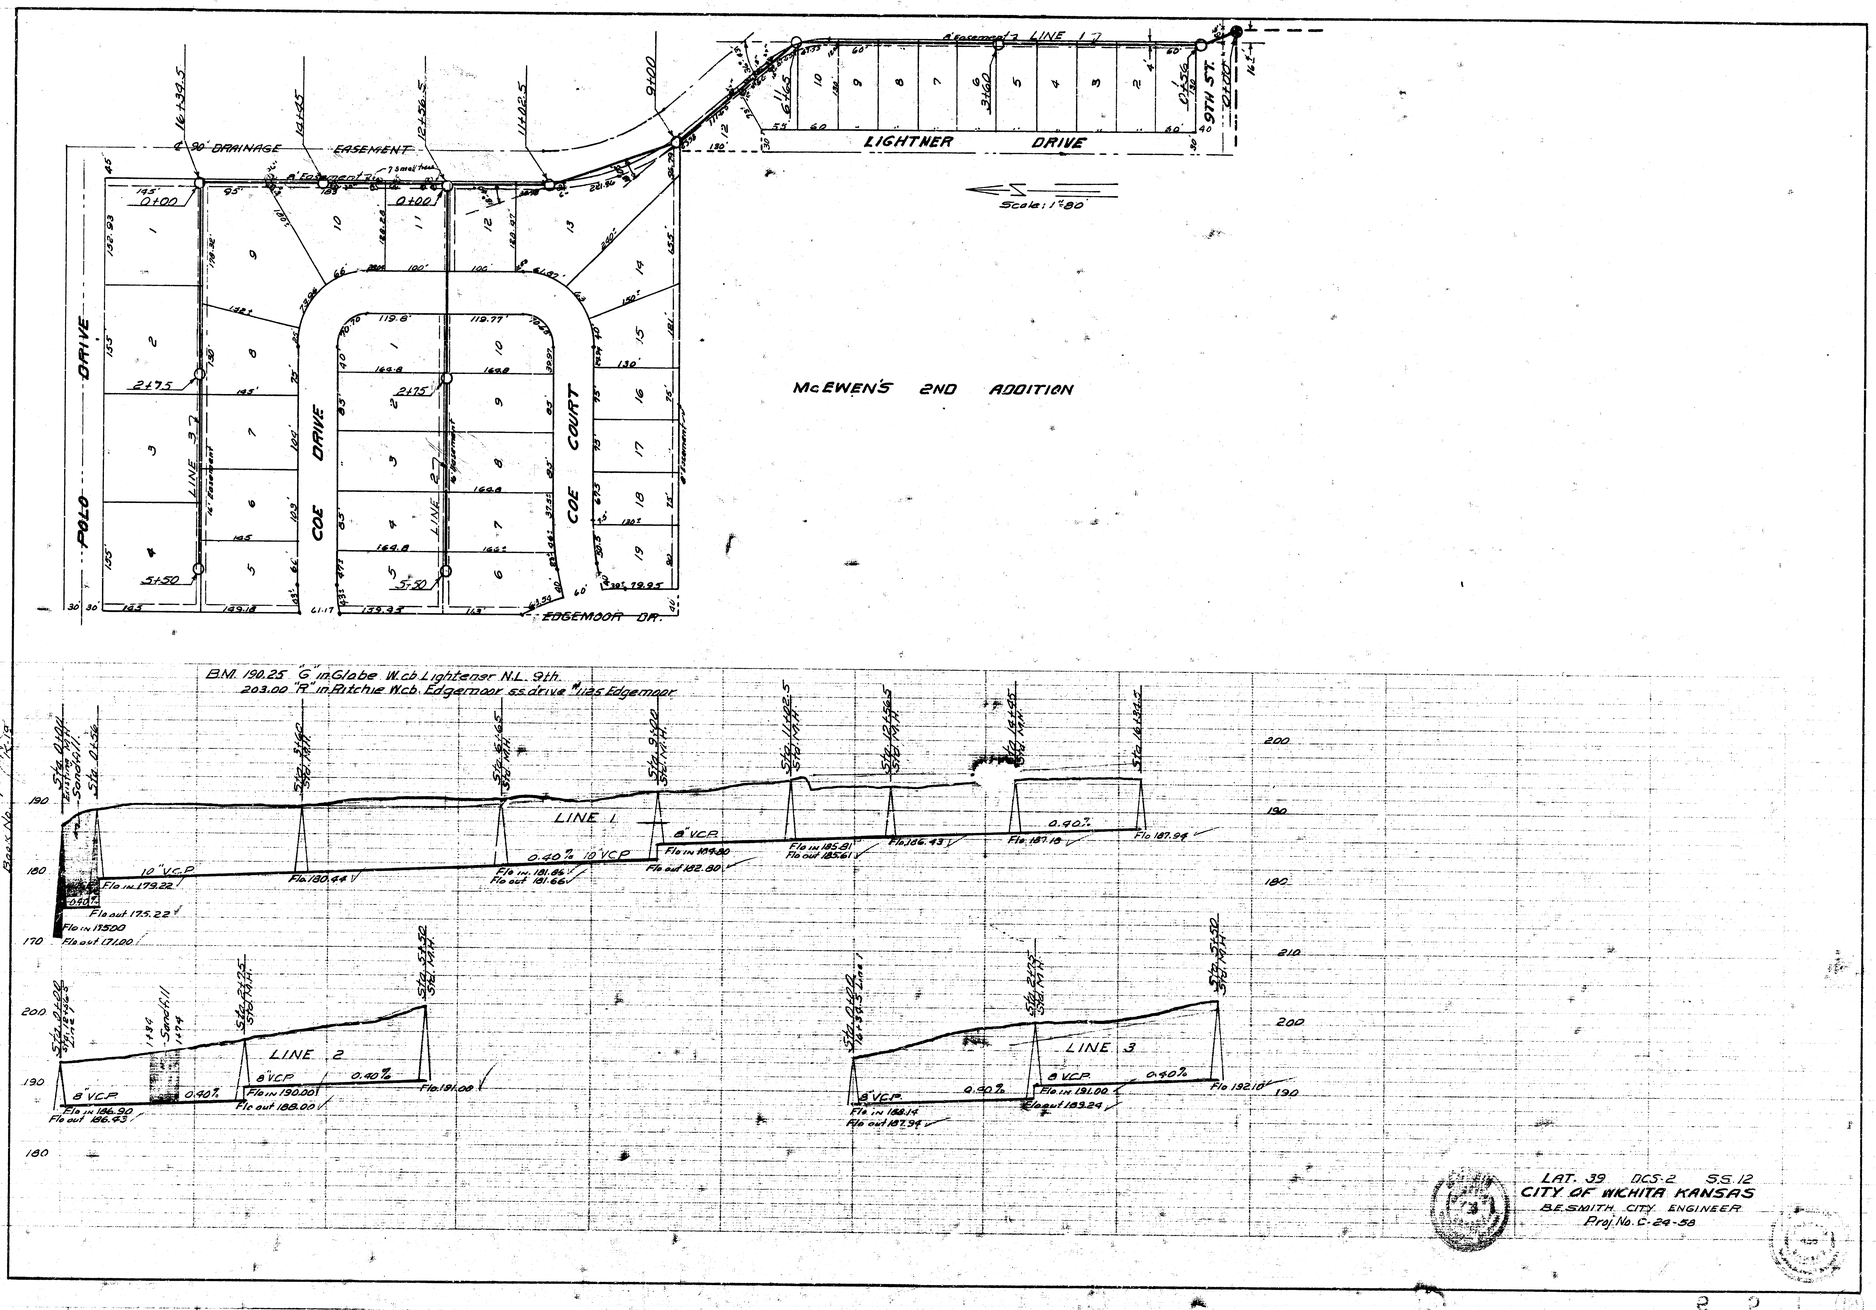
McEWEN'S 2ND ADDITION
LIGHTNER DRIVE
9TH ST.
POLO DRIVE
COE DRIVE
COE COURT
EDGEMOOR DR.
4' EASEMENT
LINE 37
LINE 27
6' EASEMENT
Scale: 1"=80'
B.M. 190.25 "G" in Globe W.cb Lightner N.L. 9th.
203.00 "R" in Ritchie Wcb. Edgemoor s.s. drive N 1125 Edgemoor
LINE 1
LINE 2
LINE 3
8" V.C.P.
10" V.C.P.
0.40%
Flo in 179.22
Flo out 175.22
Flo in 175.00
Flo out 171.00
Flo in 181.66
Flo out 181.66
Flo in 189.30
Flo out 182.90
Flo in 185.81
Flo out 185.81
Flo 186.43
Flo 187.18
Flo 187.94
Flo in 186.90
Flo out 186.43
Flo in 190.00
Flo out 188.00
Flo 191.00
Flo in 188.14
Flo out 187.34
Flo in 191.00
Flo out 189.24
Flo 192.10
Book No.
LAT. 39 DCS: 2 S.S. 12
CITY OF WICHITA KANSAS
B.E. SMITH, CITY ENGINEER
Proj. No. C-24-58