


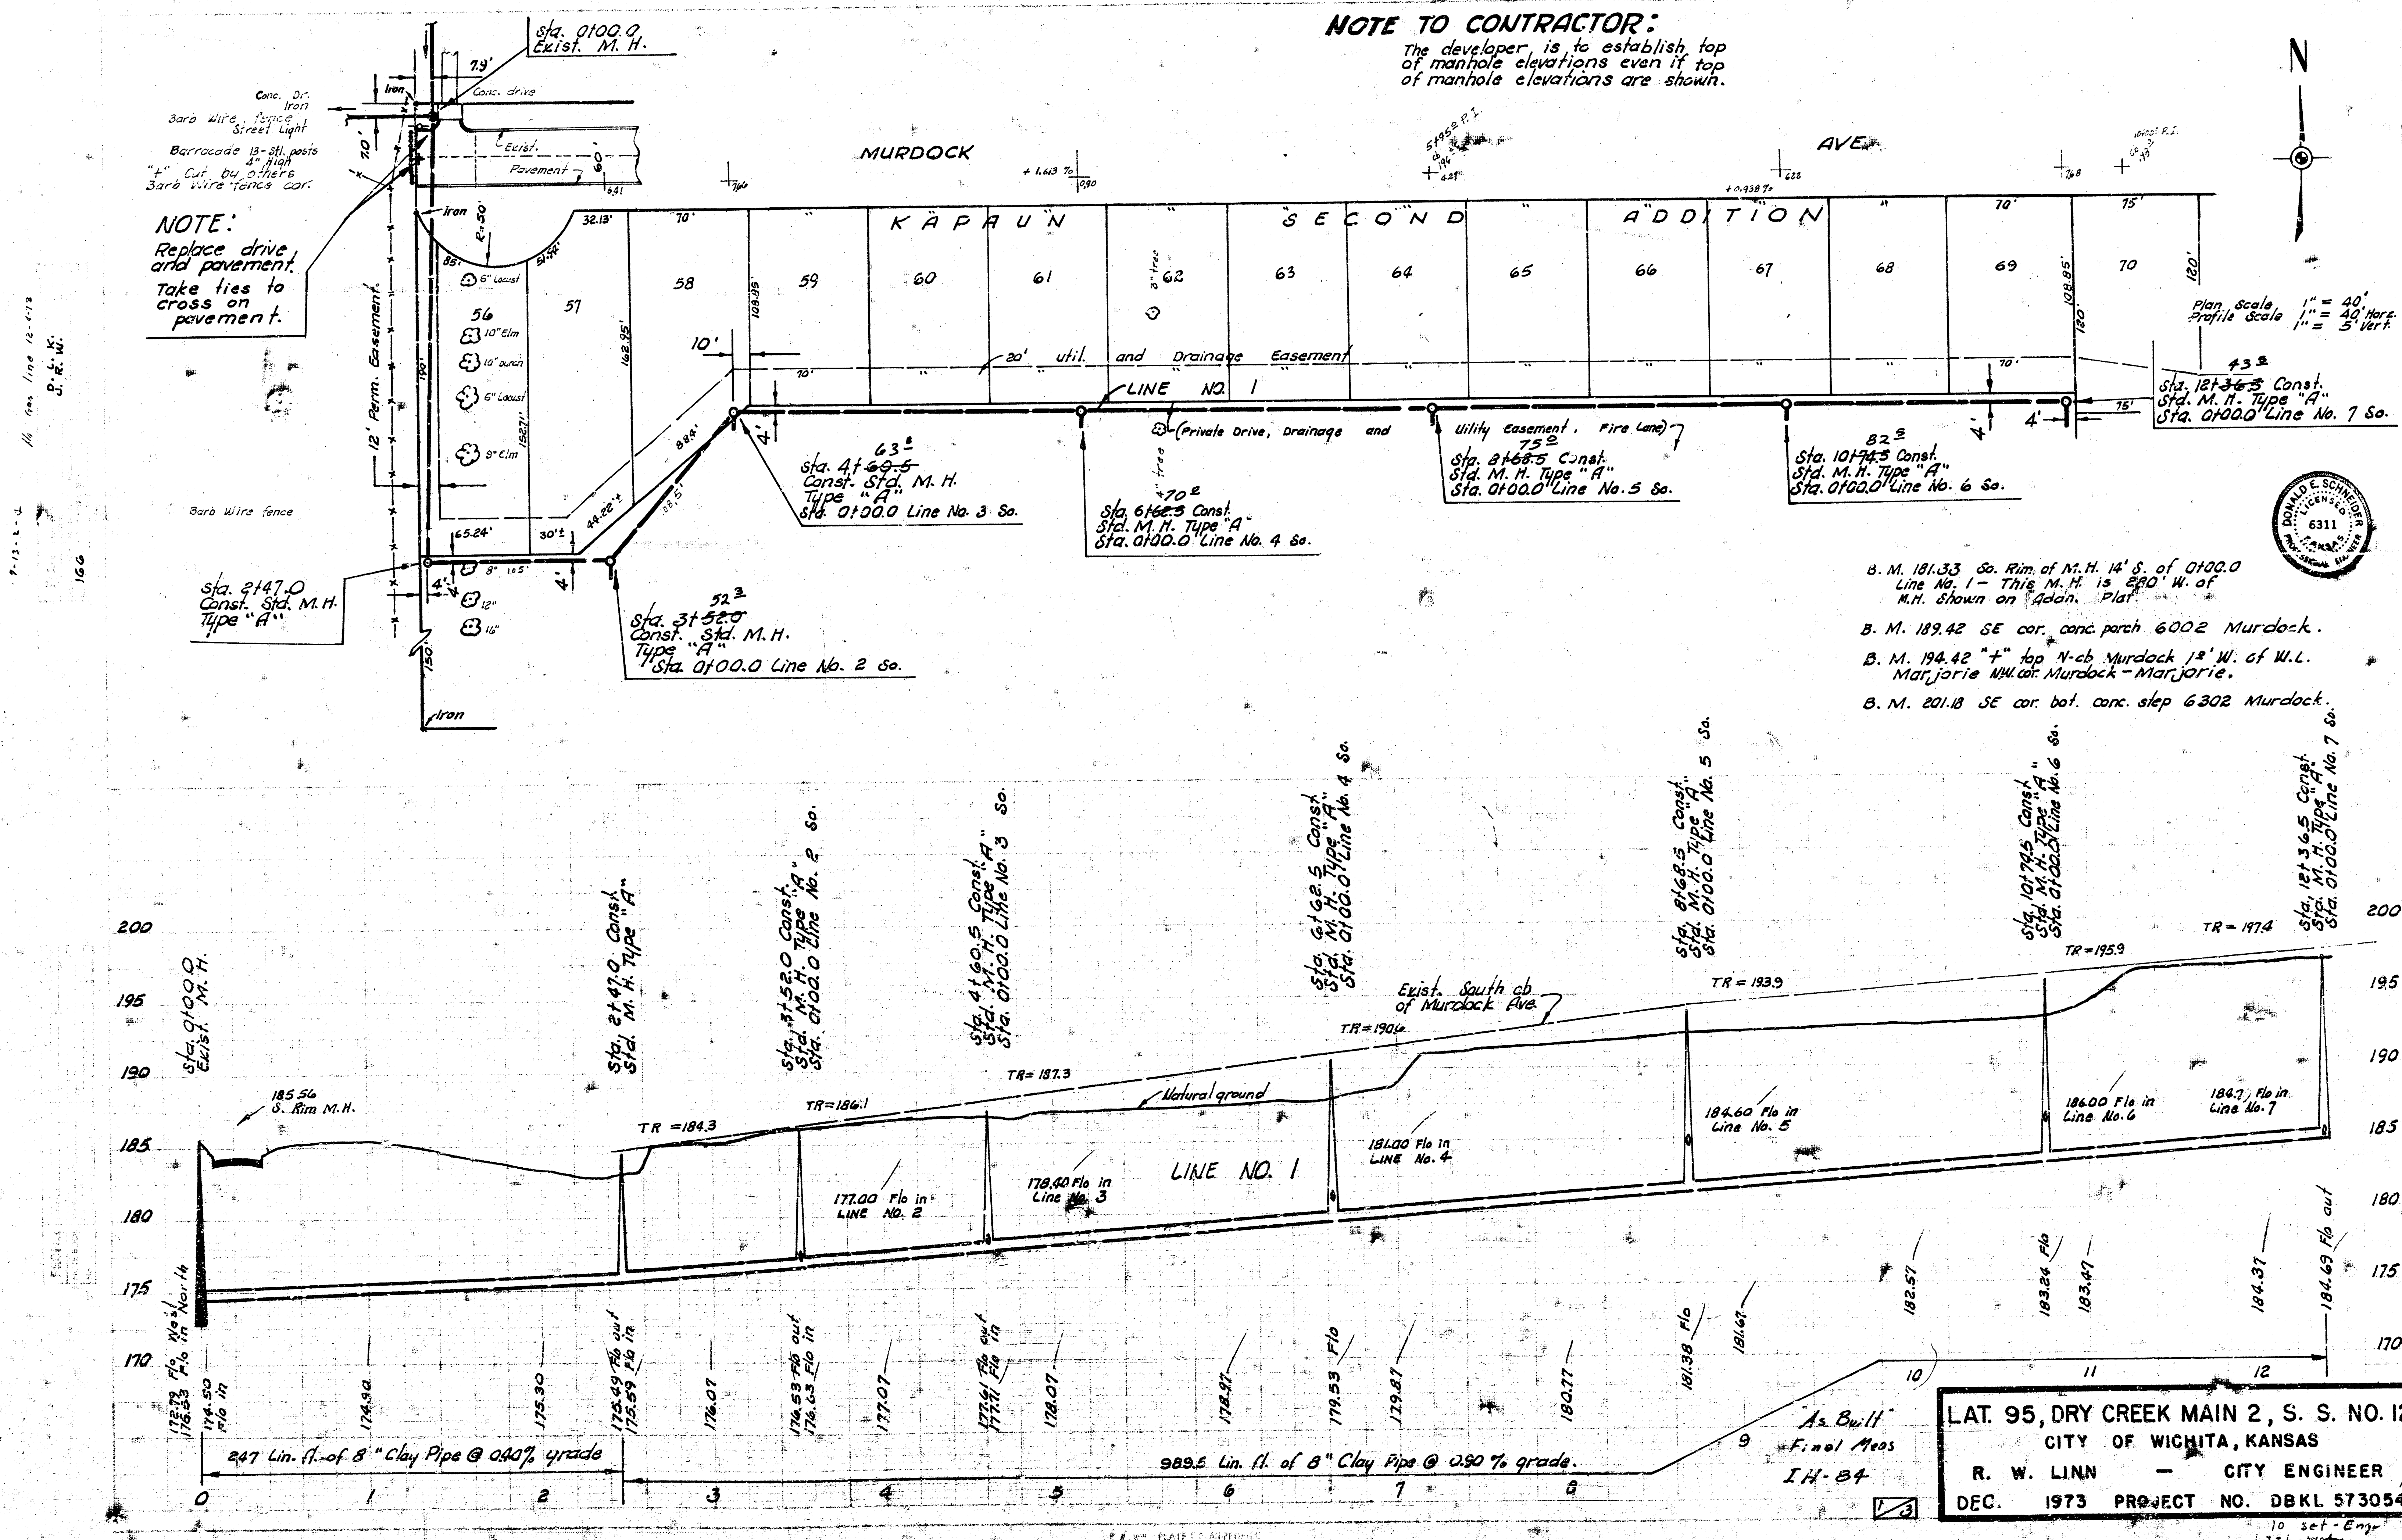
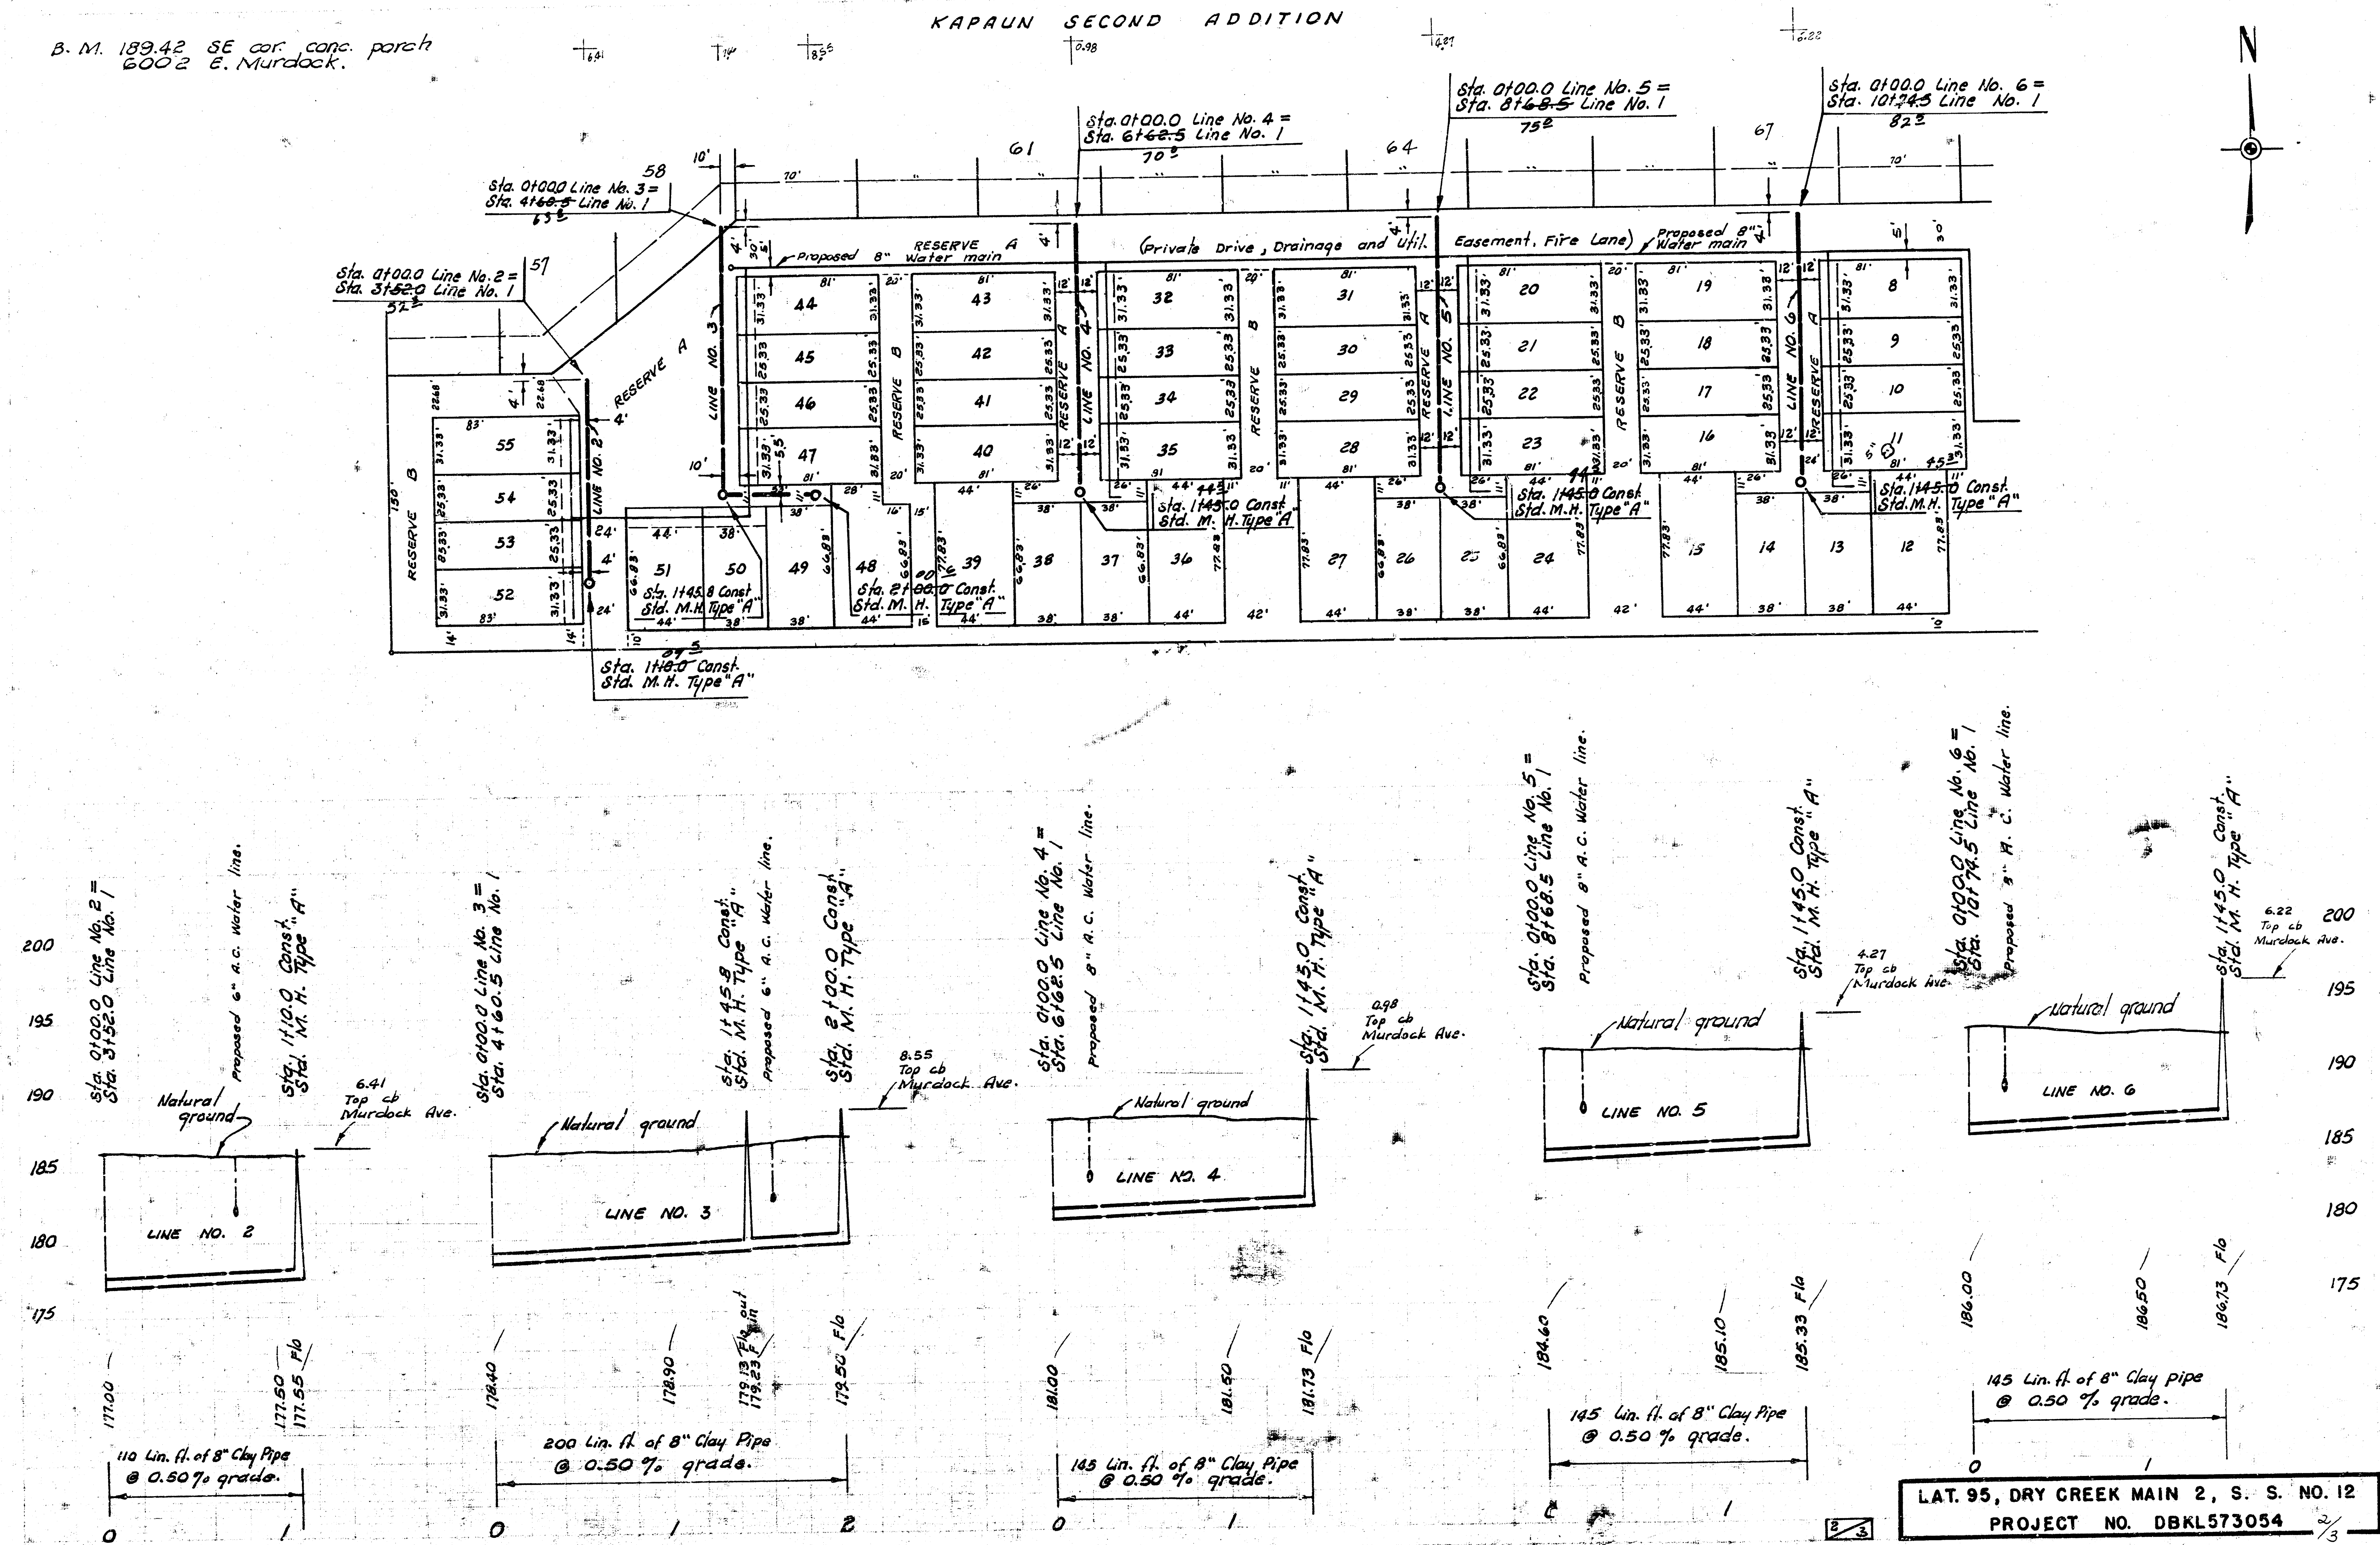
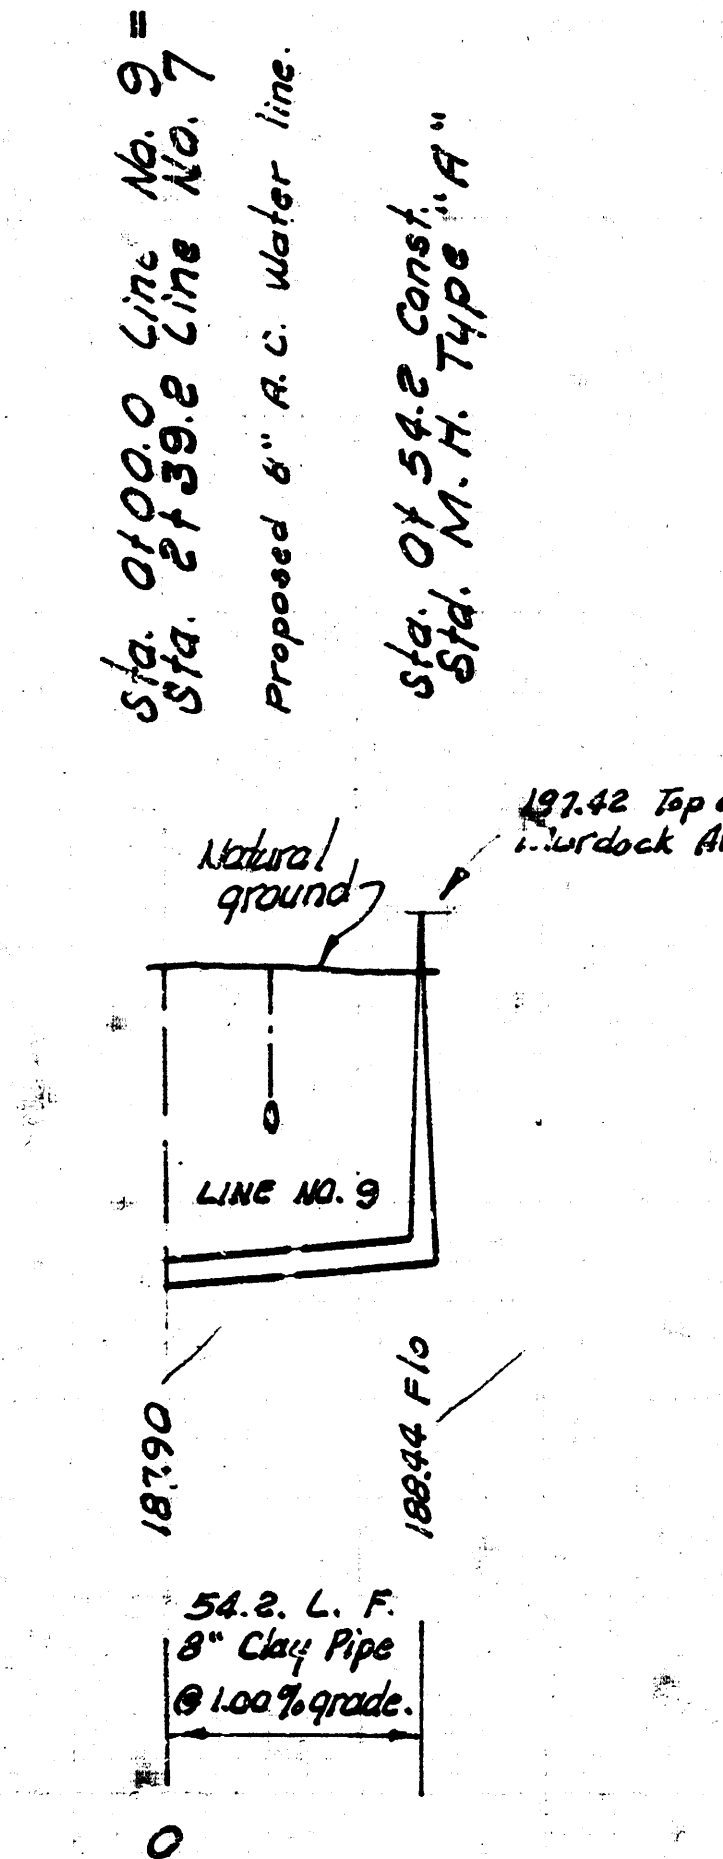


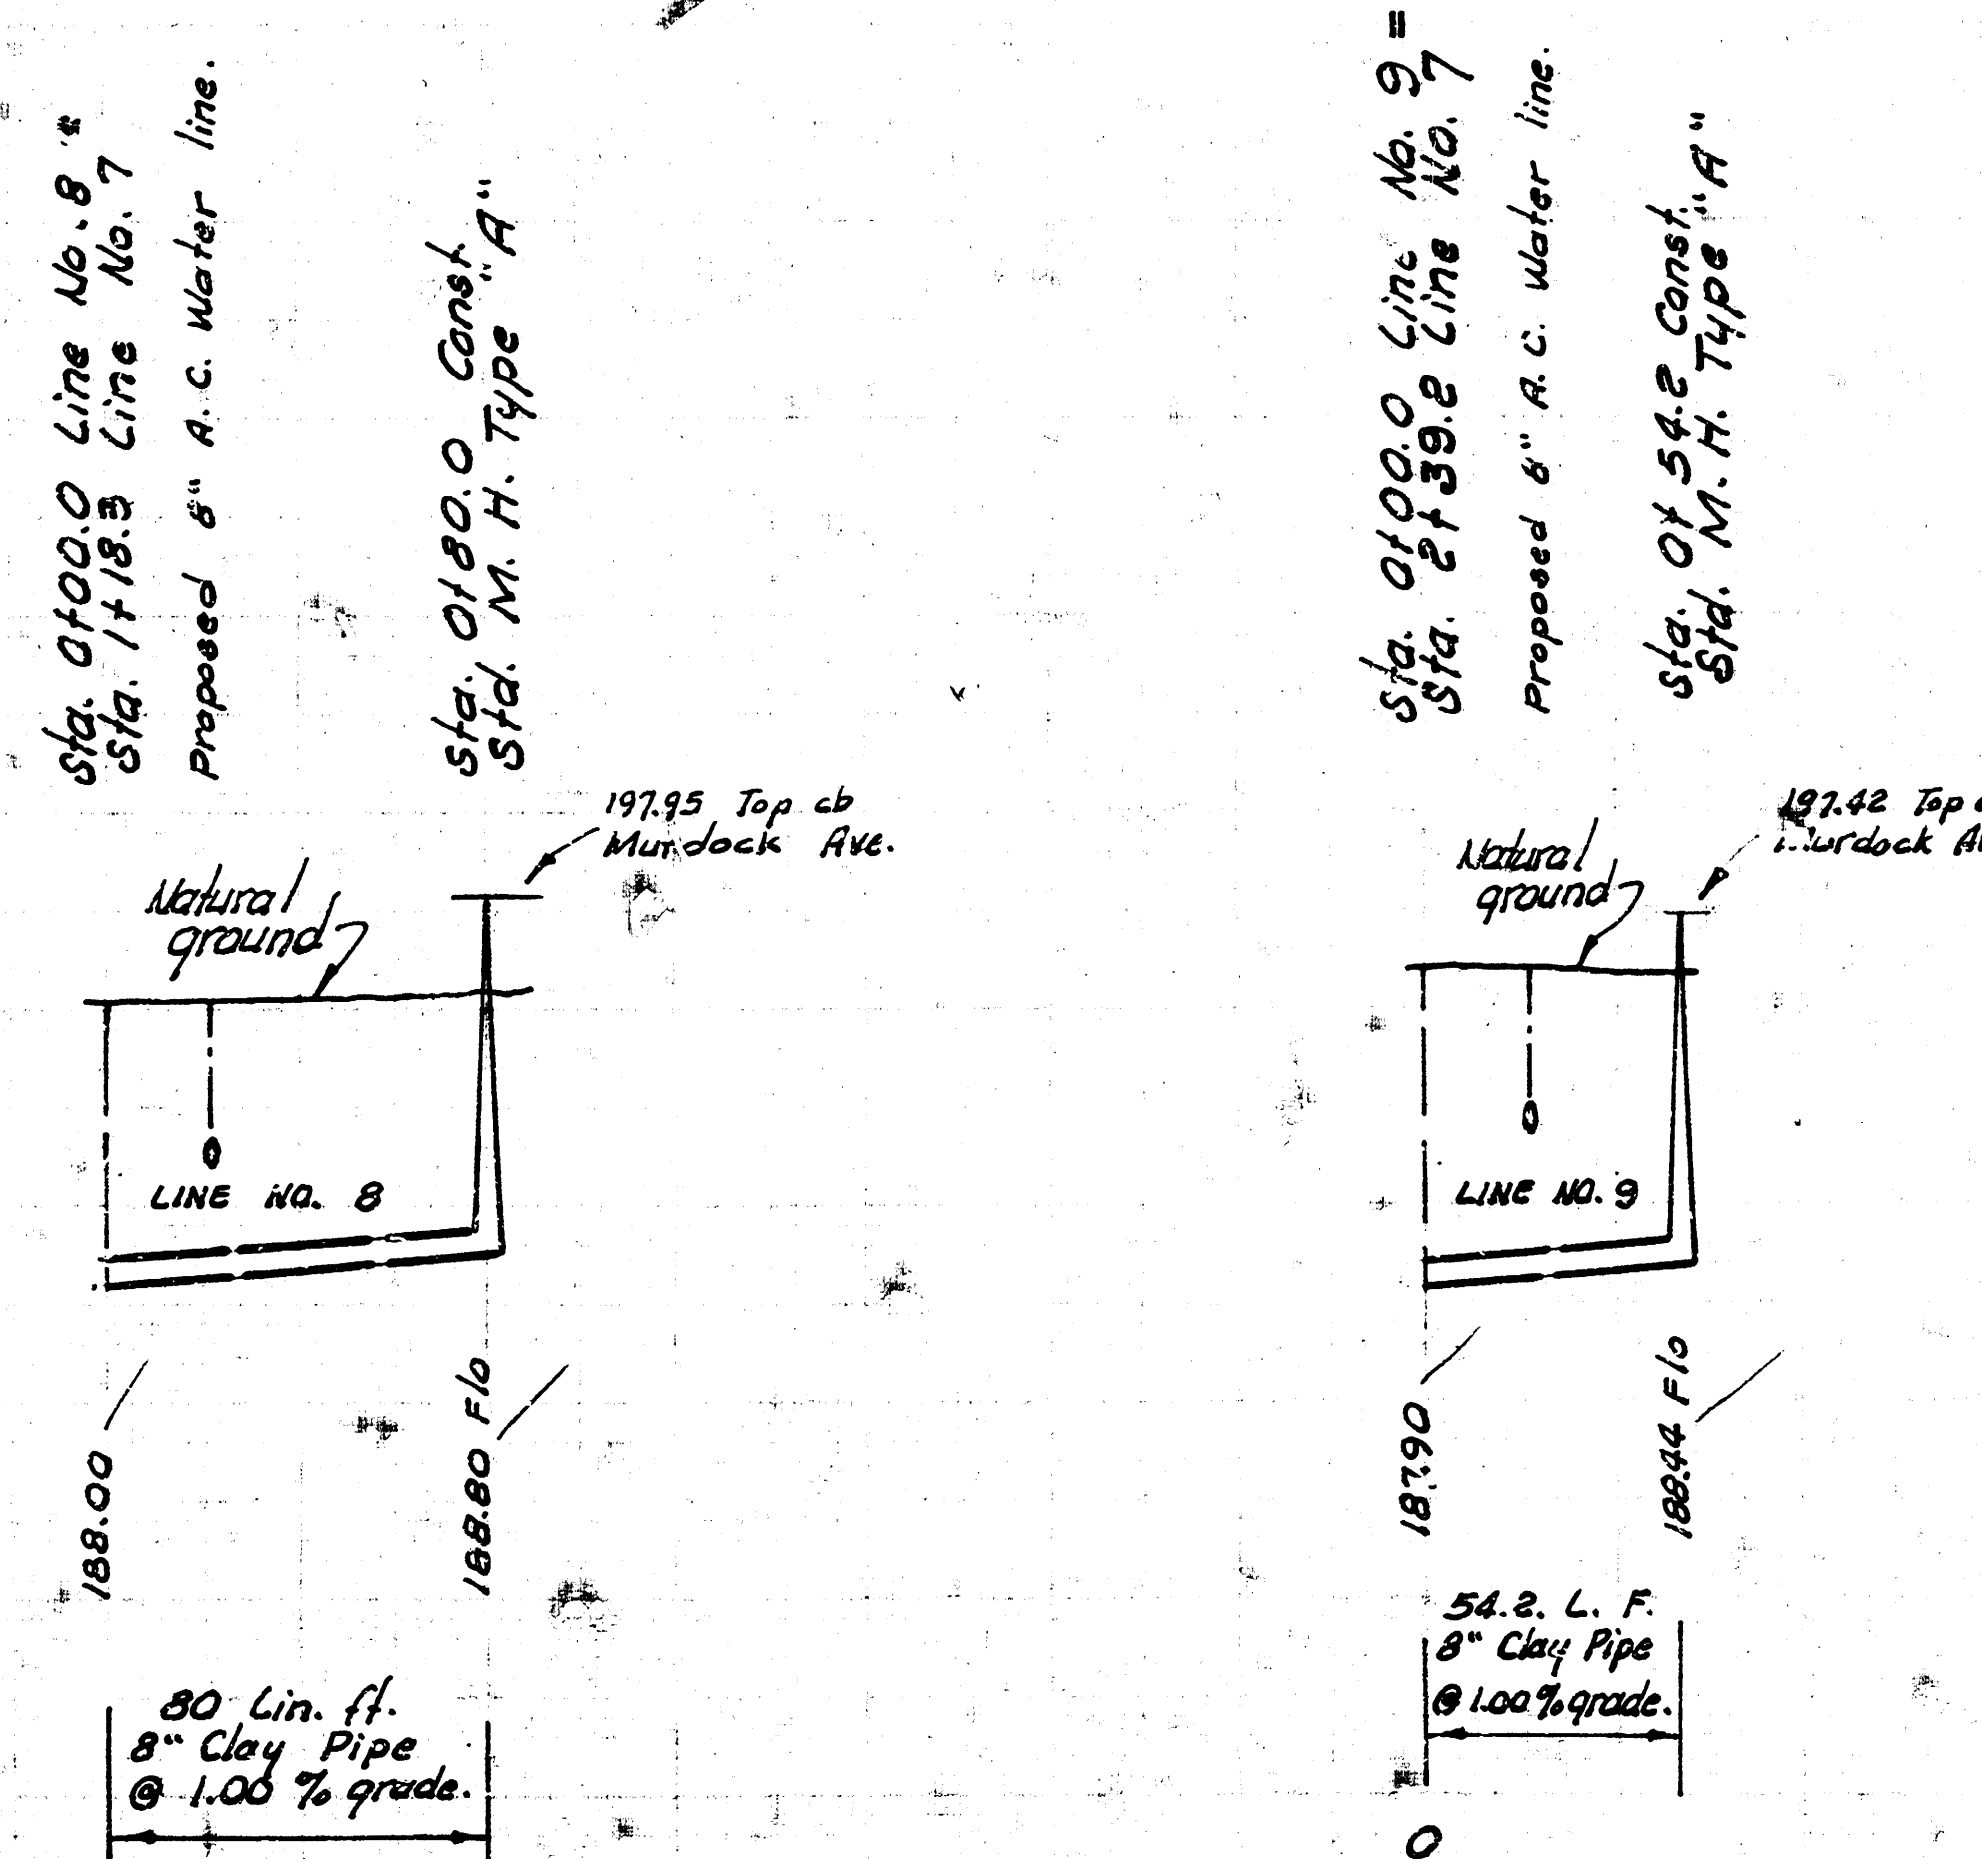

KAPALUN SECOND ADDITION

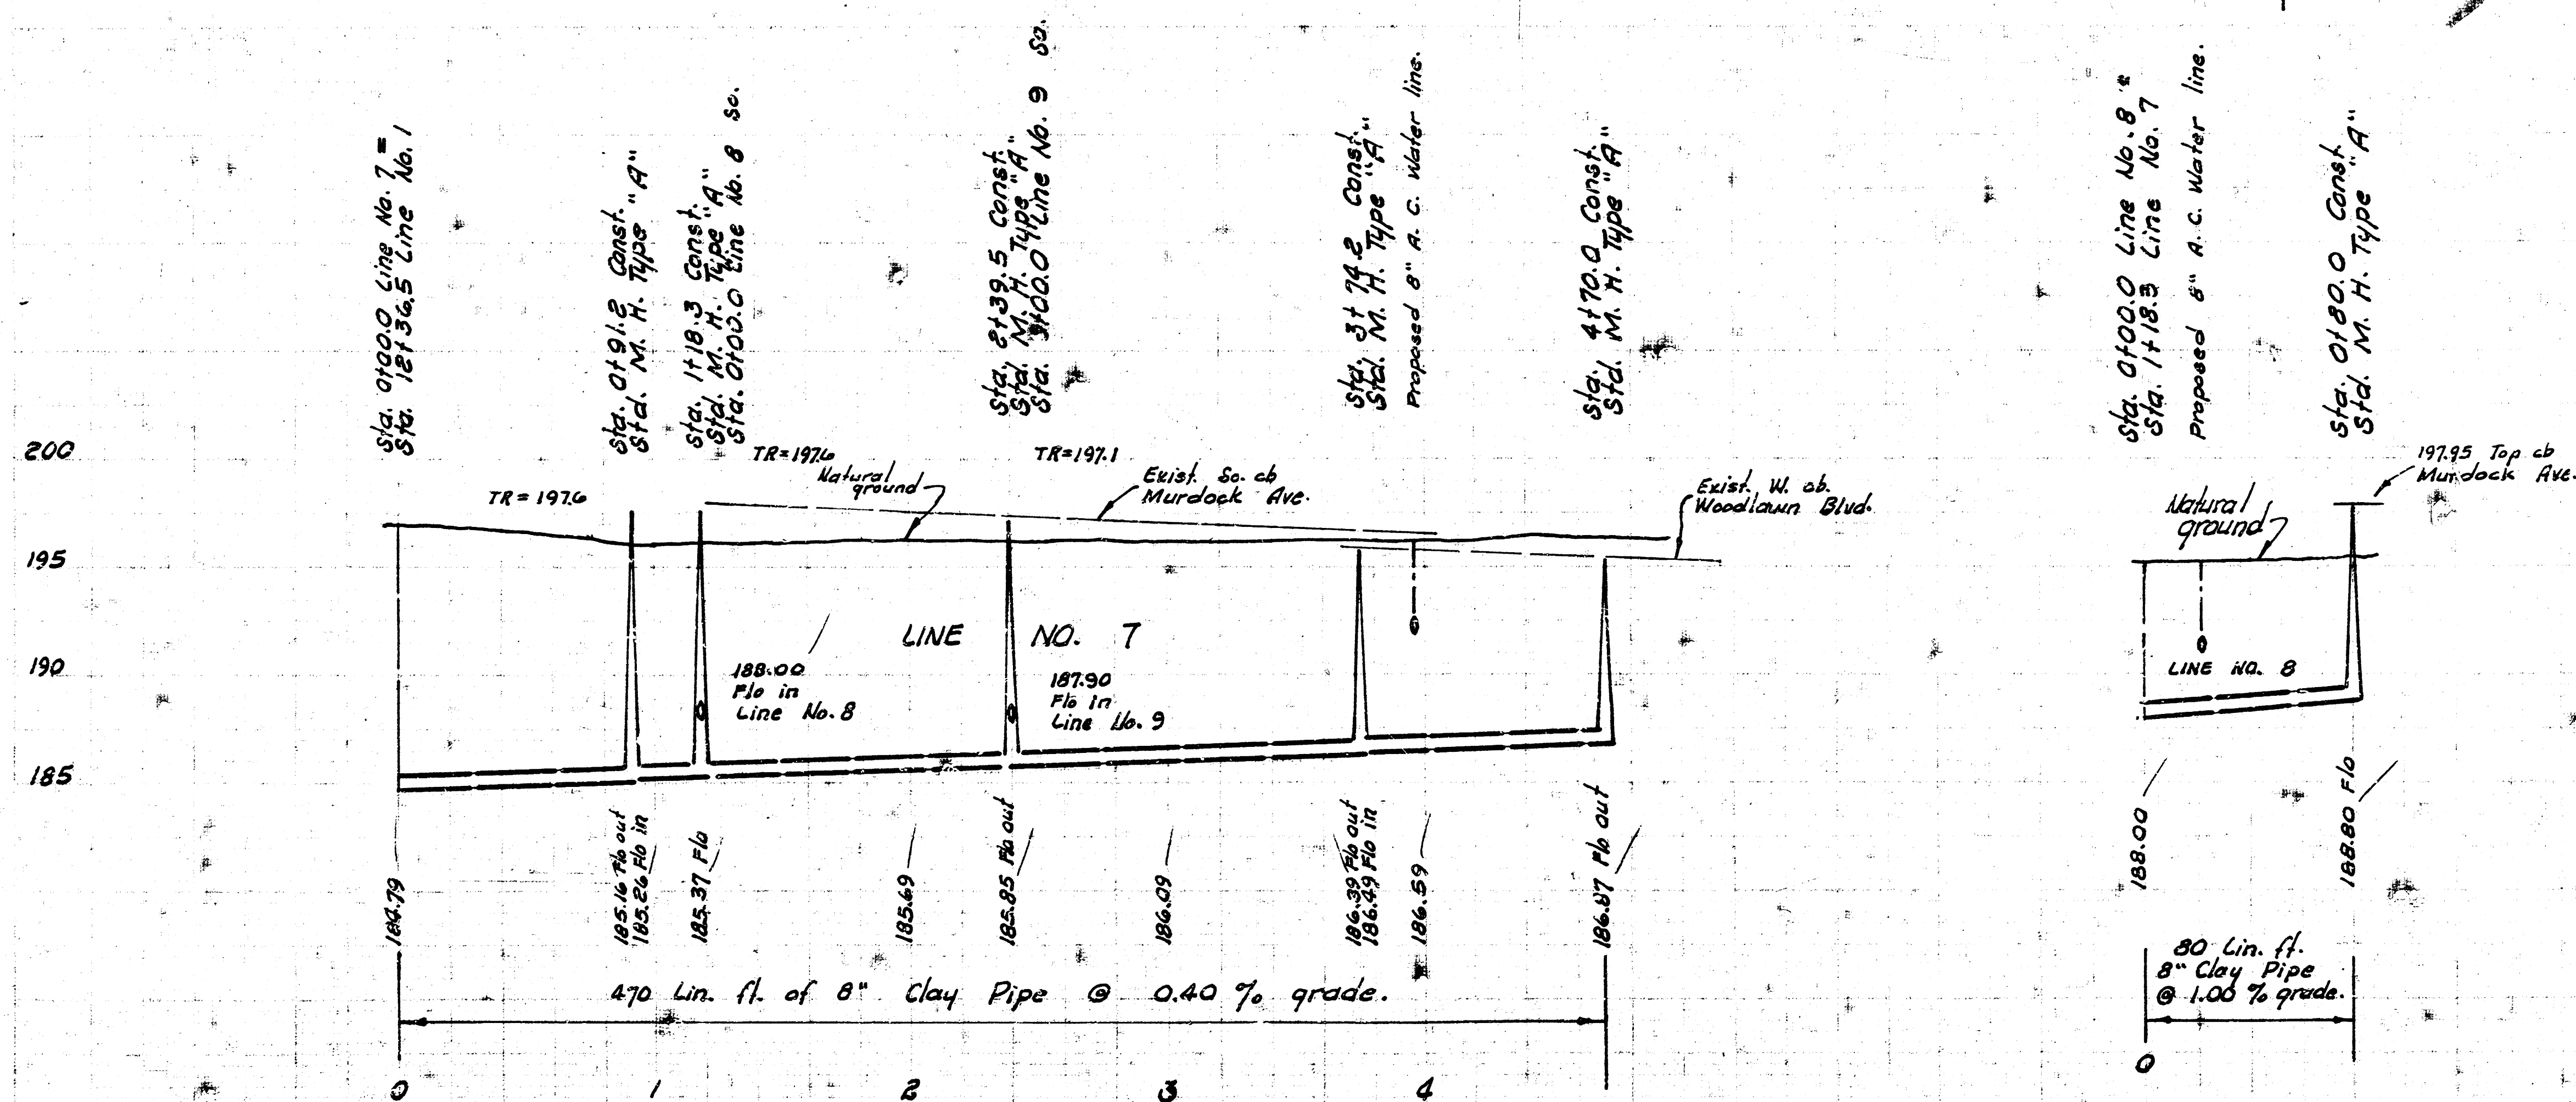

B. M. 201.18 SE cor. bot. Conc. Step
No. # 6302 Murdock.

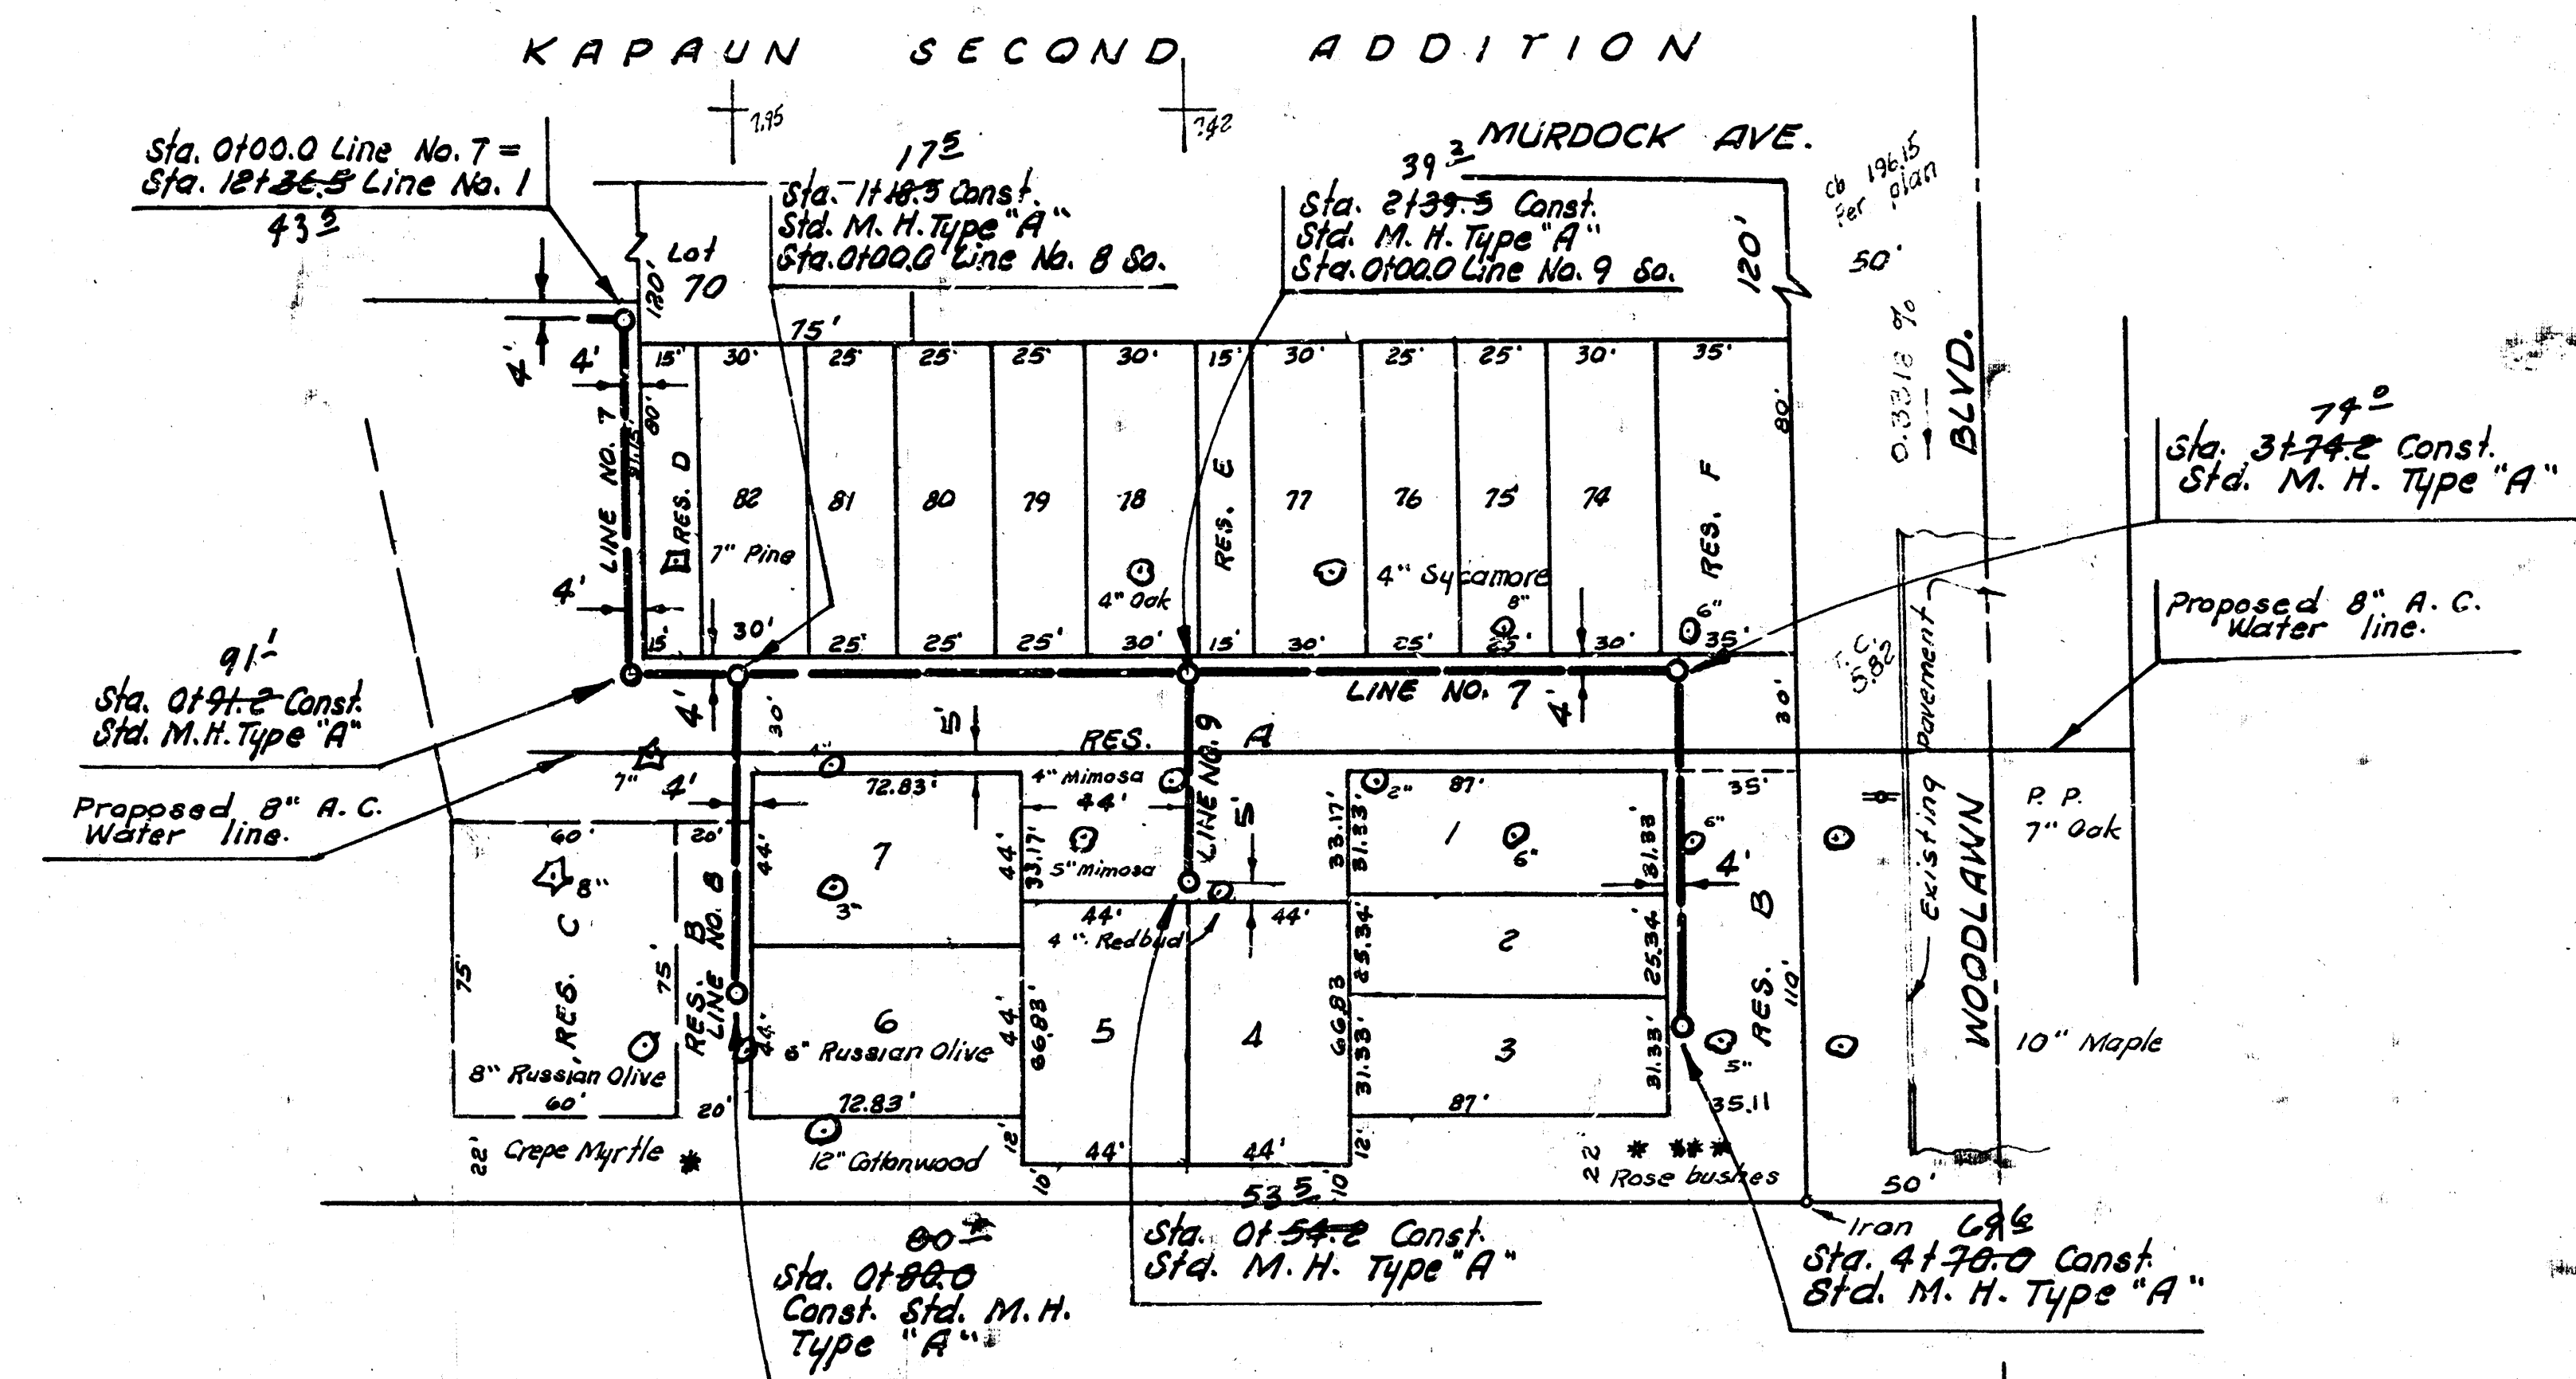

LAT. 95, DRY CREEK MAIN 2, S. S. NO. 12
PROJECT NO. DBKL573054