

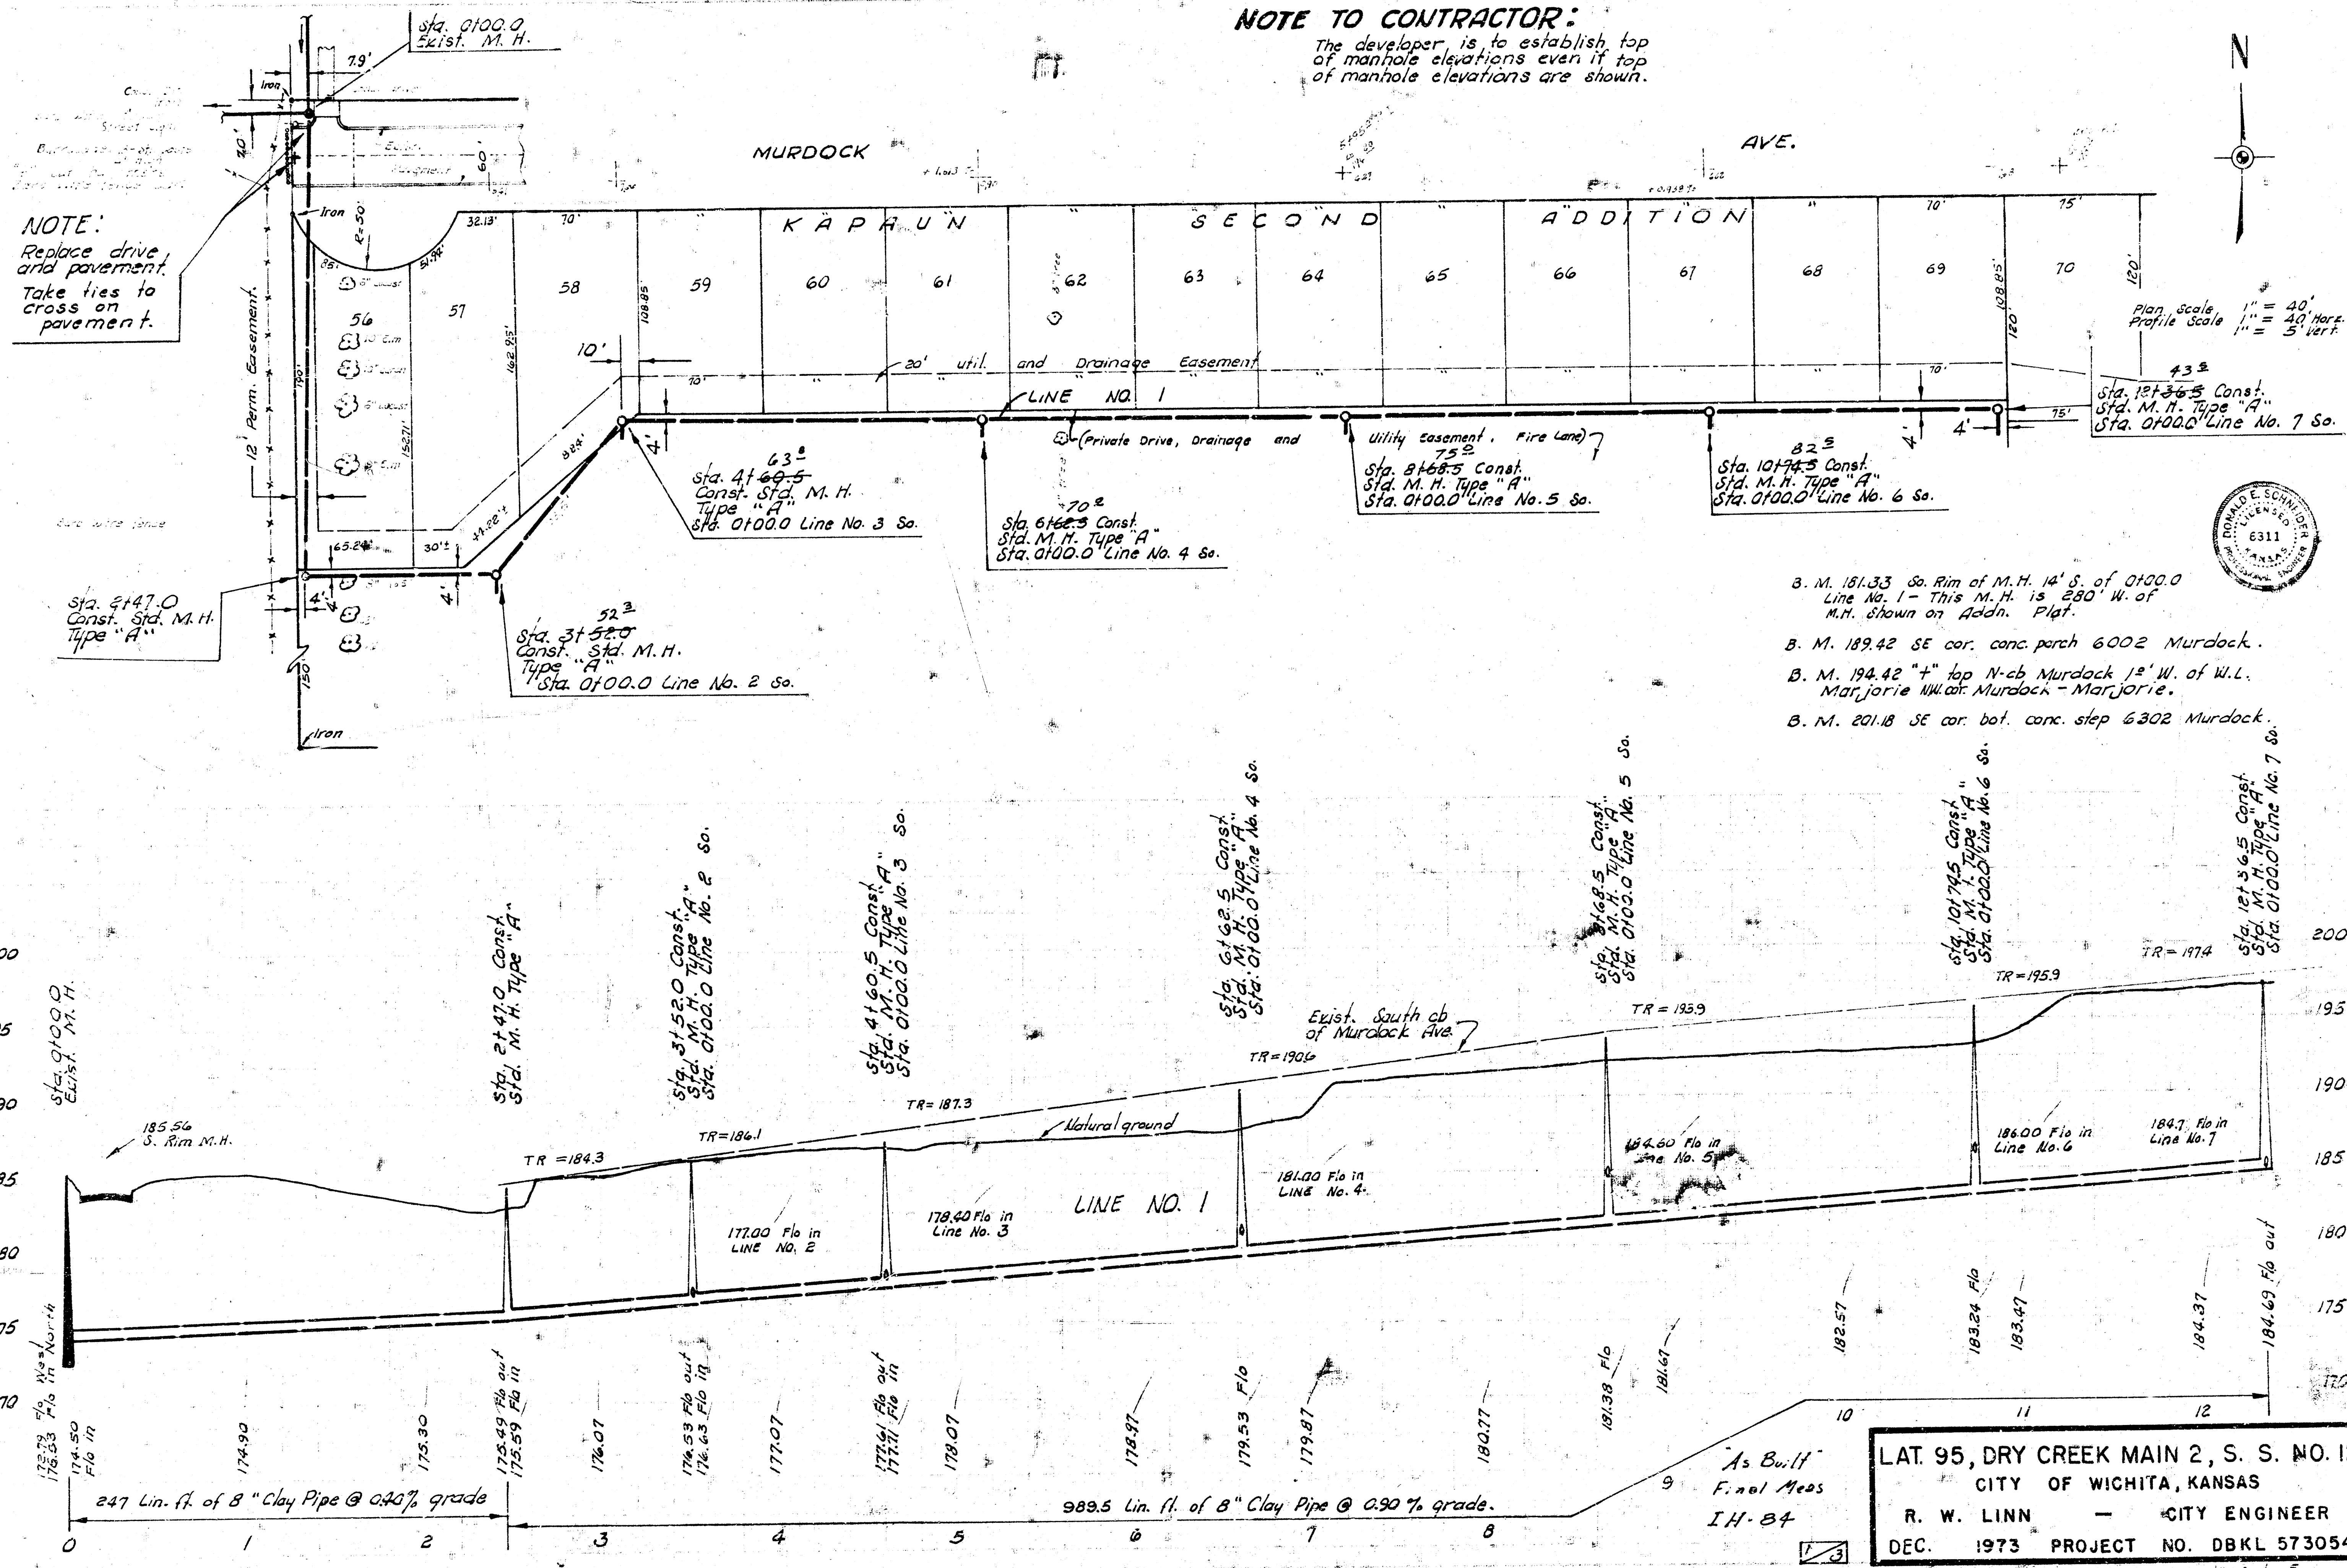
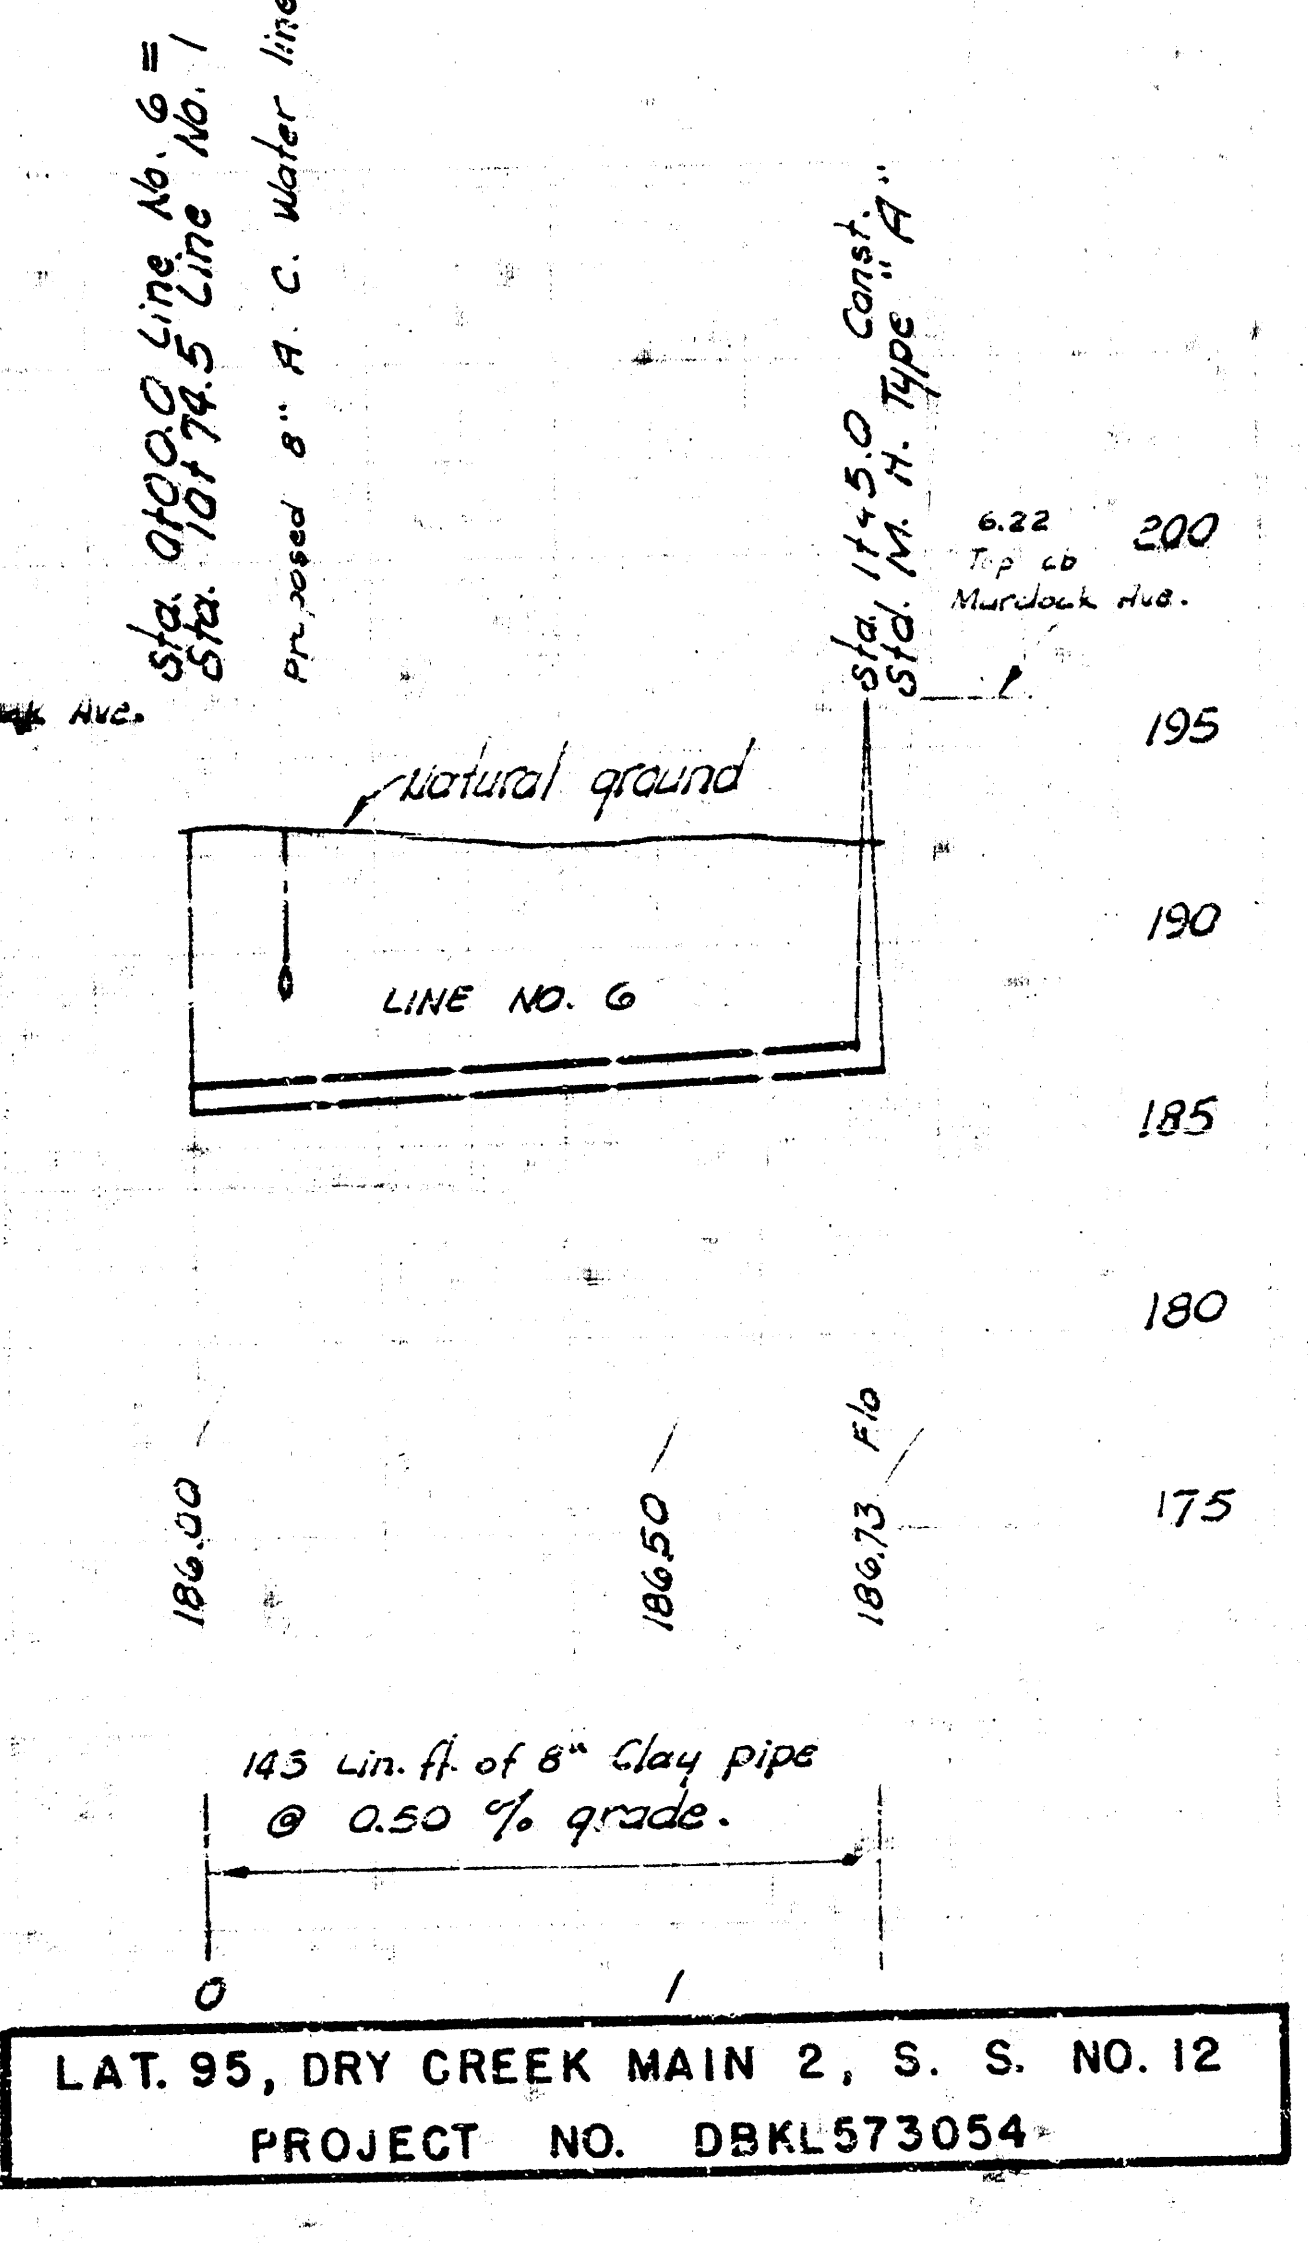
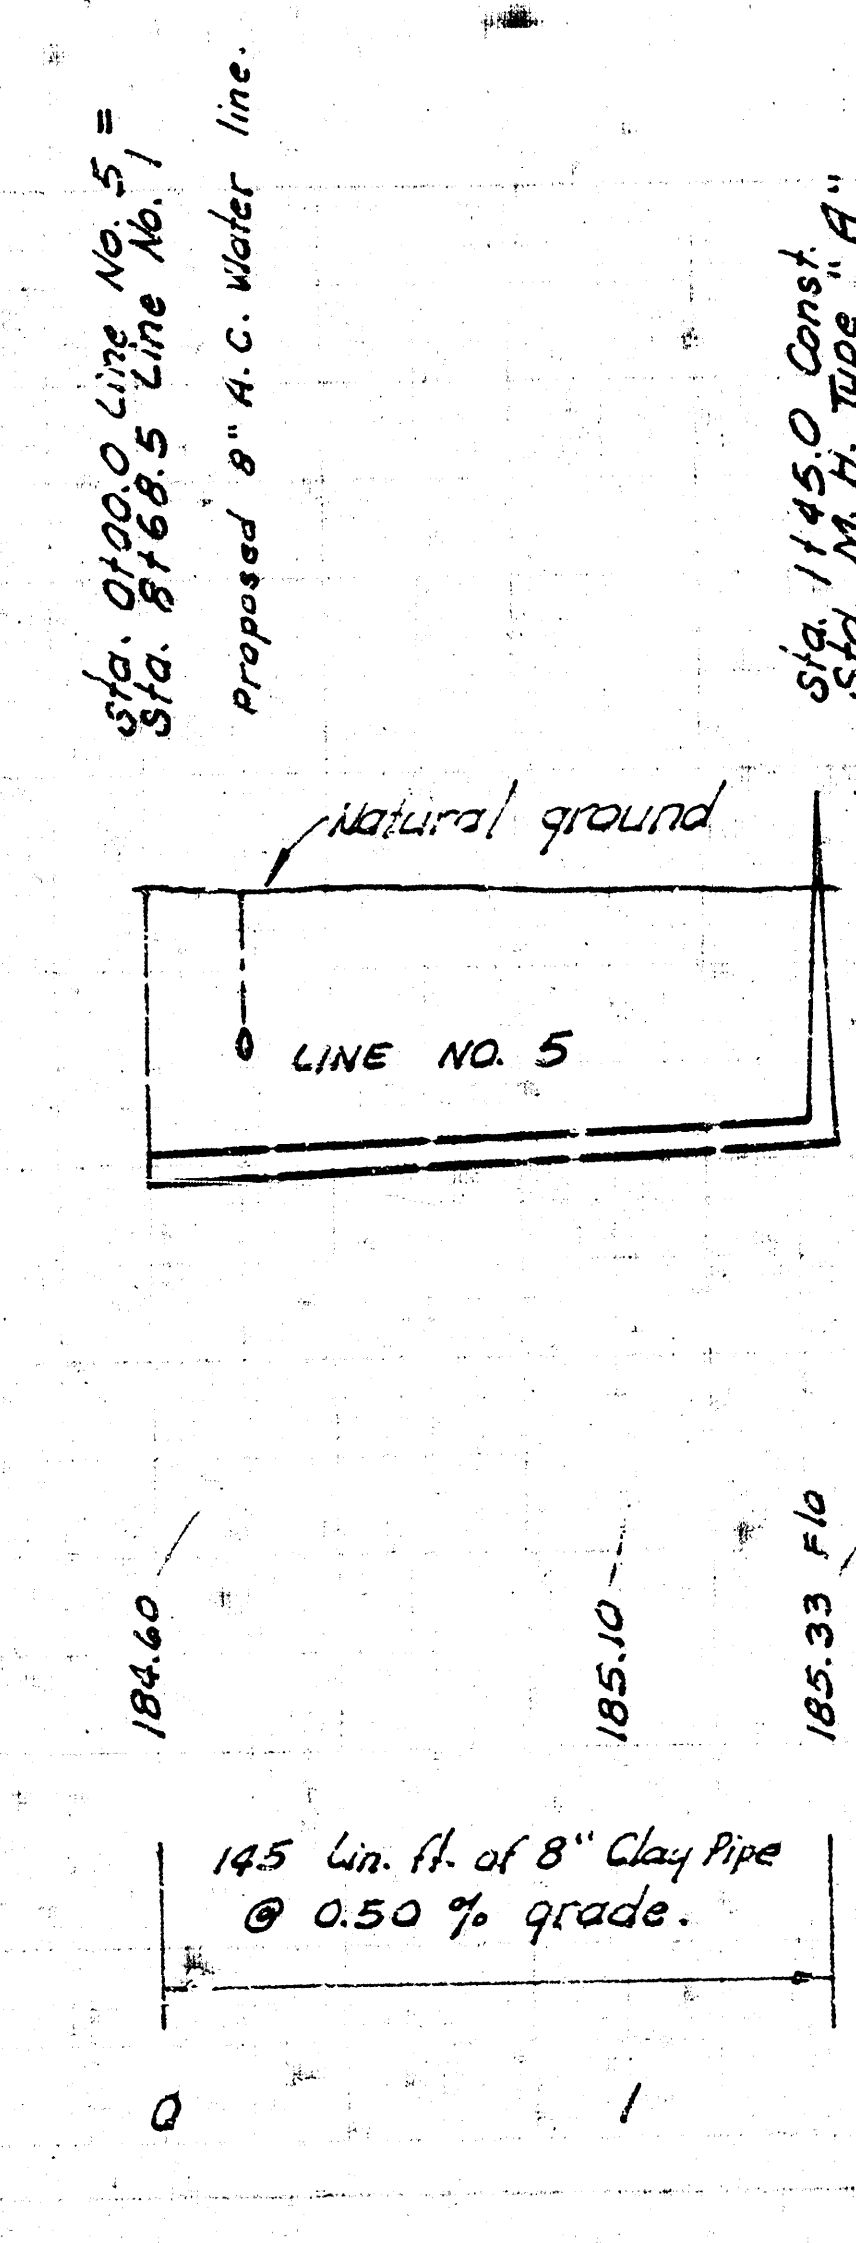
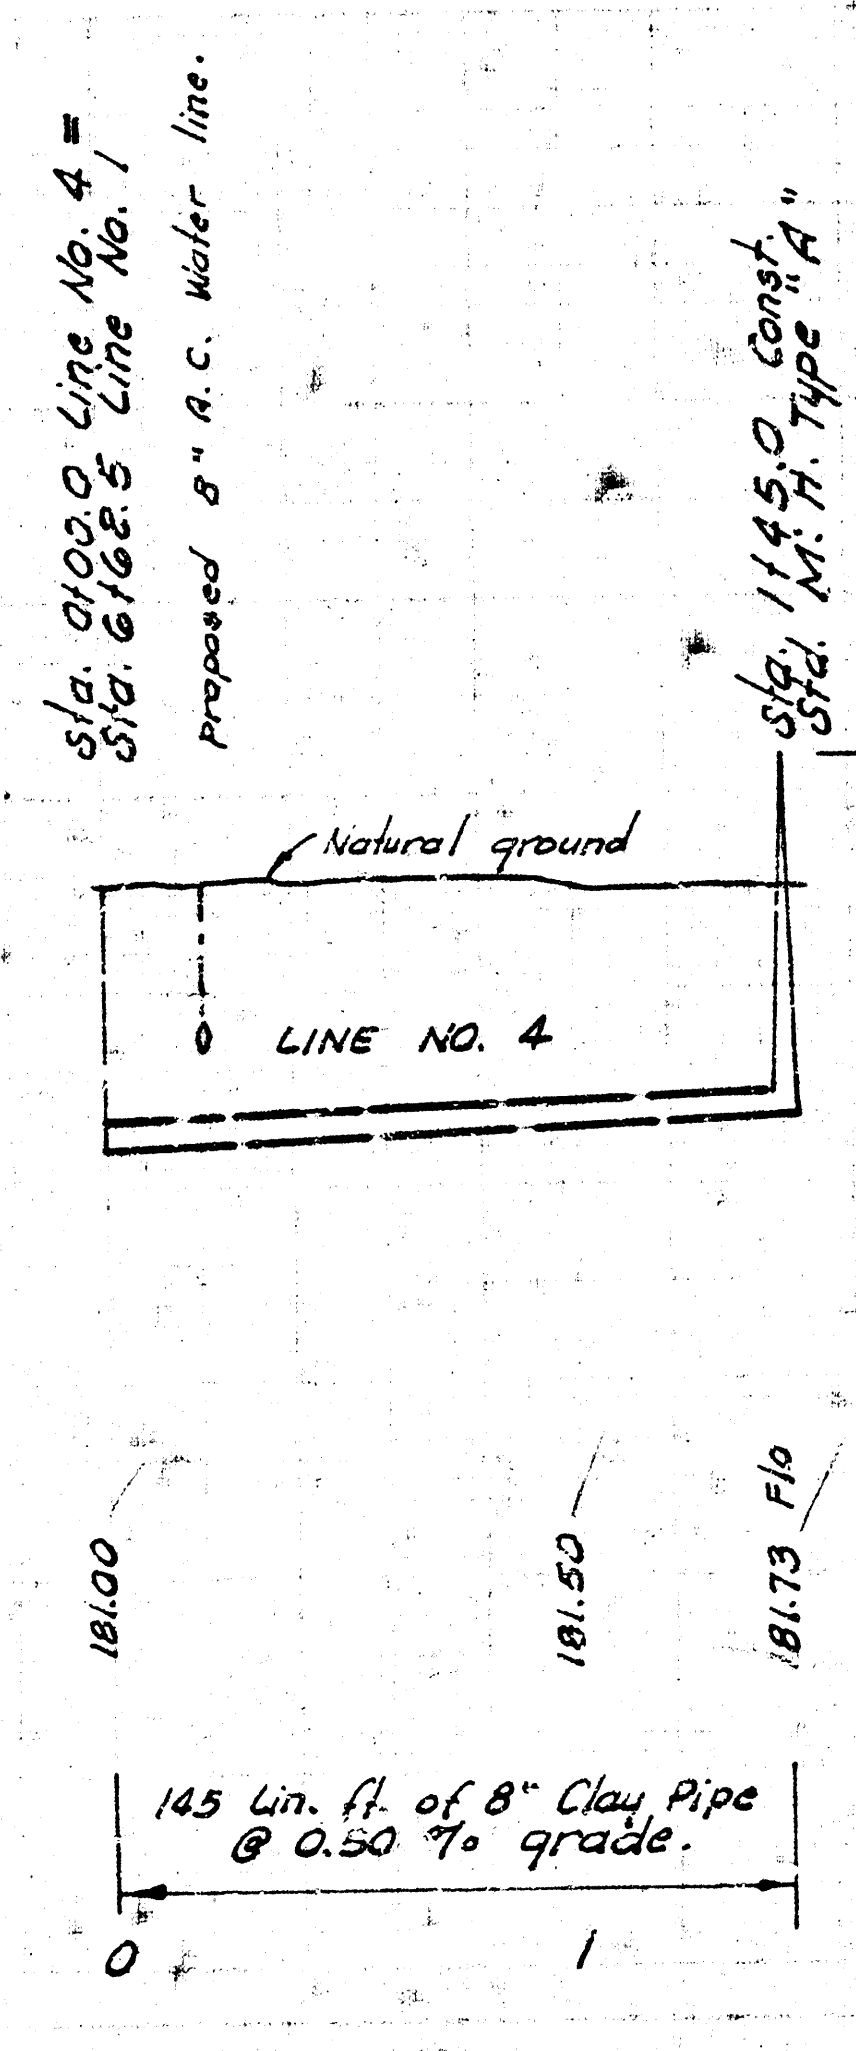
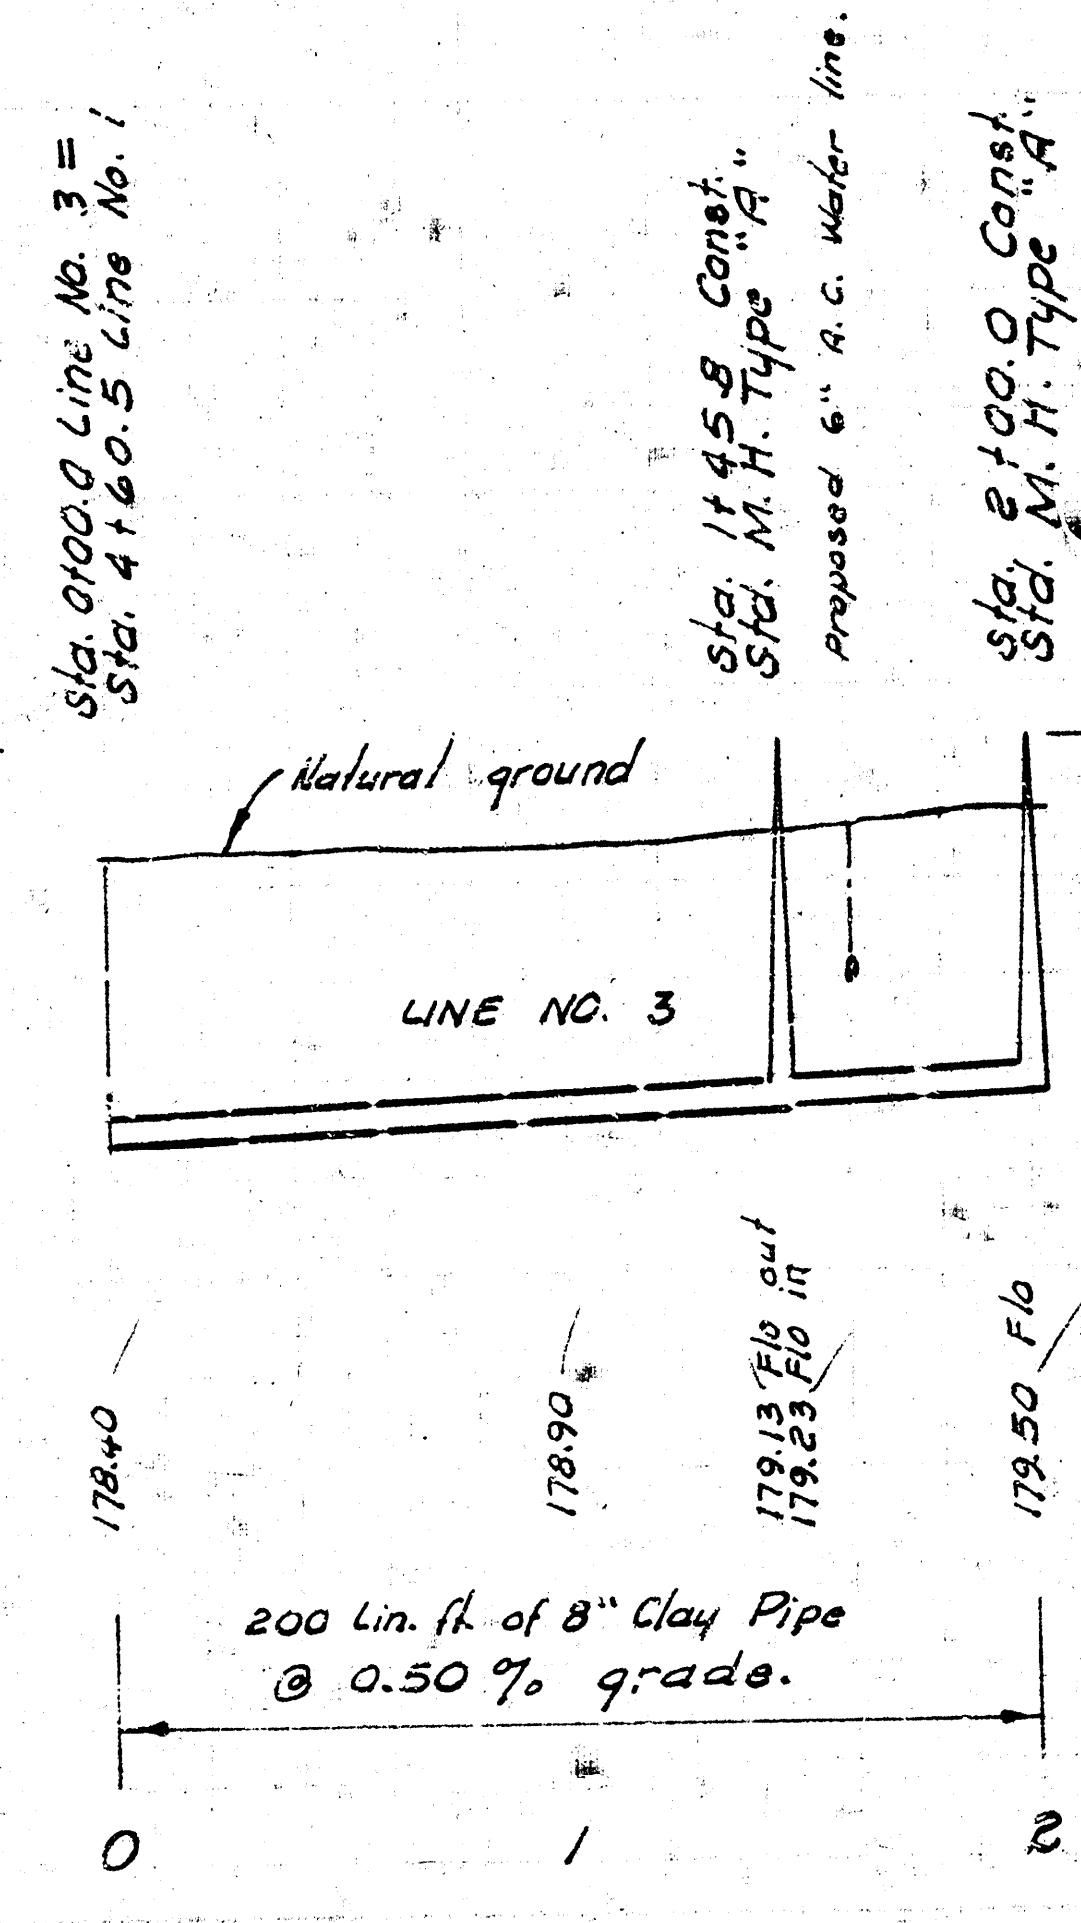
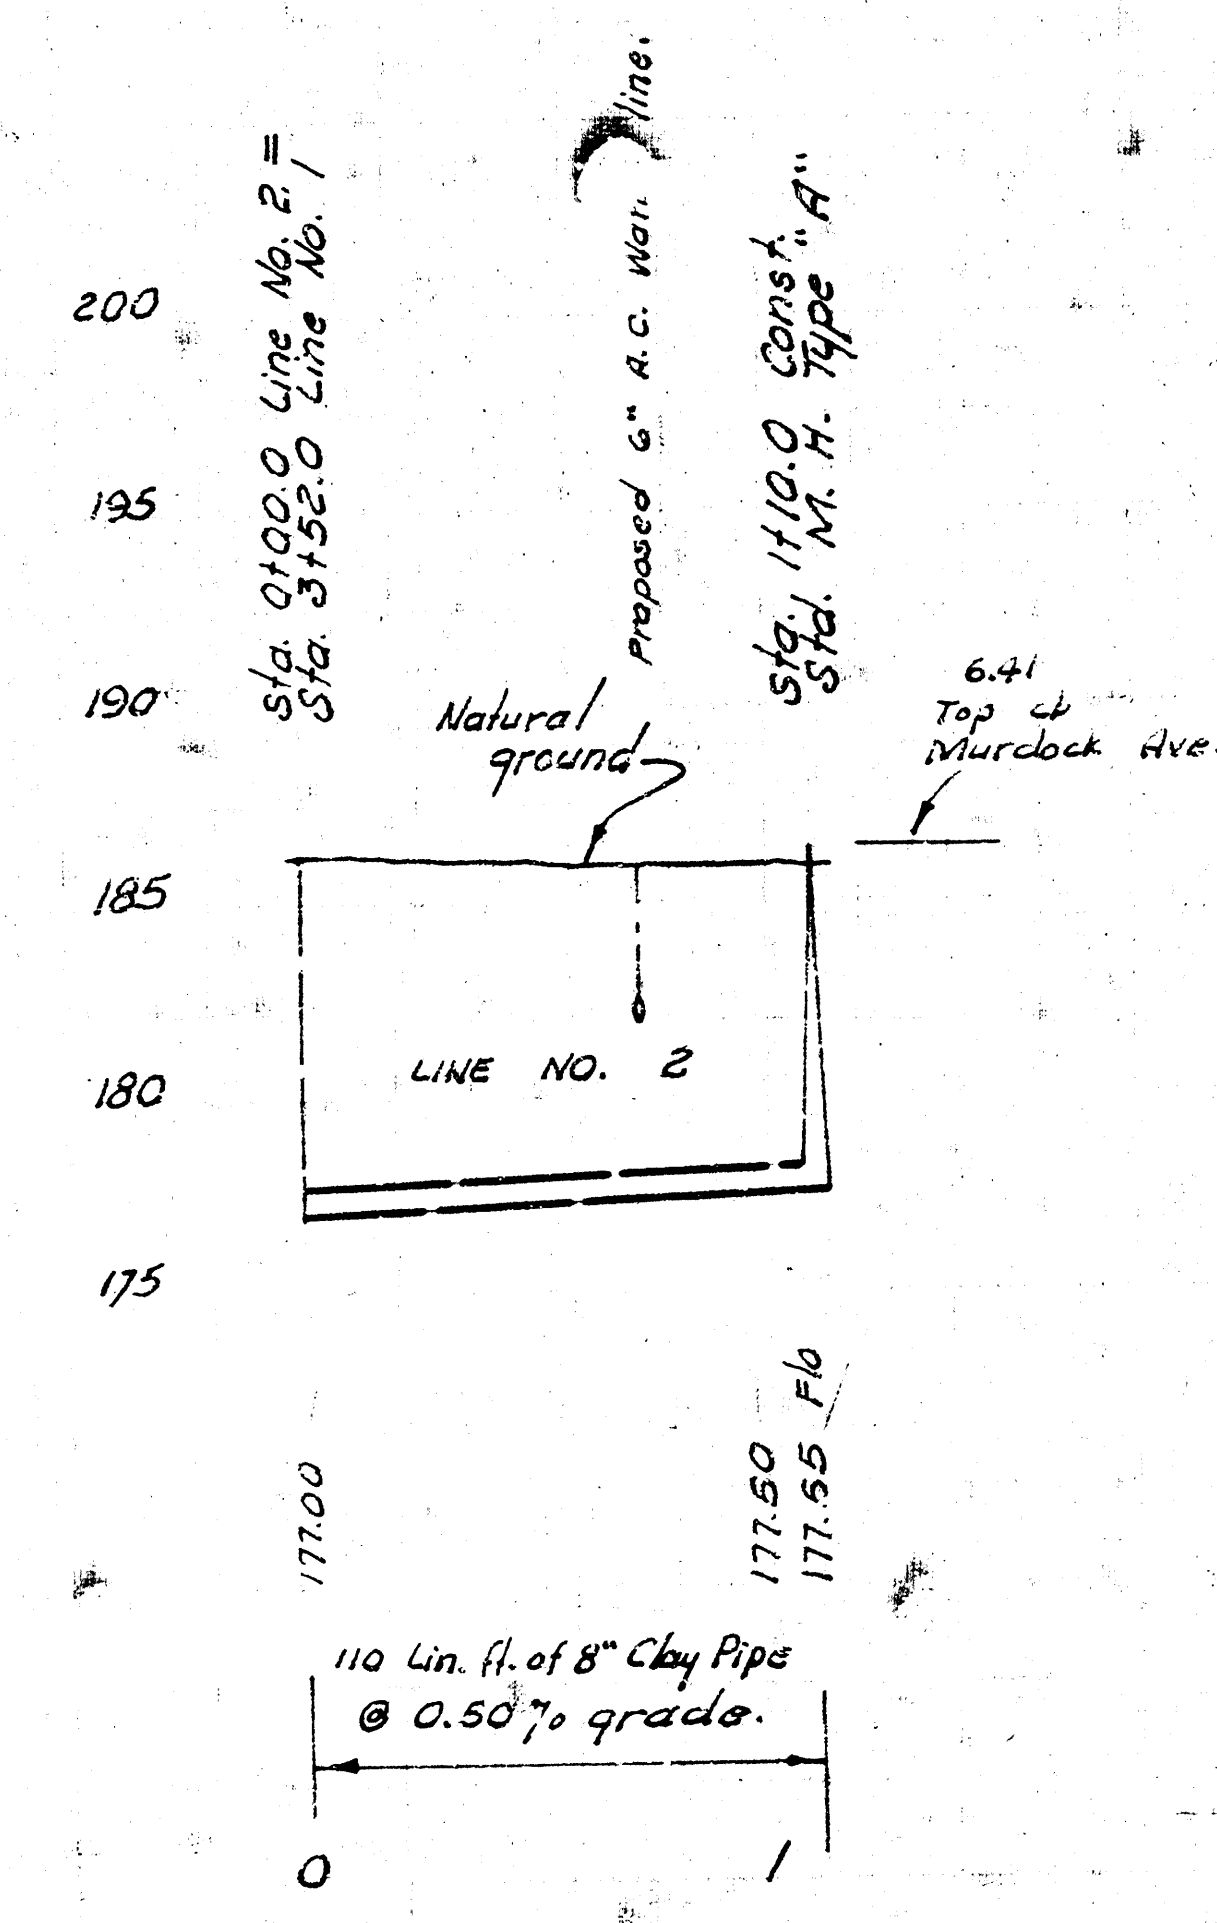


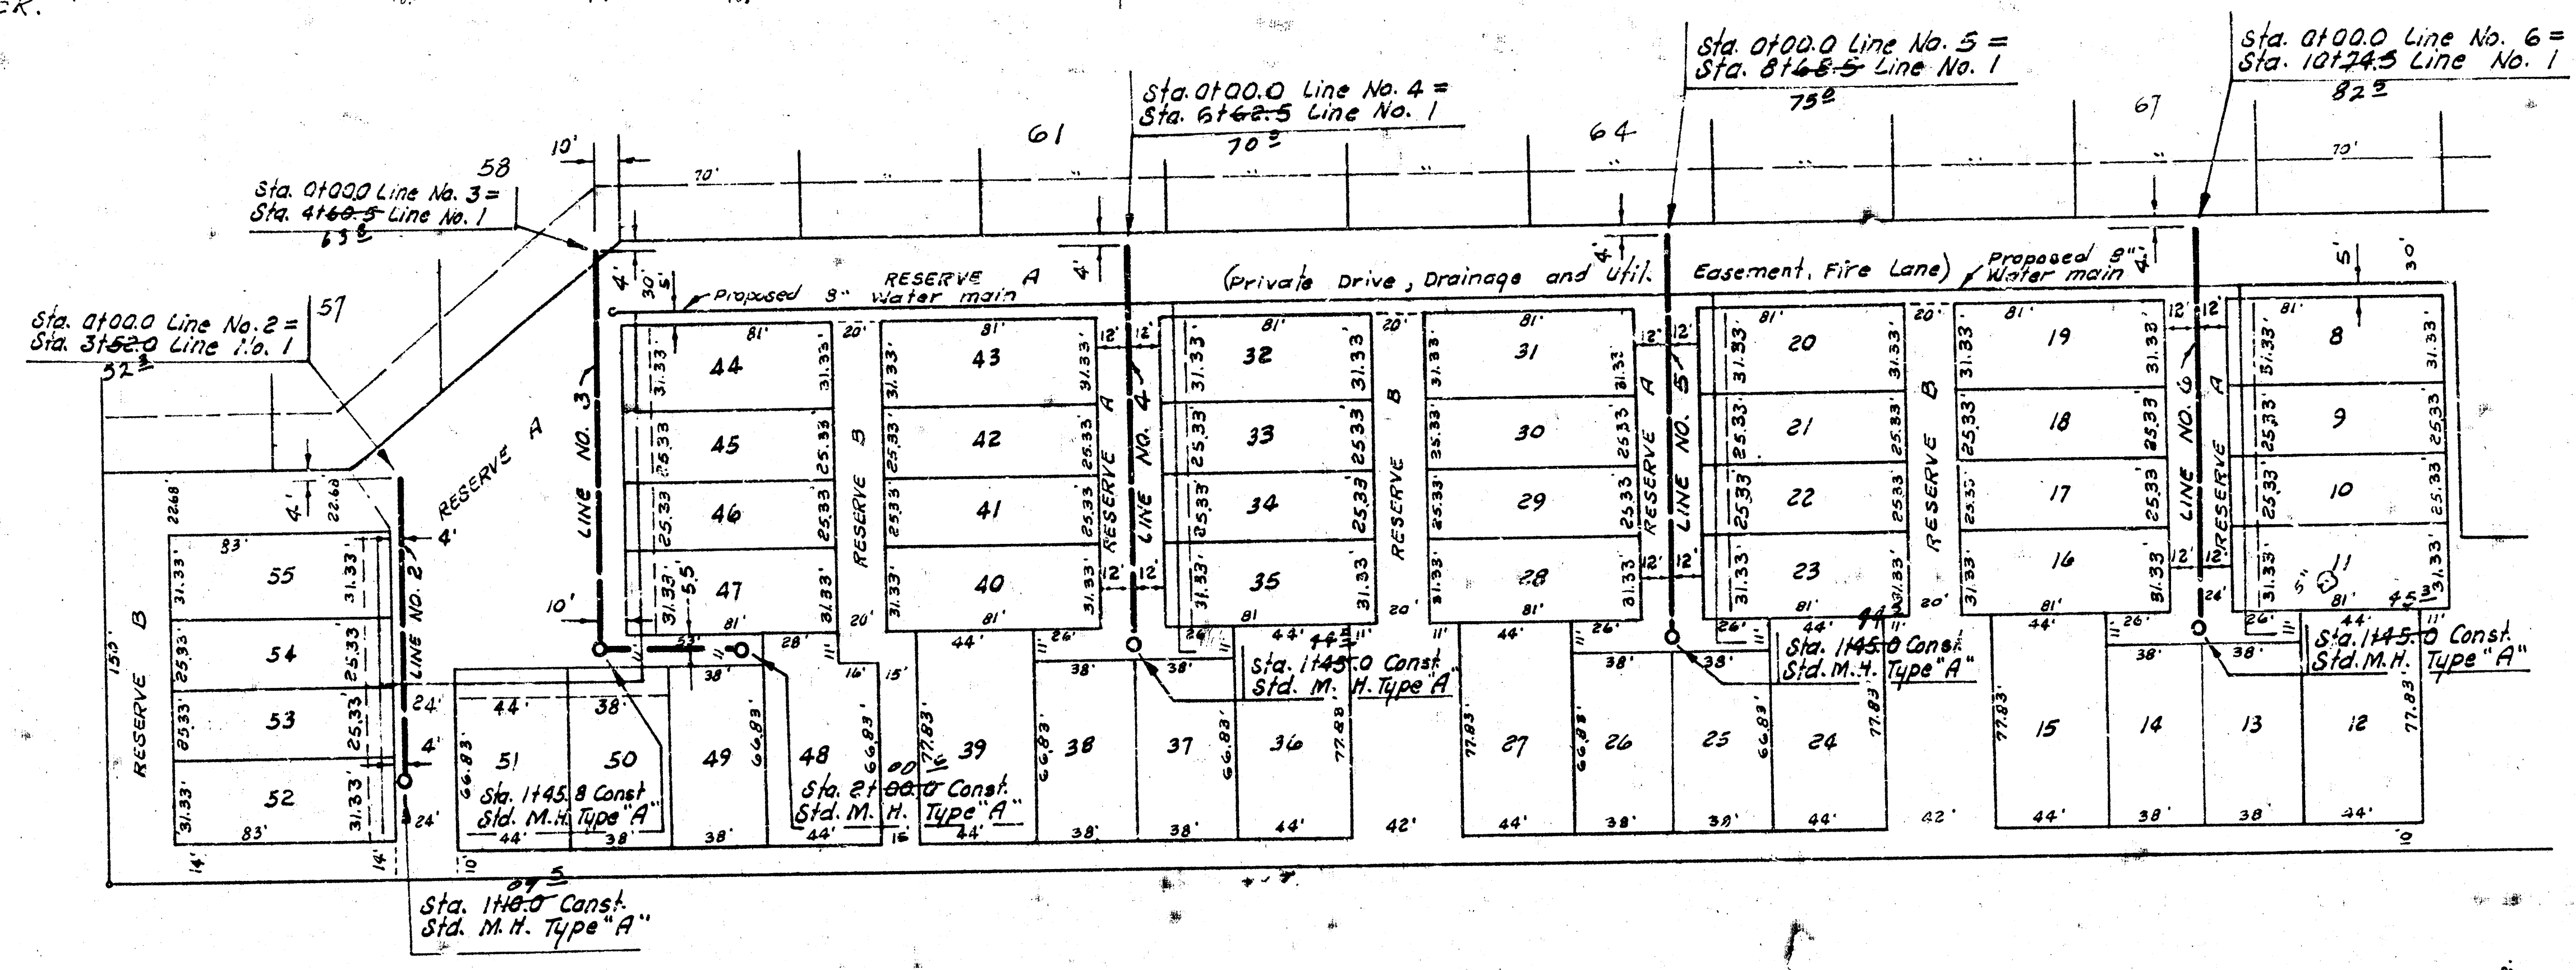

B. M. 39.42 SE conc. porch
6002 E. Murdock.

KAPAUN SECOND ADDITION

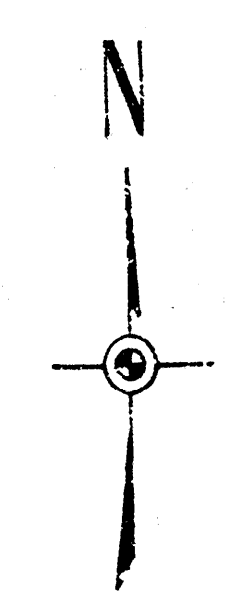

LAT. 95, DRY CREEK MAIN 2, S. S. NO. 12
PROJECT NO. DBKL573054

B. M. 20118 SE cor. bot. Conc. Step
No. # 6302 Murdock.

