Notify Central Inspection (268-4341) for Service Connection Permits

Stationing for Service Connections As Booked (B-218)

0+36	West
0+38.5	East
0+60	West
0+62.5	East
0+86.5	East
1+07	West
1+36.5	East
1+60.5	East
2+06	West
2+08.5	East
2+60	West
2+87.5	East

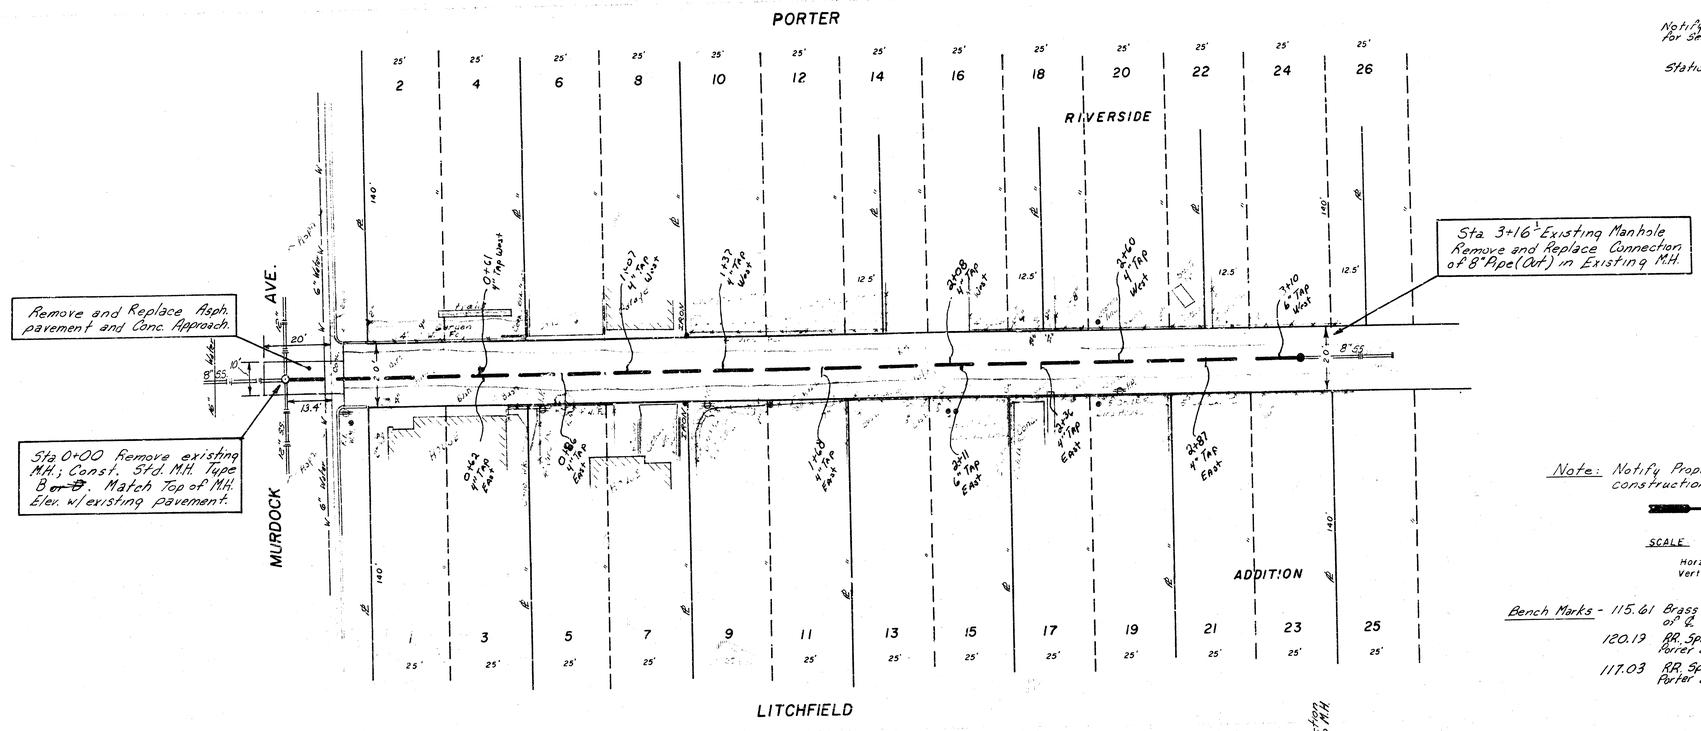

Note: Notify Property Owners 48 hrs before construction begins.

N

SCALE 1" = 20' Plan
Horz 1" = 20' Profile
Vert 1" = 5'

Bench Marks - 115.61 Brass Rod in conc. post, 27' W and 22.5' N of ℄ Buffum and Franklin
120.19 RR. Spk., W. Fc. PP., E Side of Alley between Porter and Lichfield, 4th PP N. Side Murdock
117.03 RR. Spk., W. Fc. PP., E Side Alley between Porter and Lichfield, 1st PP N. Side Murdock.

As Built
J.L.L.
5/82

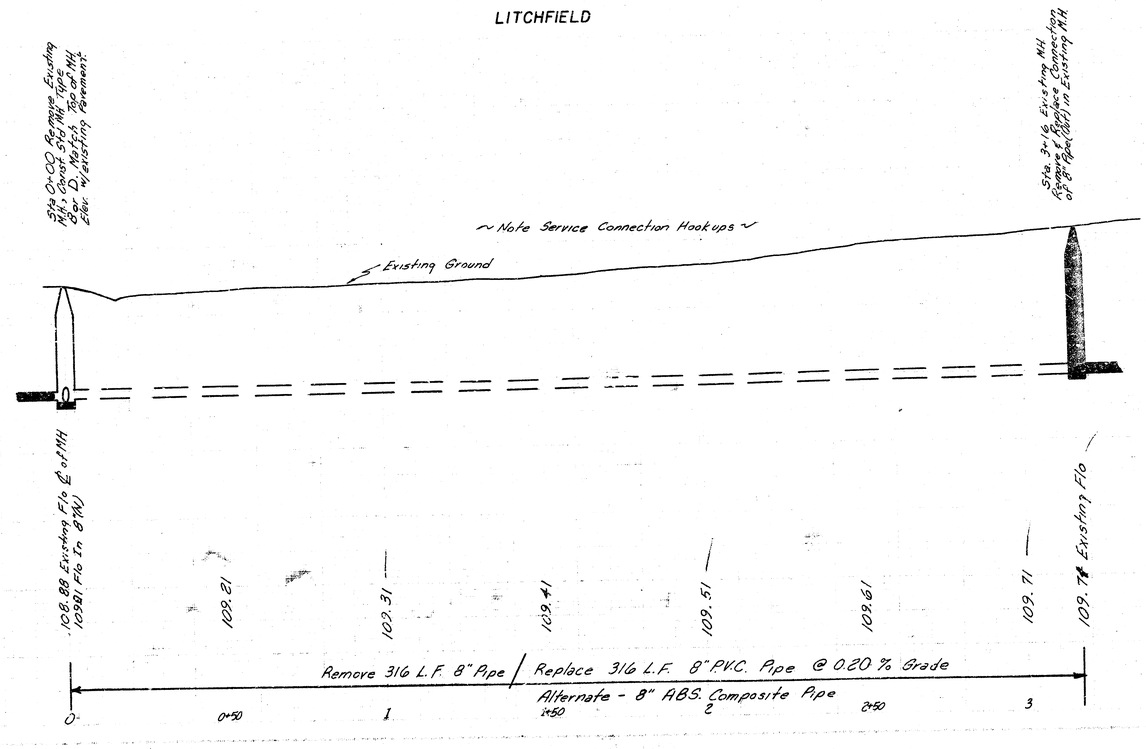

DONALD E. SCHNEIDER REGISTERED 6311 KANSAS PROFESSIONAL ENGINEER

RECONSTUCTION OF A PORTION OF S.S. NO. 15, BETWEEN PORTER & LITCHFIELD ON N.S. OF MURDOCK.

CITY OF WICHITA, KANSAS
R.W. BRUGGEMAN
DIRECTOR OF ENGINEERING / CITY ENGINEER
PROJ. NO. 468-76-245-81167-000-000-001
DATE _____ SHEET 1 OF 1