

RECONSTRUCTION OF A PORTION OF LATERAL 32 SANITARY SEWER NO. 20

PROJECT NO.
468-76-245-81333-000-000-001

CITY OF WICHITA, KANSAS
MIKE LINDEBAK, CITY ENGINEER

MARCH, 1984

GENERAL NOTES

1. ALL UTILITY LOCATIONS ARE APPROXIMATE. CONTRACTOR SHALL COORDINATE WITH RESPECTIVE UTILITY OWNERS TO FIELD LOCATE UTILITY EXCAVATION.
2. SERVICE LINE LOCATIONS AND QUANTITIES ARE APPROXIMATE AND ARE FROM EXISTING CITY RECORDS. CONTRACTOR SHALL TELEPHONE ALL SUPPLIERS OF NEW SEWER ENLARGEMENT TO VERIFY LOCATIONS OF ACTIVE SERVICE LINES. ONLY ACTIVE SERVICE LINES ARE TO BE RECONSTRUCTED.
3. TELEVISION TAPES AND LOGS OF SEWERS TO BE REPLACED OR PLACES ARE AVAILABLE FROM THE CITY SEWER MAINTENANCE DIVISION.
4. ALL MATERIALS SHOWN ARE CITY OF WICHITA DESIGN. CITY MATERIALS 8-1187-A USCS.
5. TO DAMAGED EXISTING CONSTRUCTION, EXISTING MANHOLES, SEWER LINES, AND OTHER APPROPRIATE TO REMAIN IN SERVICE SHALL BE REPAIRED TO ORIGINAL CONDITION.

7. OUTFIT SAFETY BY RAILROADS (248-7517) PRIOR TO BEGINNING OF CONSTRUCTION.
8. CONTRACTOR IS RESPONSIBLE FOR OBTAINING THE EXACT LOCATION OF ALL UTILITIES PRIOR TO CONSTRUCTION.

NOTE: CONTRACTOR'S METHOD FOR HANDLING SEWAGE FLOWS DURING CONSTRUCTION OF THIS PROJECT SHALL BE AS APPROVED BY THE ENGINEER. ONLY ACTIVE BUILDING SEWER LINES WHICH CONNECT ACTUAL BUILDINGS TO THE SEWER SYSTEM ARE TO BE RECONNECTED TO THE NEW SEWER CONSTRUCTION. BUILDING SEWER LINES AND/OR CONNECTIONS WHICH HAVE BEEN ABANDONED ARE NOT TO BE RECONNECTED TO THE NEW SEWER CONSTRUCTION. IT WILL BE THE SOLE RESPONSIBILITY OF THE CONTRACTOR TO ASCERTAIN WHICH BUILDING SEWER LINES AND/OR CONNECTIONS ARE ACTIVE AND WHICH SUCH SEWERS AND/OR CONNECTIONS HAVE BEEN ABANDONED. ALL WORK INVOLVED WITH BUILDING SEWER CONSTRUCTION AND/OR BUILDING SEWER CONNECTIONS SHALL CONFORM TO THE APPLICABLE SECTIONS OF THE STANDARD SPECIFICATION.



CONTRACTOR SHALL GIVE ALL PROPERTY OWNERS AND/OR TENANTS AFFECTED BY THE CONSTRUCTION OF THIS PROJECT A MINIMUM OF 24 HOURS ADVANCE NOTICE PRIOR TO START OF CONSTRUCTION.

NOTE: NOTIFY THE FOLLOWING COMPANIES PRIOR TO ANY TRENCHING:

AT&T COMPANY	942-8350
BELL TELEPHONE CO.	268-2256
CARLISLE	269-3340
GAS SERVICE COMPANY	263-7511
KANSAS GAS & ELECTRIC	261-6375
KAN-STATE	267-2889

NOTE: ALTERNATE IF SPOT REPAIRS SHALL CONSIST OF REMOVING APPROXIMATELY 102 LINEAL FEET OF EXISTING PIPE AND INSTALLING 102 LINEAL FEET OF NEW 6" V.C.P. AT THE FOLLOWING LOCATIONS:

STATION 2 + 374
STATION 2 + 974
STATION 3 + 262
STATION 3 + 774

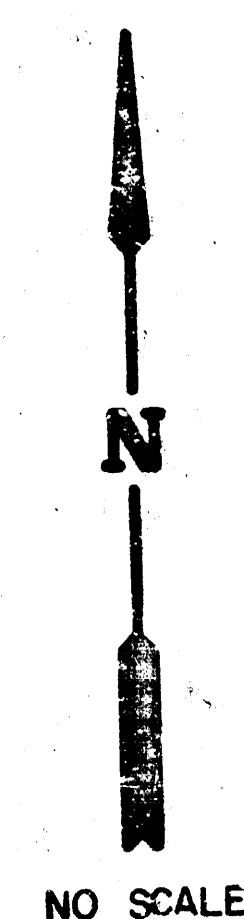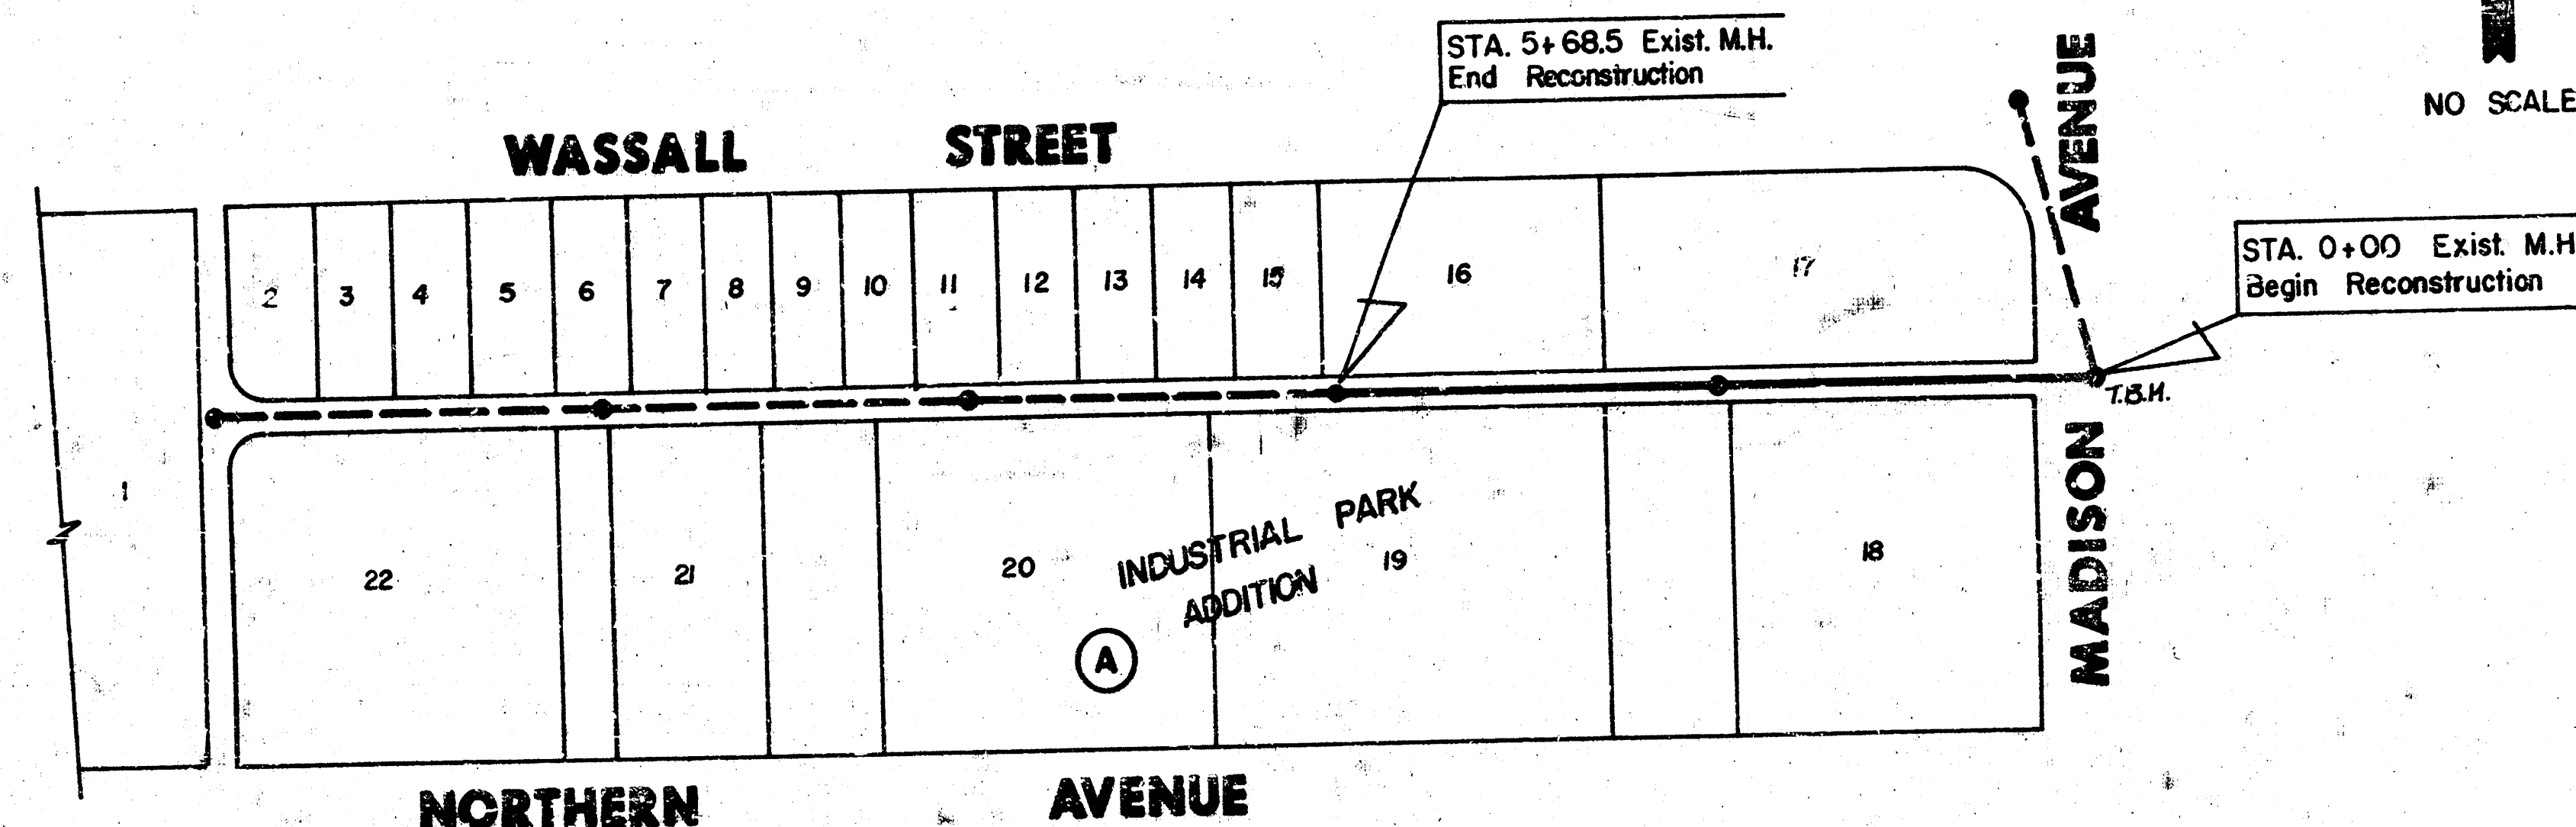

INDEX TO DRAWINGS

SHEET NO.	DESCRIPTION
1	TITLE SHEET
2	PLAN AND PROFILE

BENCH MARKS


- T.B.M. #1 - Sta. 0+00 Existing
Manhole Rim
ELEVATION = 92.90
- B.M. #2 - City St. Southeast corner
Hydraulic & Wessell
ELEVATION = 93.07



	SANITARY SEWER RECONSTRUCTION OF A PORTION OF LATERAL 32 SANITARY SEWER NO. 20		Design Drawn by Checked by Date Job no.
	MID-KANSAS ENGINEERING CONSULTANTS PA 240 NORTH ROCK ROAD SUITE 130 WICHITA, KANSAS 67206		682-6561
	SHEET 1 OF 2		1 2

RECONSTRUCTION OF A PORTION OF
LAT. 32 SAN. SEWER NO. 20
PROJ. NO. 468-76-245-81333-000-000

Is Built
J.L.
3/85

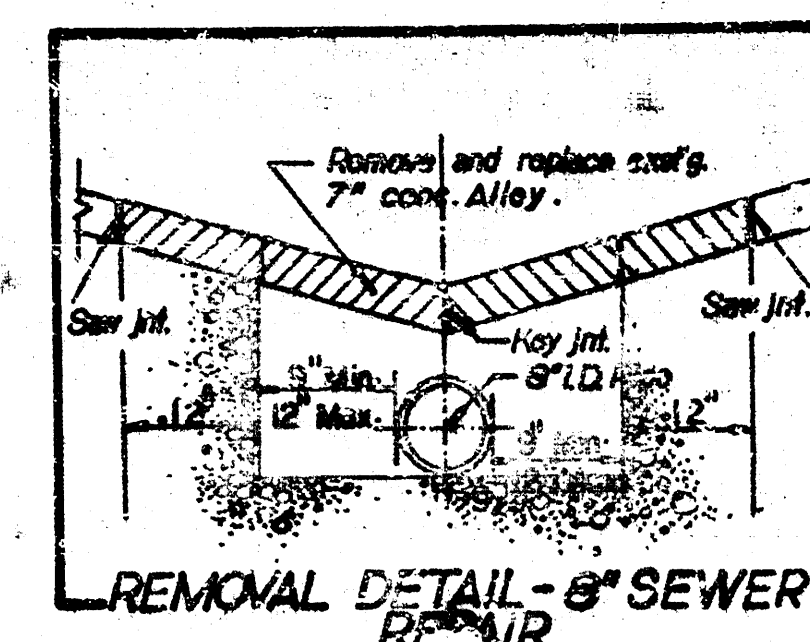


STA. 2+34.5 - EXIST'G MANHOLE
NOTE: REMOVE AND RECONST.
WITH TYPE 'B' MANHOLE (ALT. I
RECONSTRUCTION ONLY)

STA. 3+63 & RXR TRACKS (30')
NOTE: BORE AND JACK IN THIS AREA
(ALT. I RECONSTRUCTION ONLY)

REMOVE AND REPLACE -(2)
2' x 2' AREA INLETS
ALT. I RECONSTRUCTION ONLY

NOTE: INFORMATION AS TO LOCATION OF
BUILDING LEADS & SPOT REPAIRS FROM
CITY OF WICHITA (VIDEO TAPE NO. C138)
12-05-83

- LEGEND
- ↑ - BUILDING LEAD
 - ▲ - SPOT REPAIR
 - ⊙ - HOLE
 - ⊗ - MISSING TILE

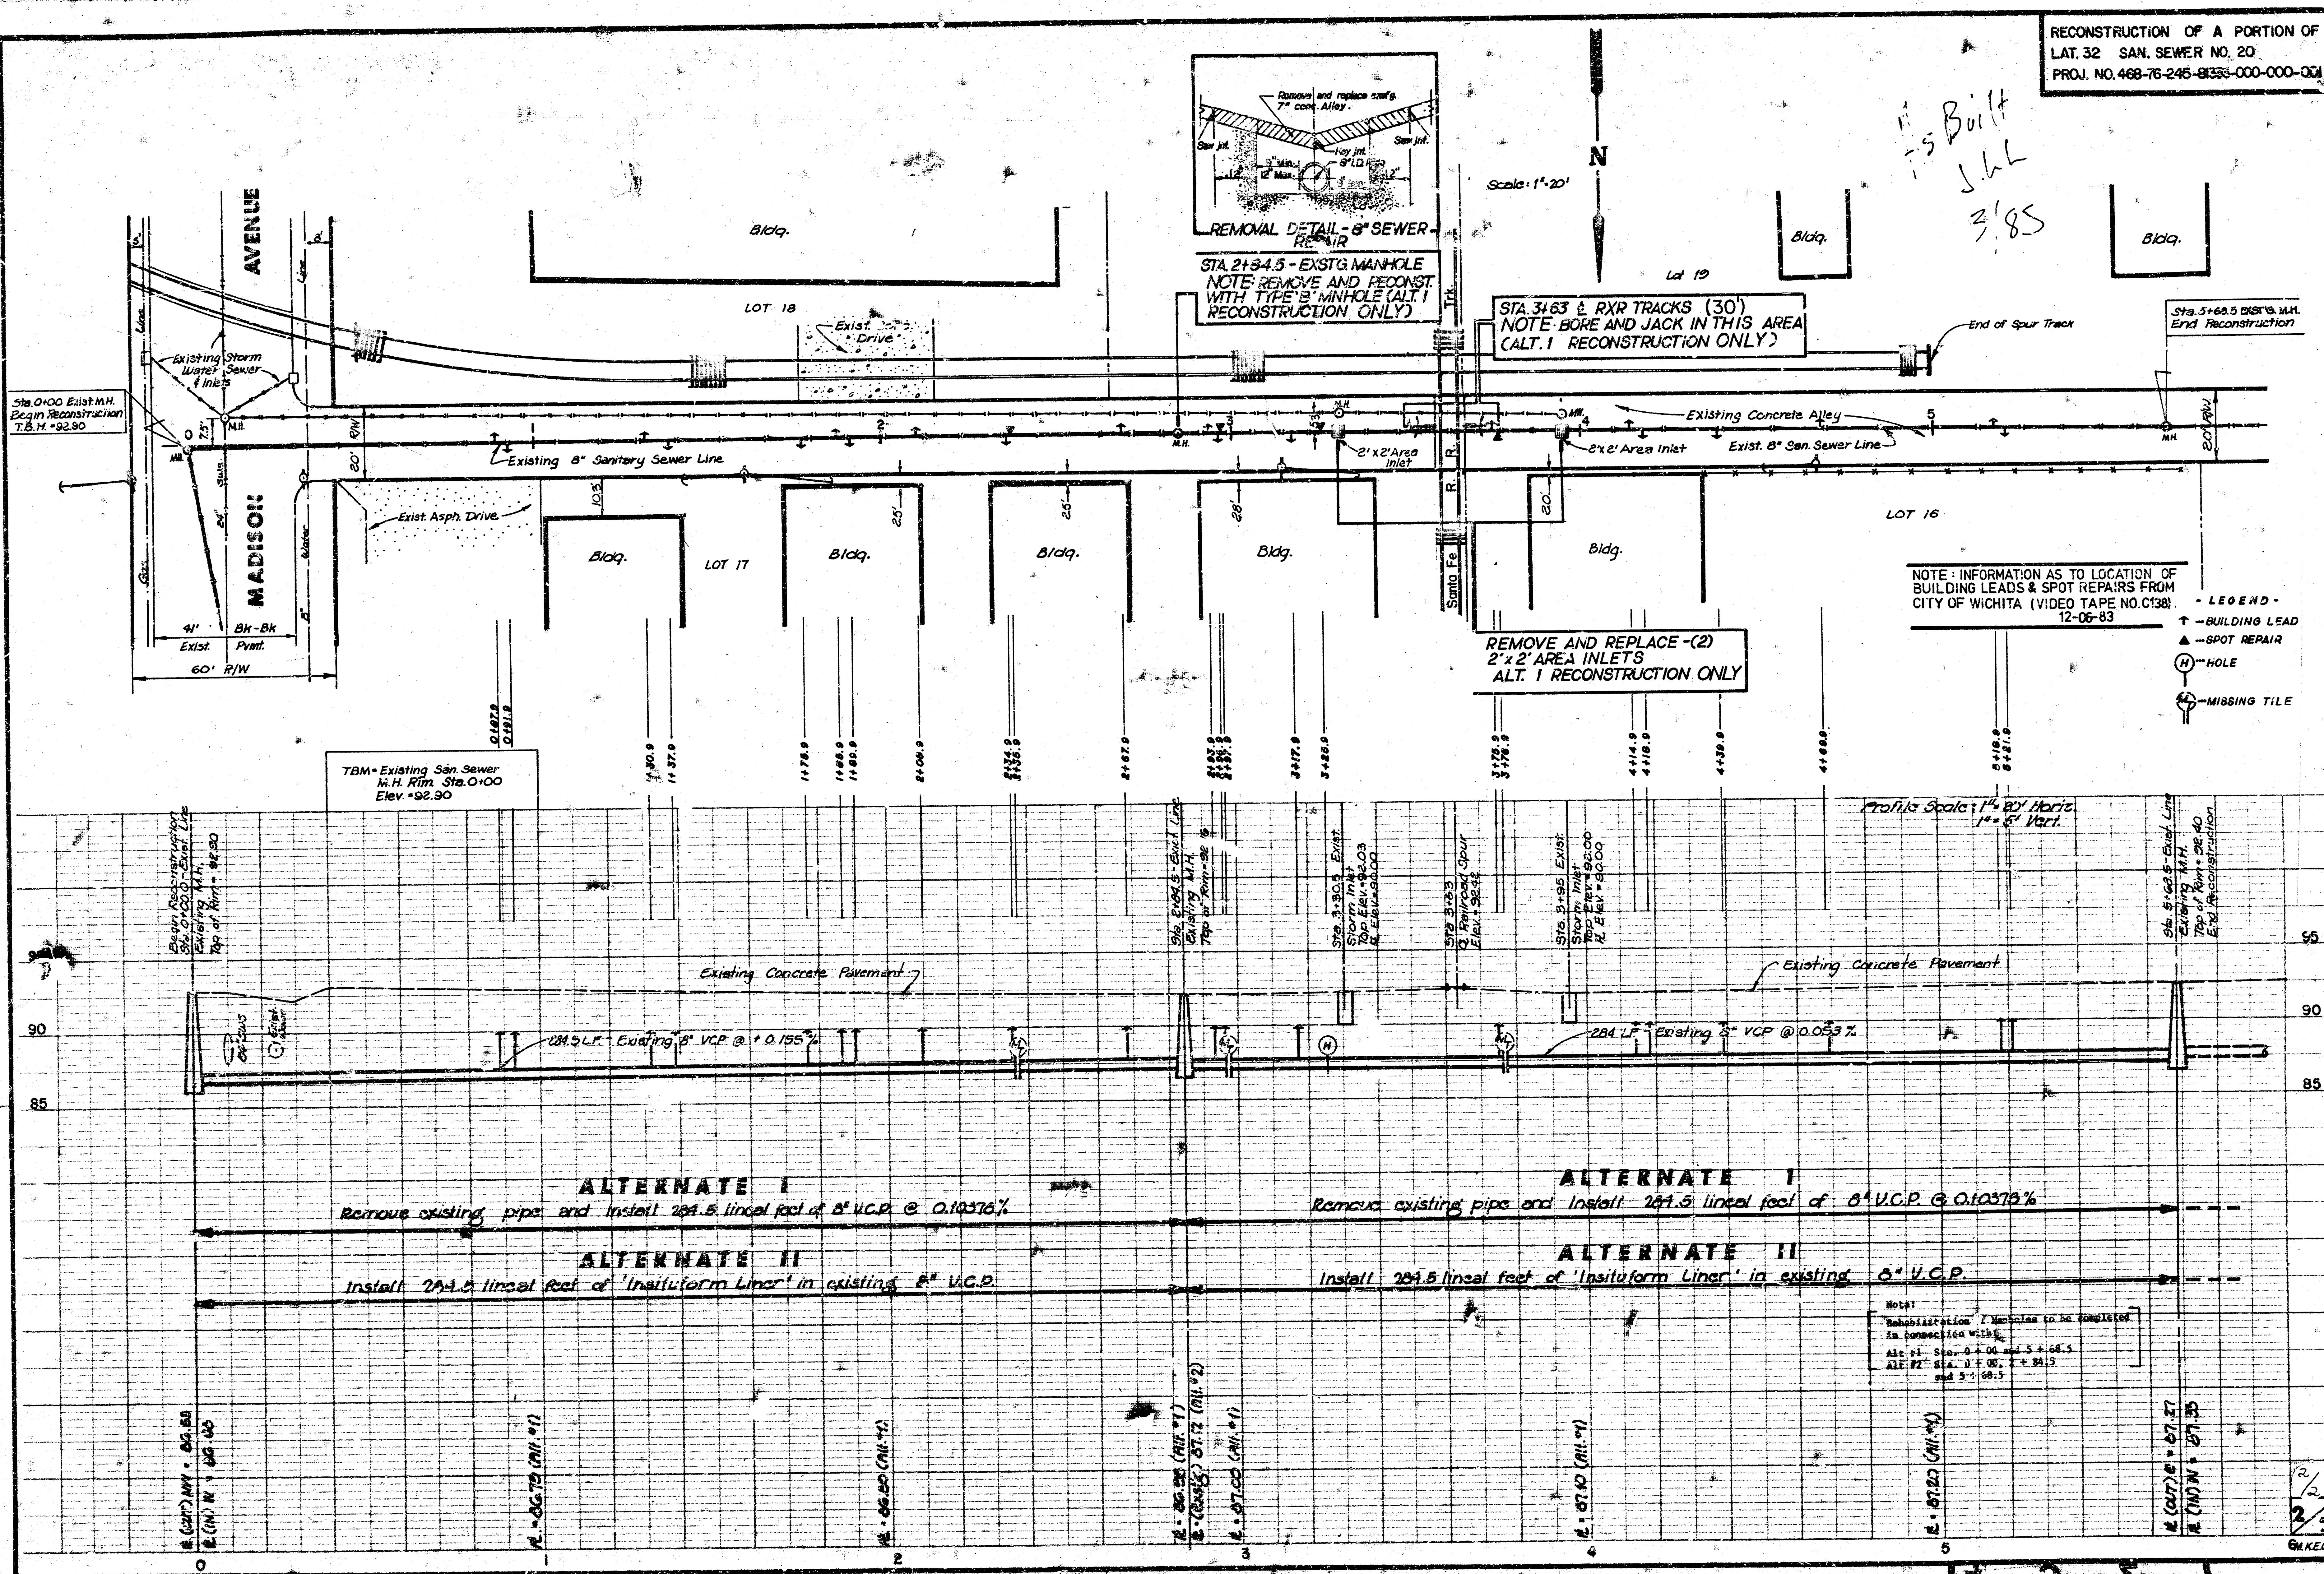

Notes:
Rehabilitation / Machine to be completed
in connection with:
Alt. #1 Sta. 0+00 to 5+68.5
Alt. #2 Sta. 0+05 to 5+94.5
and 5+68.5

ON KEC