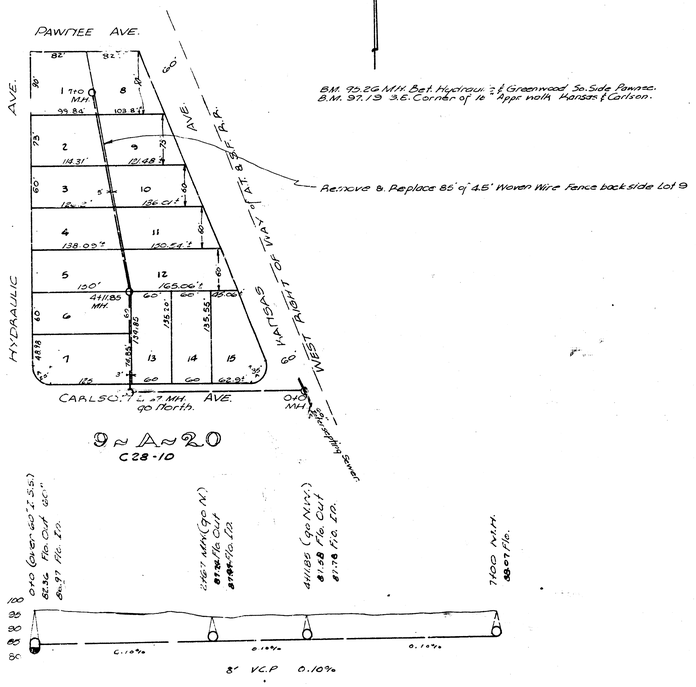

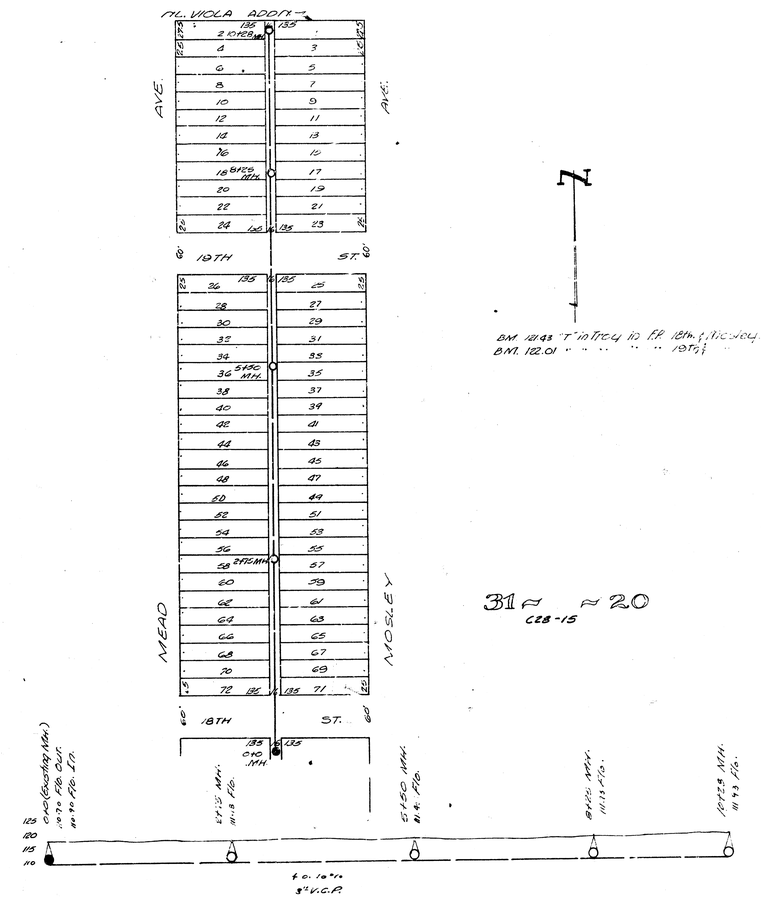

LAT. 9, DIST. A, MAIN 20
LAT. 31, DIST. MAIN 20

CITY OF WICHITA, KANS.

W. WHITE City Engineer.

June 1948 Proj Nos. C28-15&10