



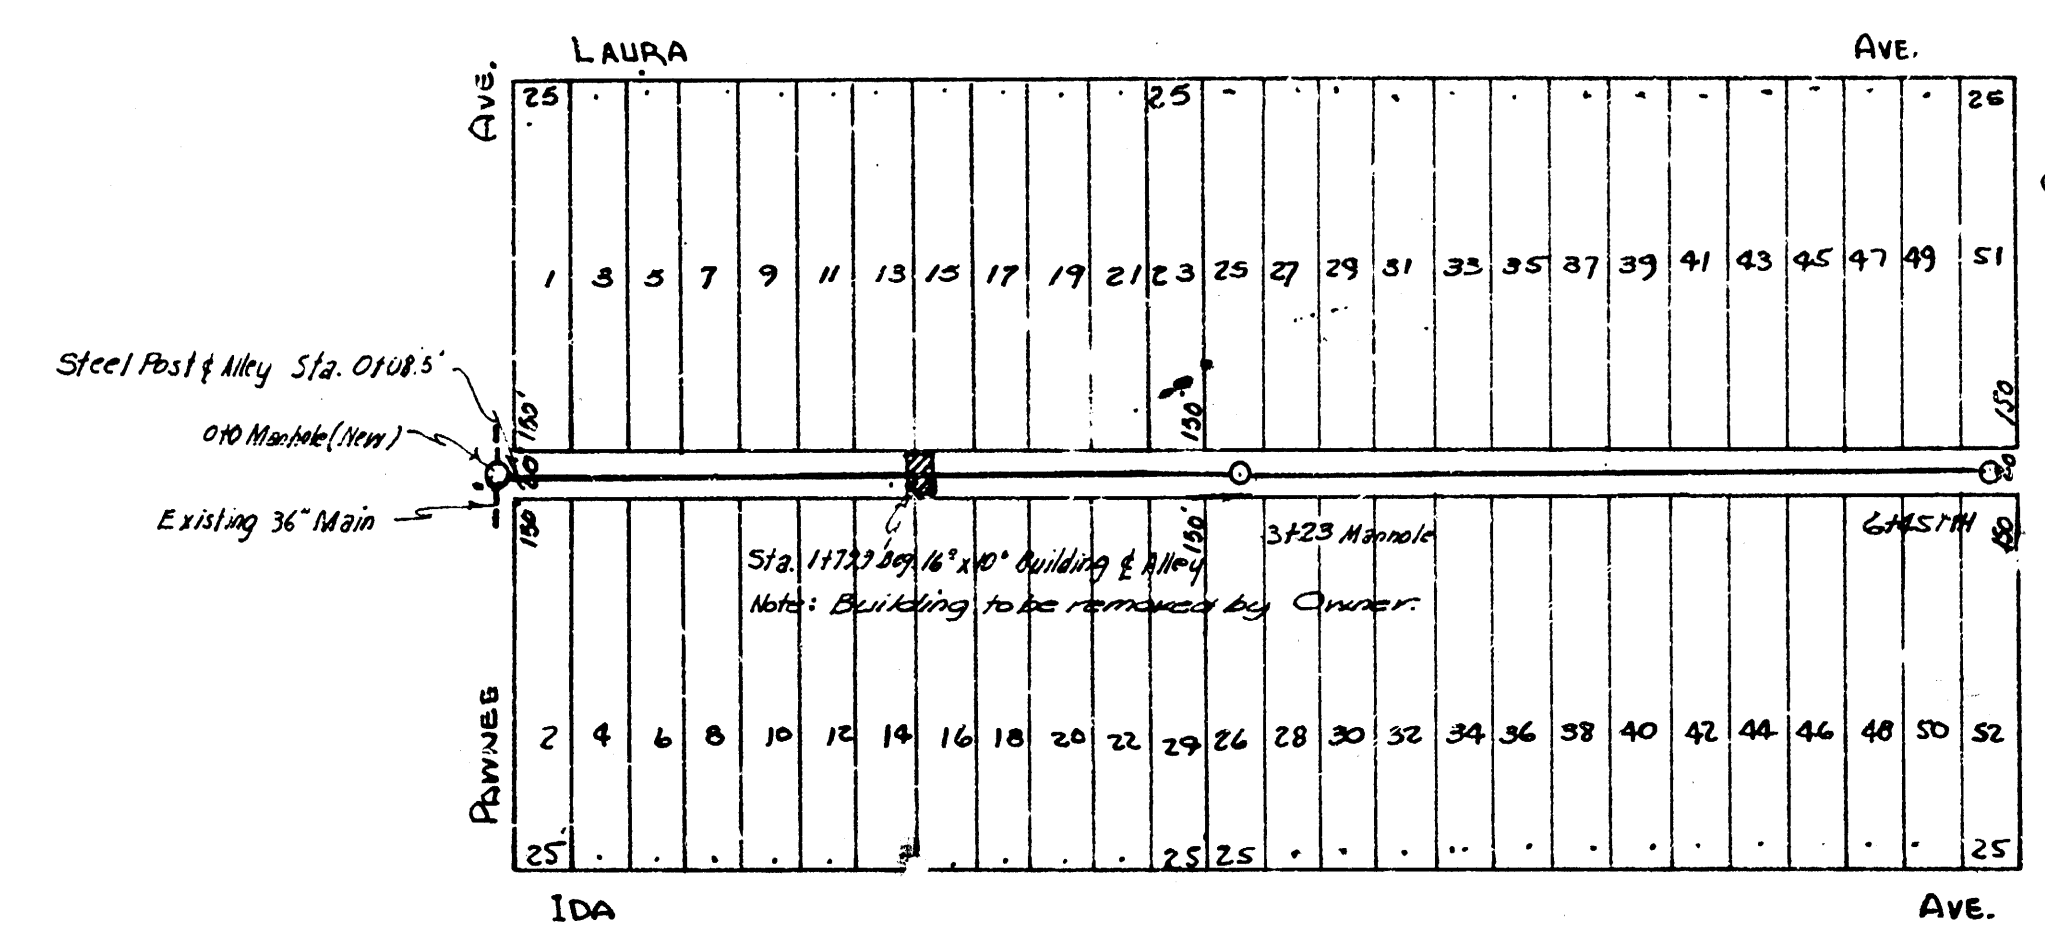

Sta. 7942 Standard NE Corner Pawnee & Washington
 Sta. 7732 RR Spike in RR MS Pawnee Det. Laef Laura
 Sta. 7735 RR Spike between WS Alley Det. Laef Laura, 200' So. of Pawnee.

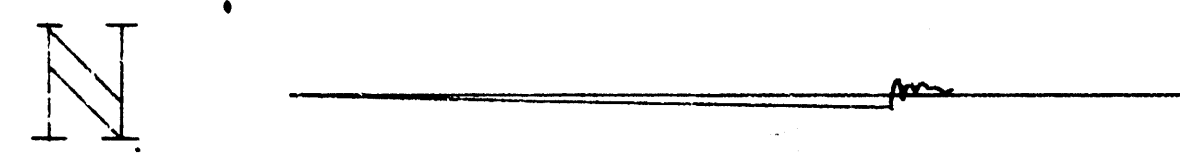