



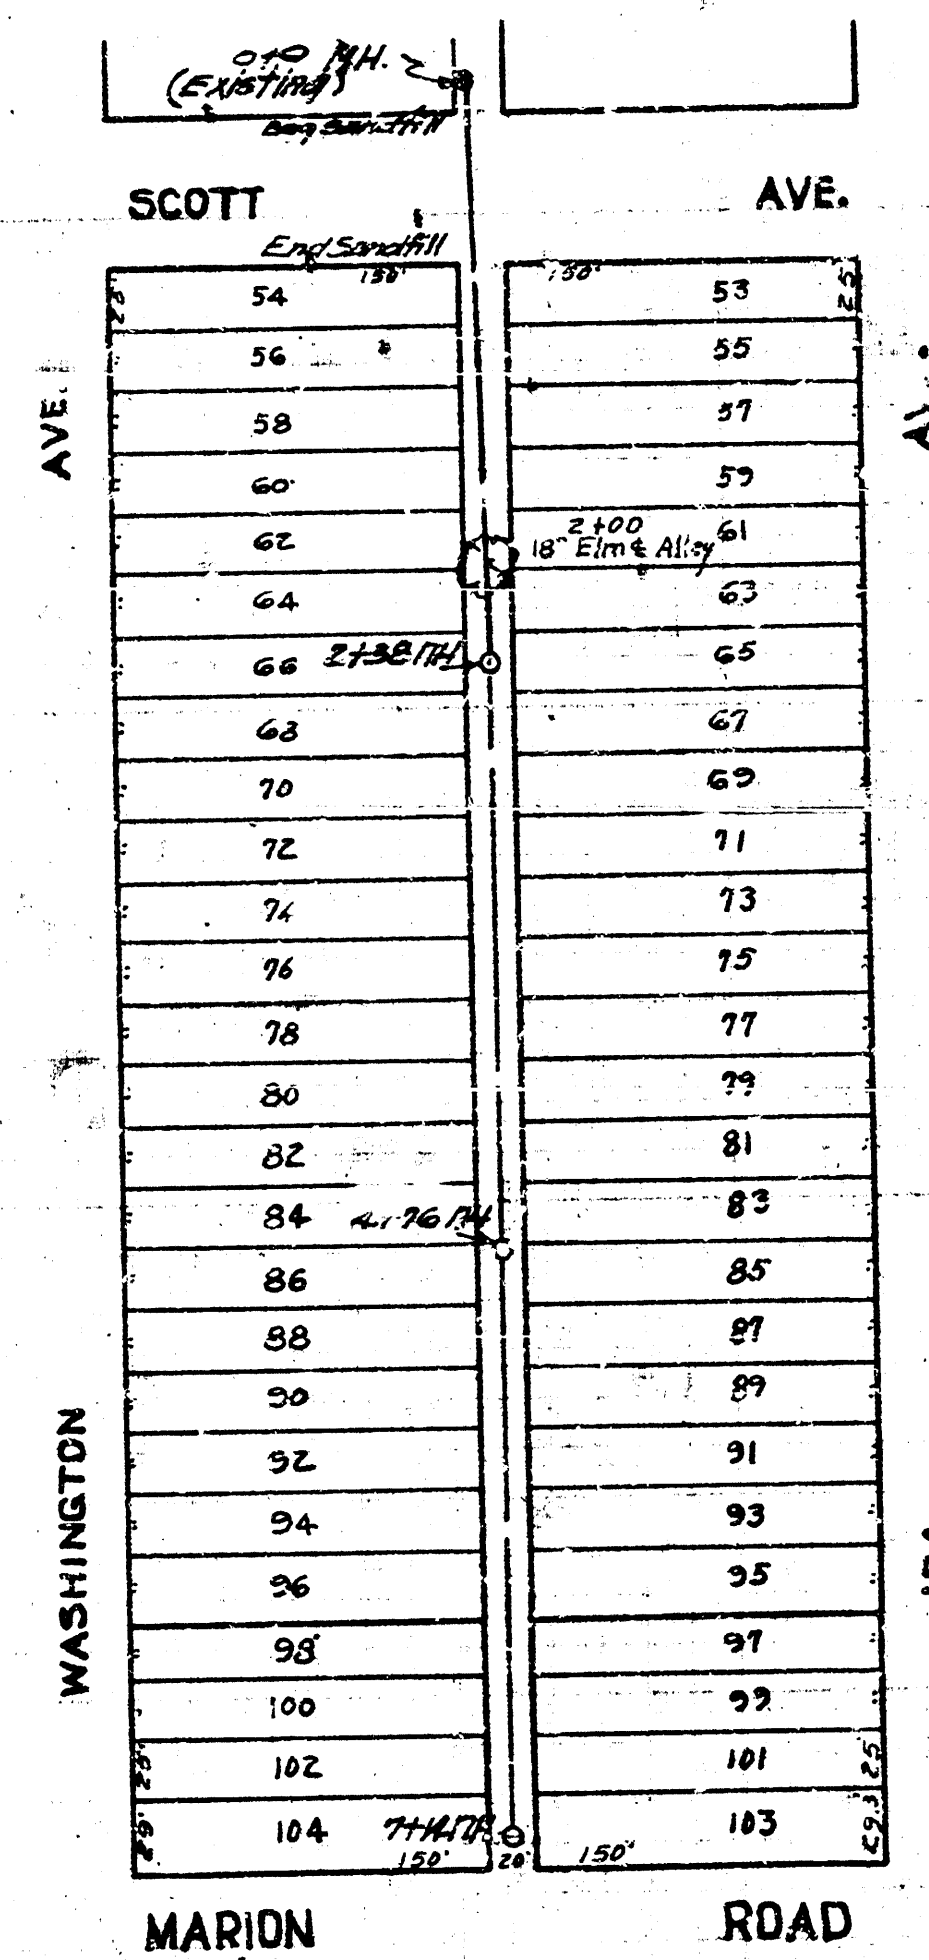





N
SCALE 1"=30'

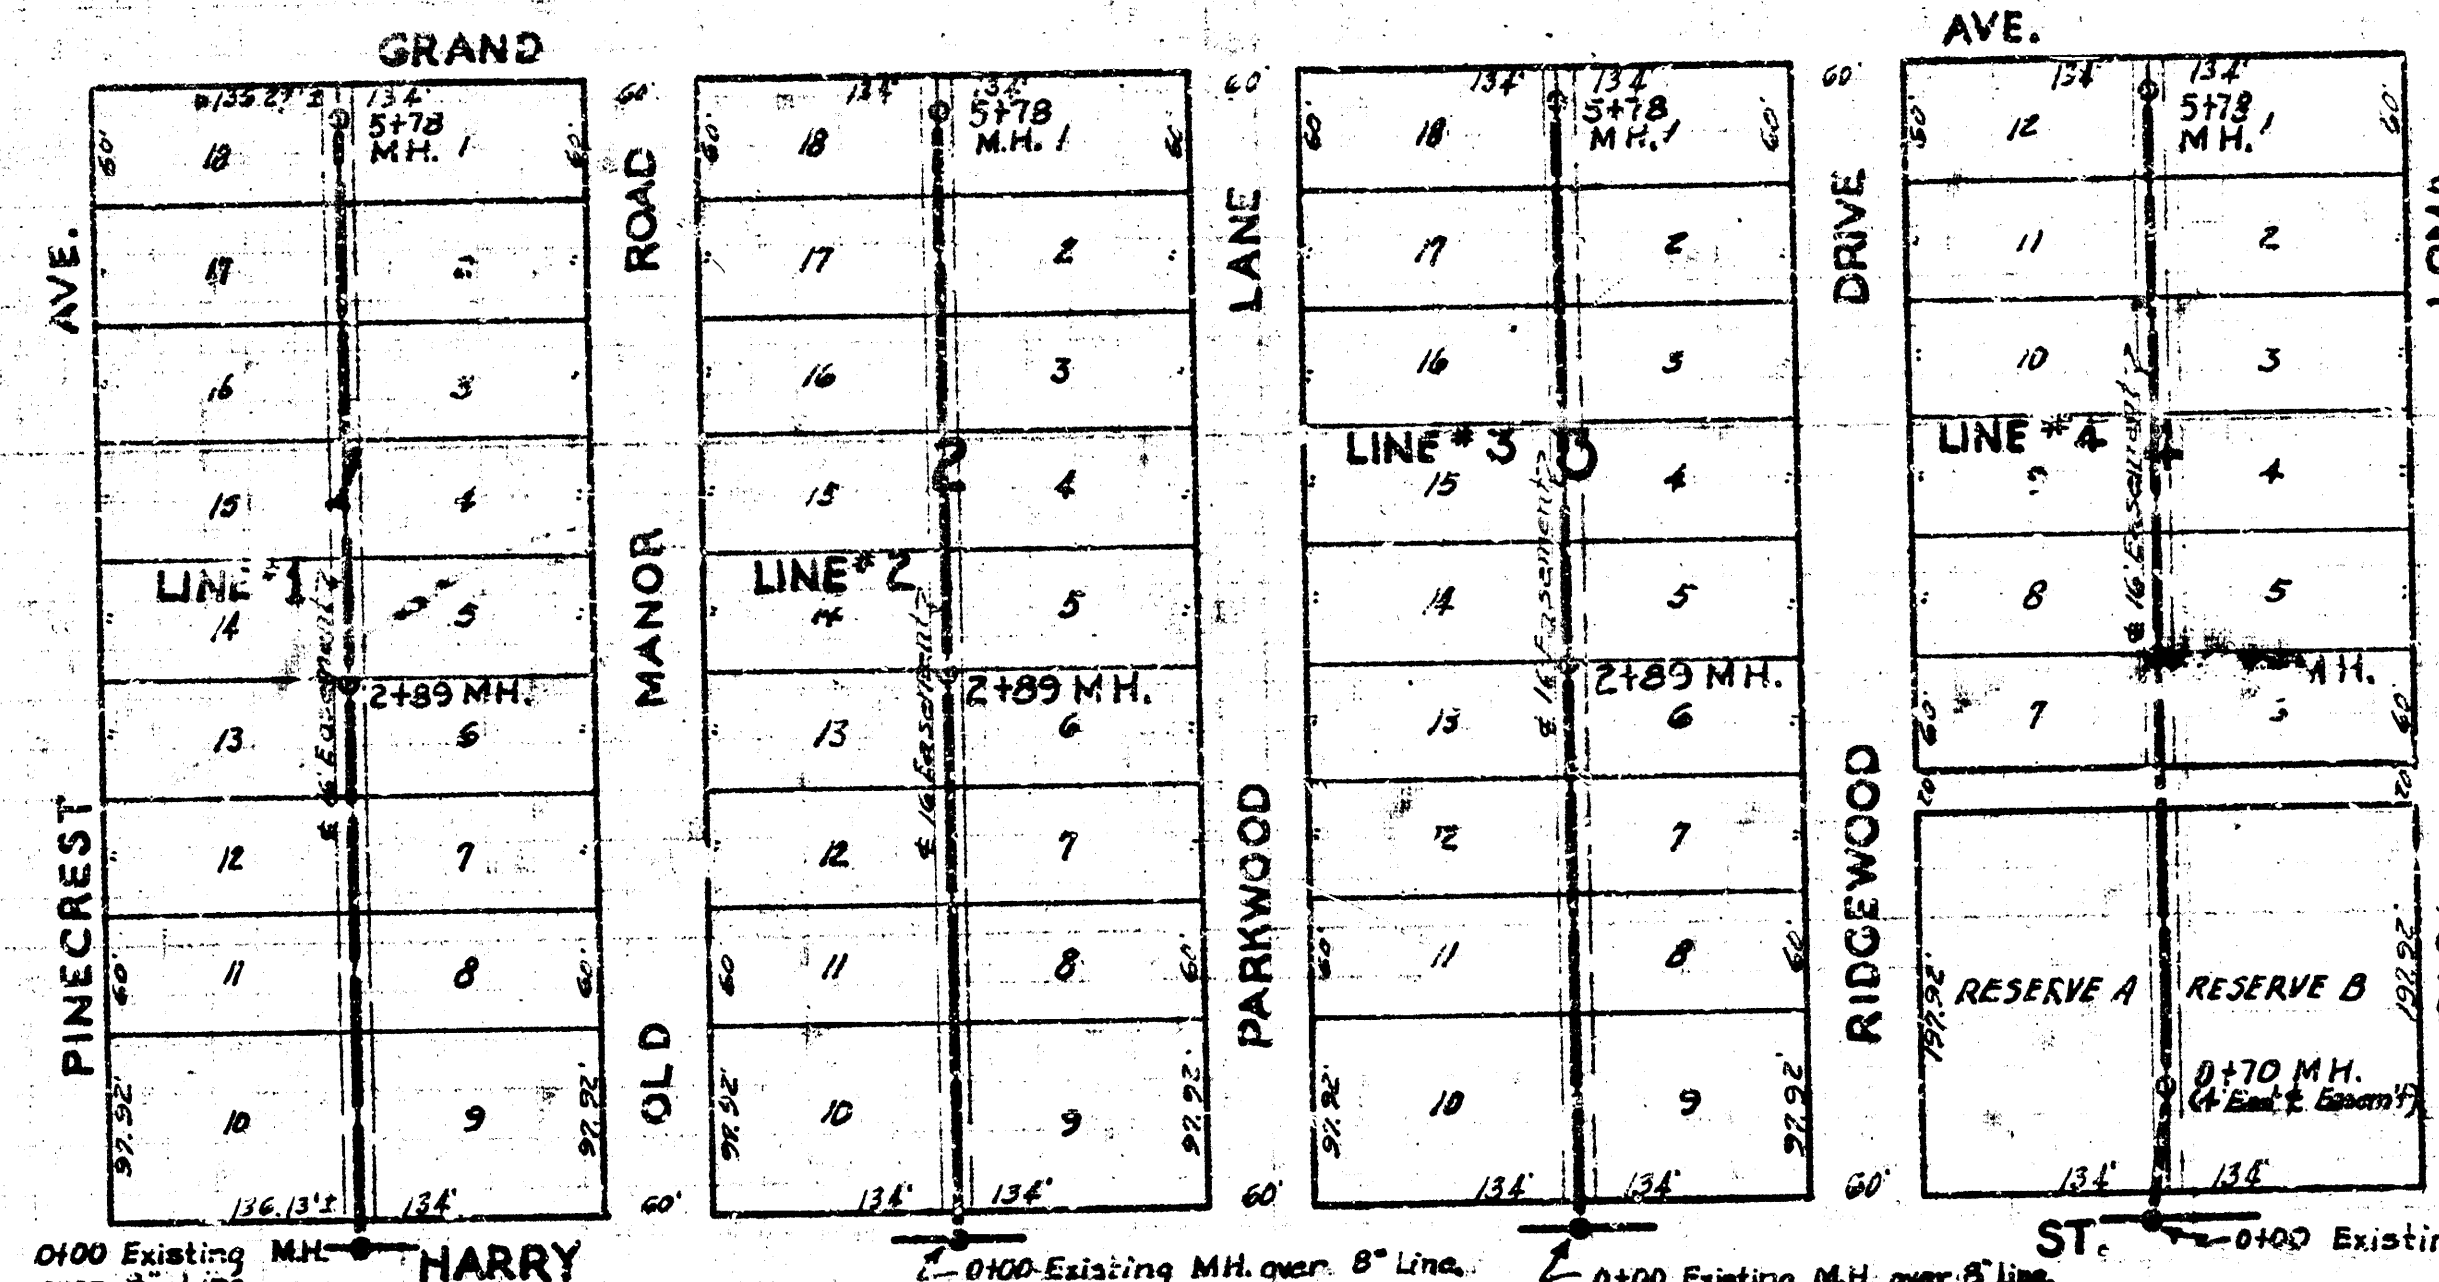

N
SCALE 1"=100'

Lat. 16, Dist. A, S.S. # 20
Project No. C 20-13

B.M. 97.62 Std. N.E. cor. Pawnee & Washington.
B.M. 96.81 "G" in Globe So. curb of return "H" #2469.

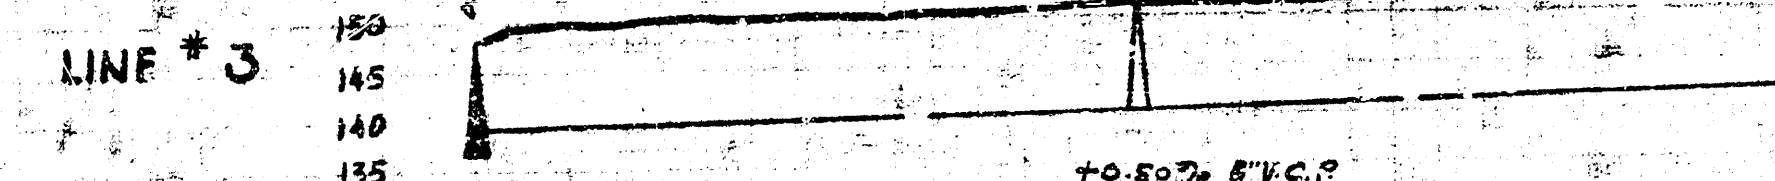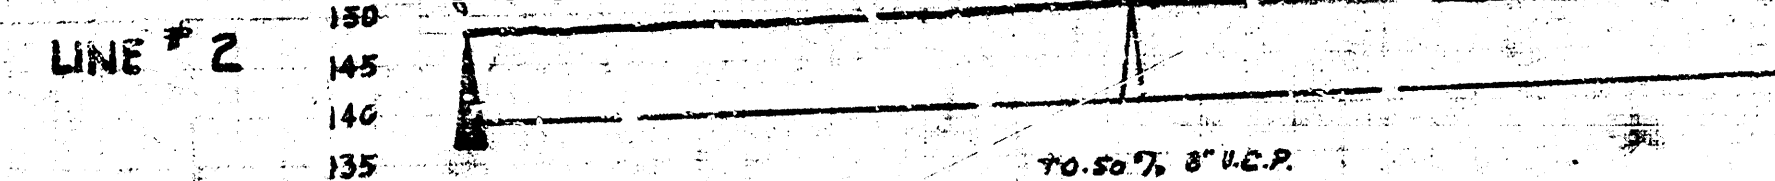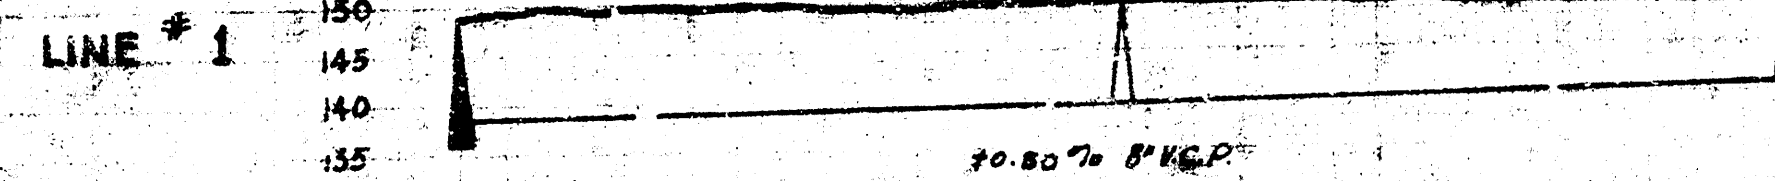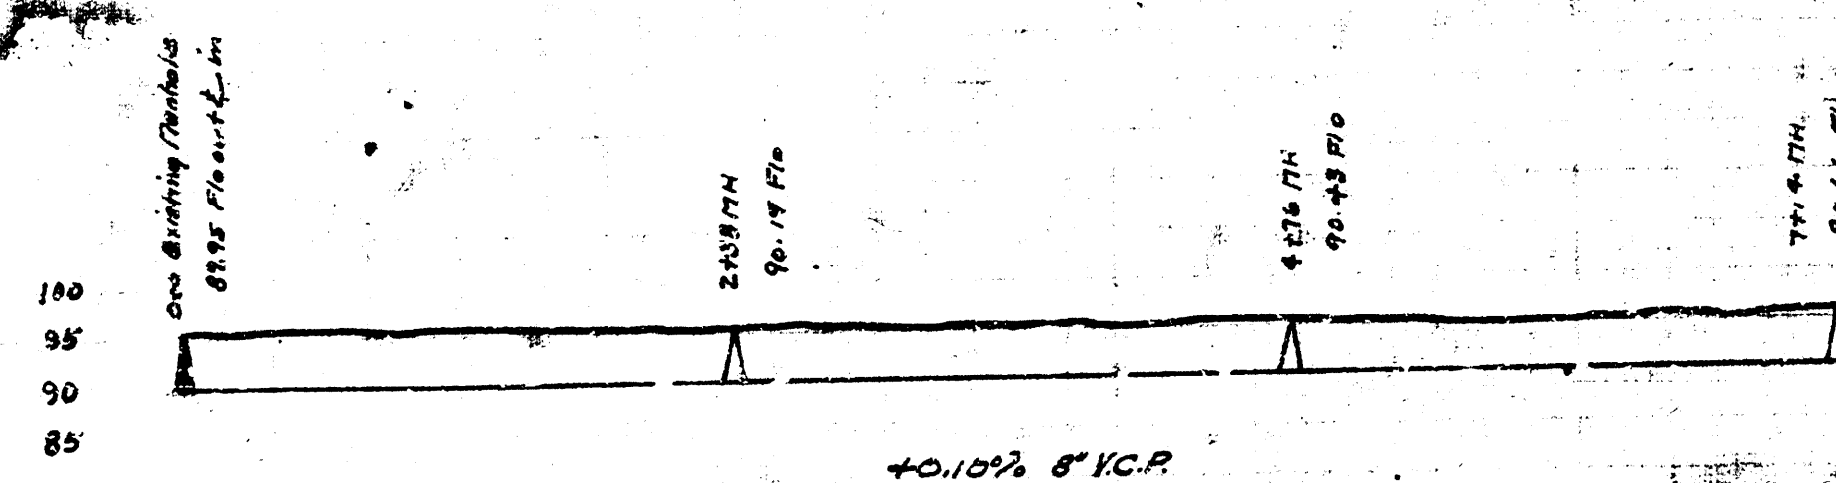

Lat. 16, Dist. A, S.S. # 20 - Lat. 16, D.C.S. S.S. # 12
City of Wichita, Kansas
L.R. White - City Engineer
Data 3-28-50 - Proj. No. C20-13