

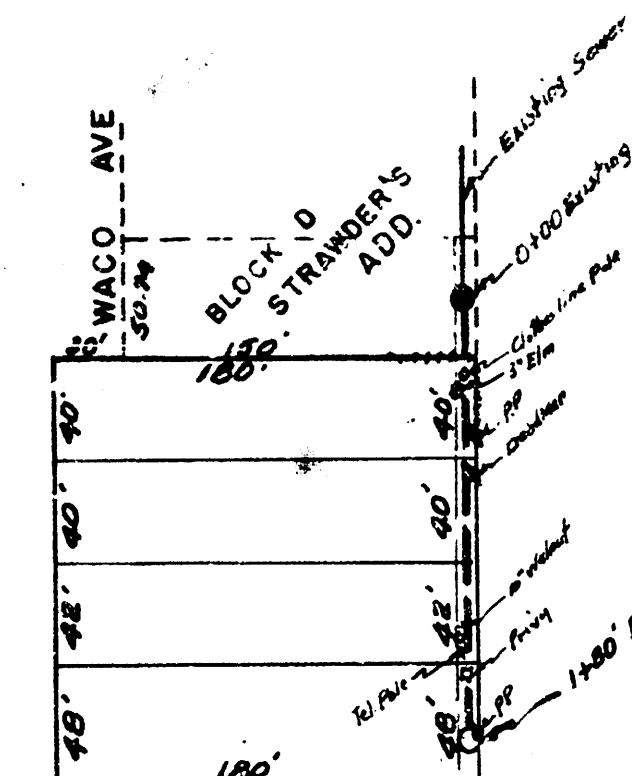
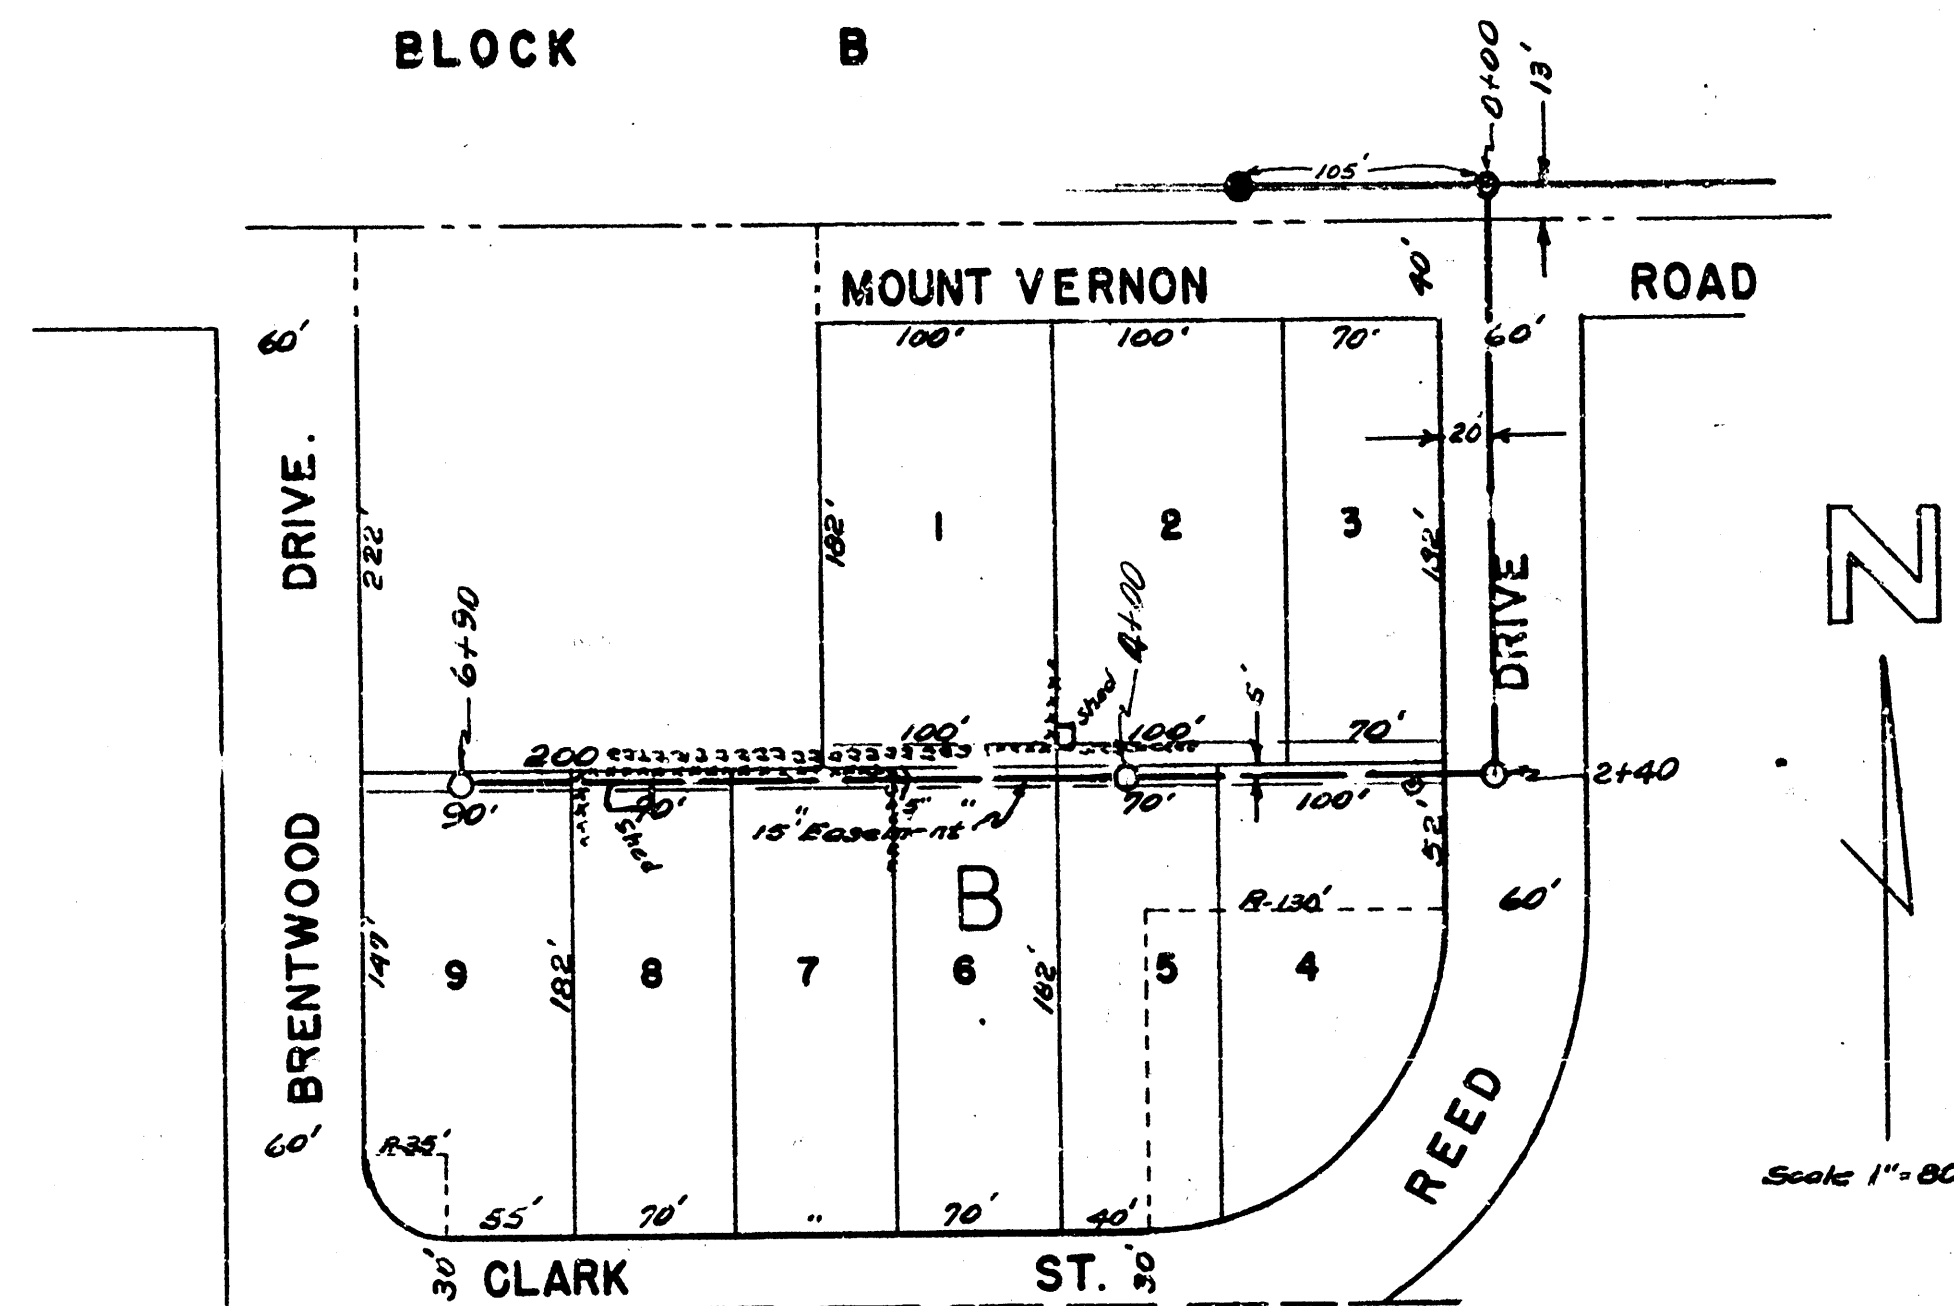


**MOUNT VERNON HEIGHTS
BLOCK B**

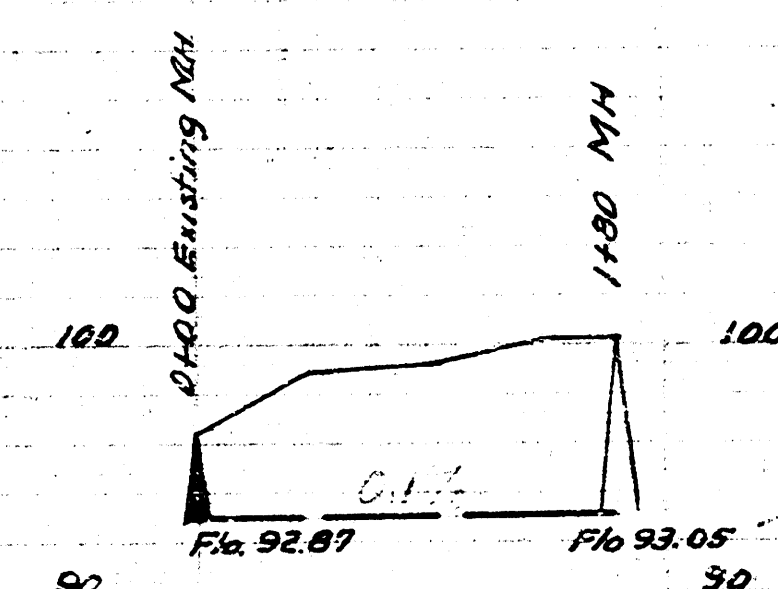

B.M. 128.52 Step bench in N.S. P.R. and pole E. of Clinton N.S. Mt. Vernon

B.M. 97.42 Top cb. so. end of radius SW cor Waco & Blake

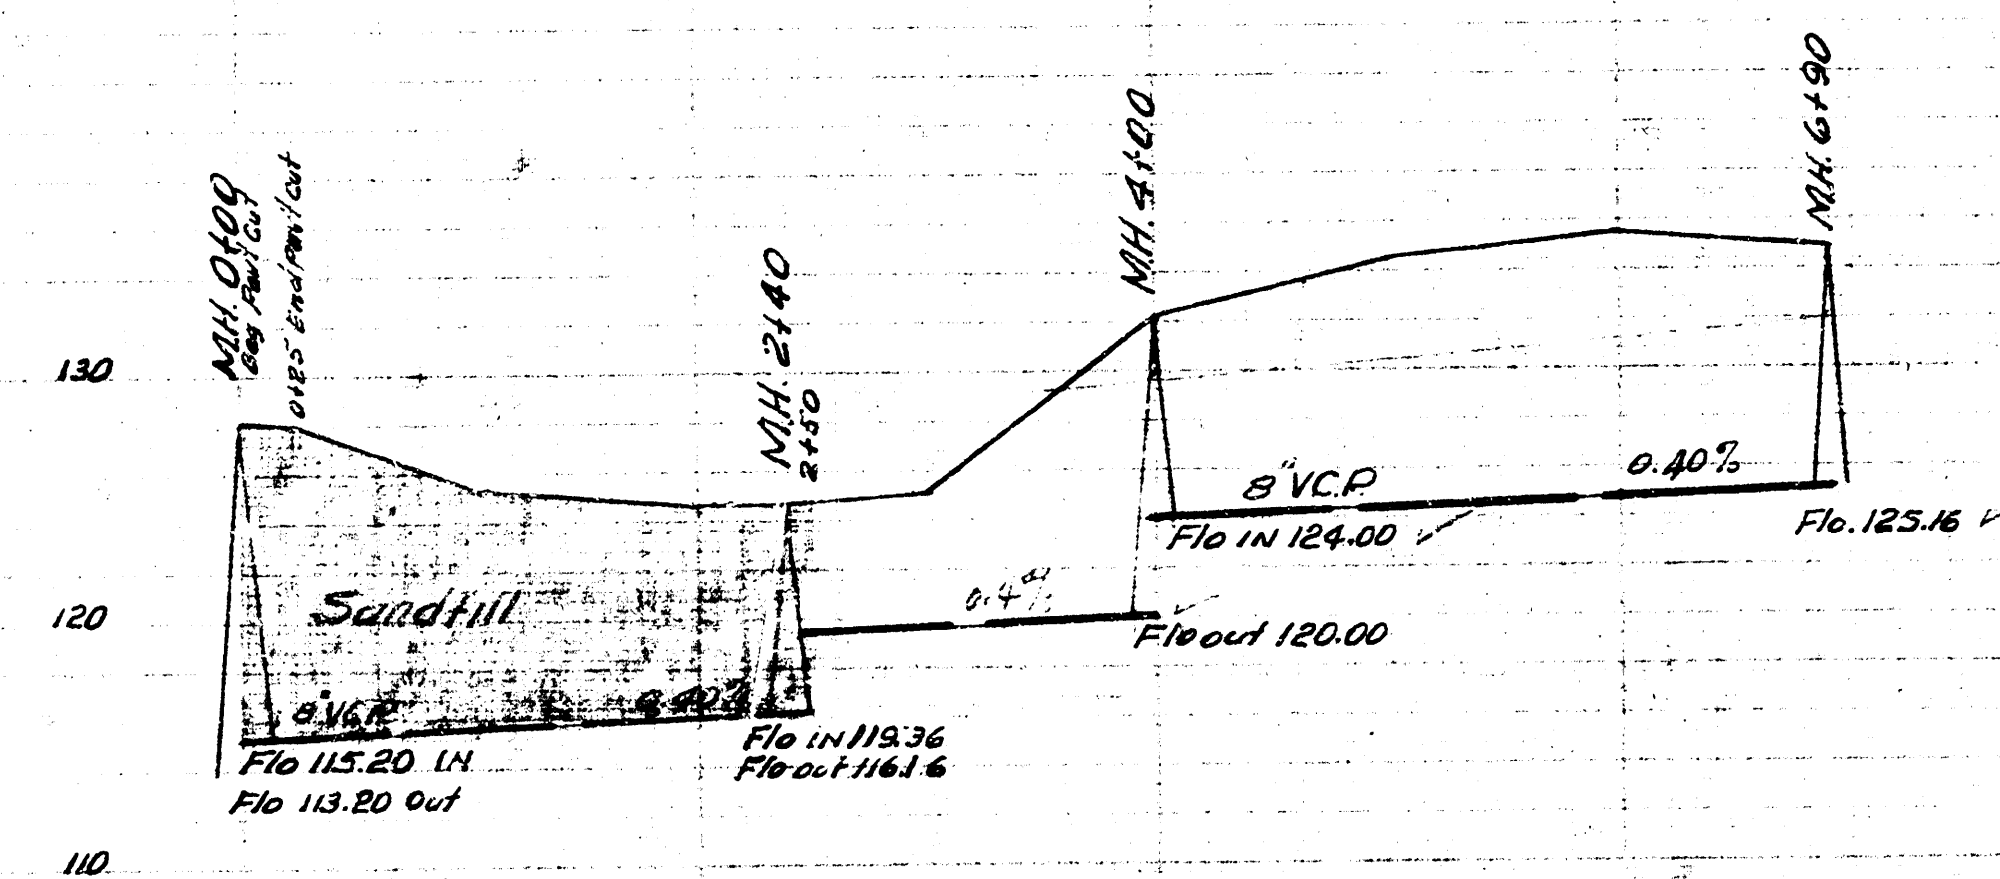

LAT. 25 DCS 2 SS 12
CITY OF WICHITA KANSAS
L.H. WHITE CITY ENGINEER
Proj No C-22-65

LAT. 19 DIST. 19 SS 20
CITY OF WICHITA KANSAS
L.H. WHITE CITY ENGINEER
Proj No C-22-47

9-21-52
Drawn by
Checked by
Block No.

8-9-52
Drawn by
Checked by
Block No.