

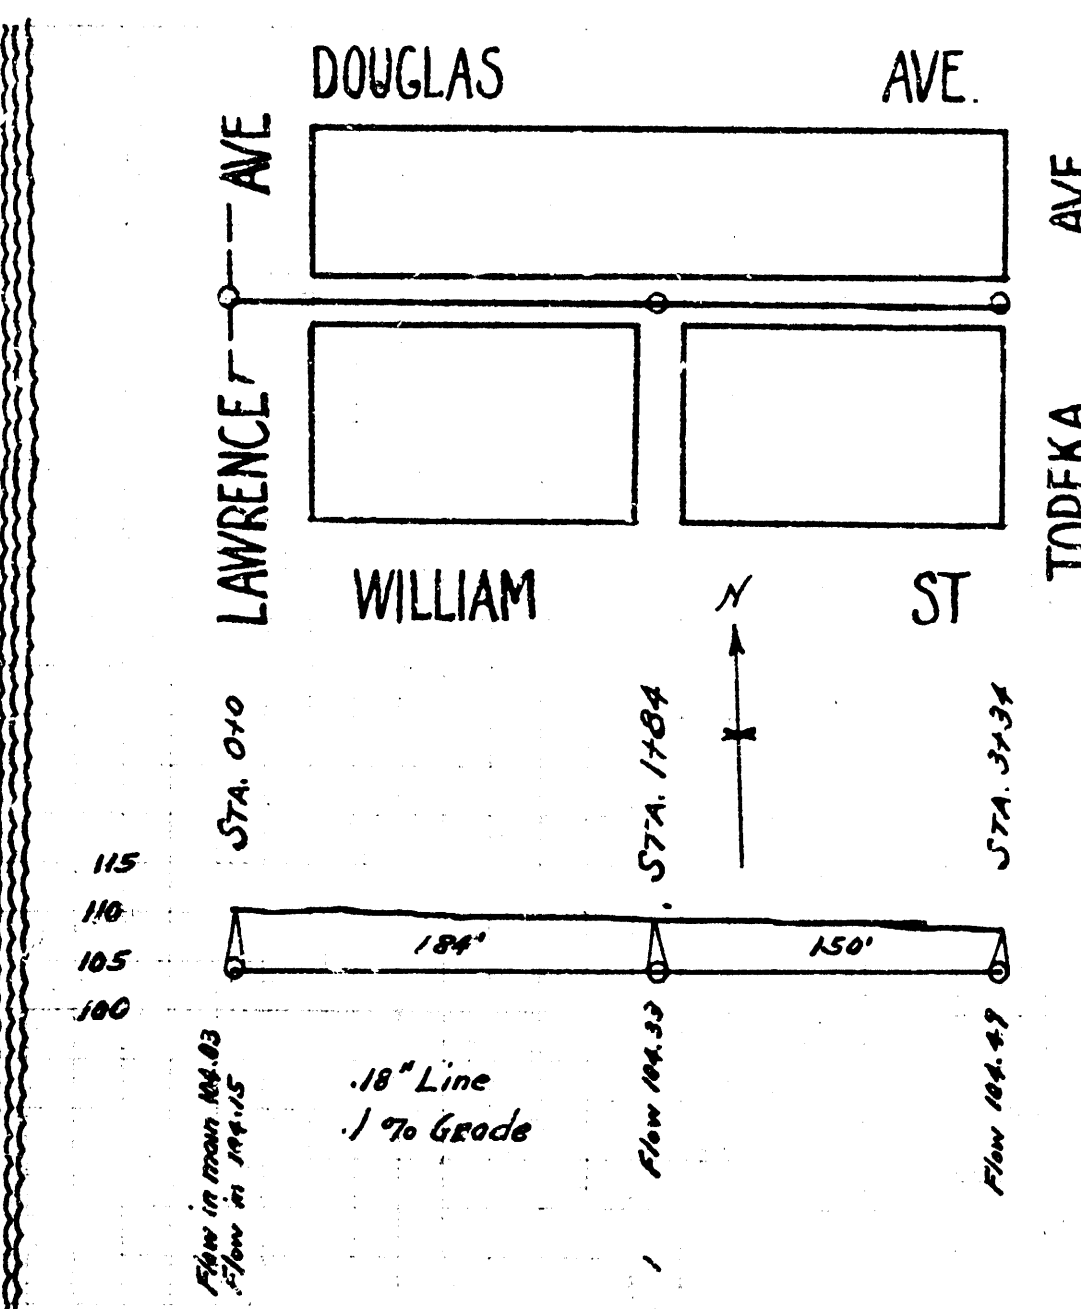
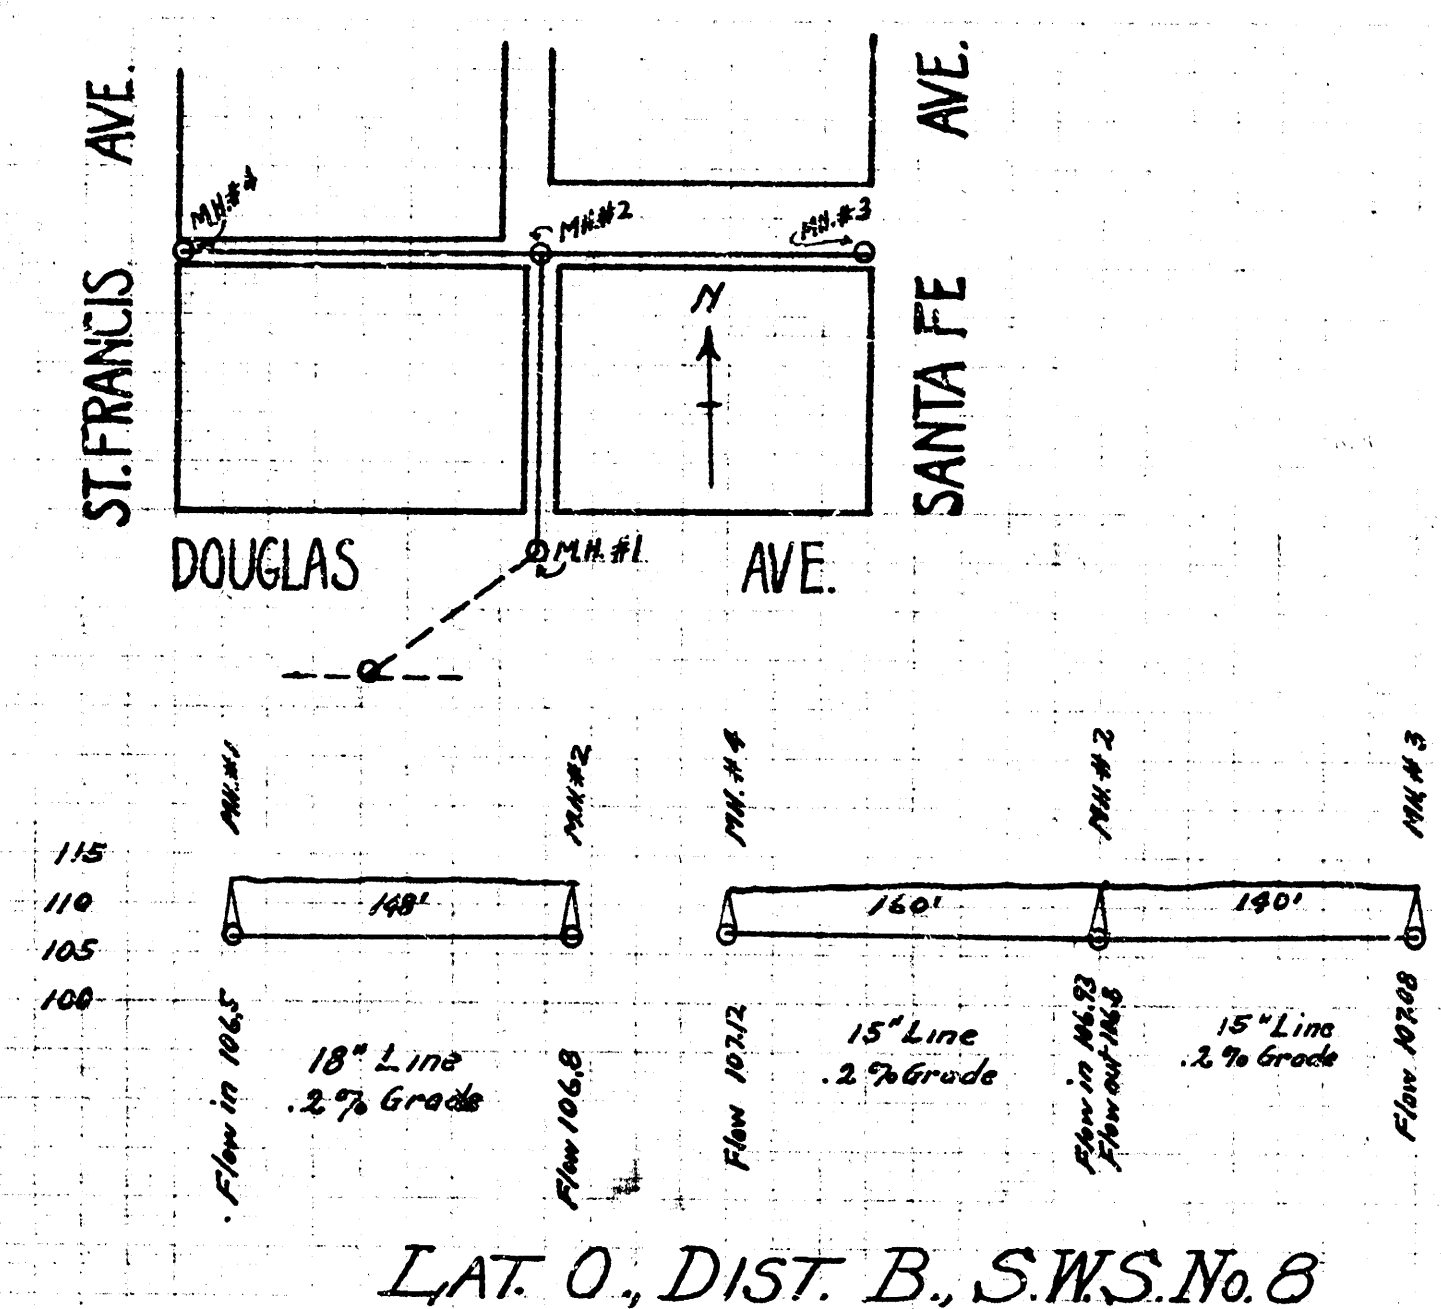


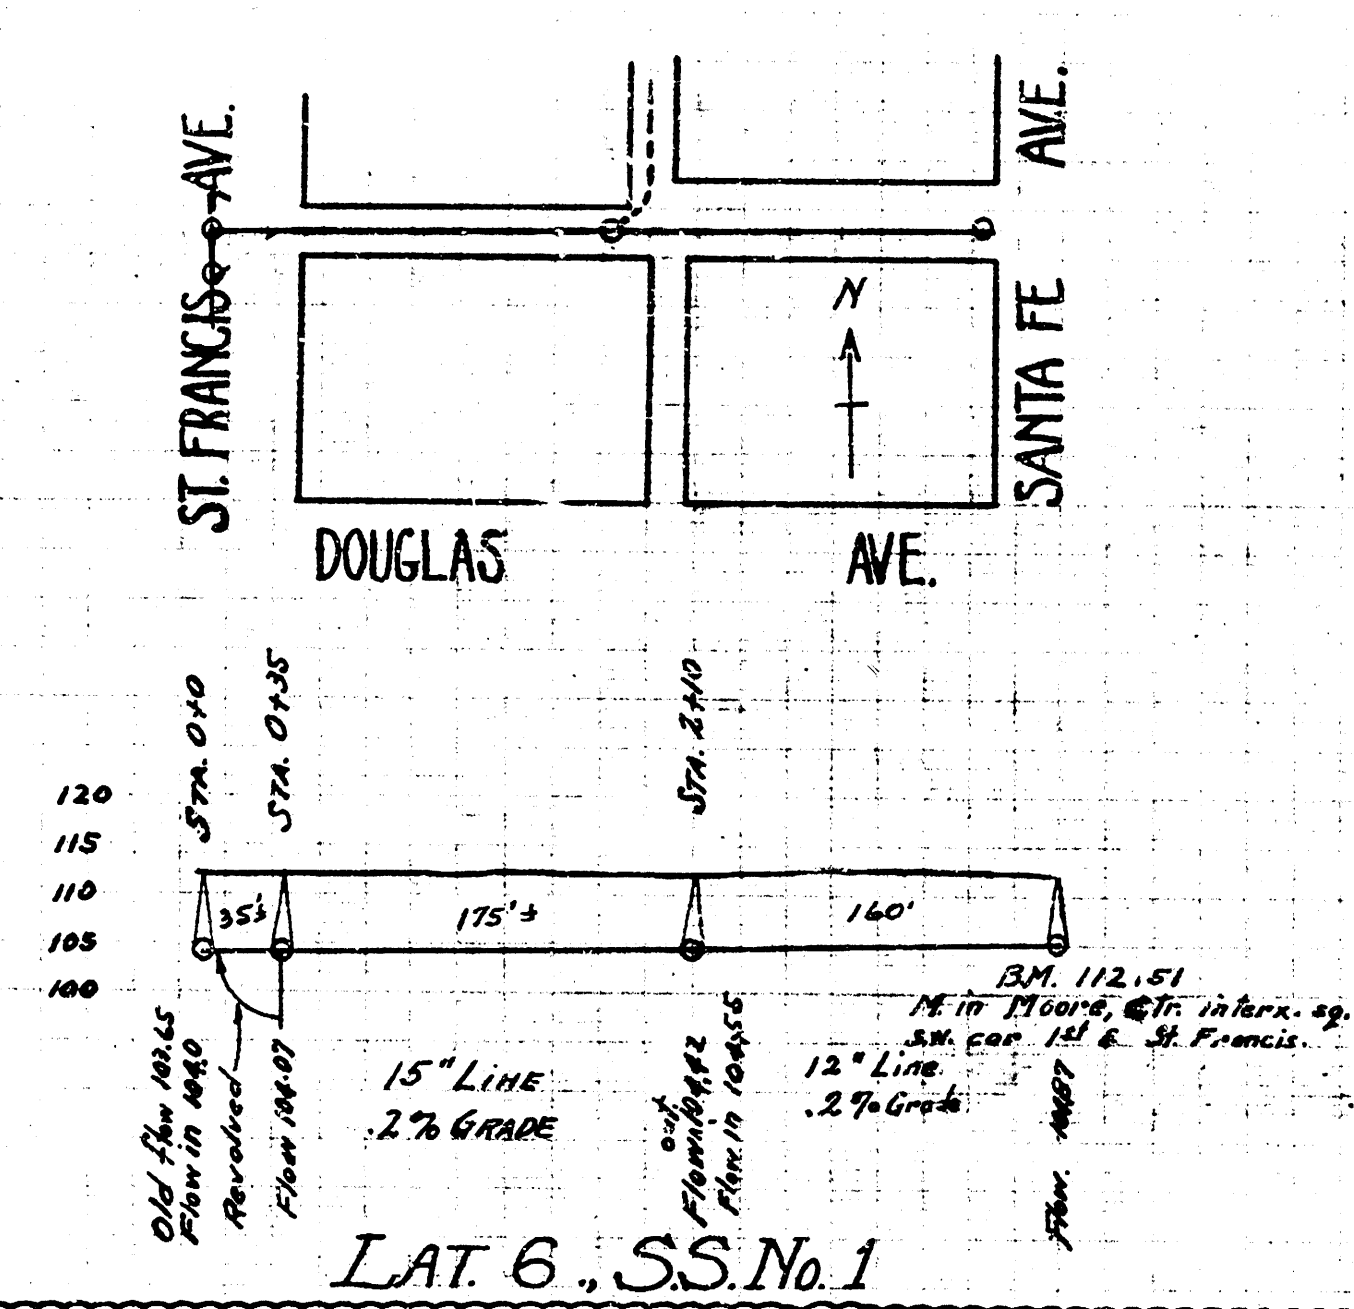

B.M. 110.39 - On south end iron water table under south window E. side International Hotel. Run con. Topeka & Douglas.

LAT. 7, S.S. No. 1.

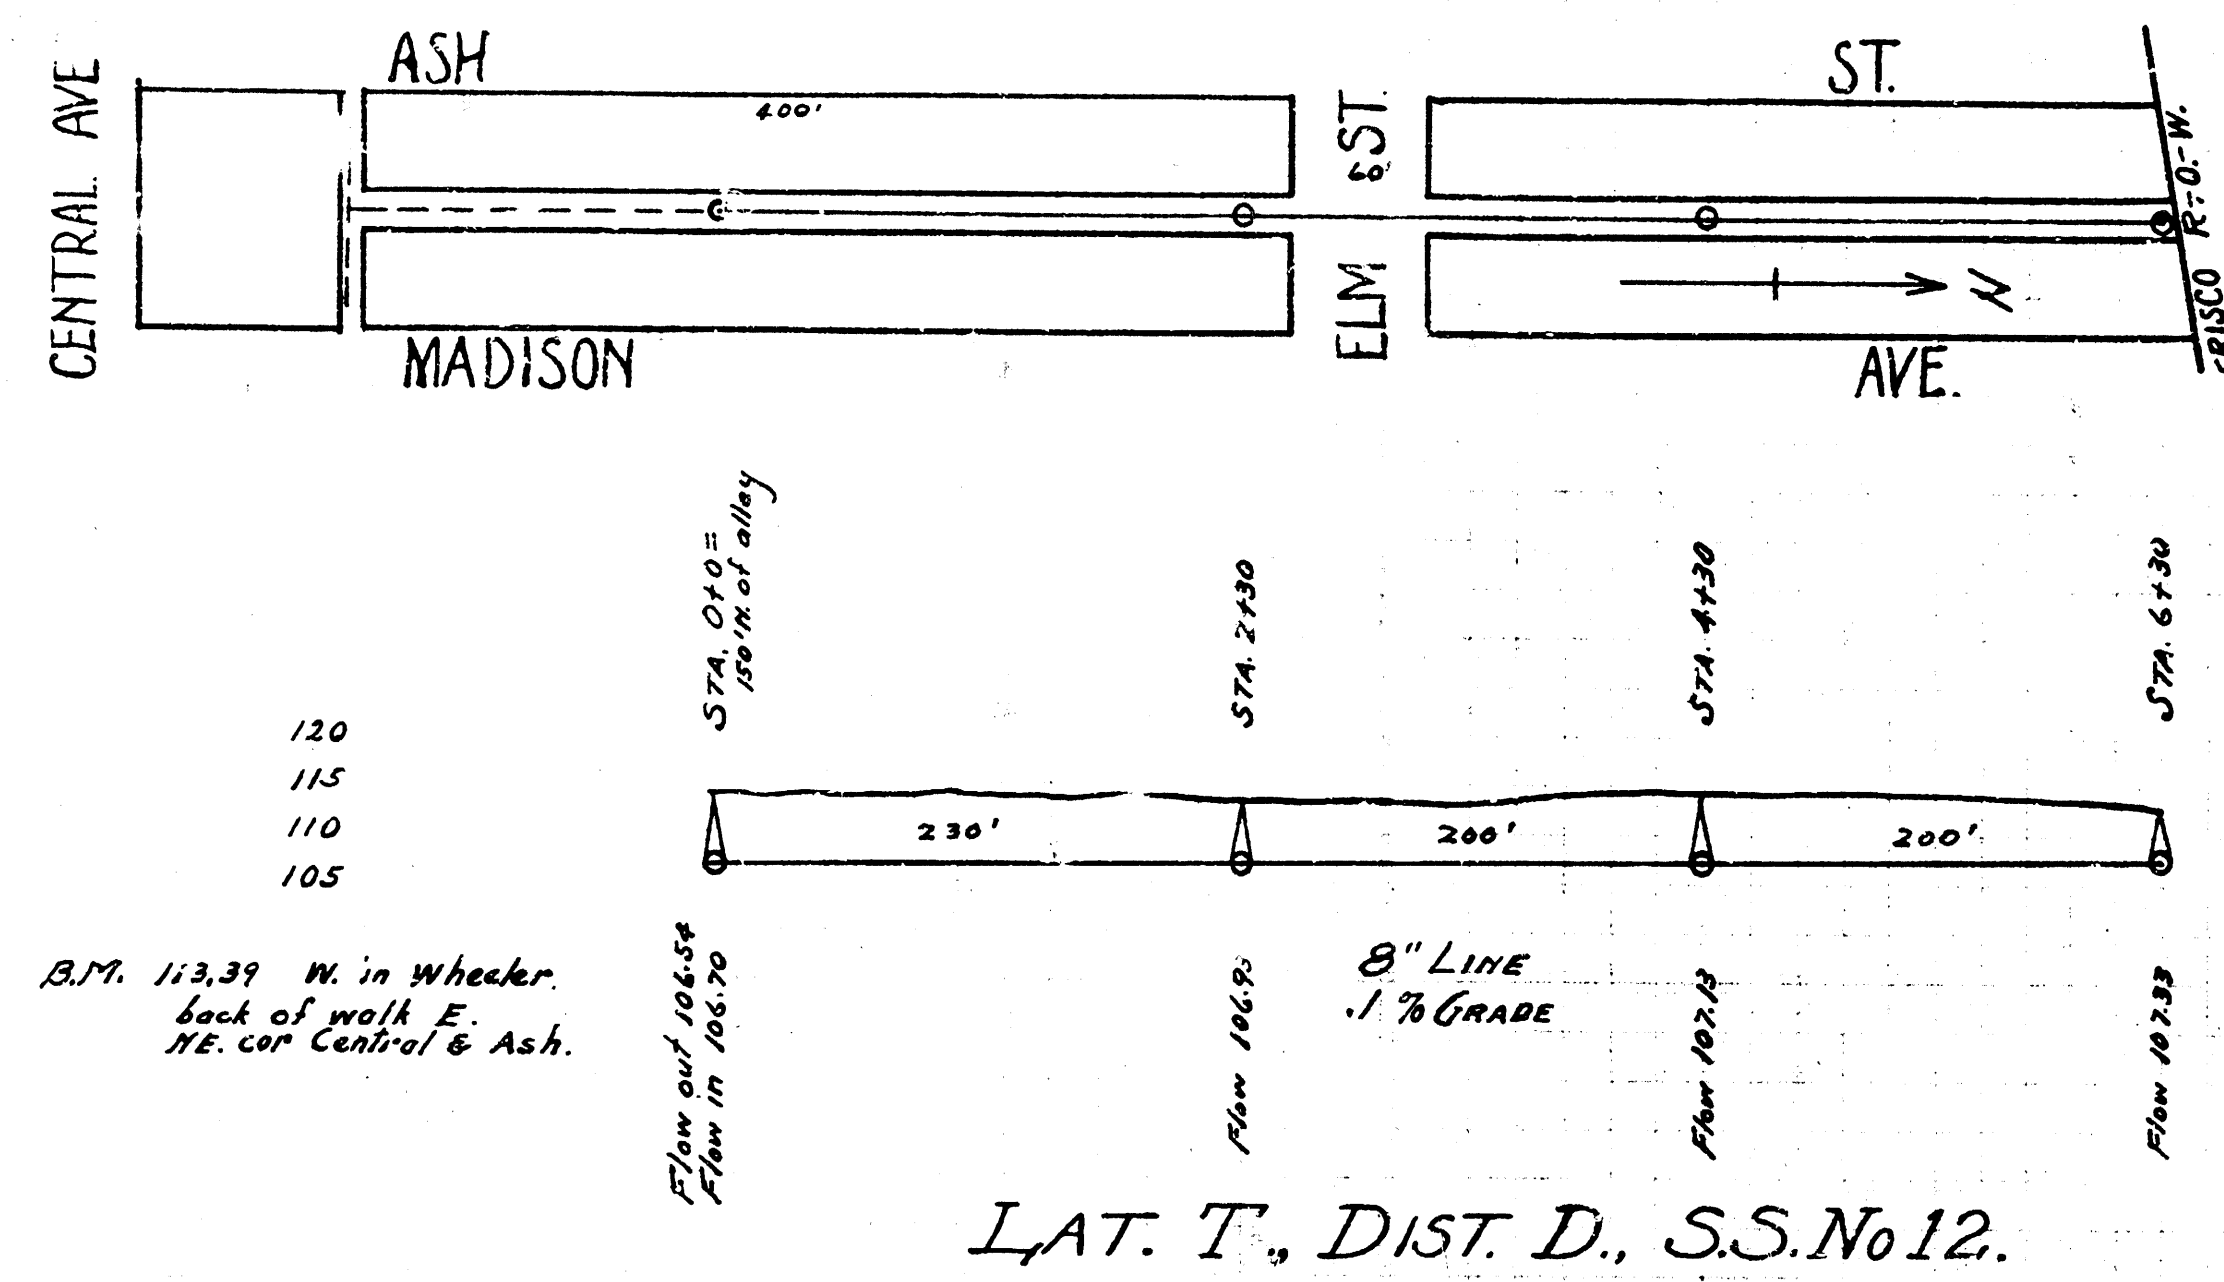