
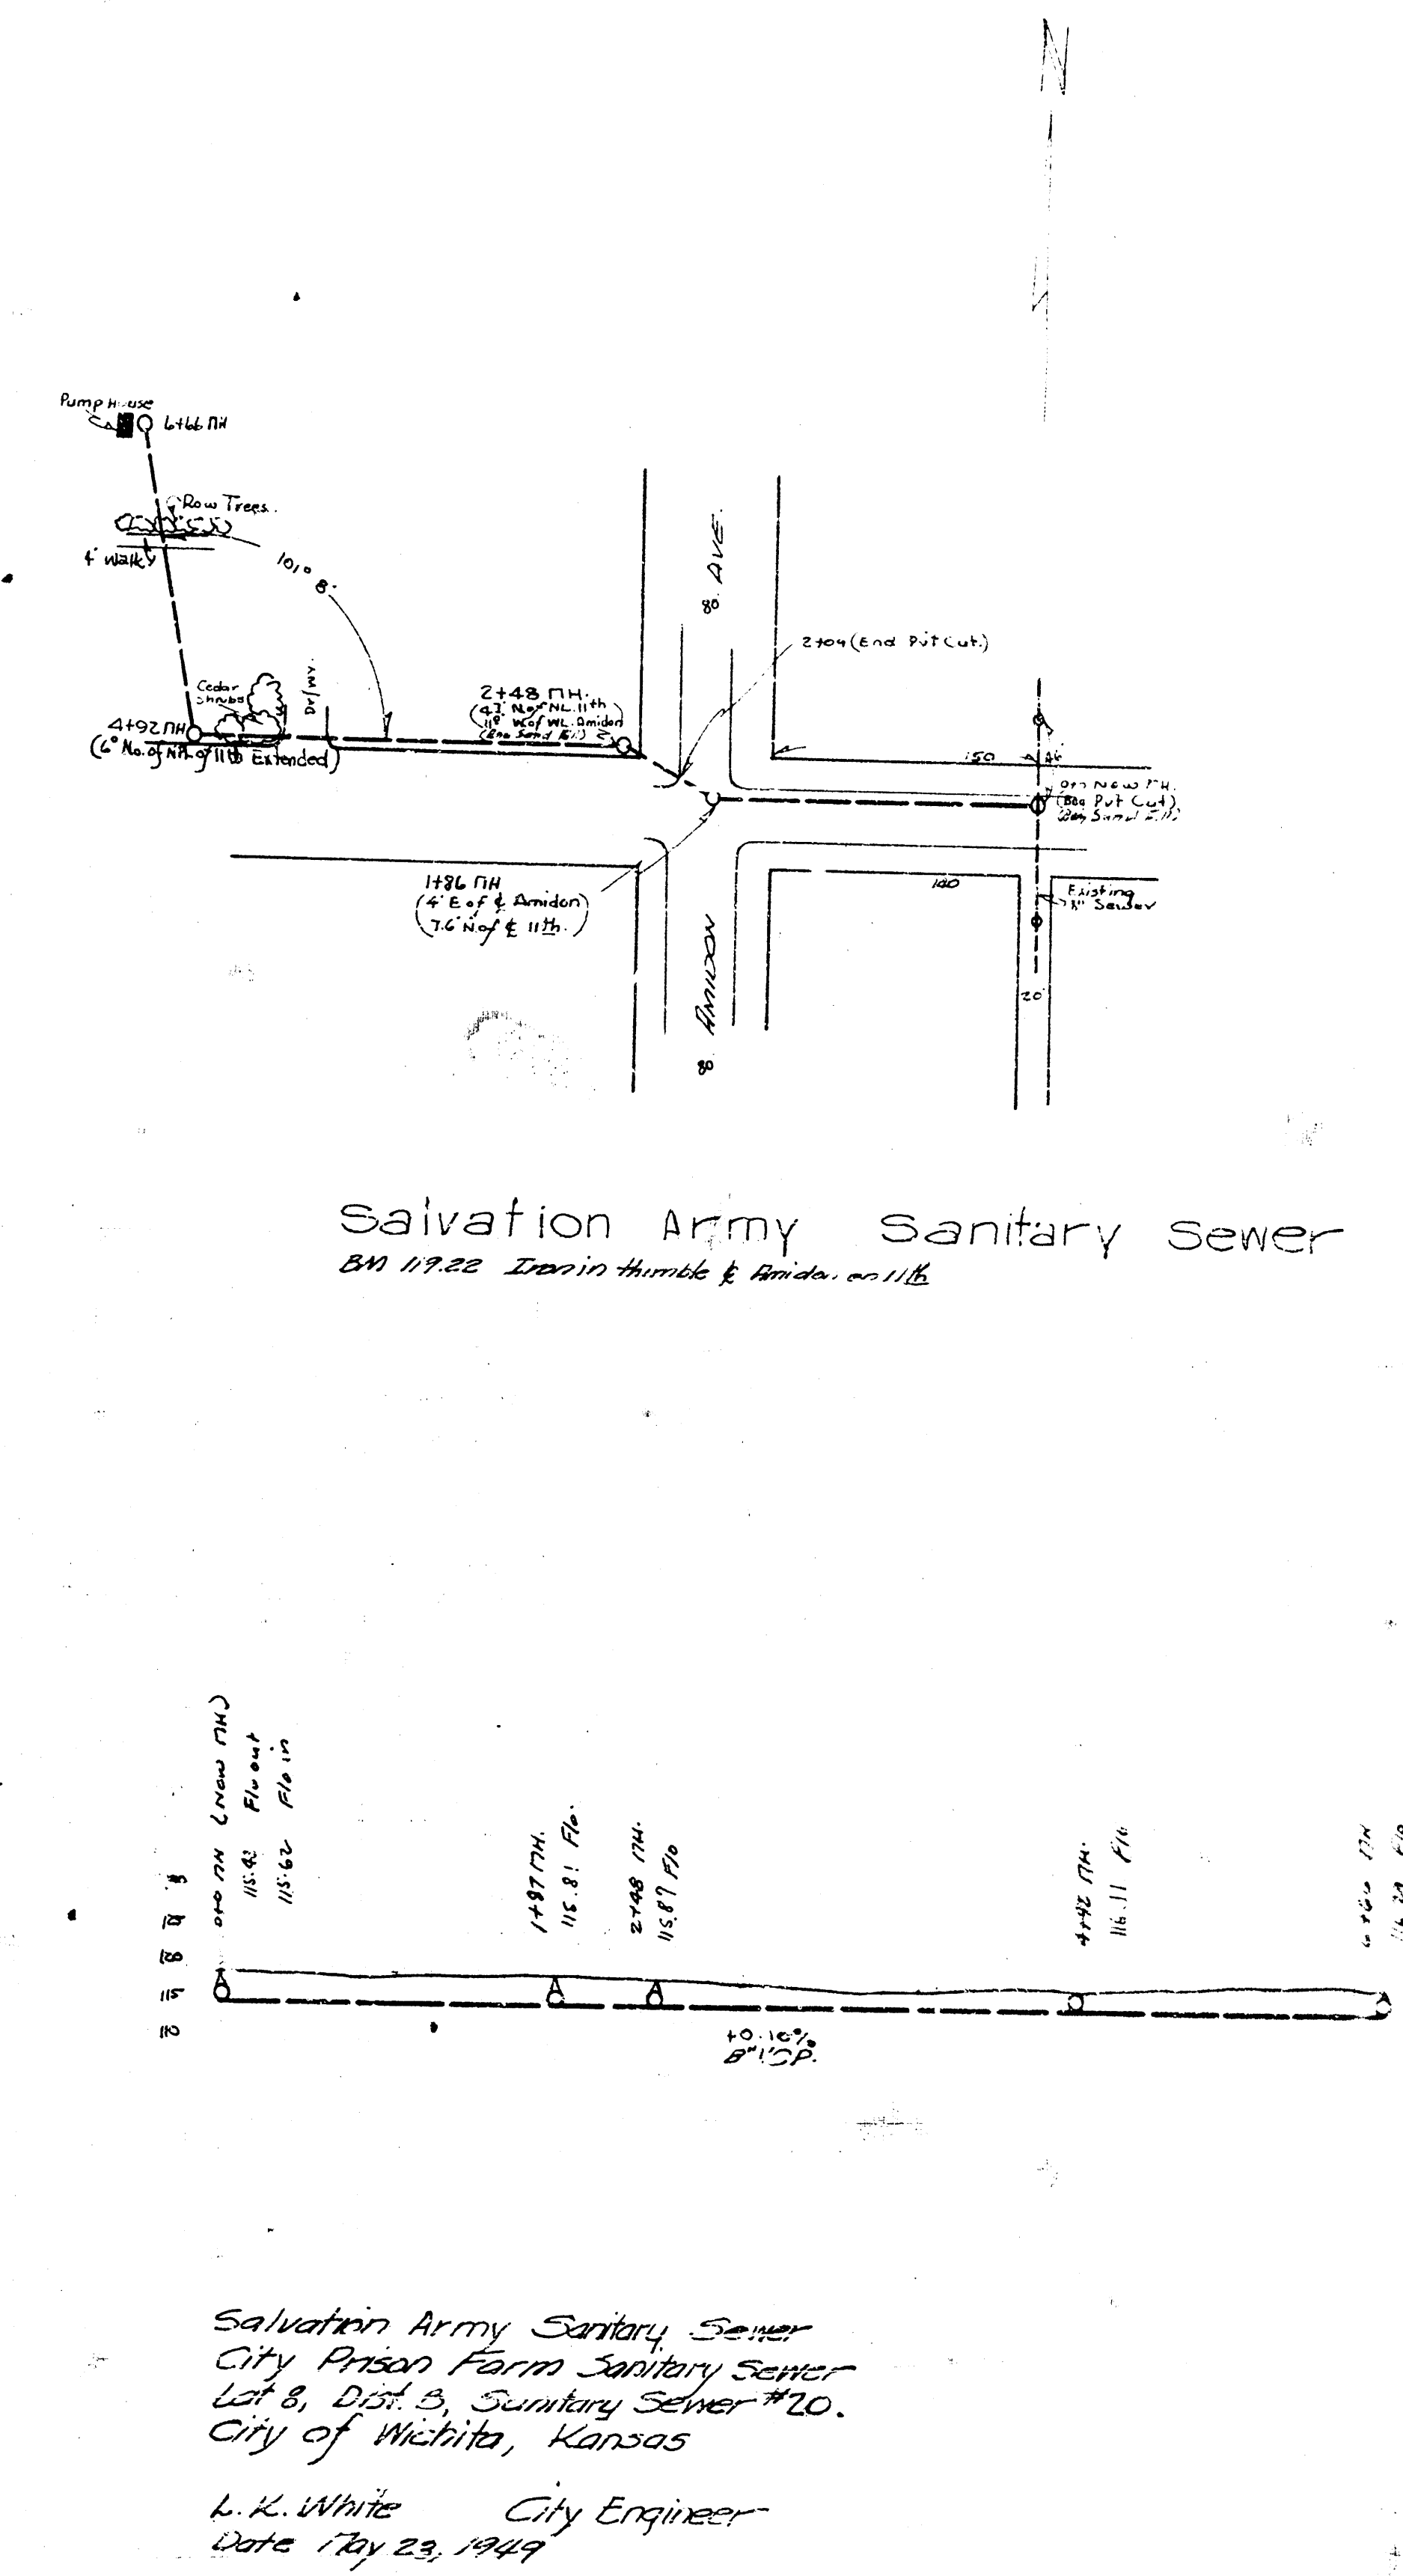
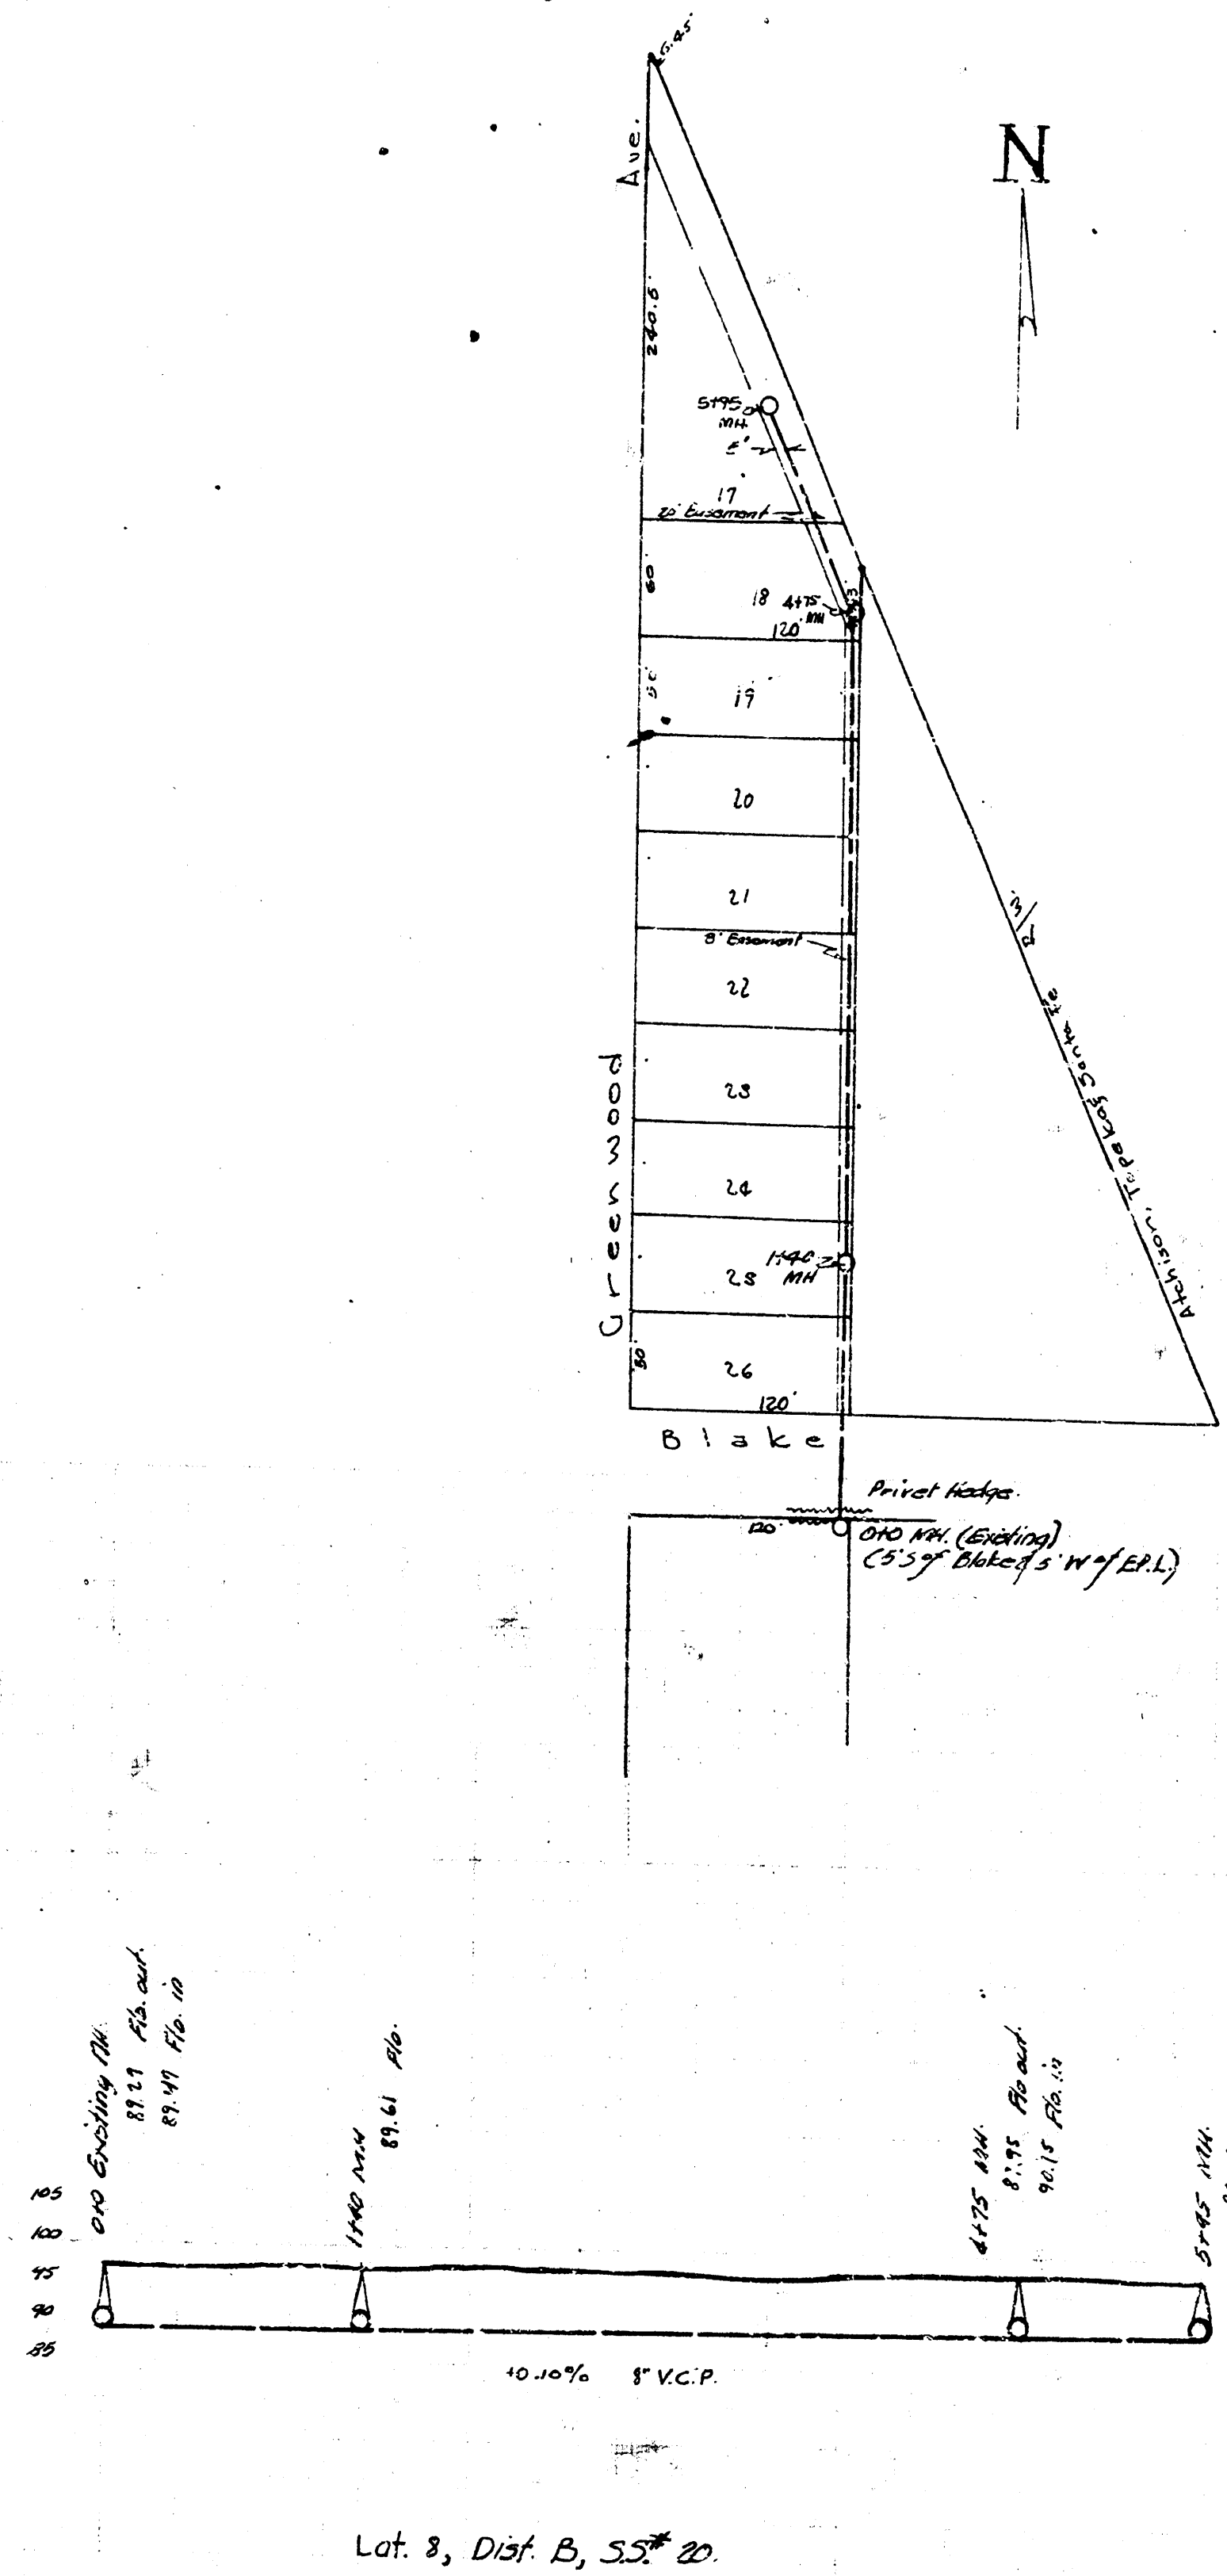


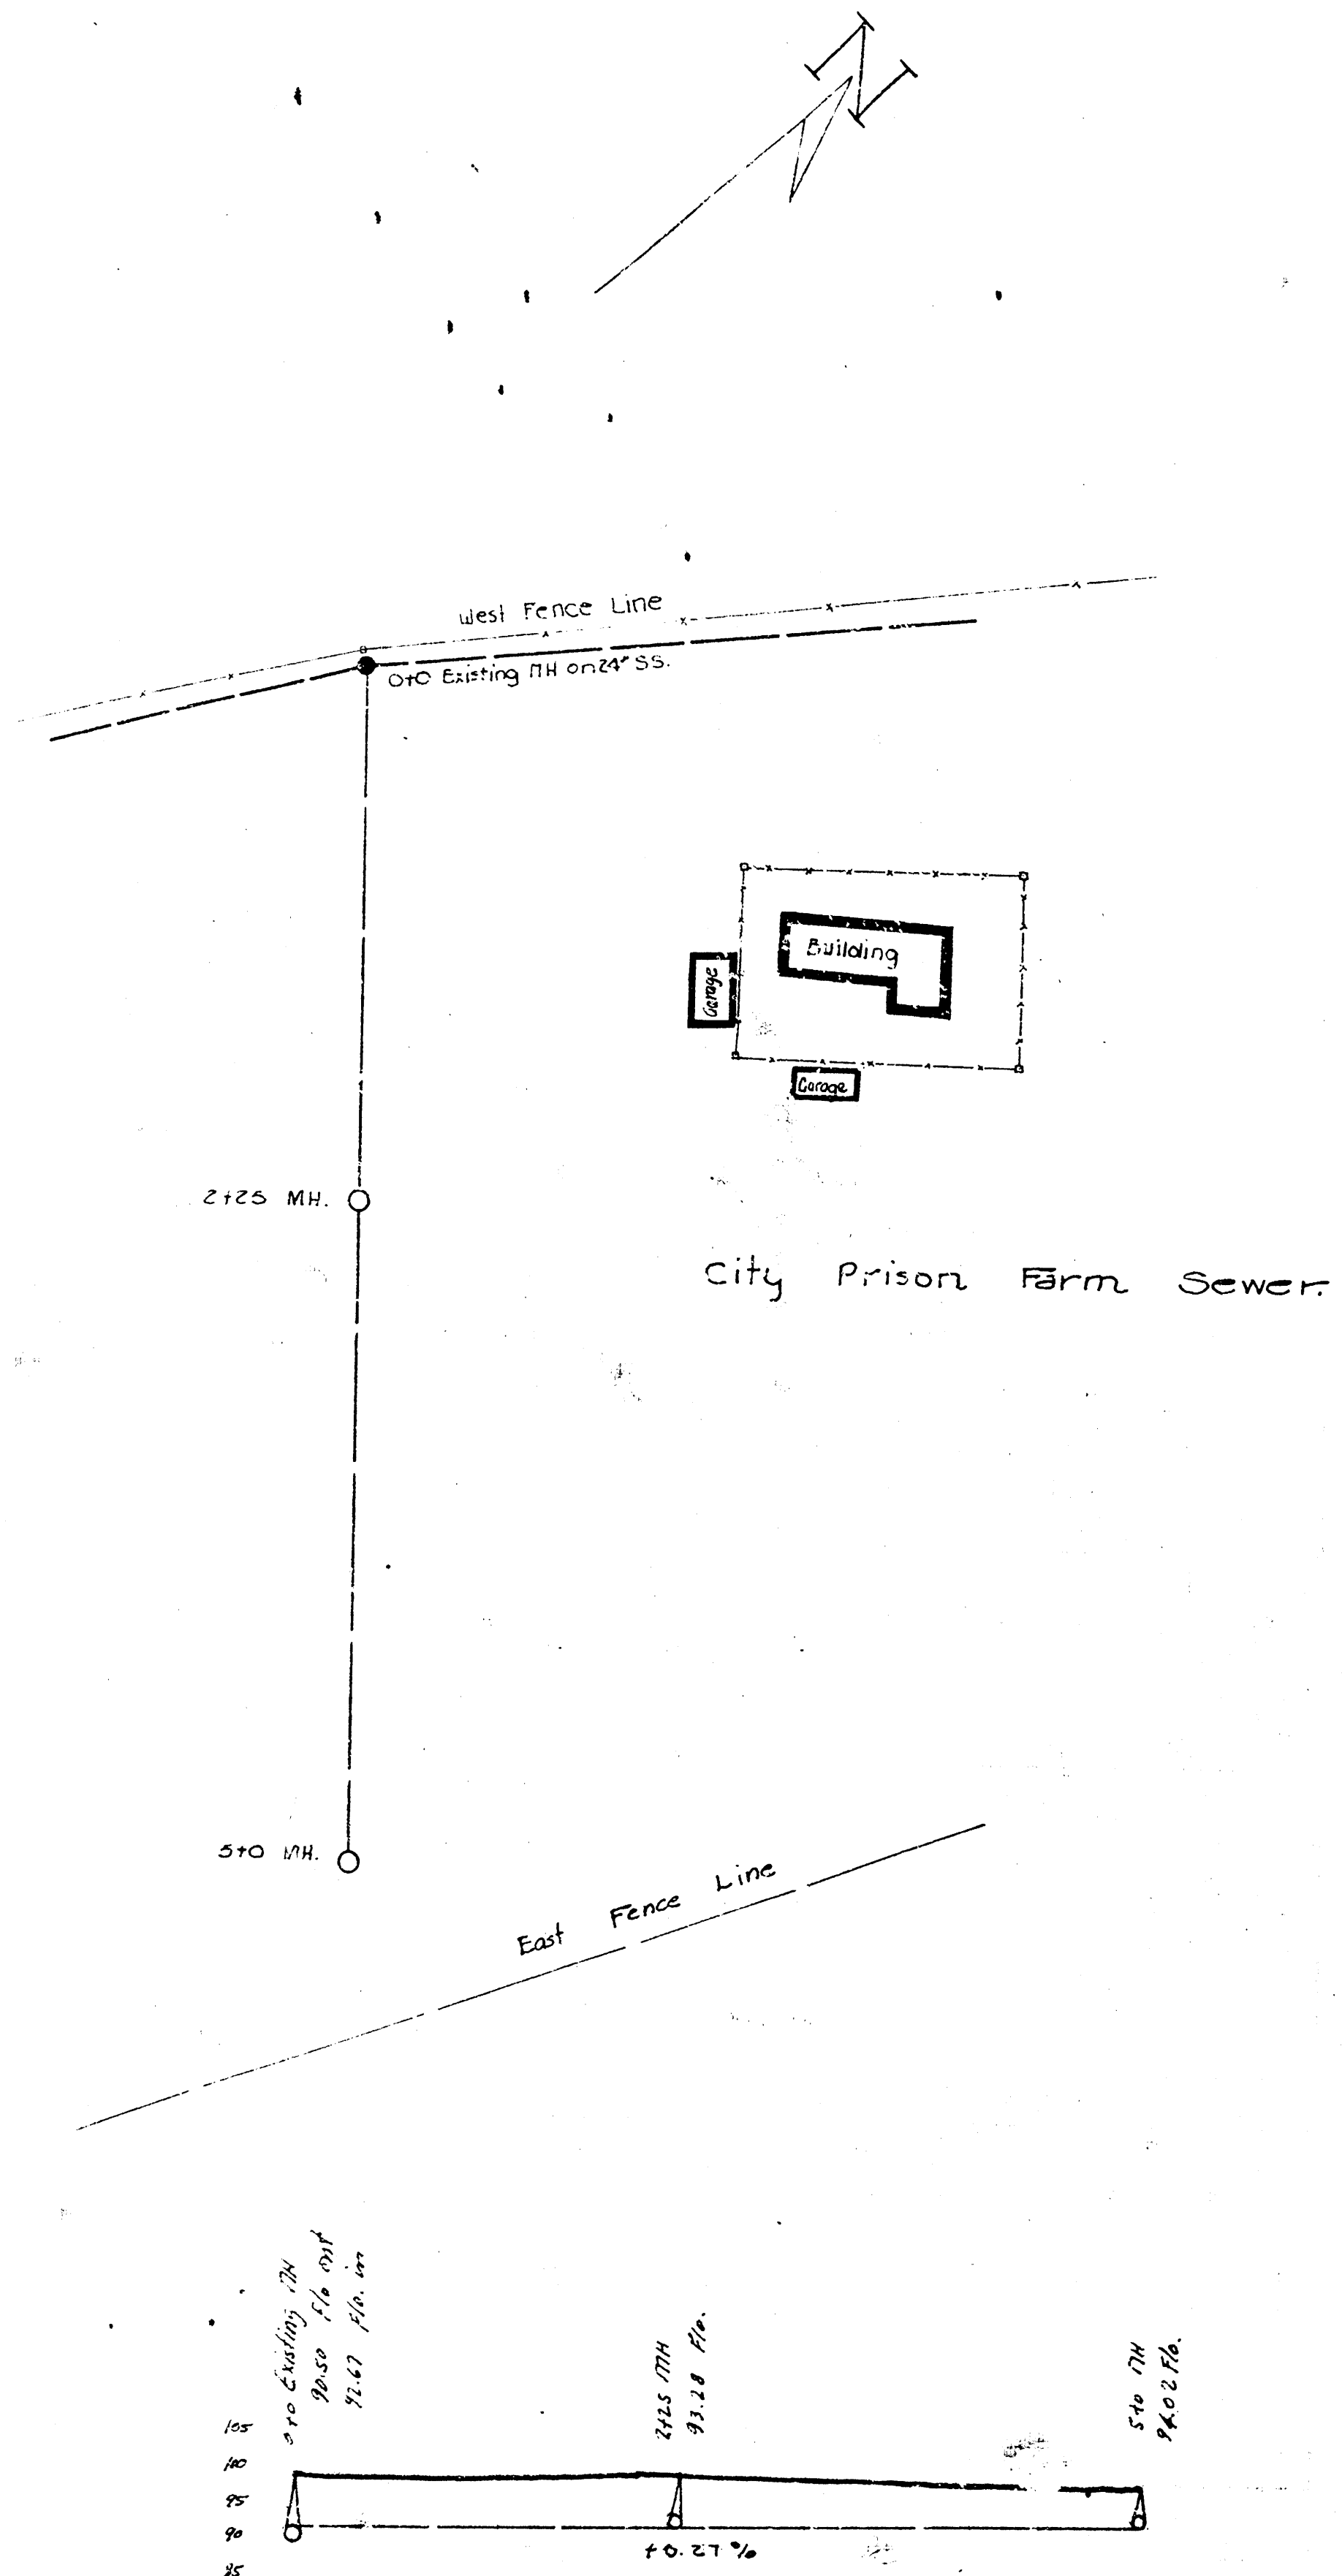

Salvation Army Sanitary Sewer
 City Prison Farm Sanitary Sewer
 Lot 8, Dist. B, Sanitary Sewer #20.
 City of Wichita, Kansas
 L. K. White City Engineer
 Date May 23, 1949