




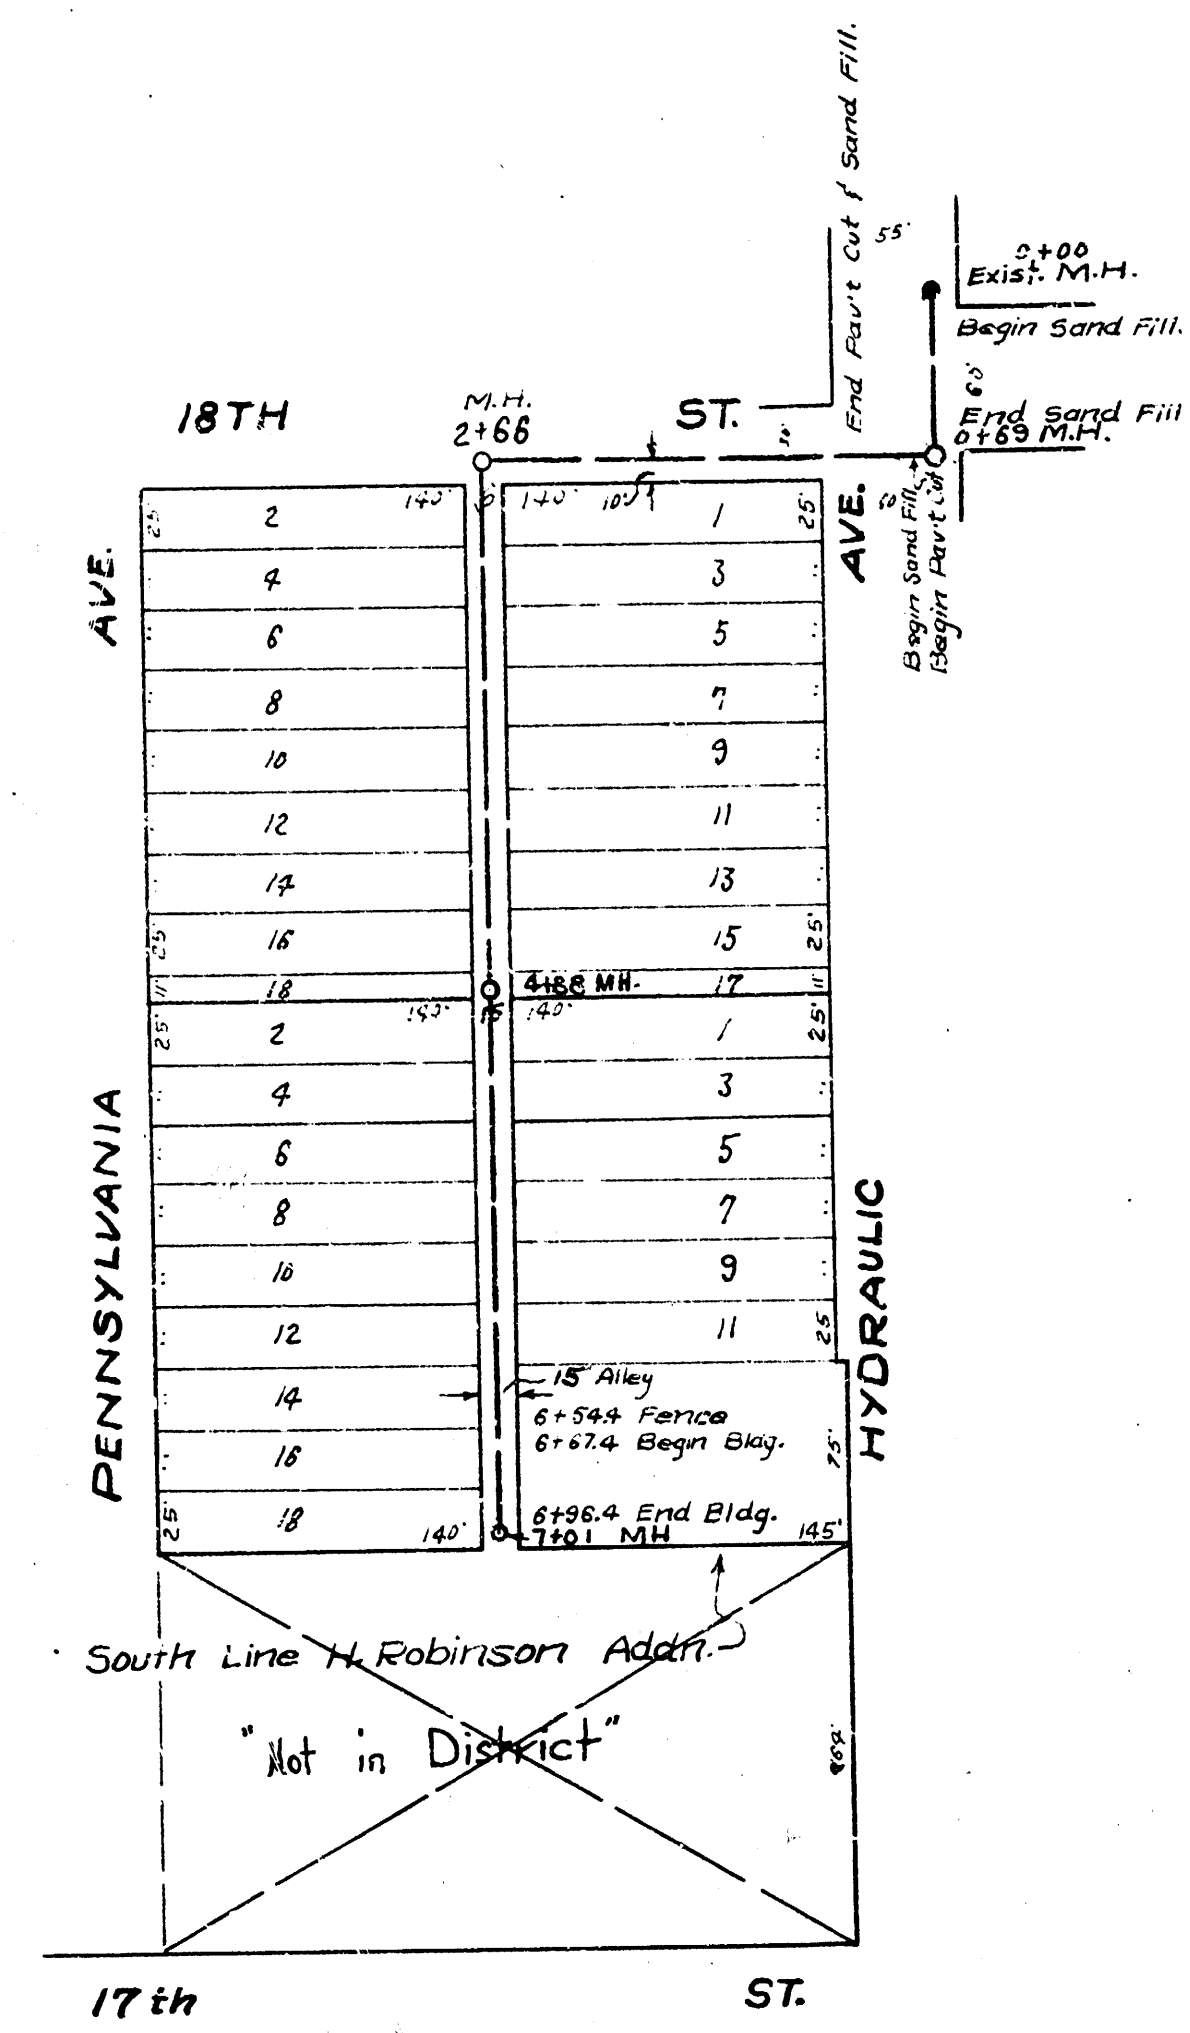


B.M. 11725 Std. N.E. Cor. 17TH & Hydraulic.

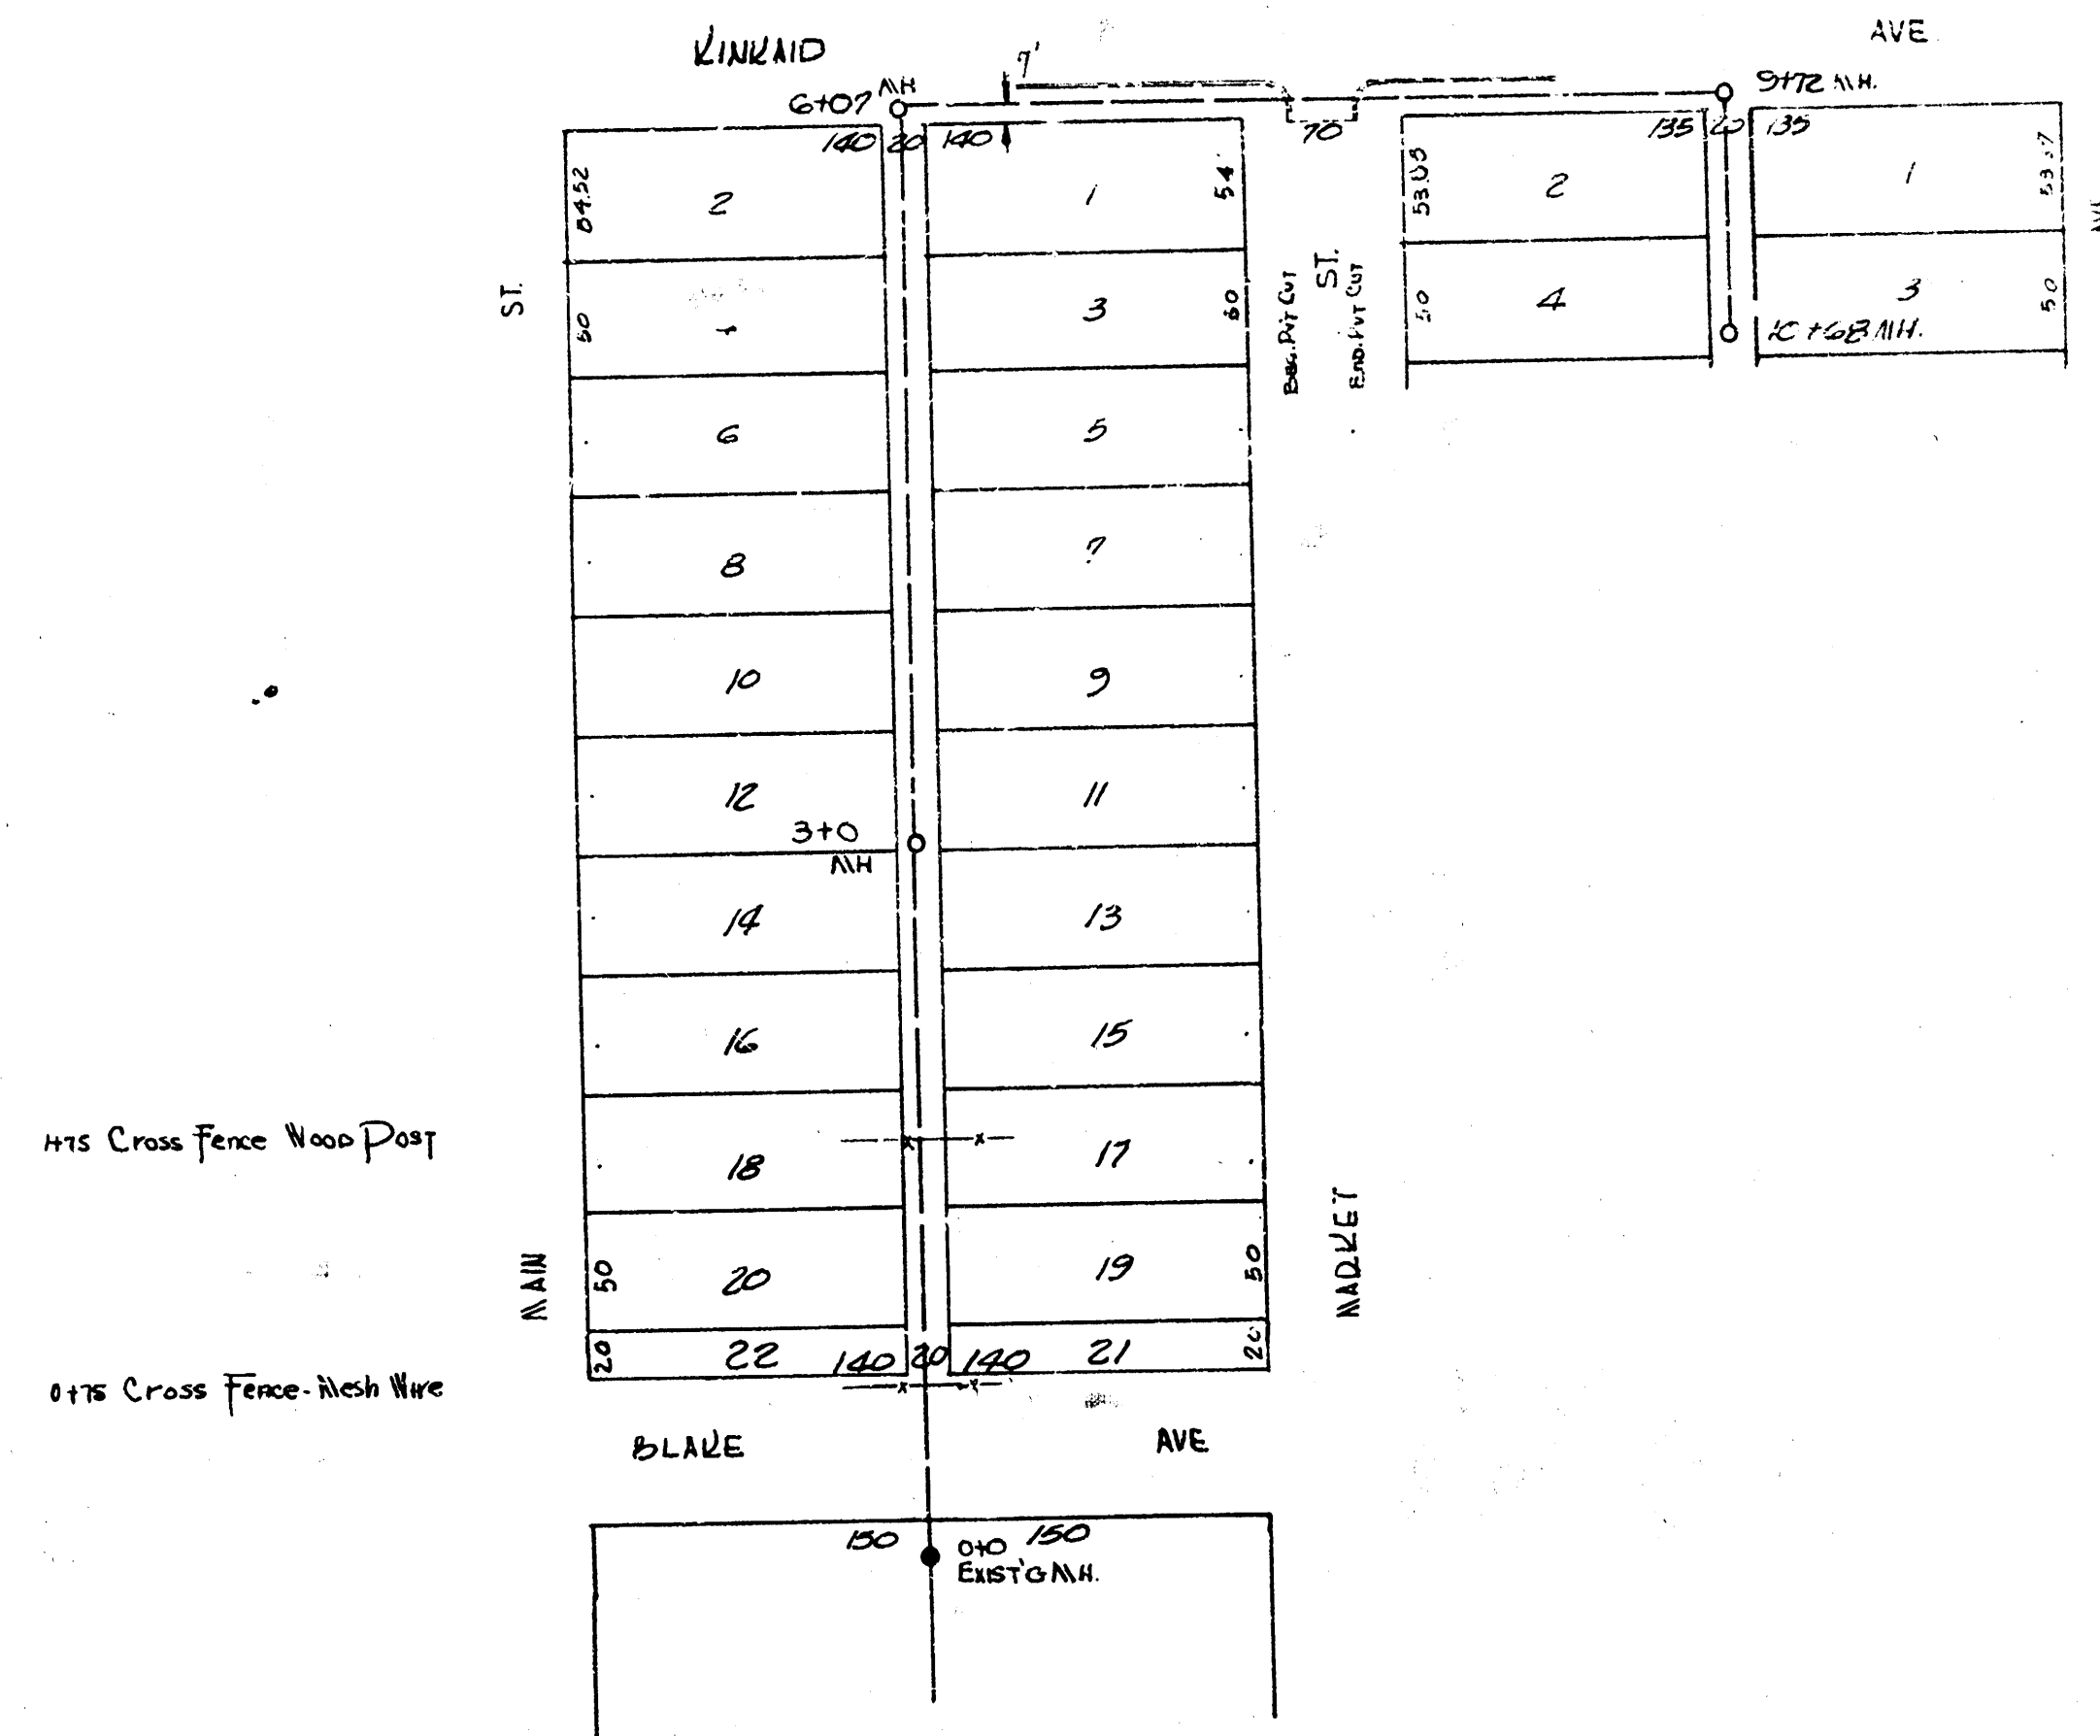

B.M. 1060 Iron N.E. Corner N.W. S.D.N. 9629

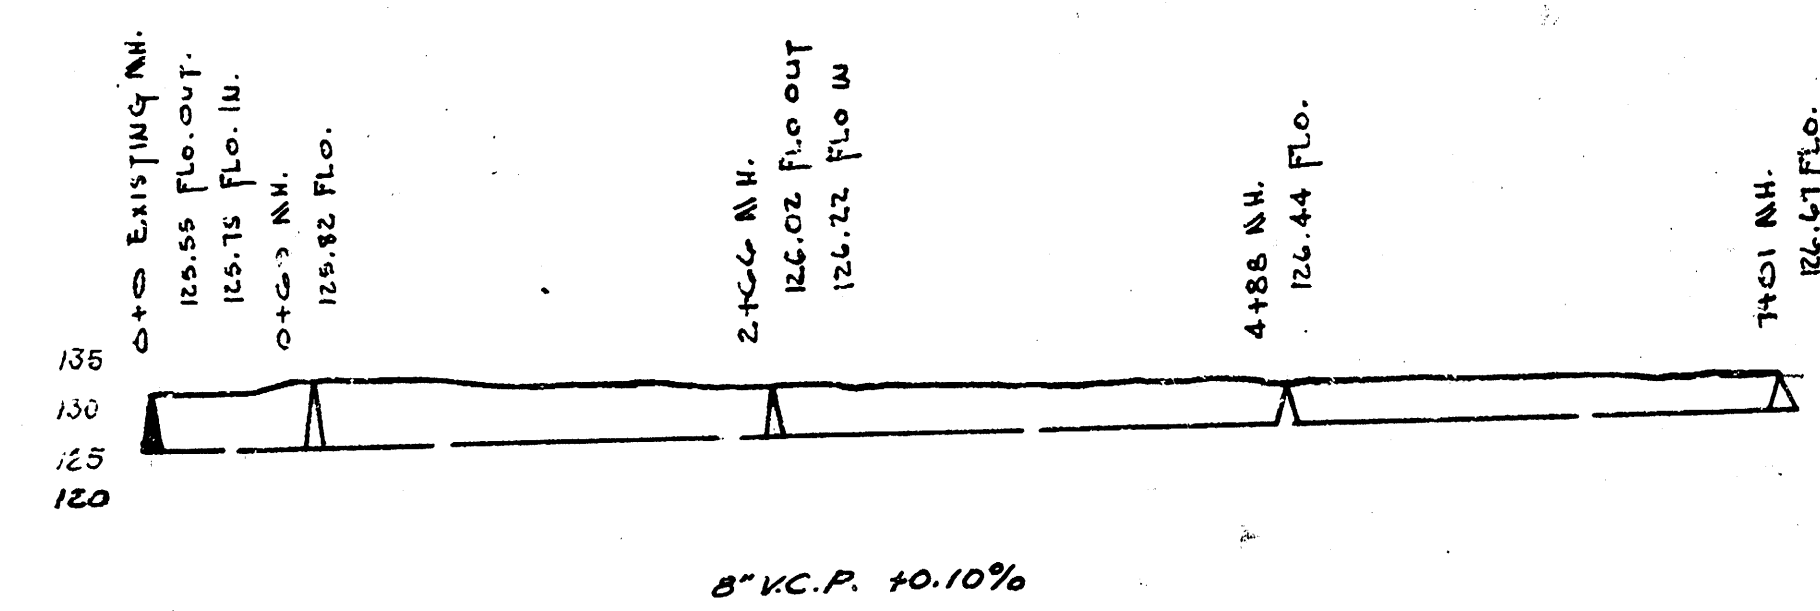

LAT. 16, DIST. T, SS*12

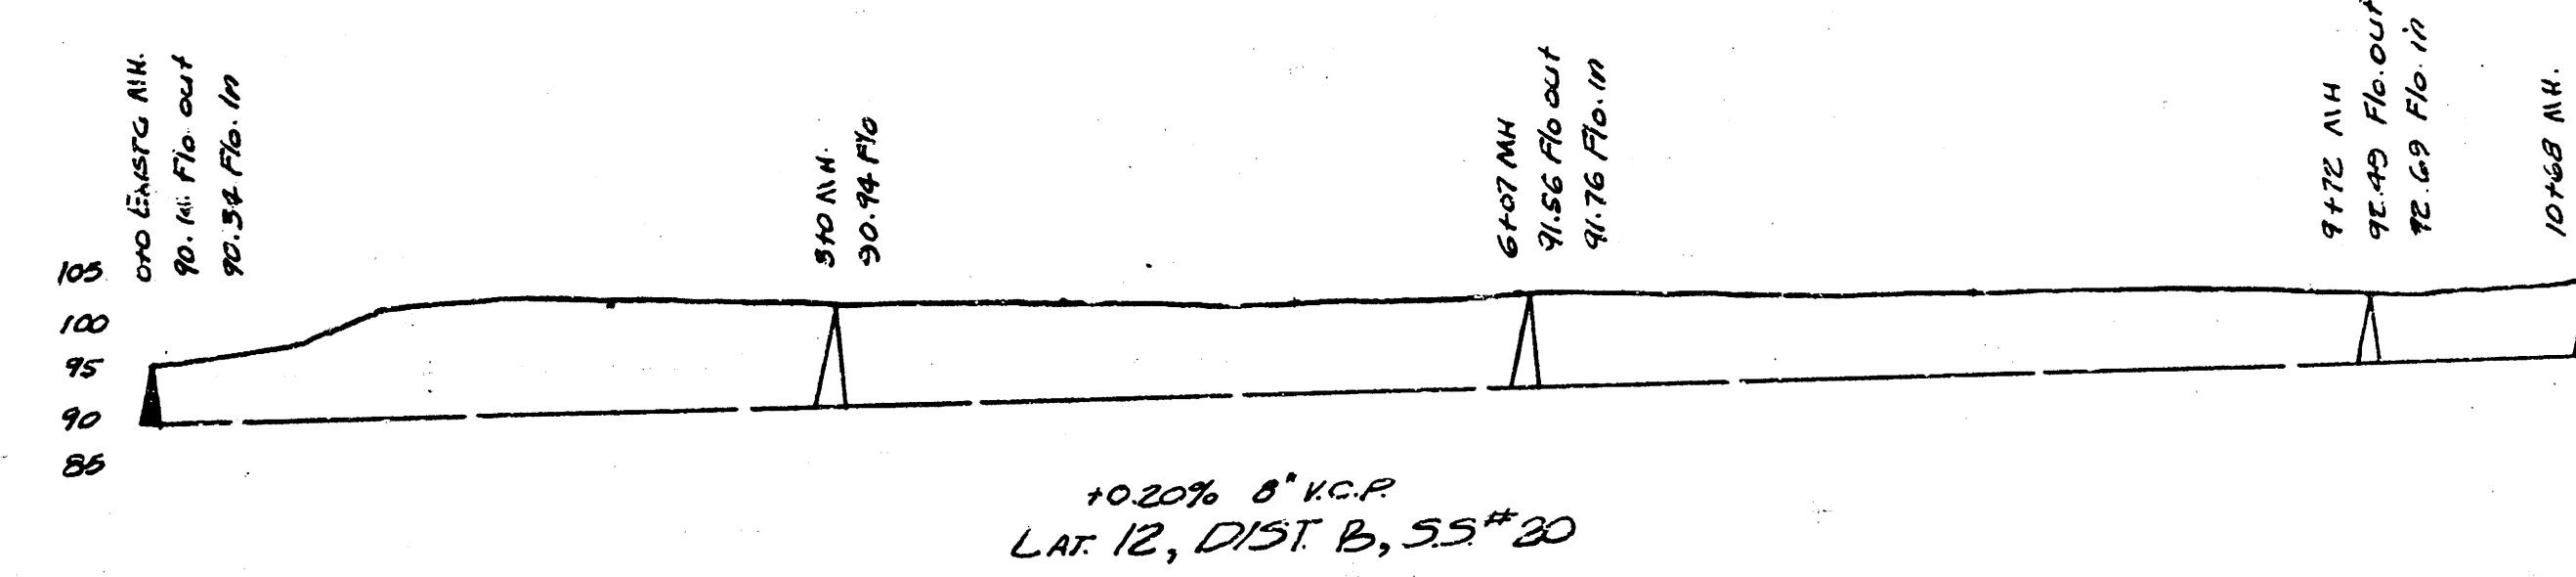

LAT. 12, DIST. B, SS*20
LAT. K, DIST. T, SS*12
CITY OF WICHITA, KANSAS
L.K. WHITE CITY ENGINEER
1940