

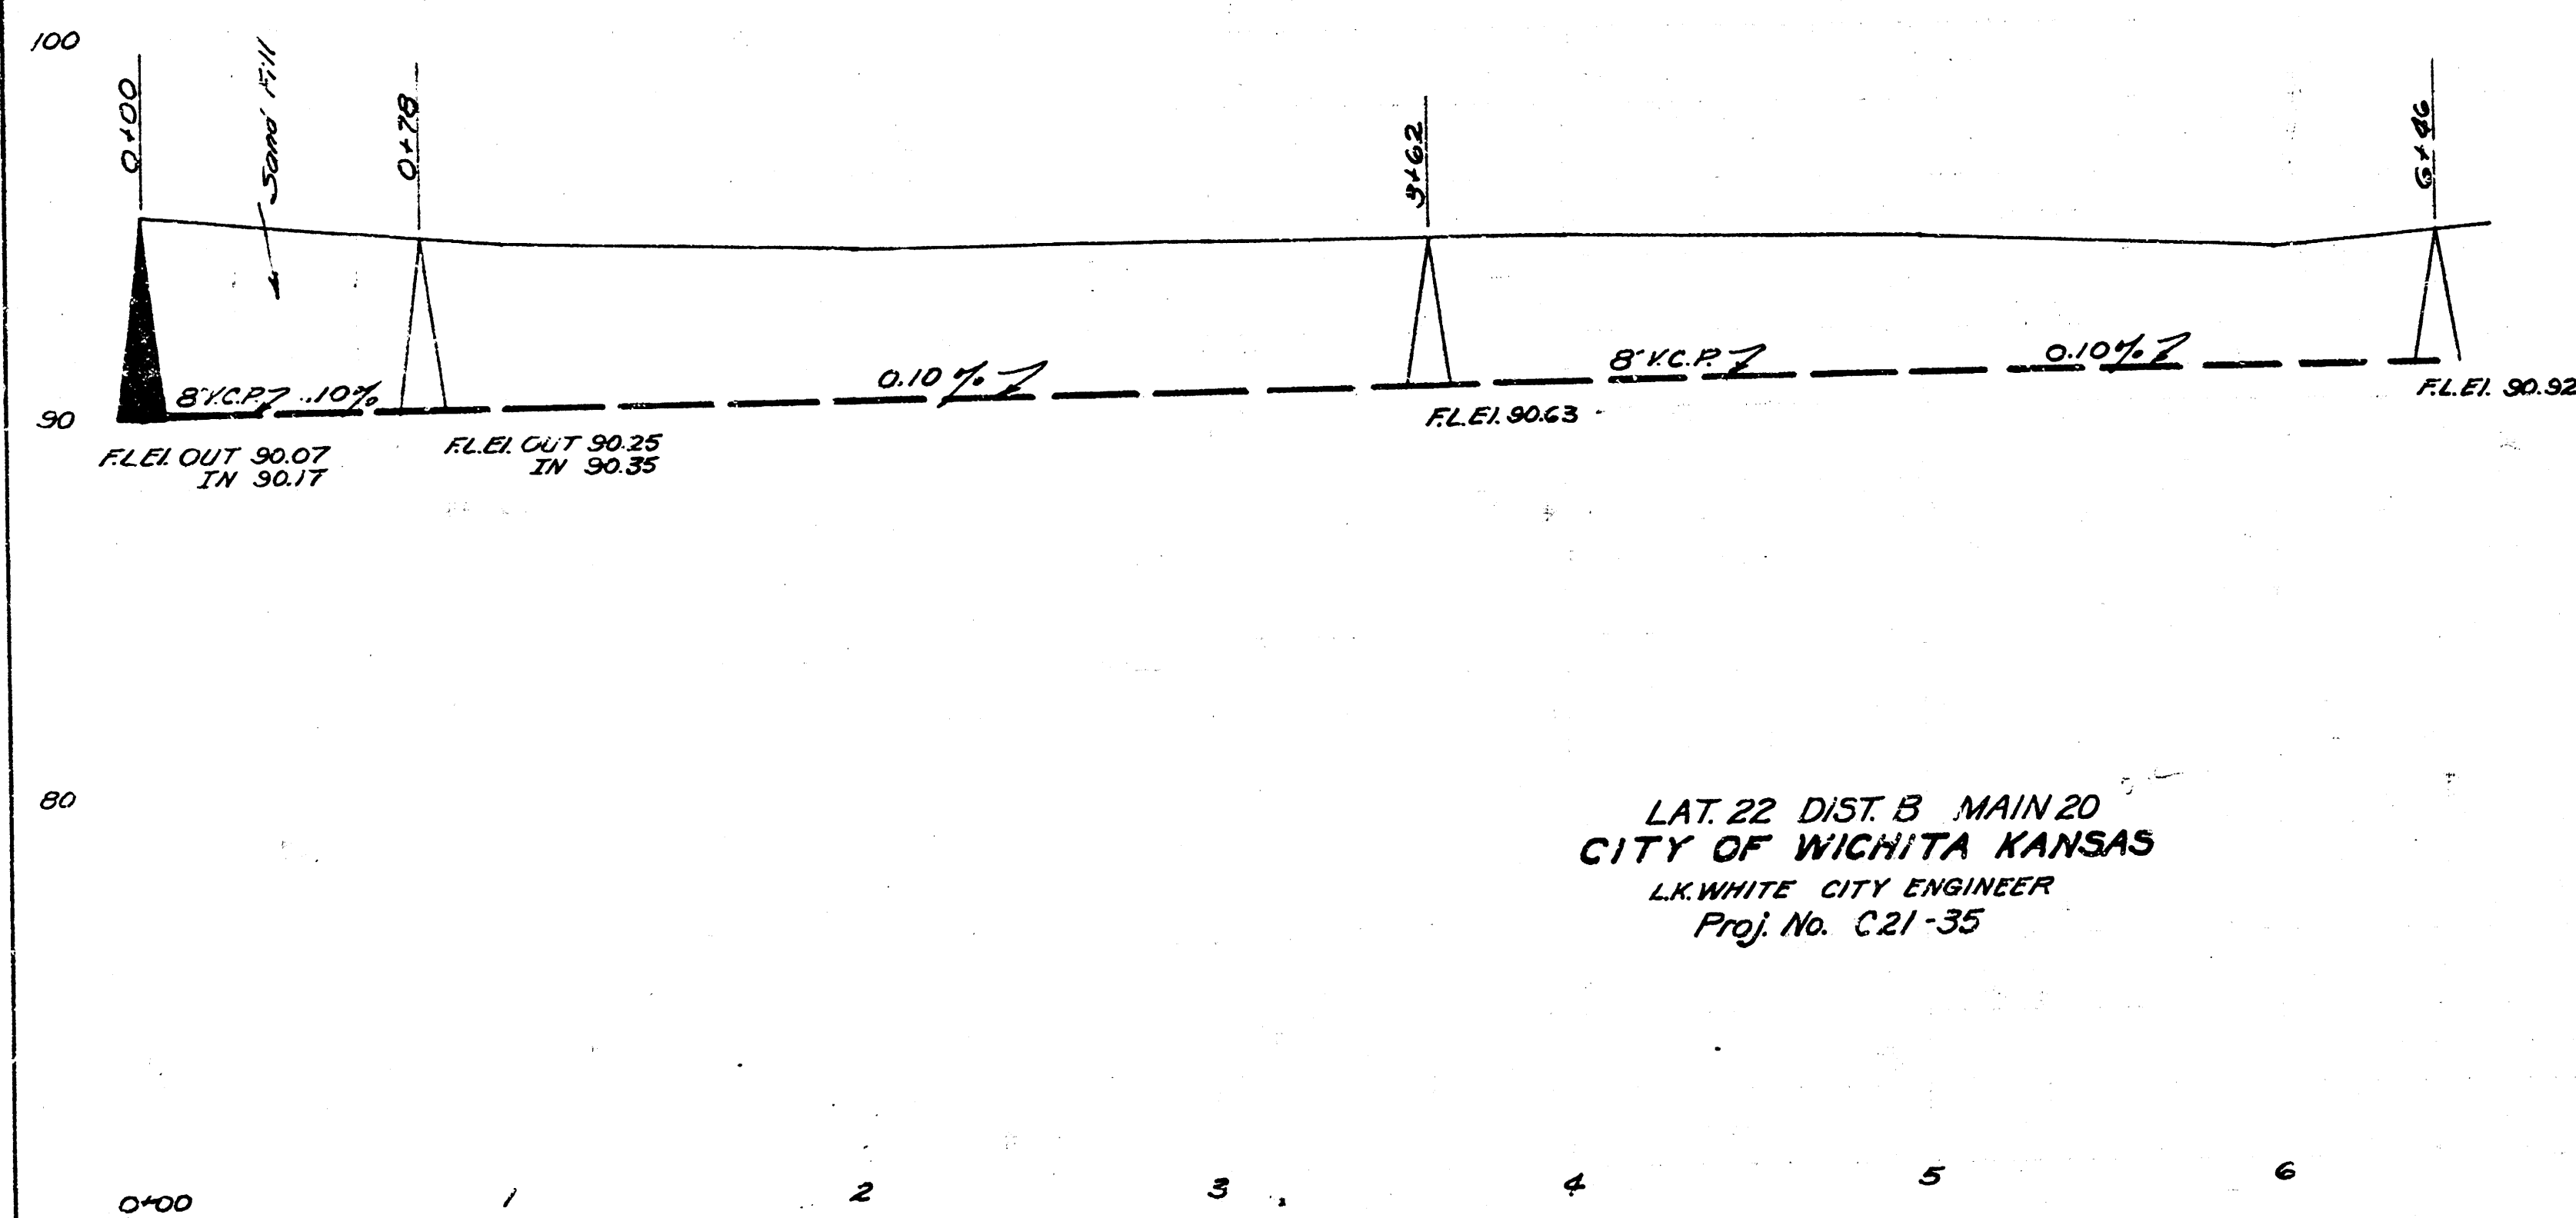


Date 8-28-51
 Drawn by J.L.H.
 Checked by N.H. Boer
 Note Book No. 56

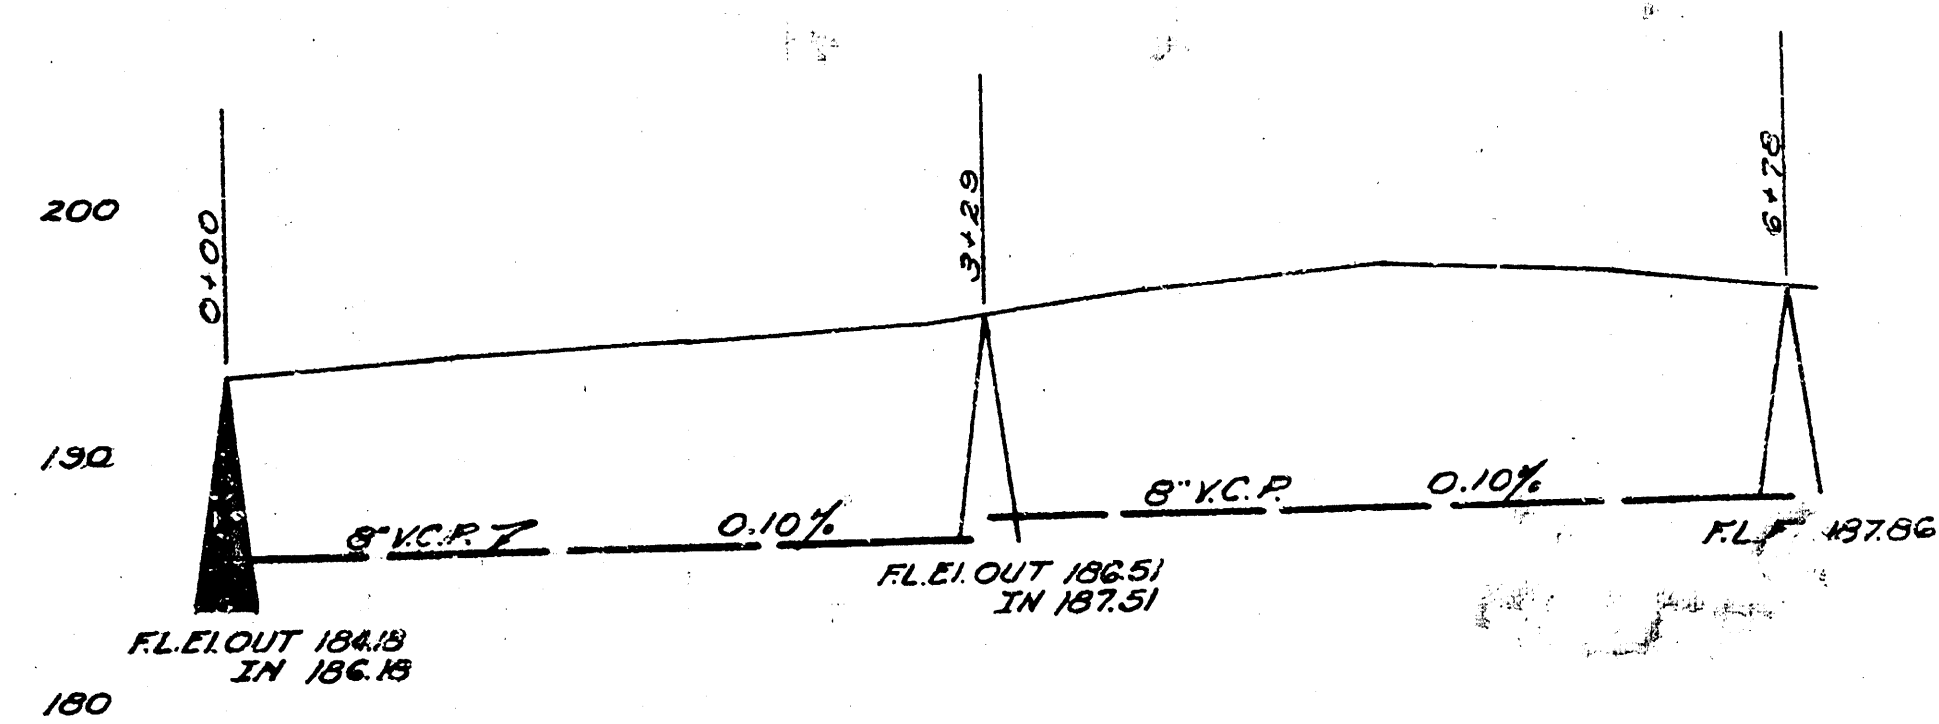

LAT. 22 DIST. B. MAIN 20
 CITY OF WICHITA KANSAS
 L.K. WHITE CITY ENGINEER
 Proj. No. C21-35

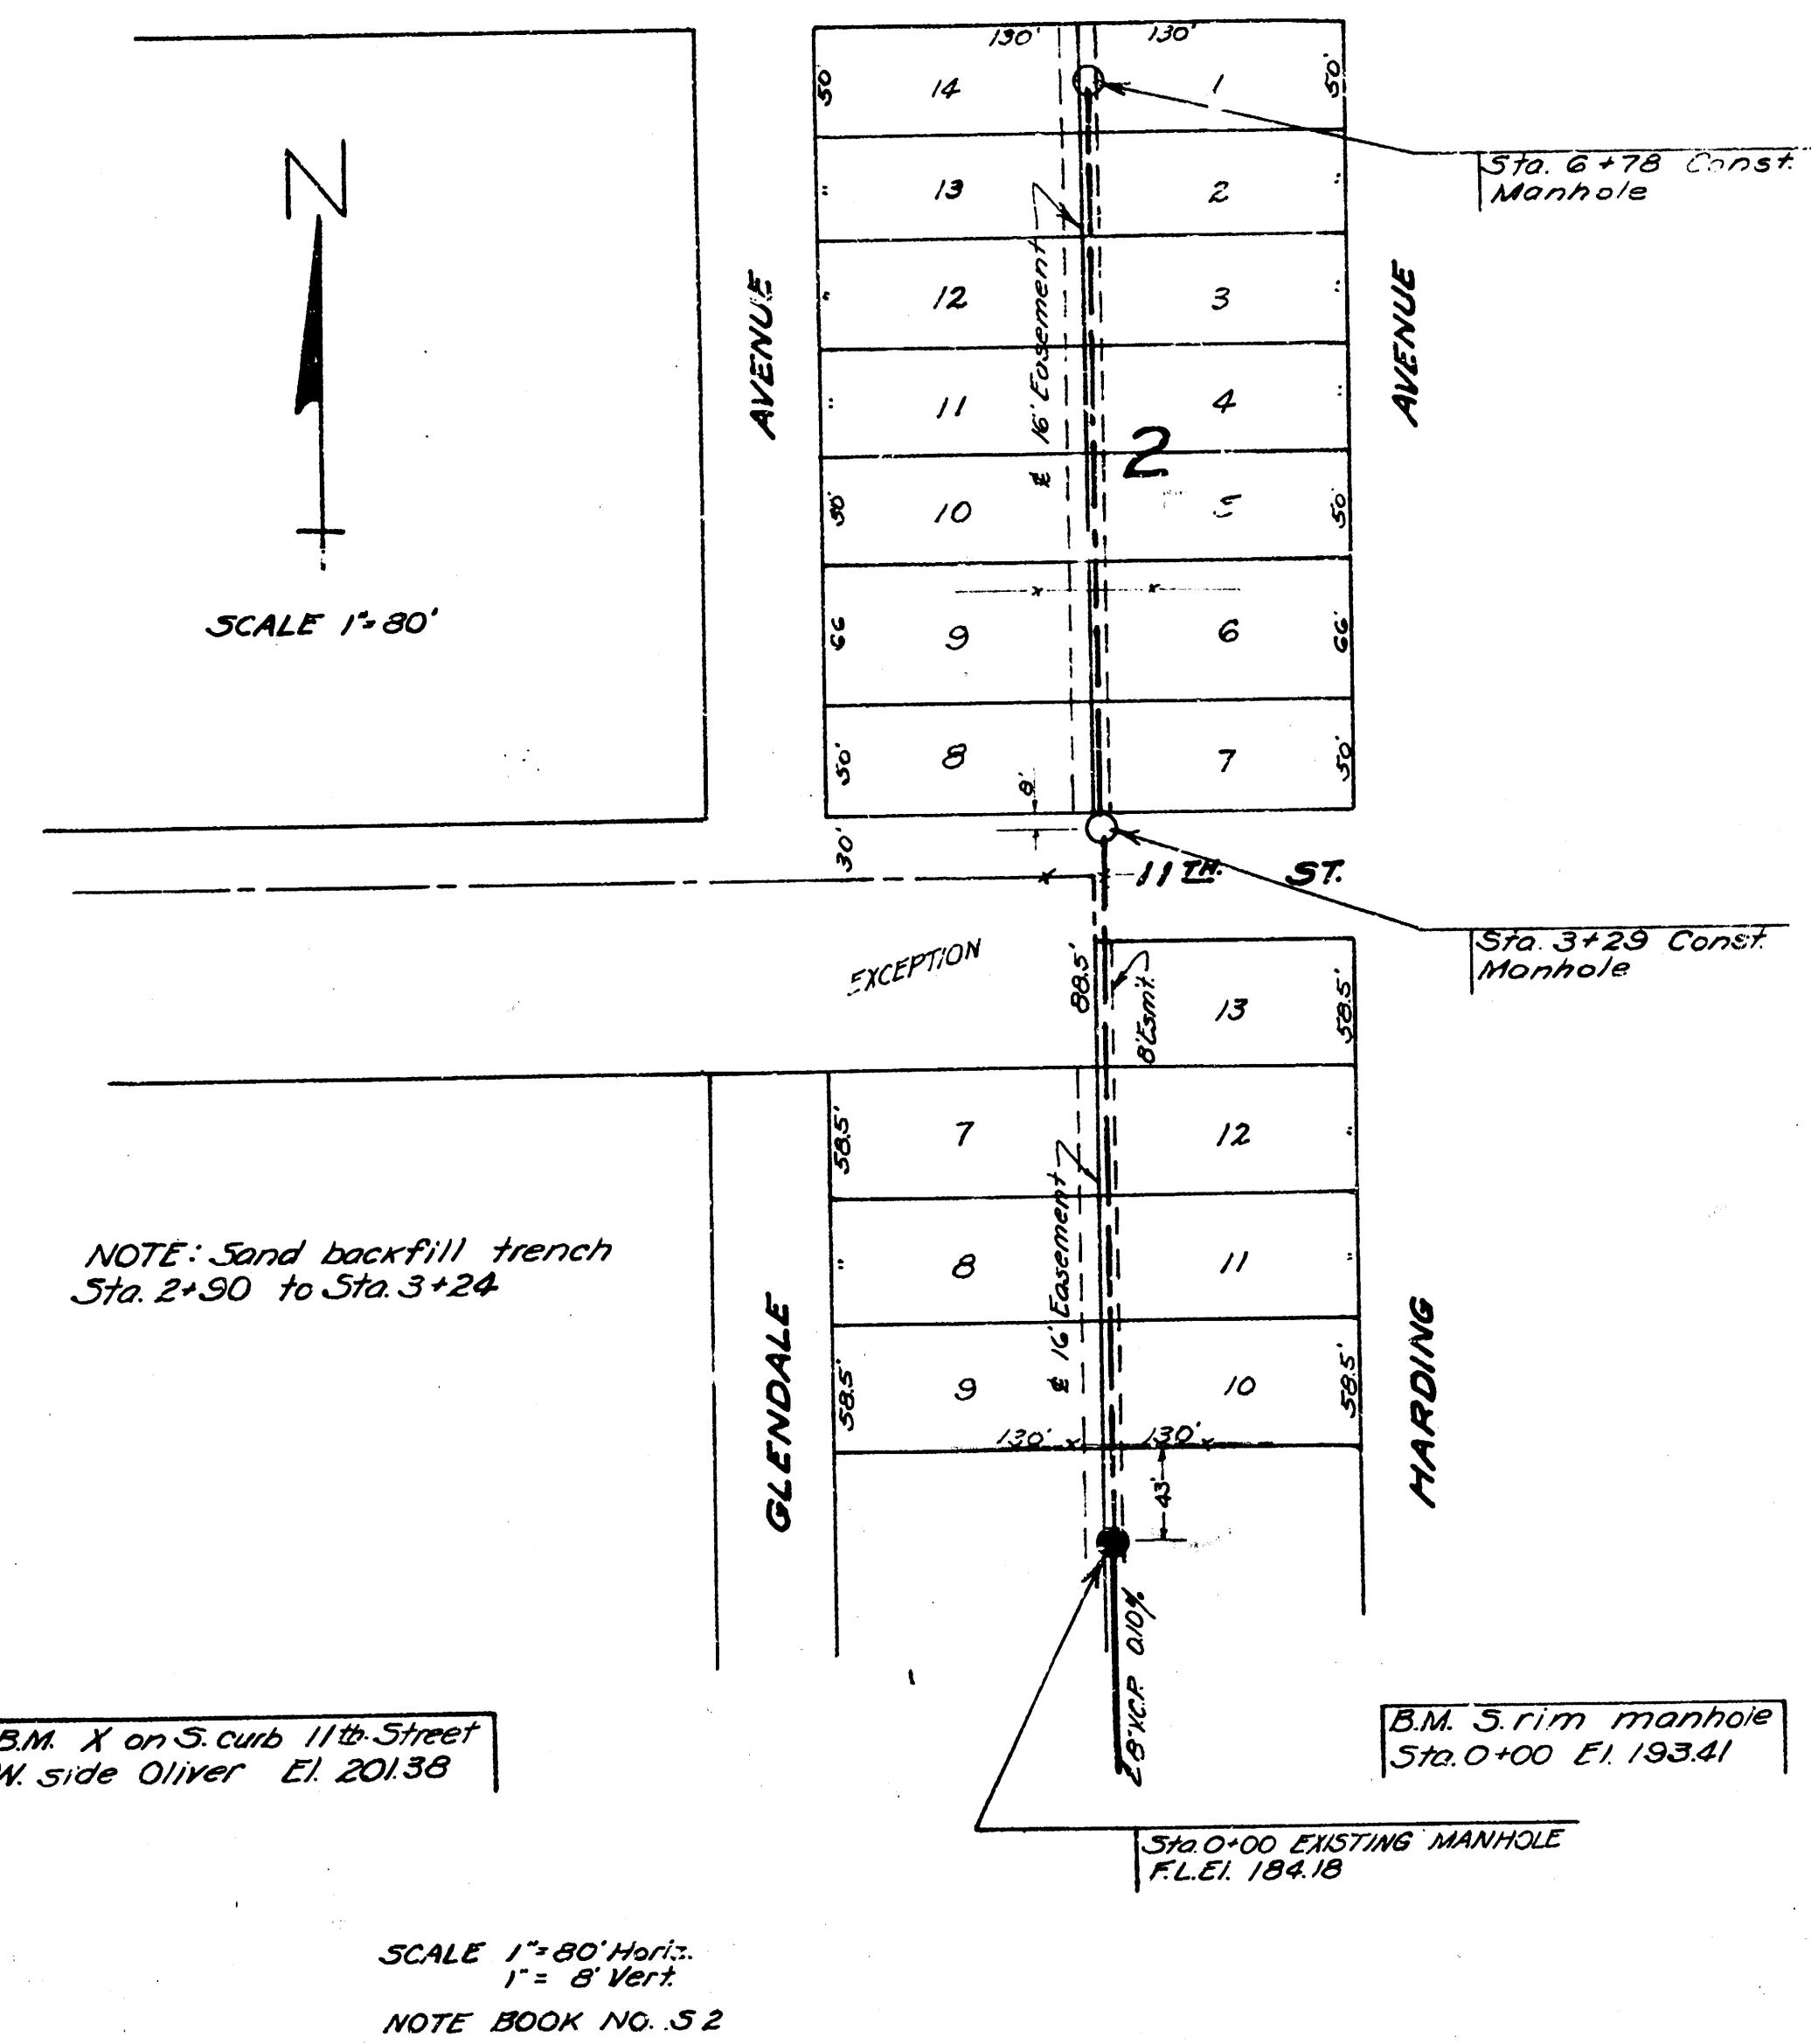

LAT. 58 DCS. #12
 CITY OF WICHITA KANSAS
 L.K. WHITE CITY ENGINEER
 Proj. No. C21-45
 8-28-51