



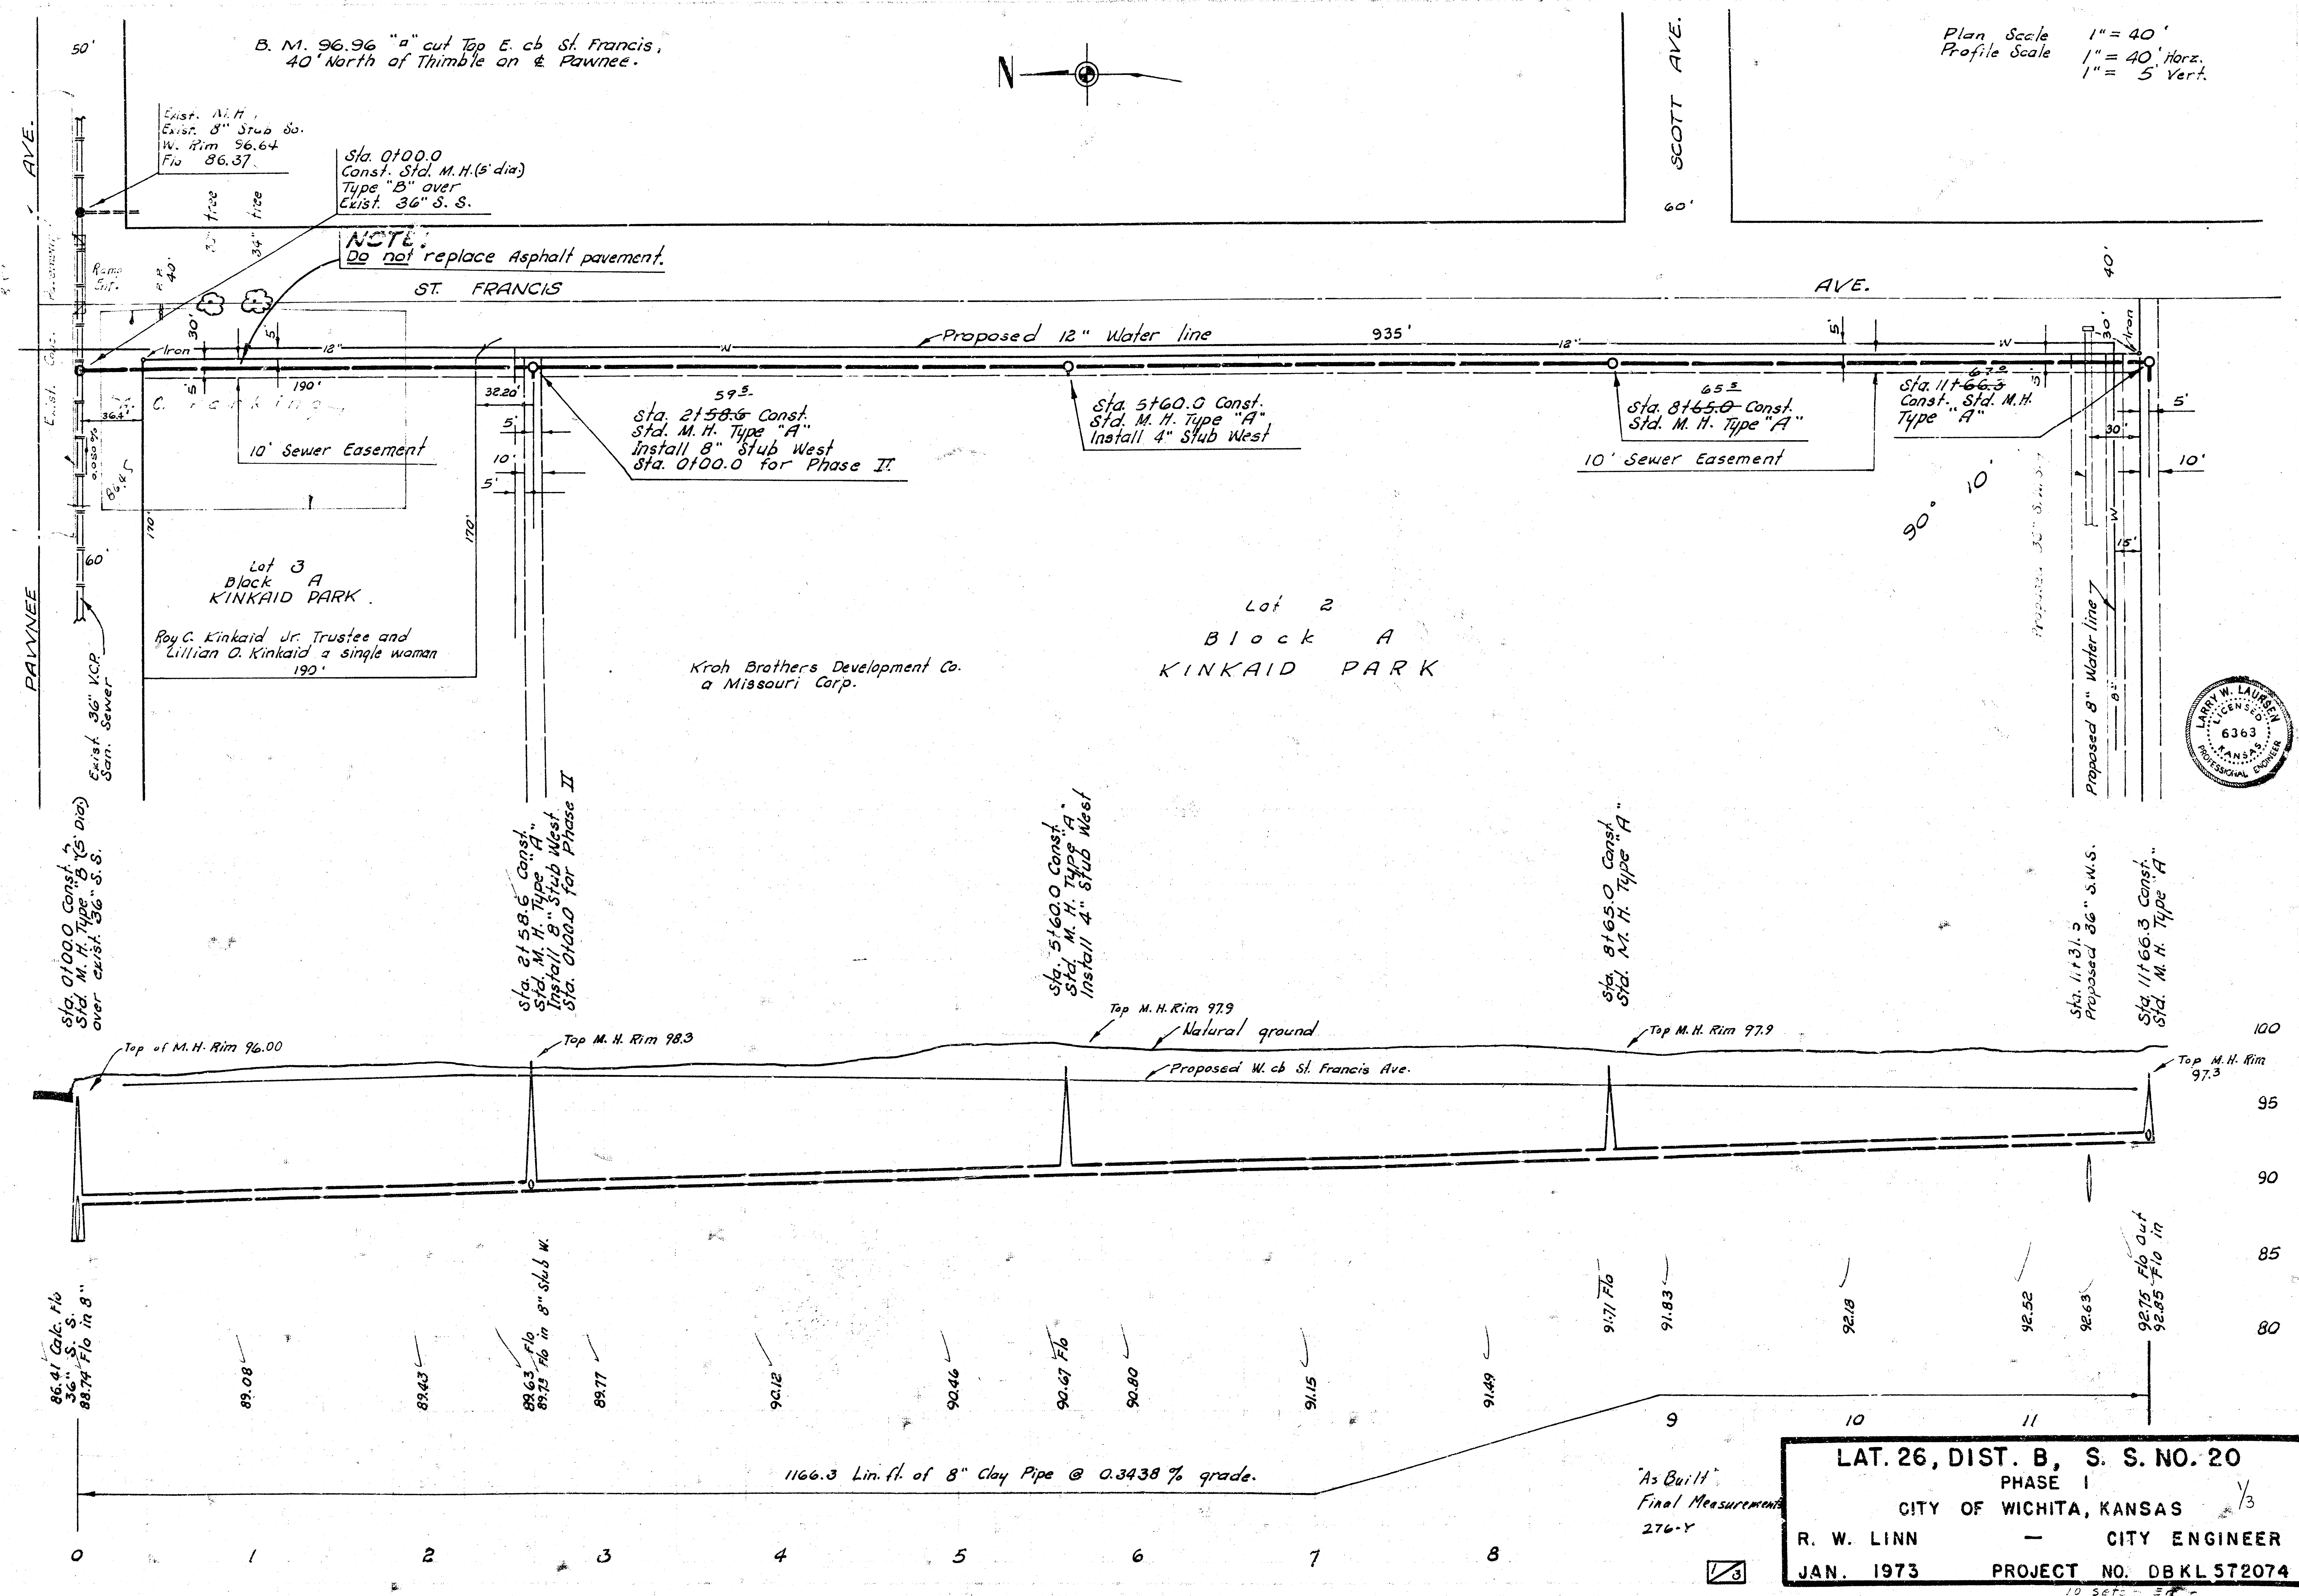


LAT. 26, DIST. B, S. S. NO. 20
PHASE I
CITY OF WICHITA, KANSAS
R. W. LINN — CITY ENGINEER
JAN. 1973 PROJECT NO. DBKL 572074

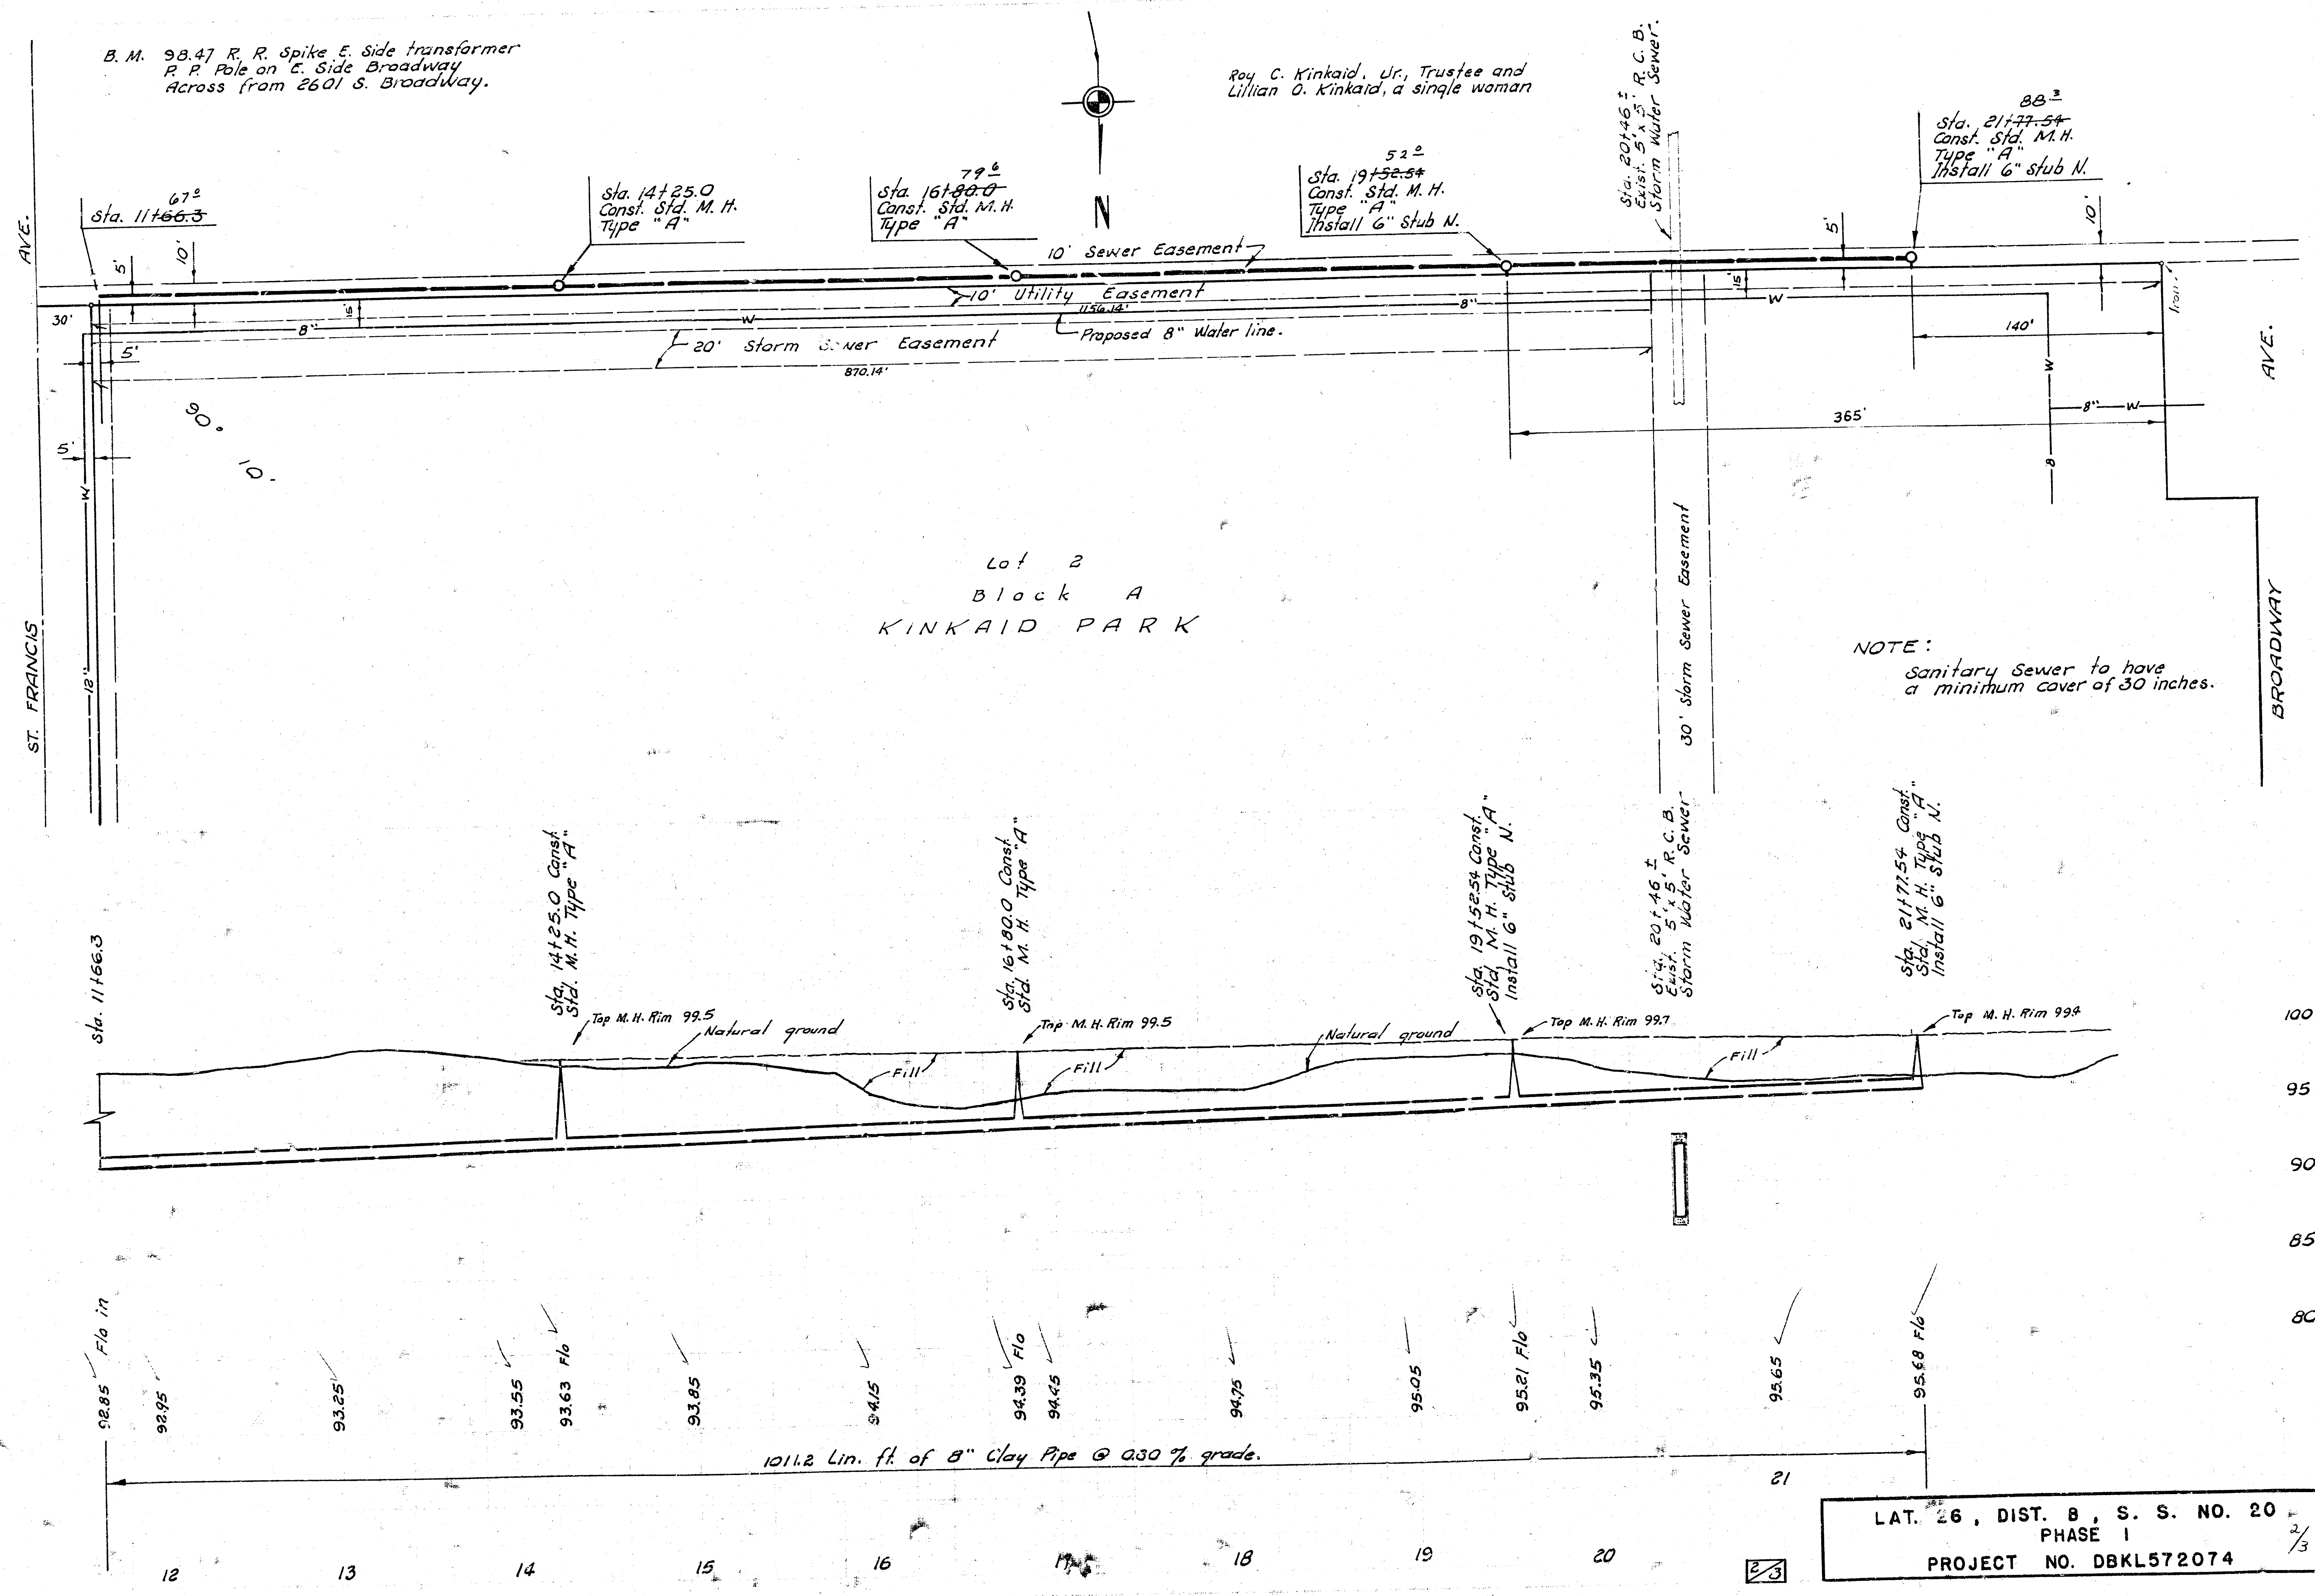

J. F. G.
J. R. W.

205

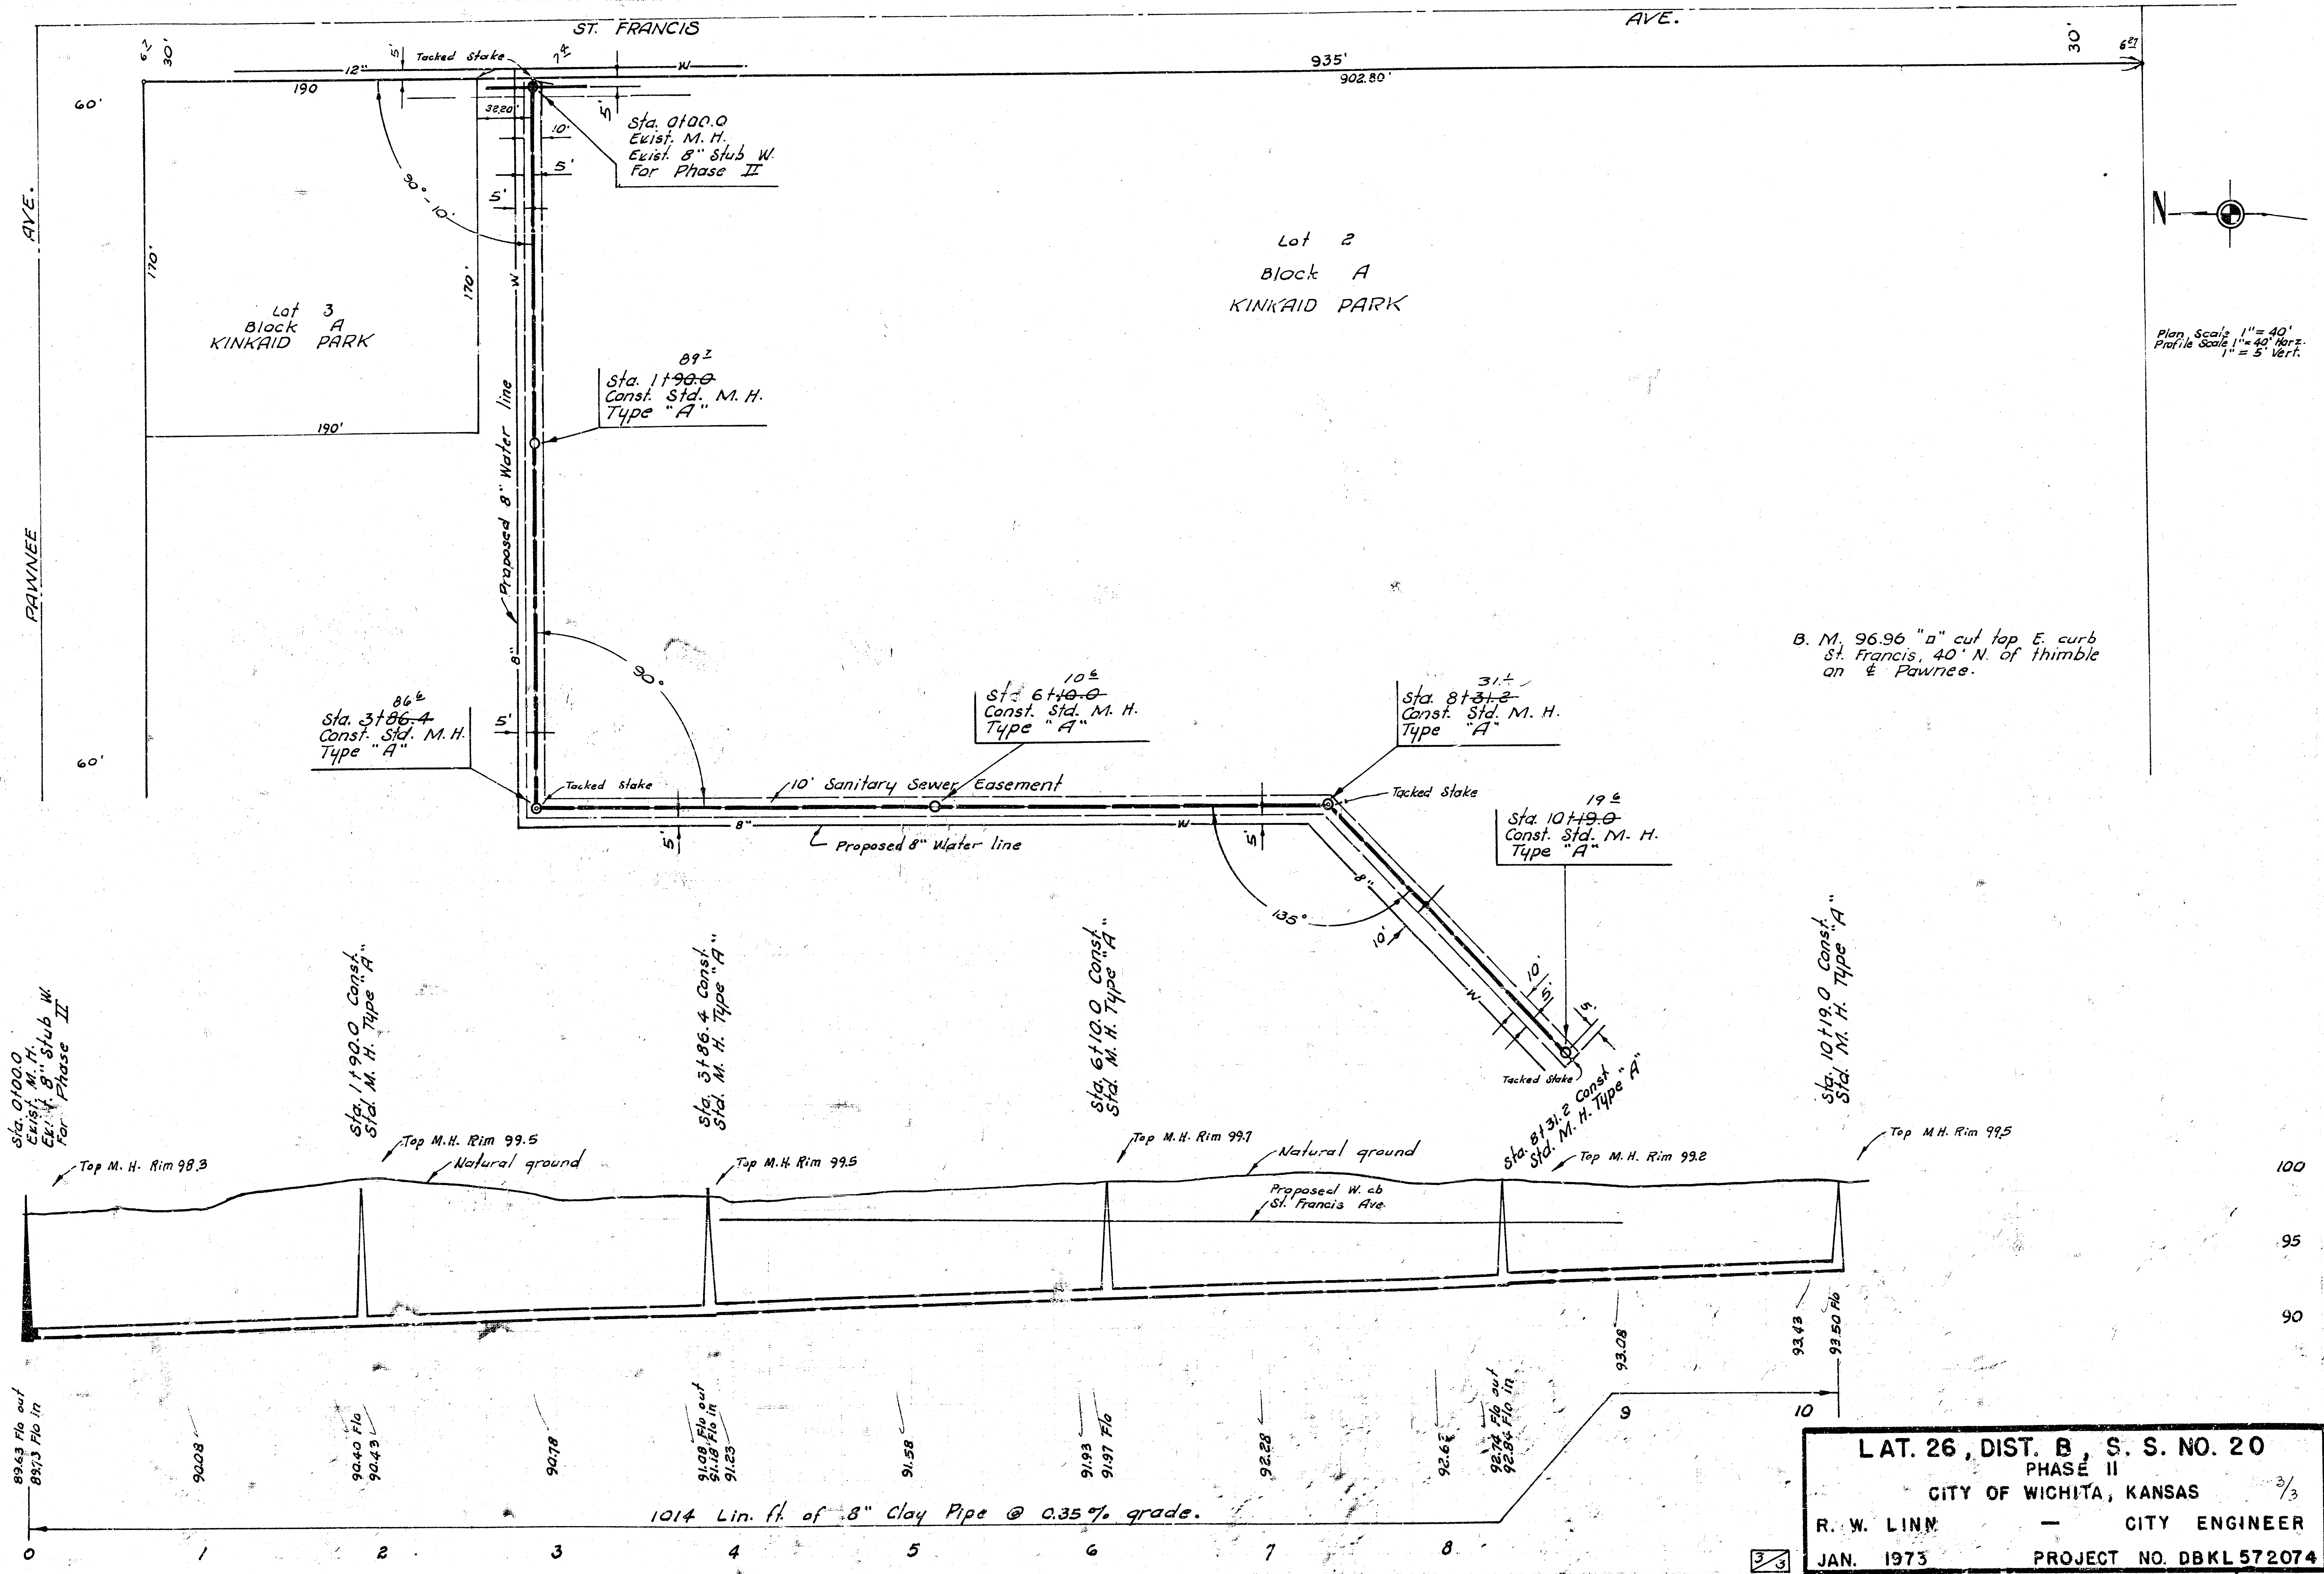

LAT. 26, DIST. B, S. S. NO. 20
PHASE II
CITY OF WICHITA, KANSAS
R. W. LINN — CITY ENGINEER
JAN. 1973 PROJECT NO. DBKL 572074