

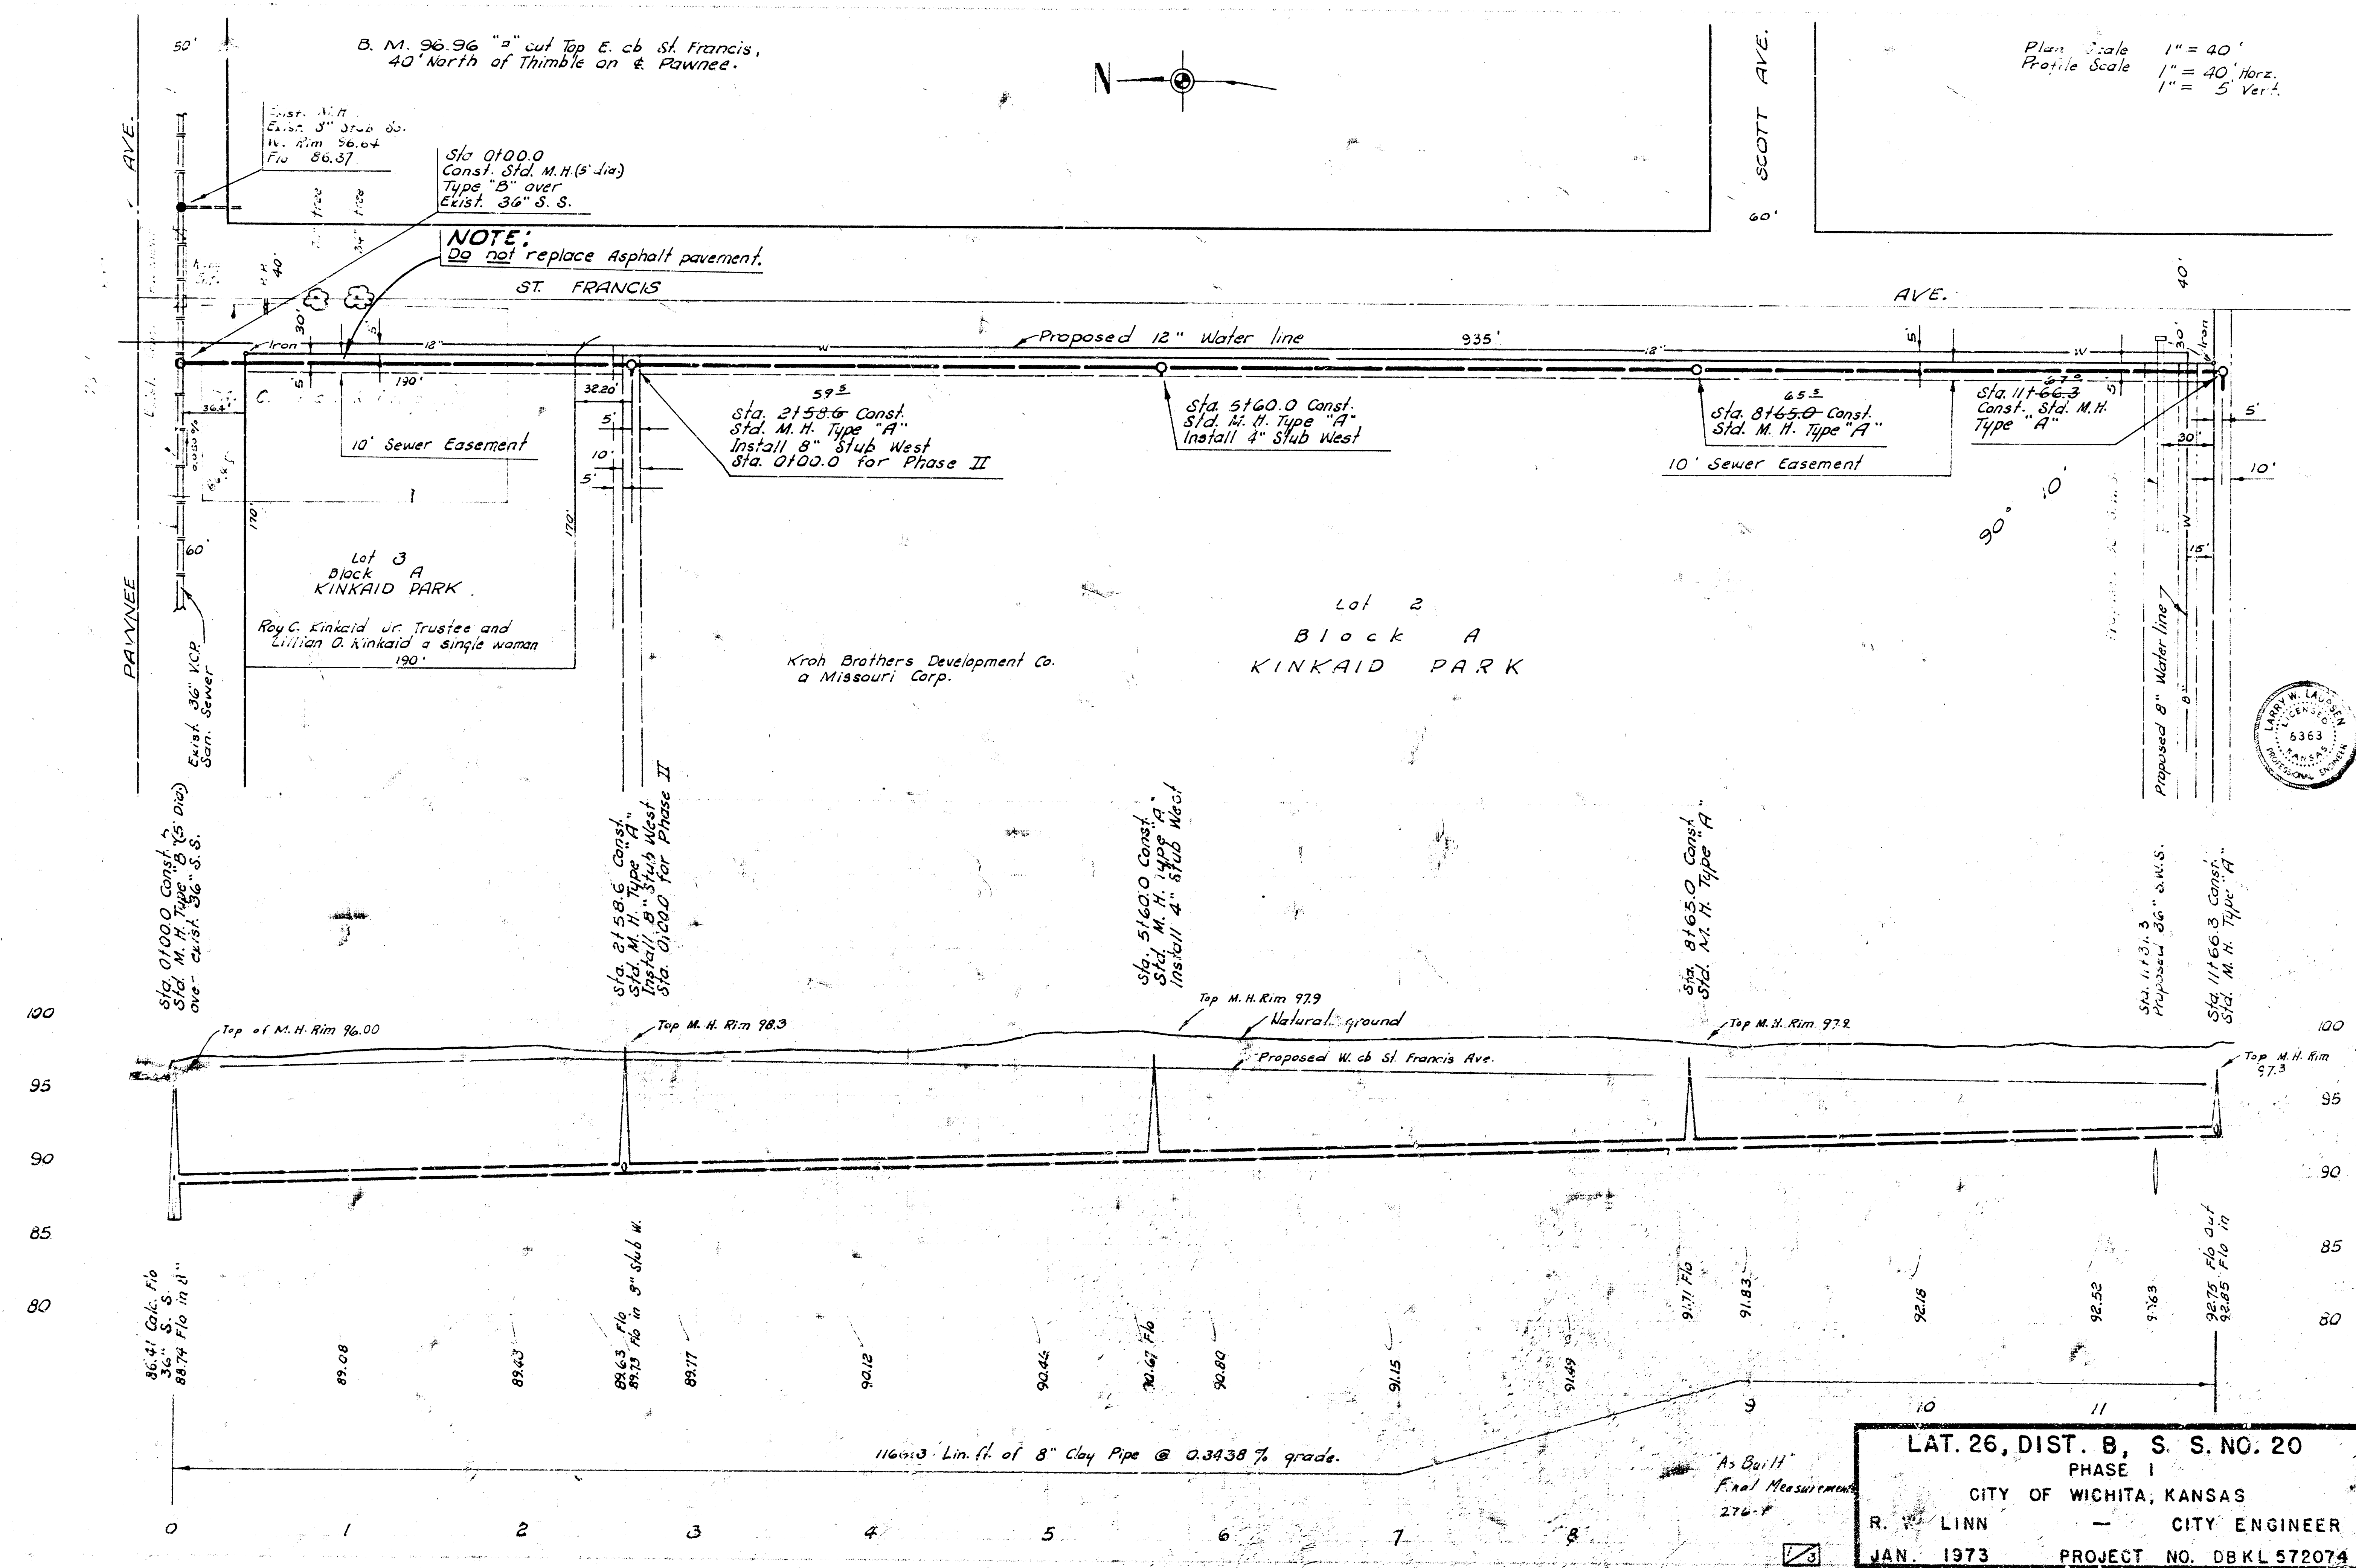


447.18

205

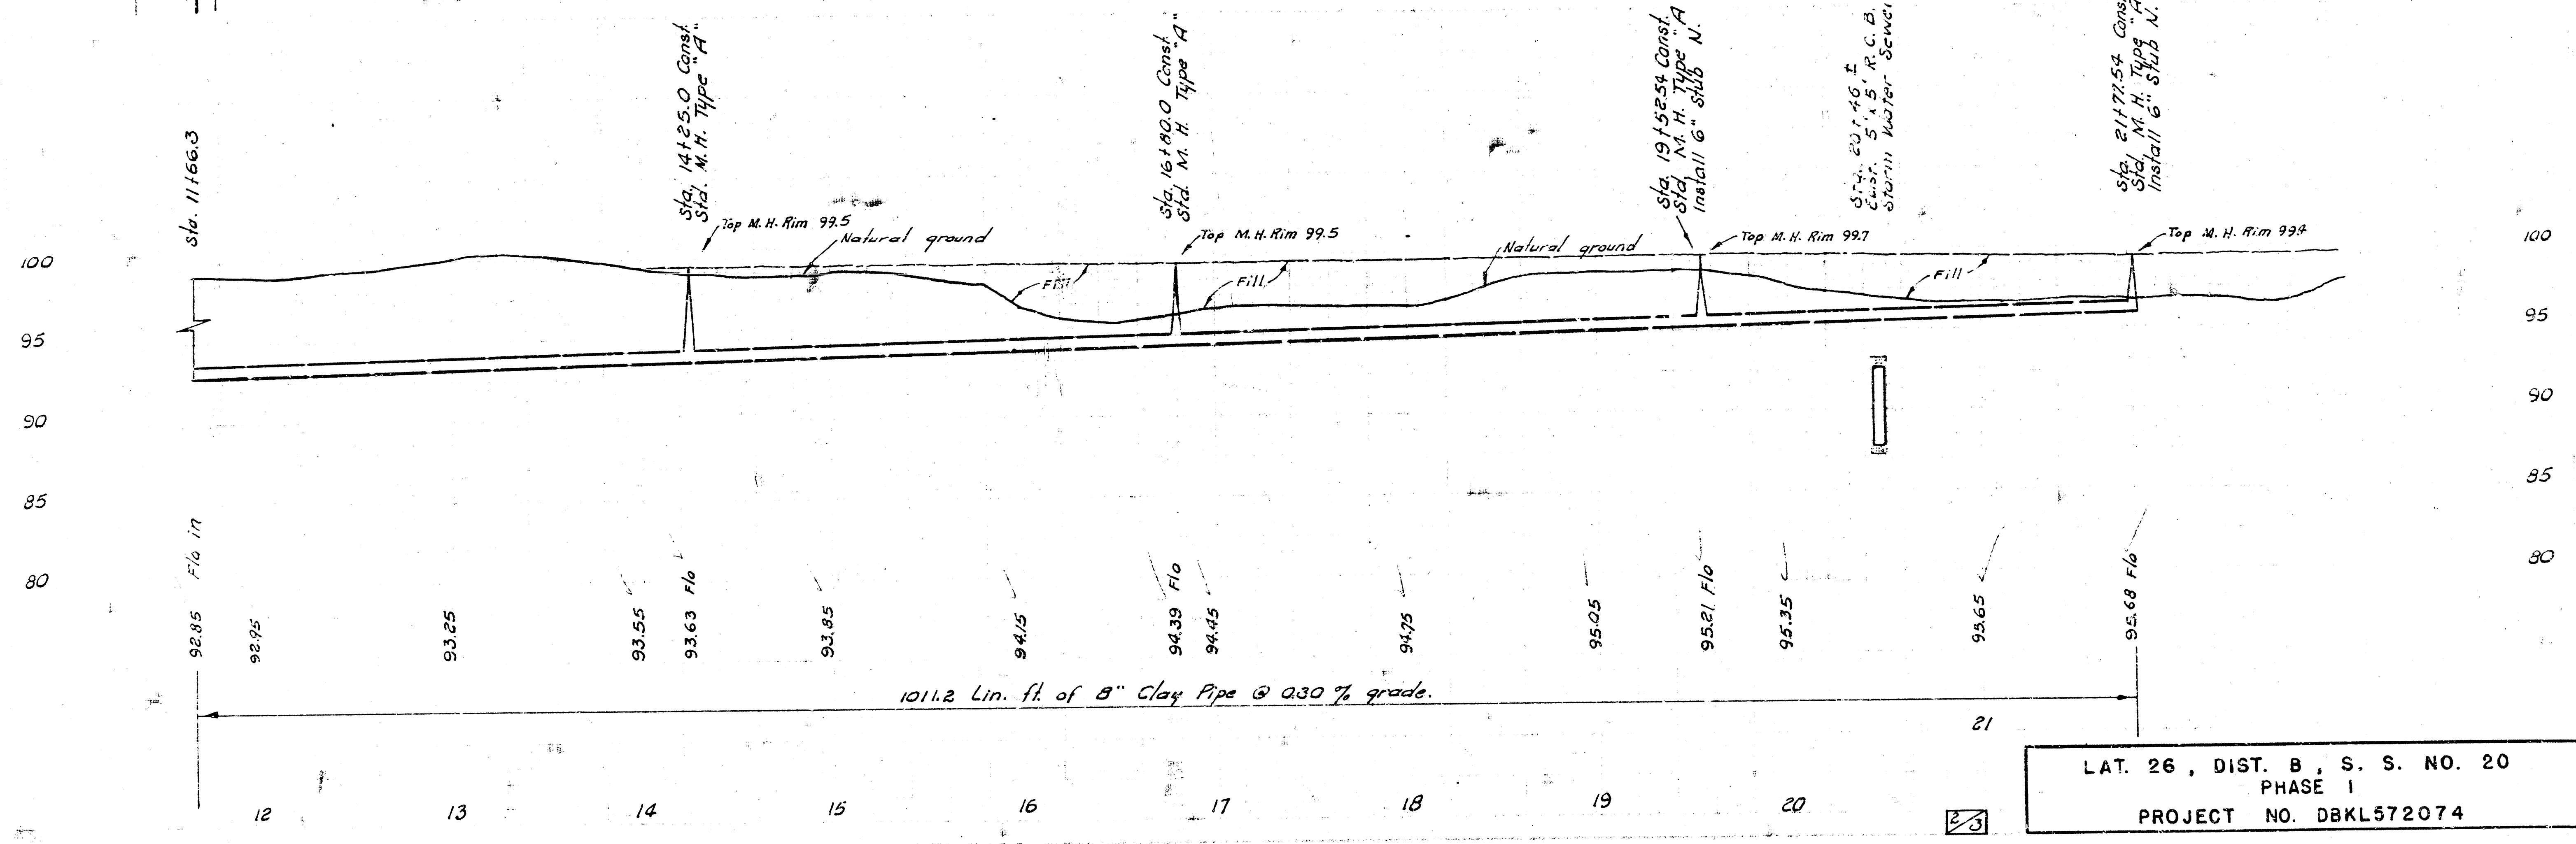

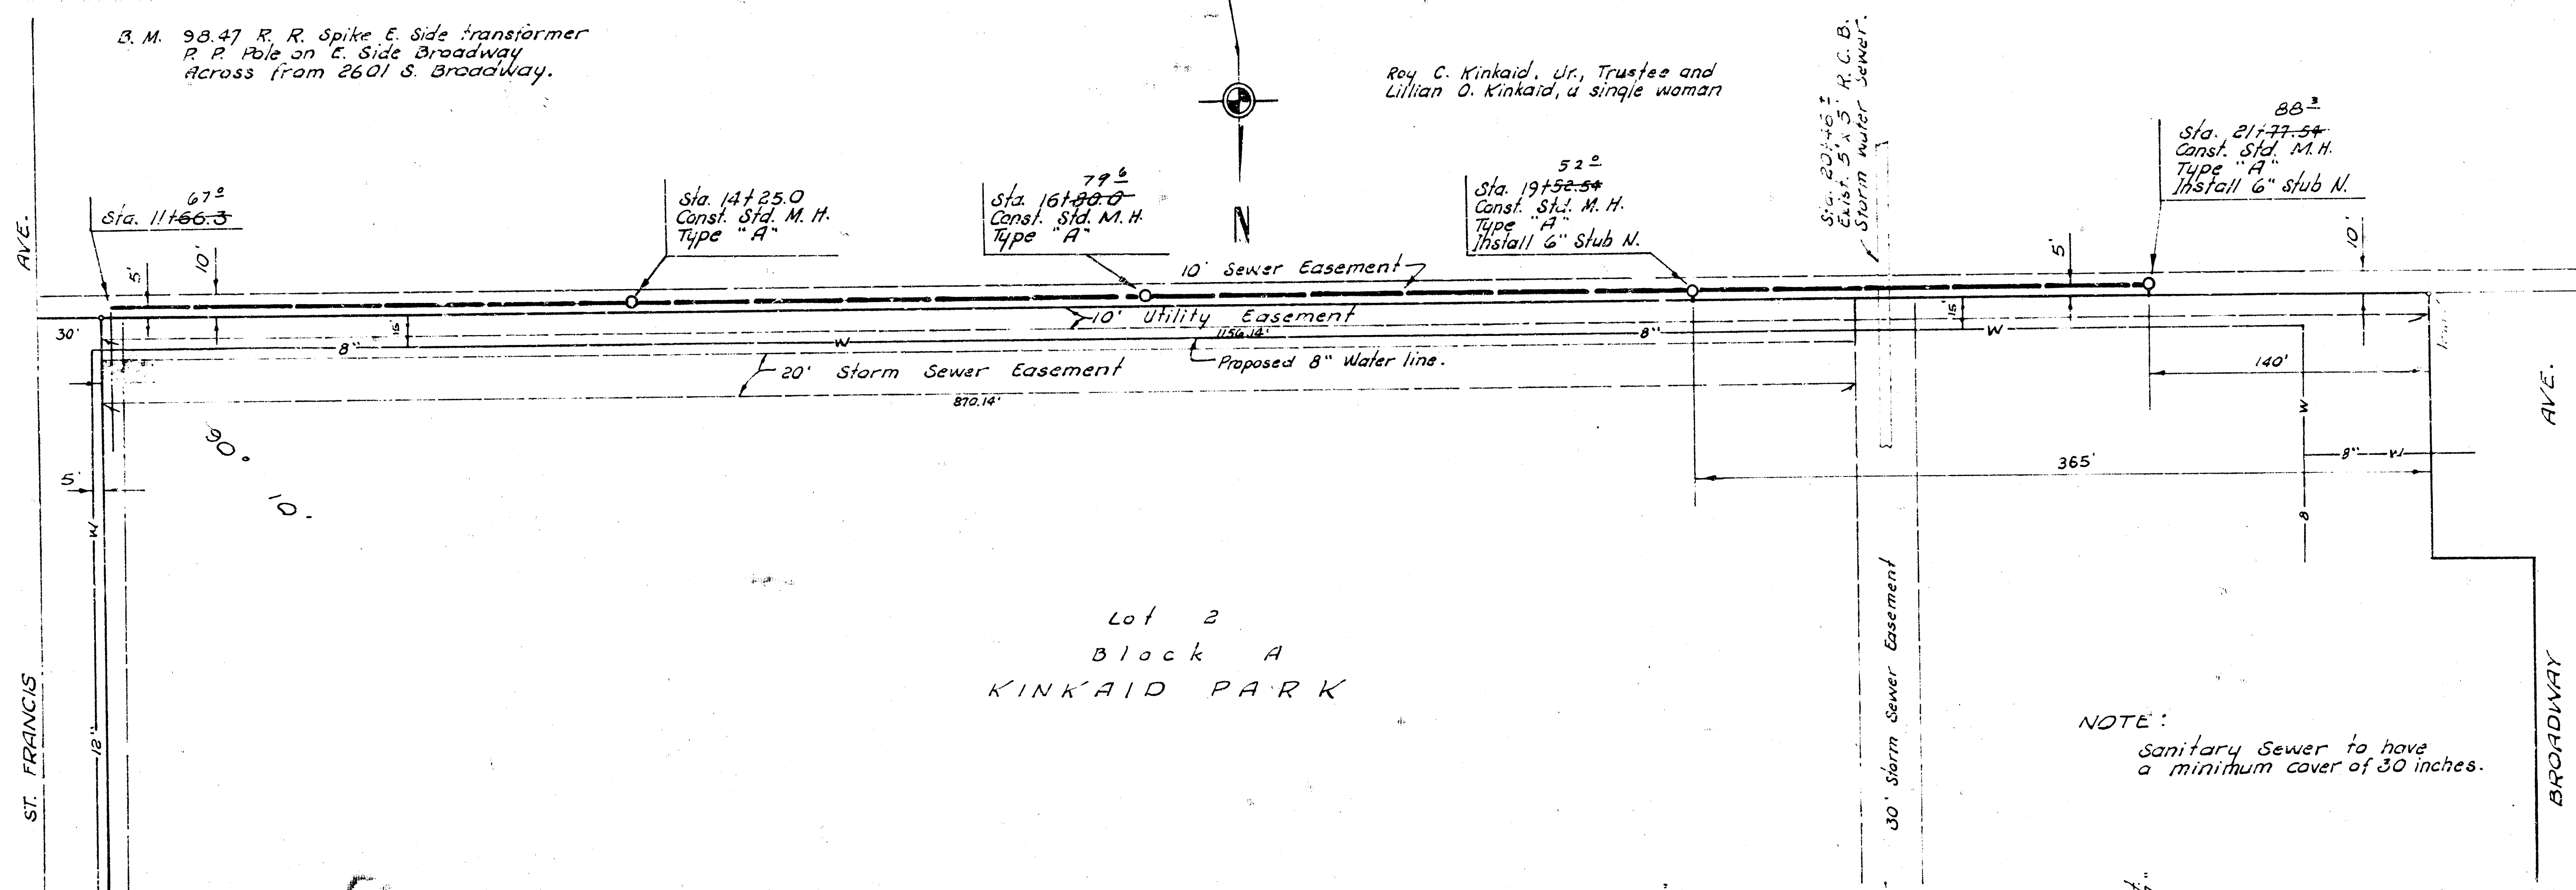

LAT. 26, DIST. 8, S. S. NO. 20
 PHASE I
 PROJECT NO. DBKL572074

