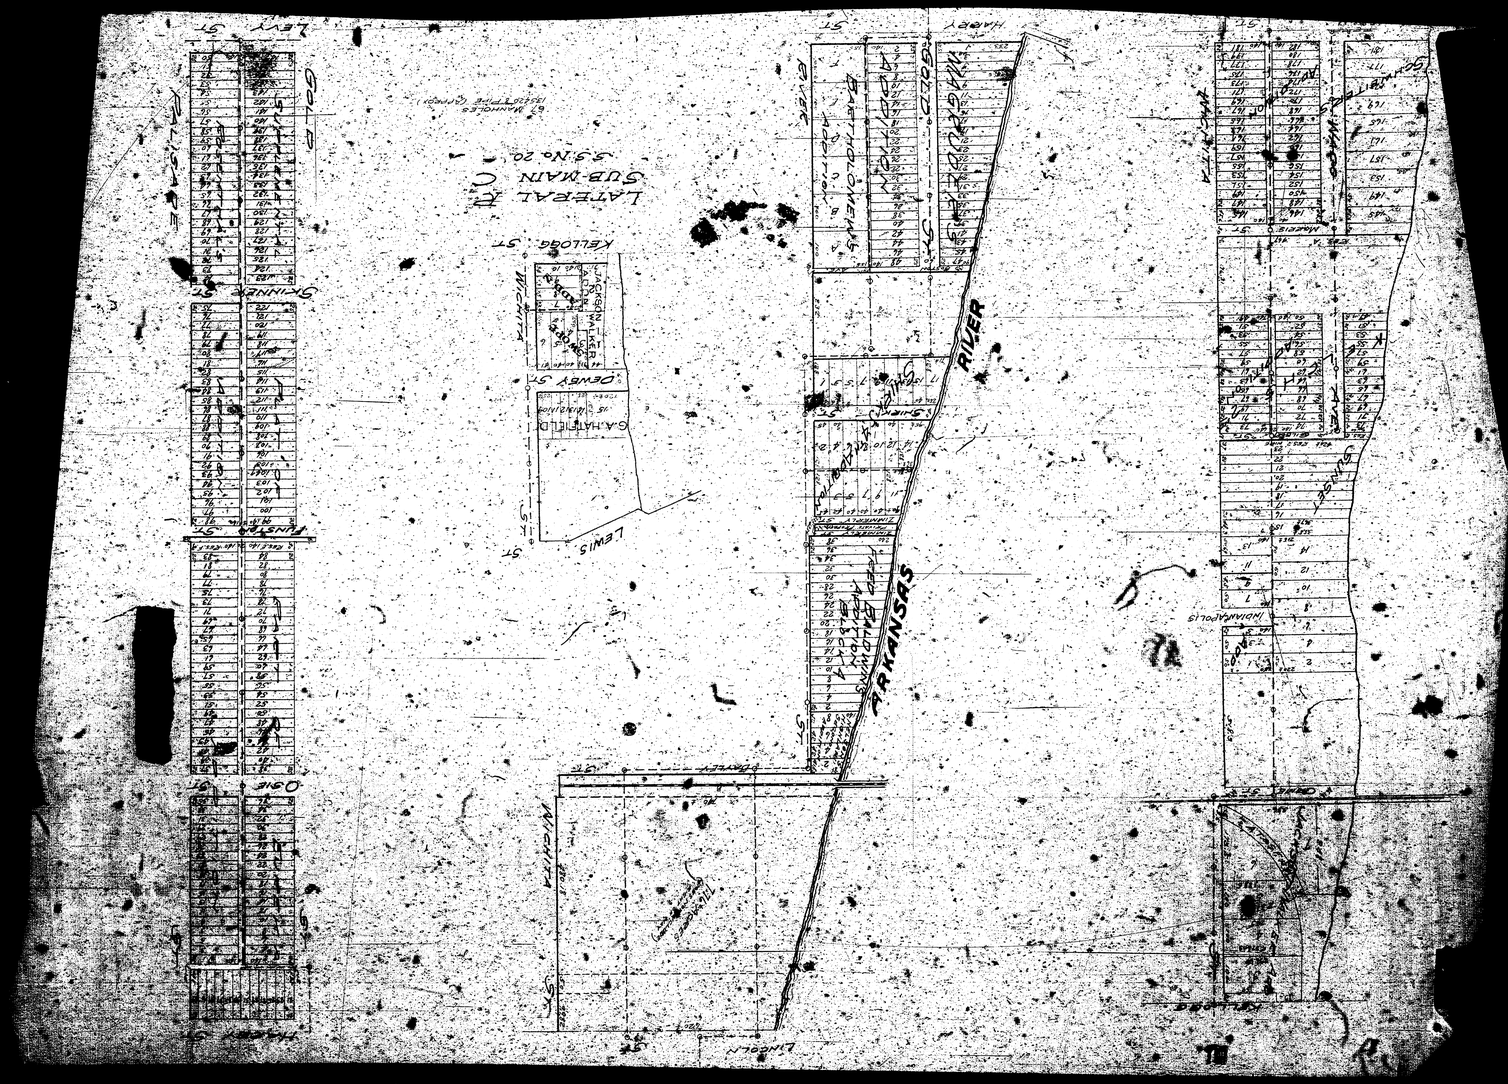
LATERAL E
SUB-MAIN C
S.3 No. 20
ARKANSAS RIVER
GOLD
LEWIS
DENBY
KELLOGG
MCKINLEY
LINCOLN
HARRY
GAHAGHILD
BARTHOLOMEWS
INDIANAPOLIS