

B. M. 107.30 "D" in Dalton W. side int. "D"
on S.E. cor. Ellis & Lincoln.

B. M. 108.27 NW. conc. step. Apt. # 1501 E.
Lincoln @ Ellis S.

B. M. 107.49 R. R. Spike NE. side Elm tres
on S.W. cor. Lincoln & Greenwood.


B. M. 107.68 S. cor. of conc. base to mobil
sign on N.W. cor. Lincoln & Hydraulic.

U. F. G.
A. R. W.

229

110
105
100
95
90

NOTE:
Contractor is to excavate
pipe at Sta. 7130.0 Line
No. 1 and Sta. 0175.0 Line
No. 2 so that field Engineer
can verify pipe Flo. elevations
prior to construction.


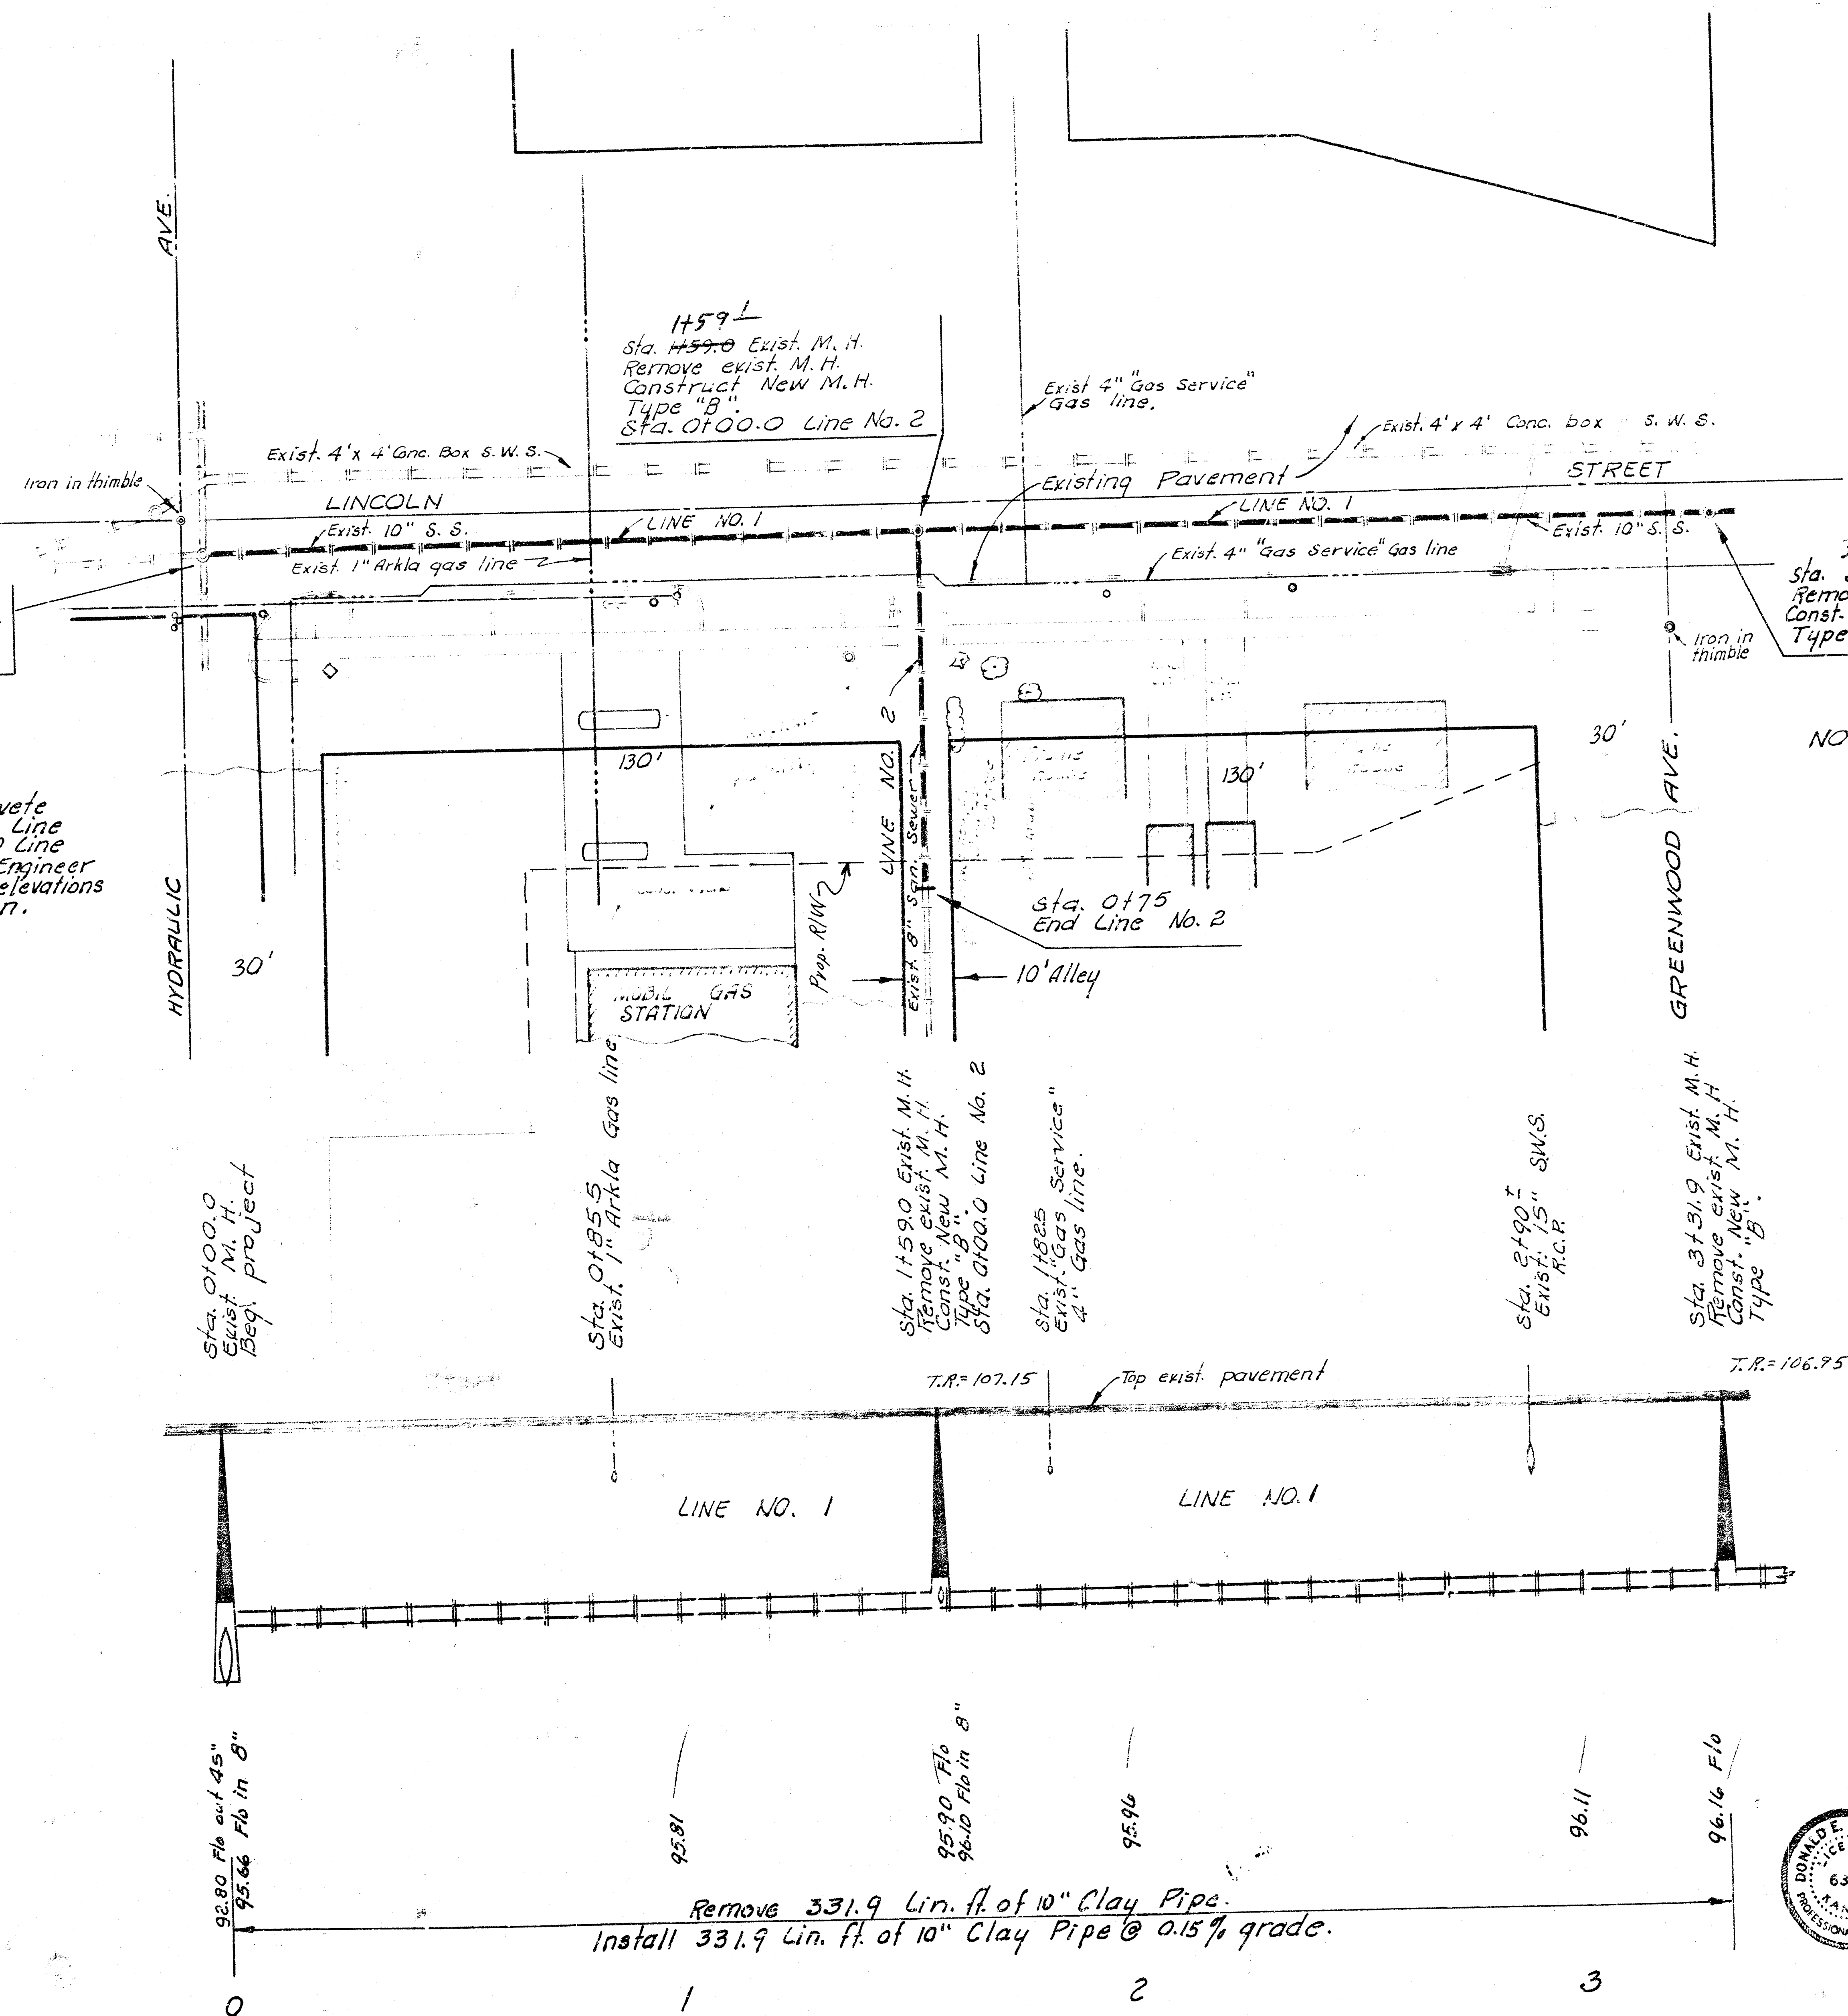


NOTE:
Do not replace
pavement and
storm water
sewer leads.
Sta. 0100.0 to Sta. 7125.0

NOTE: JOINTS BETWEEN NEW PIPE AND EXISTING PIPE
SHALL BE ENCASED WITH CONCRETE ENCASEMENT A MINIMUM
DISTANCE OF 2' ON EACH SIDE OF THE JOINT. THIS
WORK WILL NOT BE PAID FOR DIRECTLY AND THE COST
FOR THIS WORK SHALL BE INCLUDED IN THE PRICE BID
FOR THE OTHER ITEMS OF WORK.


Sta. 0100.0 Line No. 2 =
Sta. 1159.0 Line No. 1
Sta. 0199.0 Exist. 4"
Gas Service Gas line

Sta. 0175.0 End Line No. 2

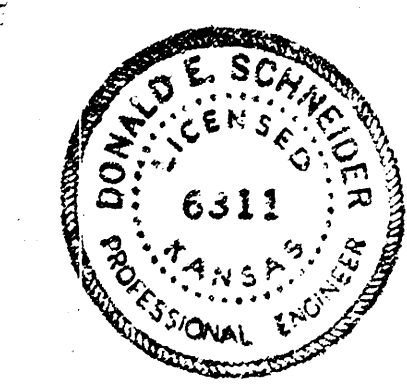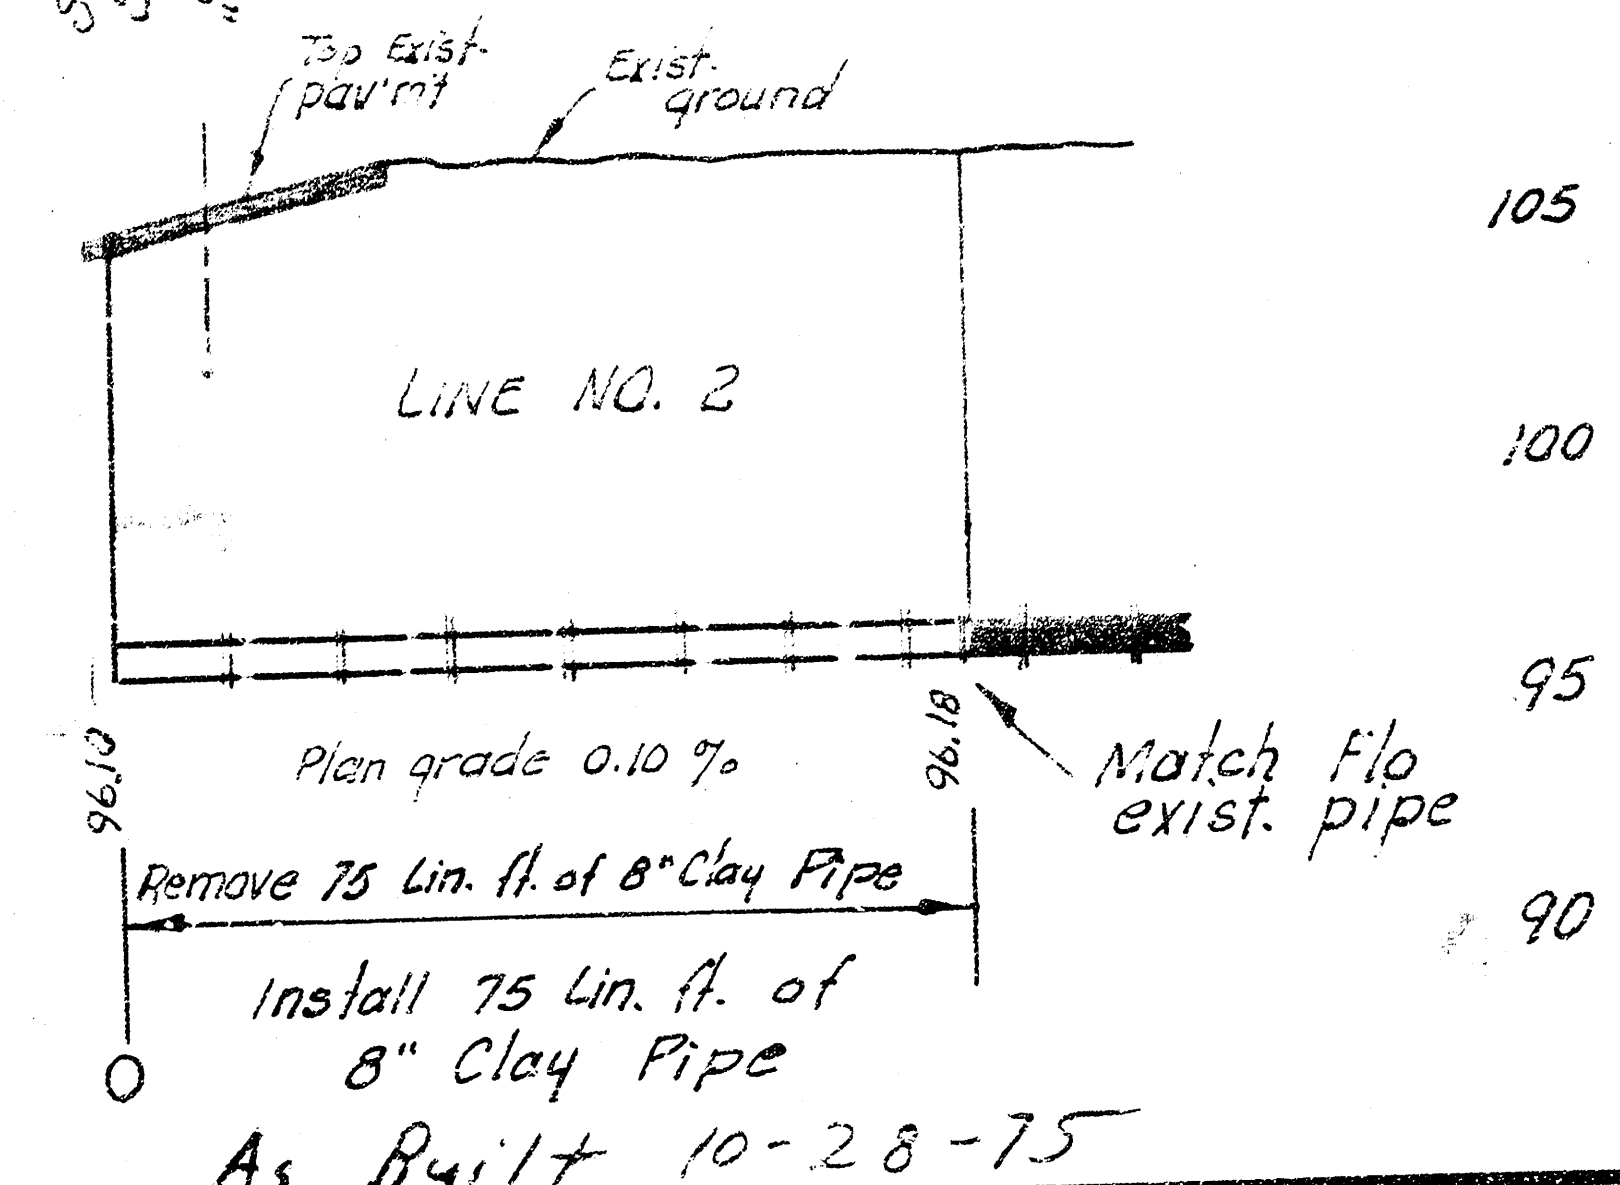

RECONSTRUCTION OF A PORTION OF
DISTRICT G, S. S. NO. 20
IN LINCOLN ST. FROM HYDRAULIC AVE. TO ELLIS AVE.
CITY OF WICHITA, KANSAS
R. W. LINN — CITY ENGINEER
DATE: PROJECT NO. DBKM575063

110
105
100
95

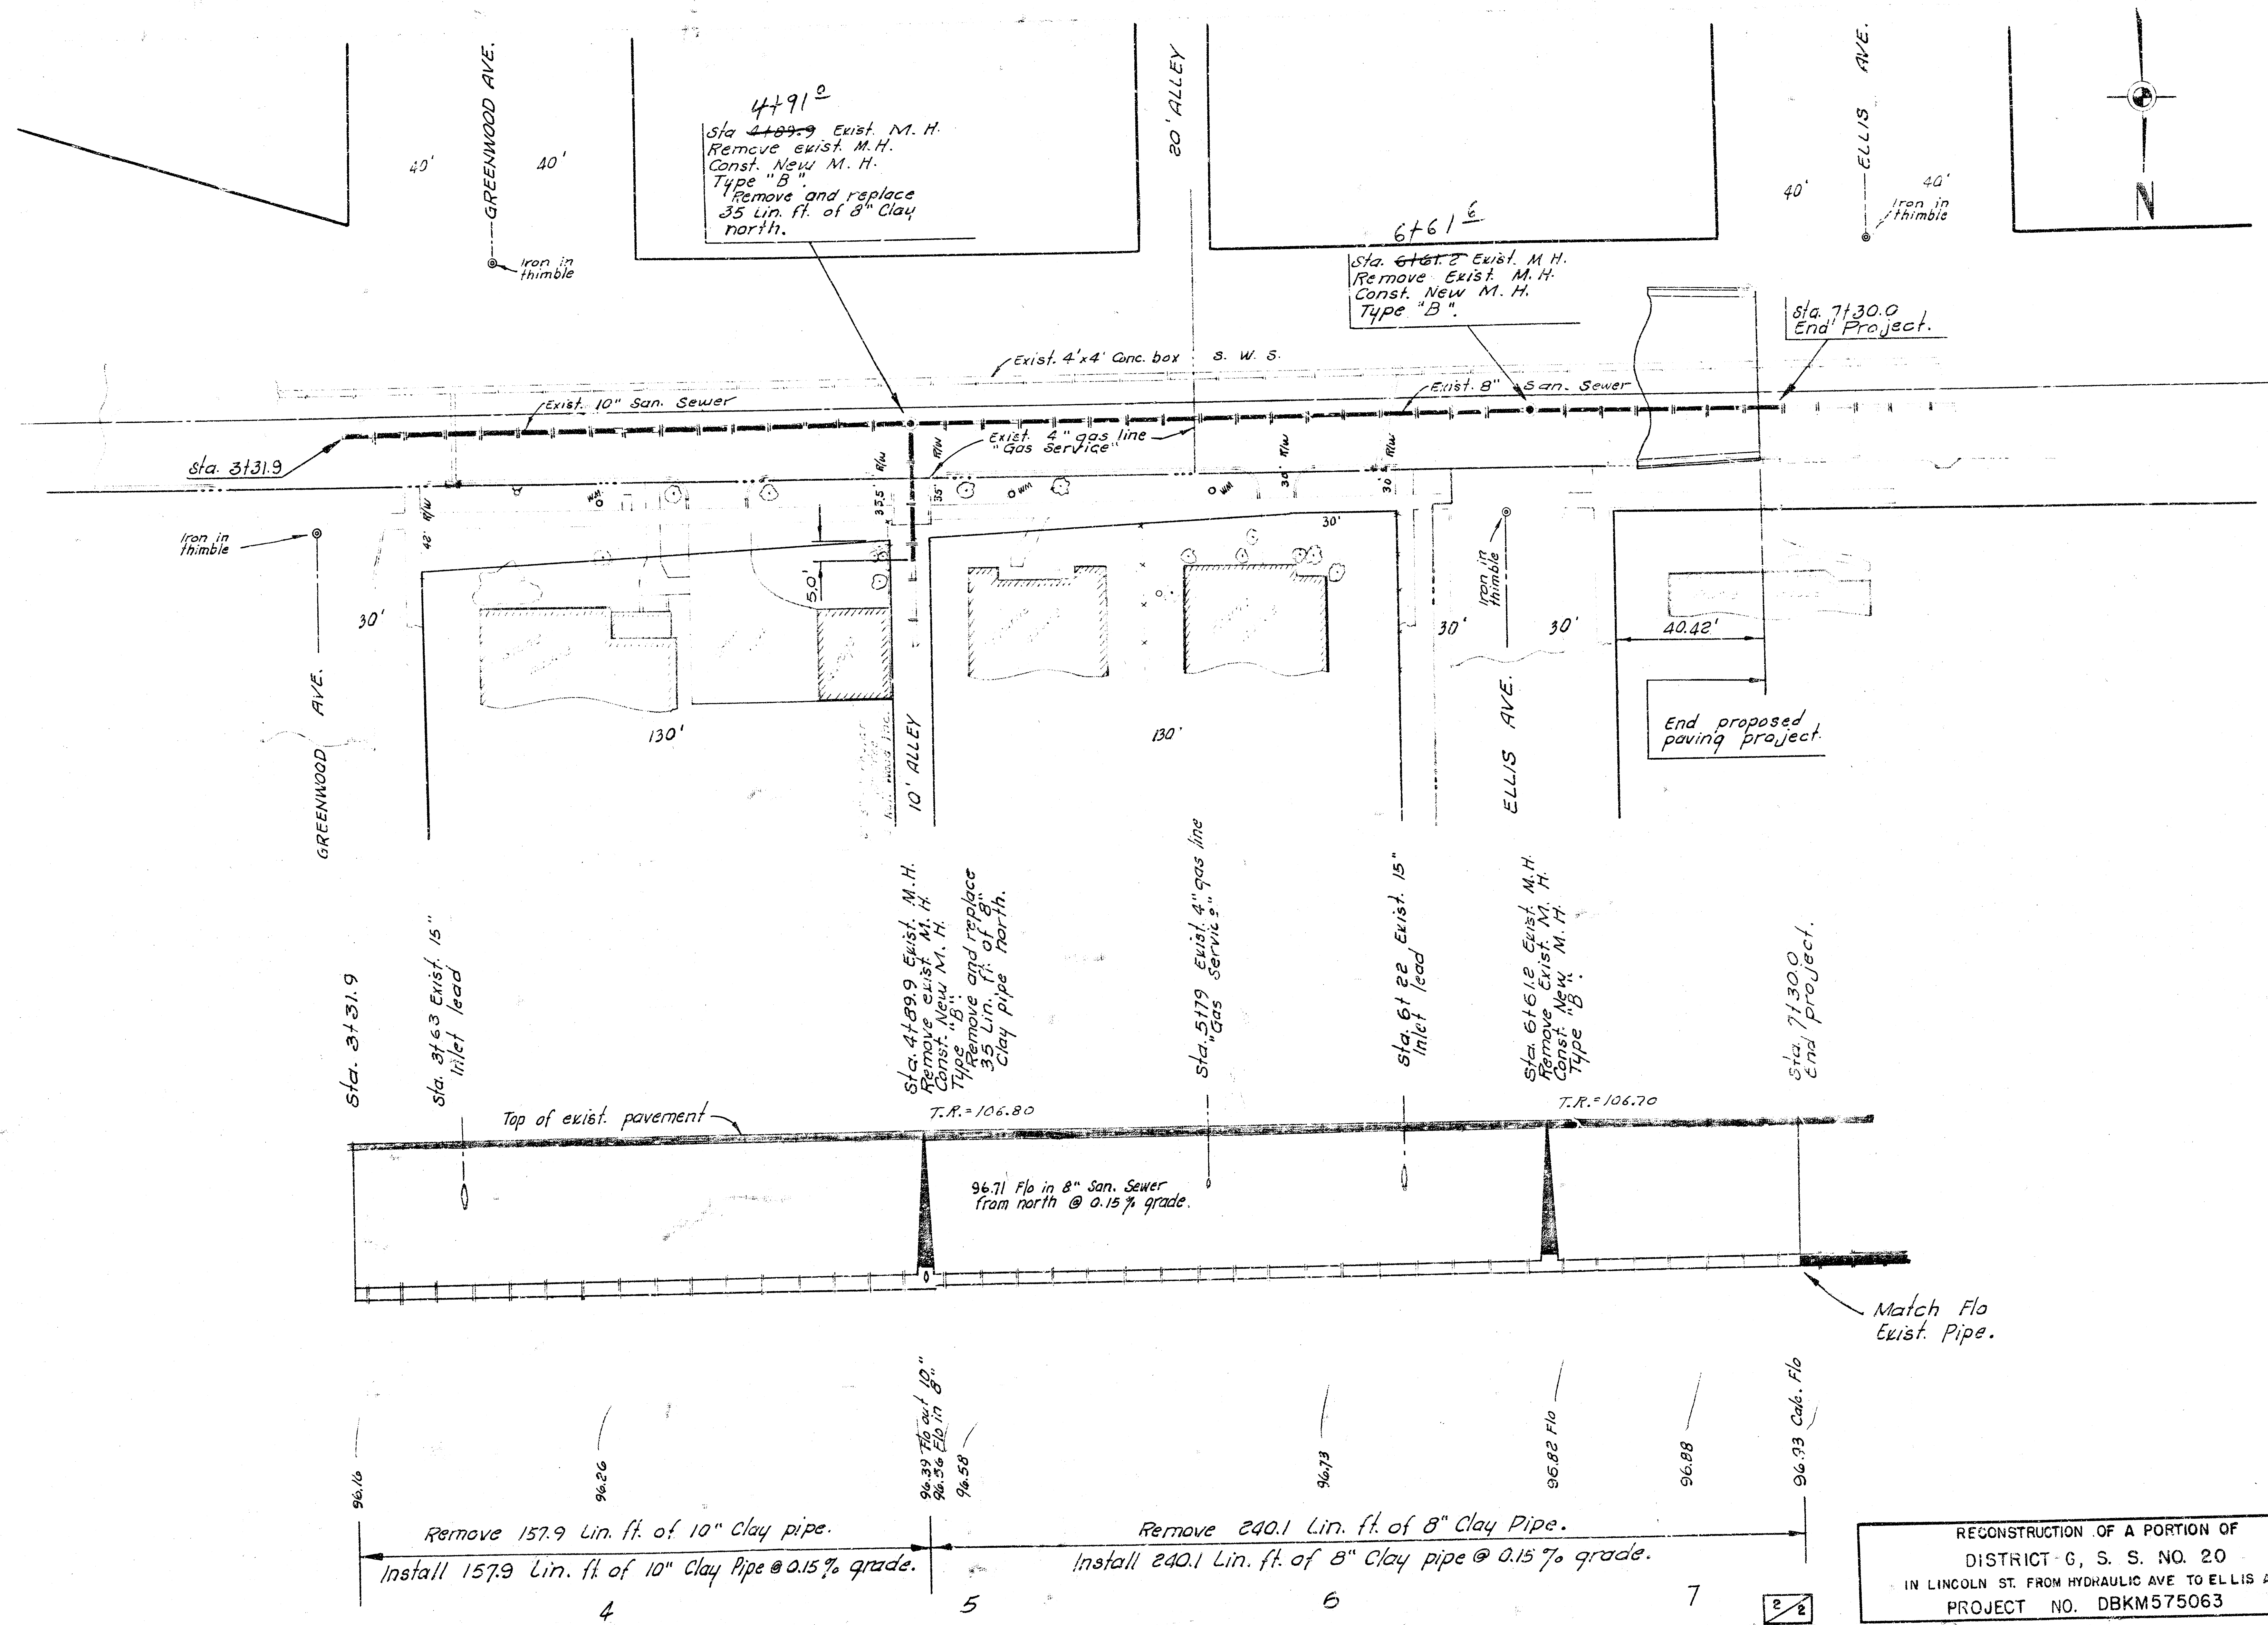

110
105
100
95