




244 JMK K-18
244 JMK
244 JMK

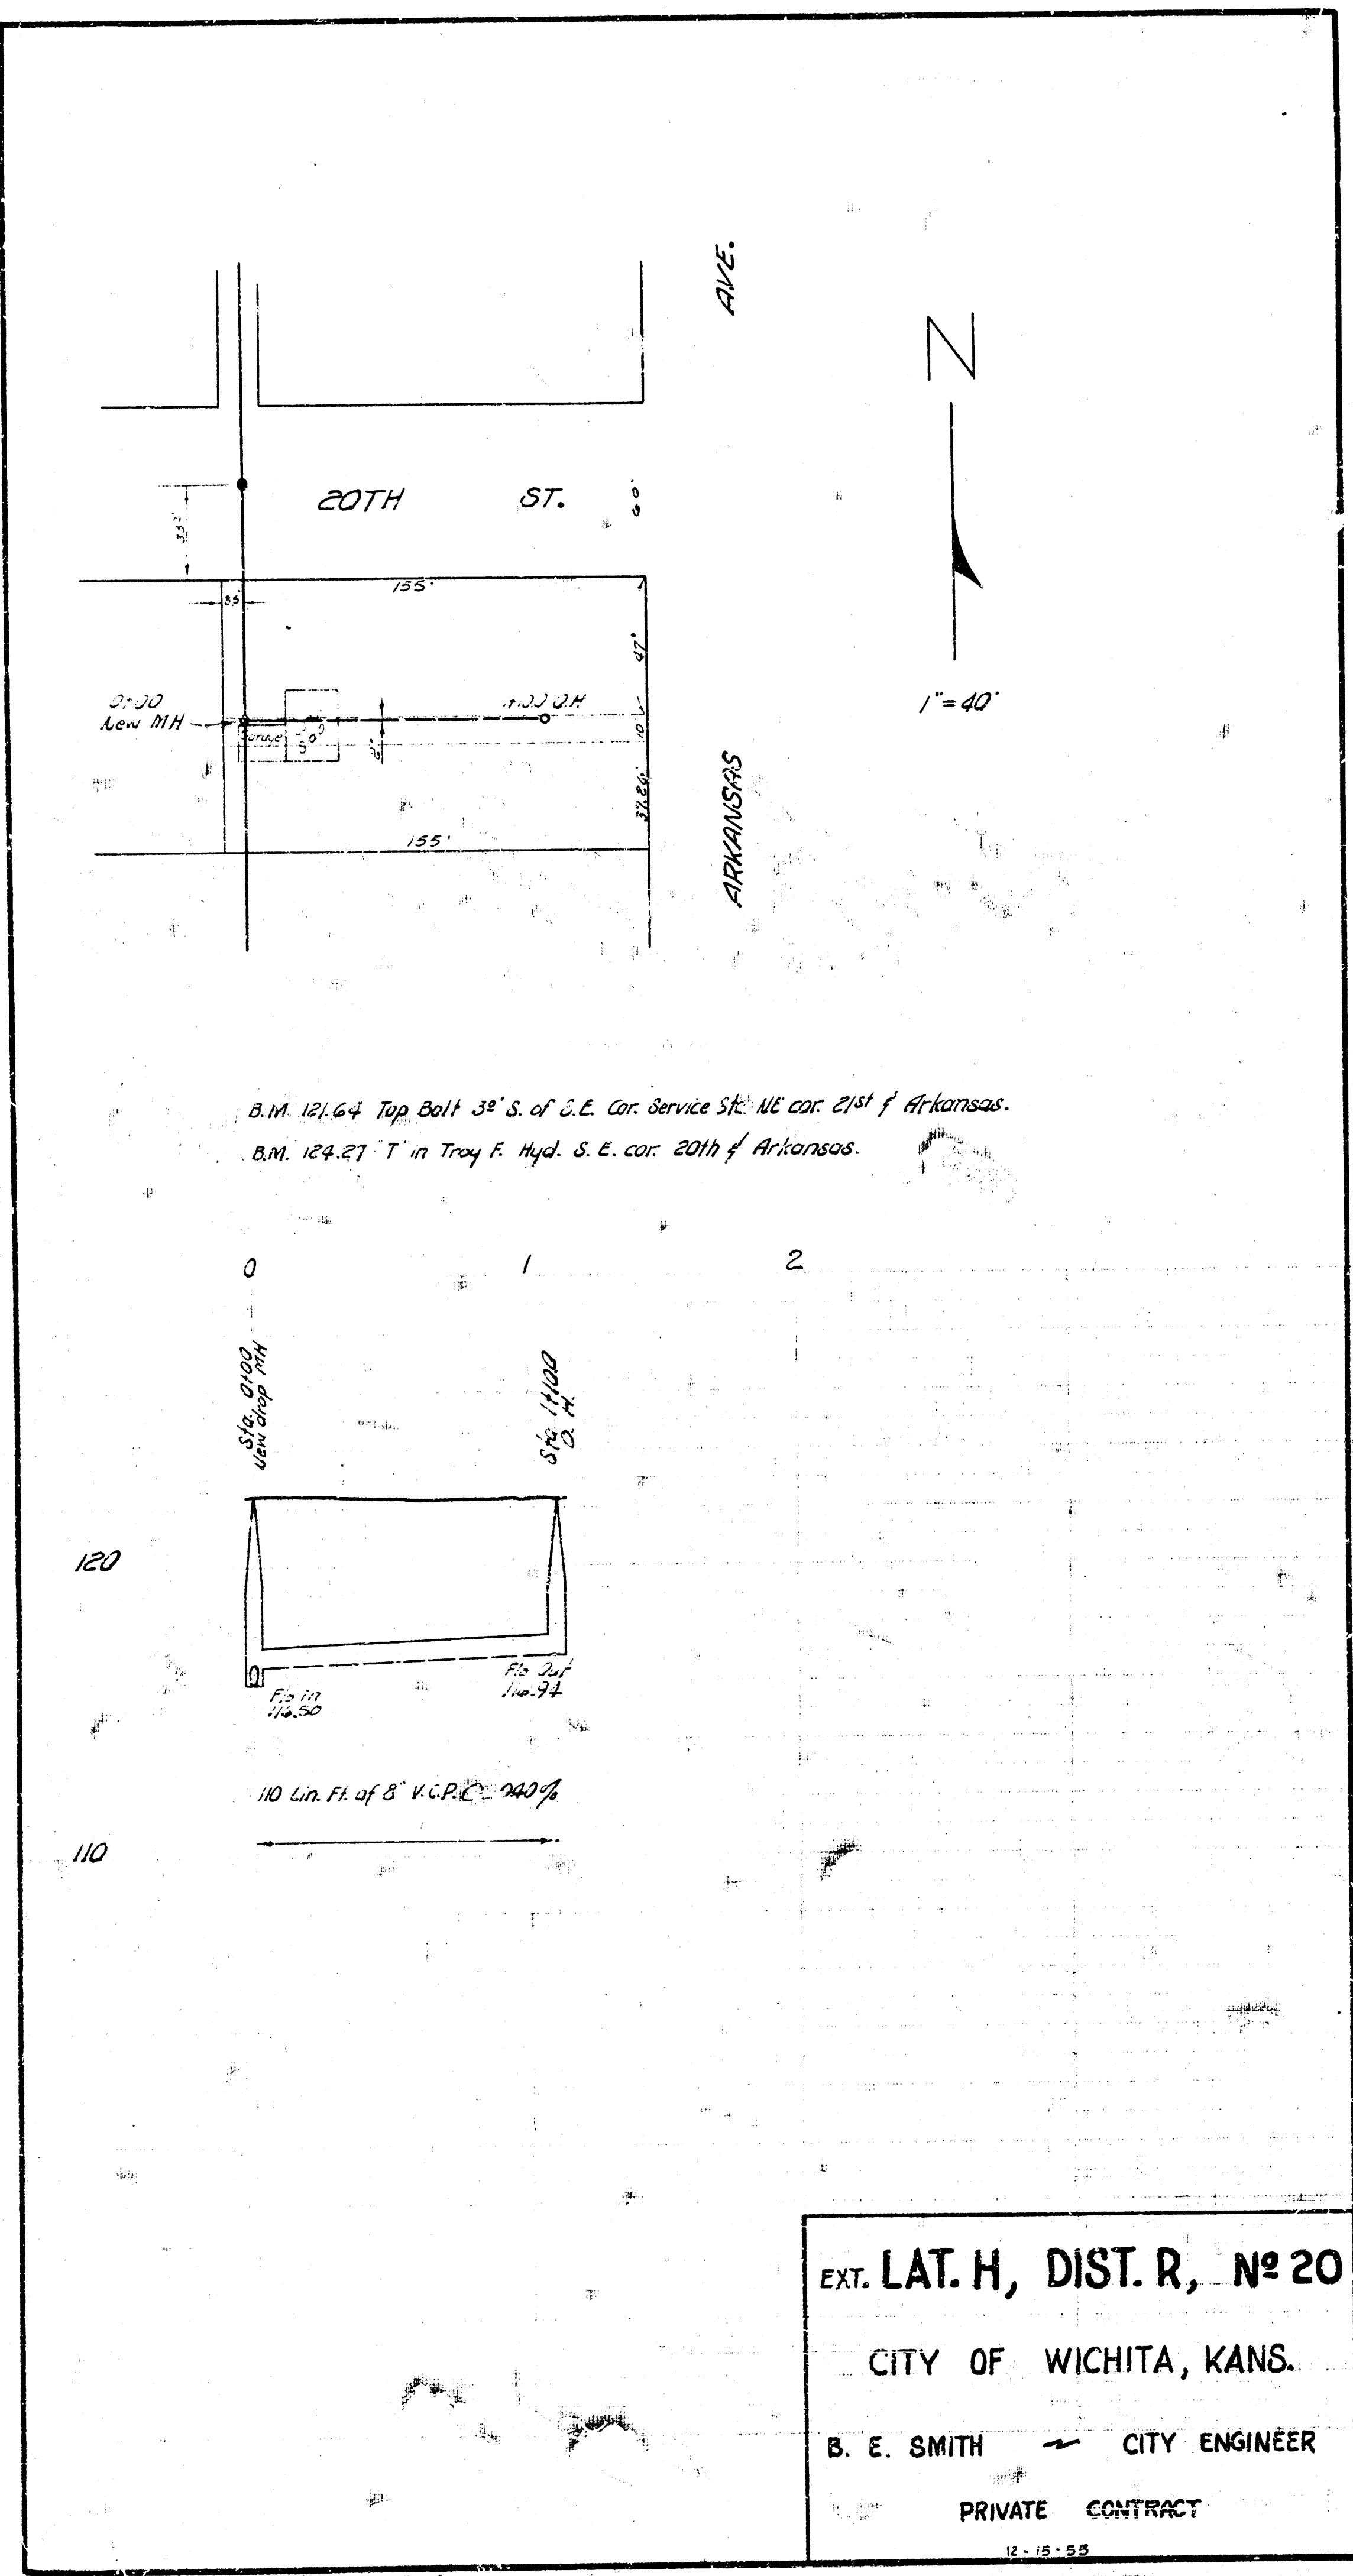

EXT. LAT. H, DIST. R, N^o 20
CITY OF WICHITA, KANS.
B. E. SMITH CITY ENGINEER
PRIVATE CONTRACT
12-18-55

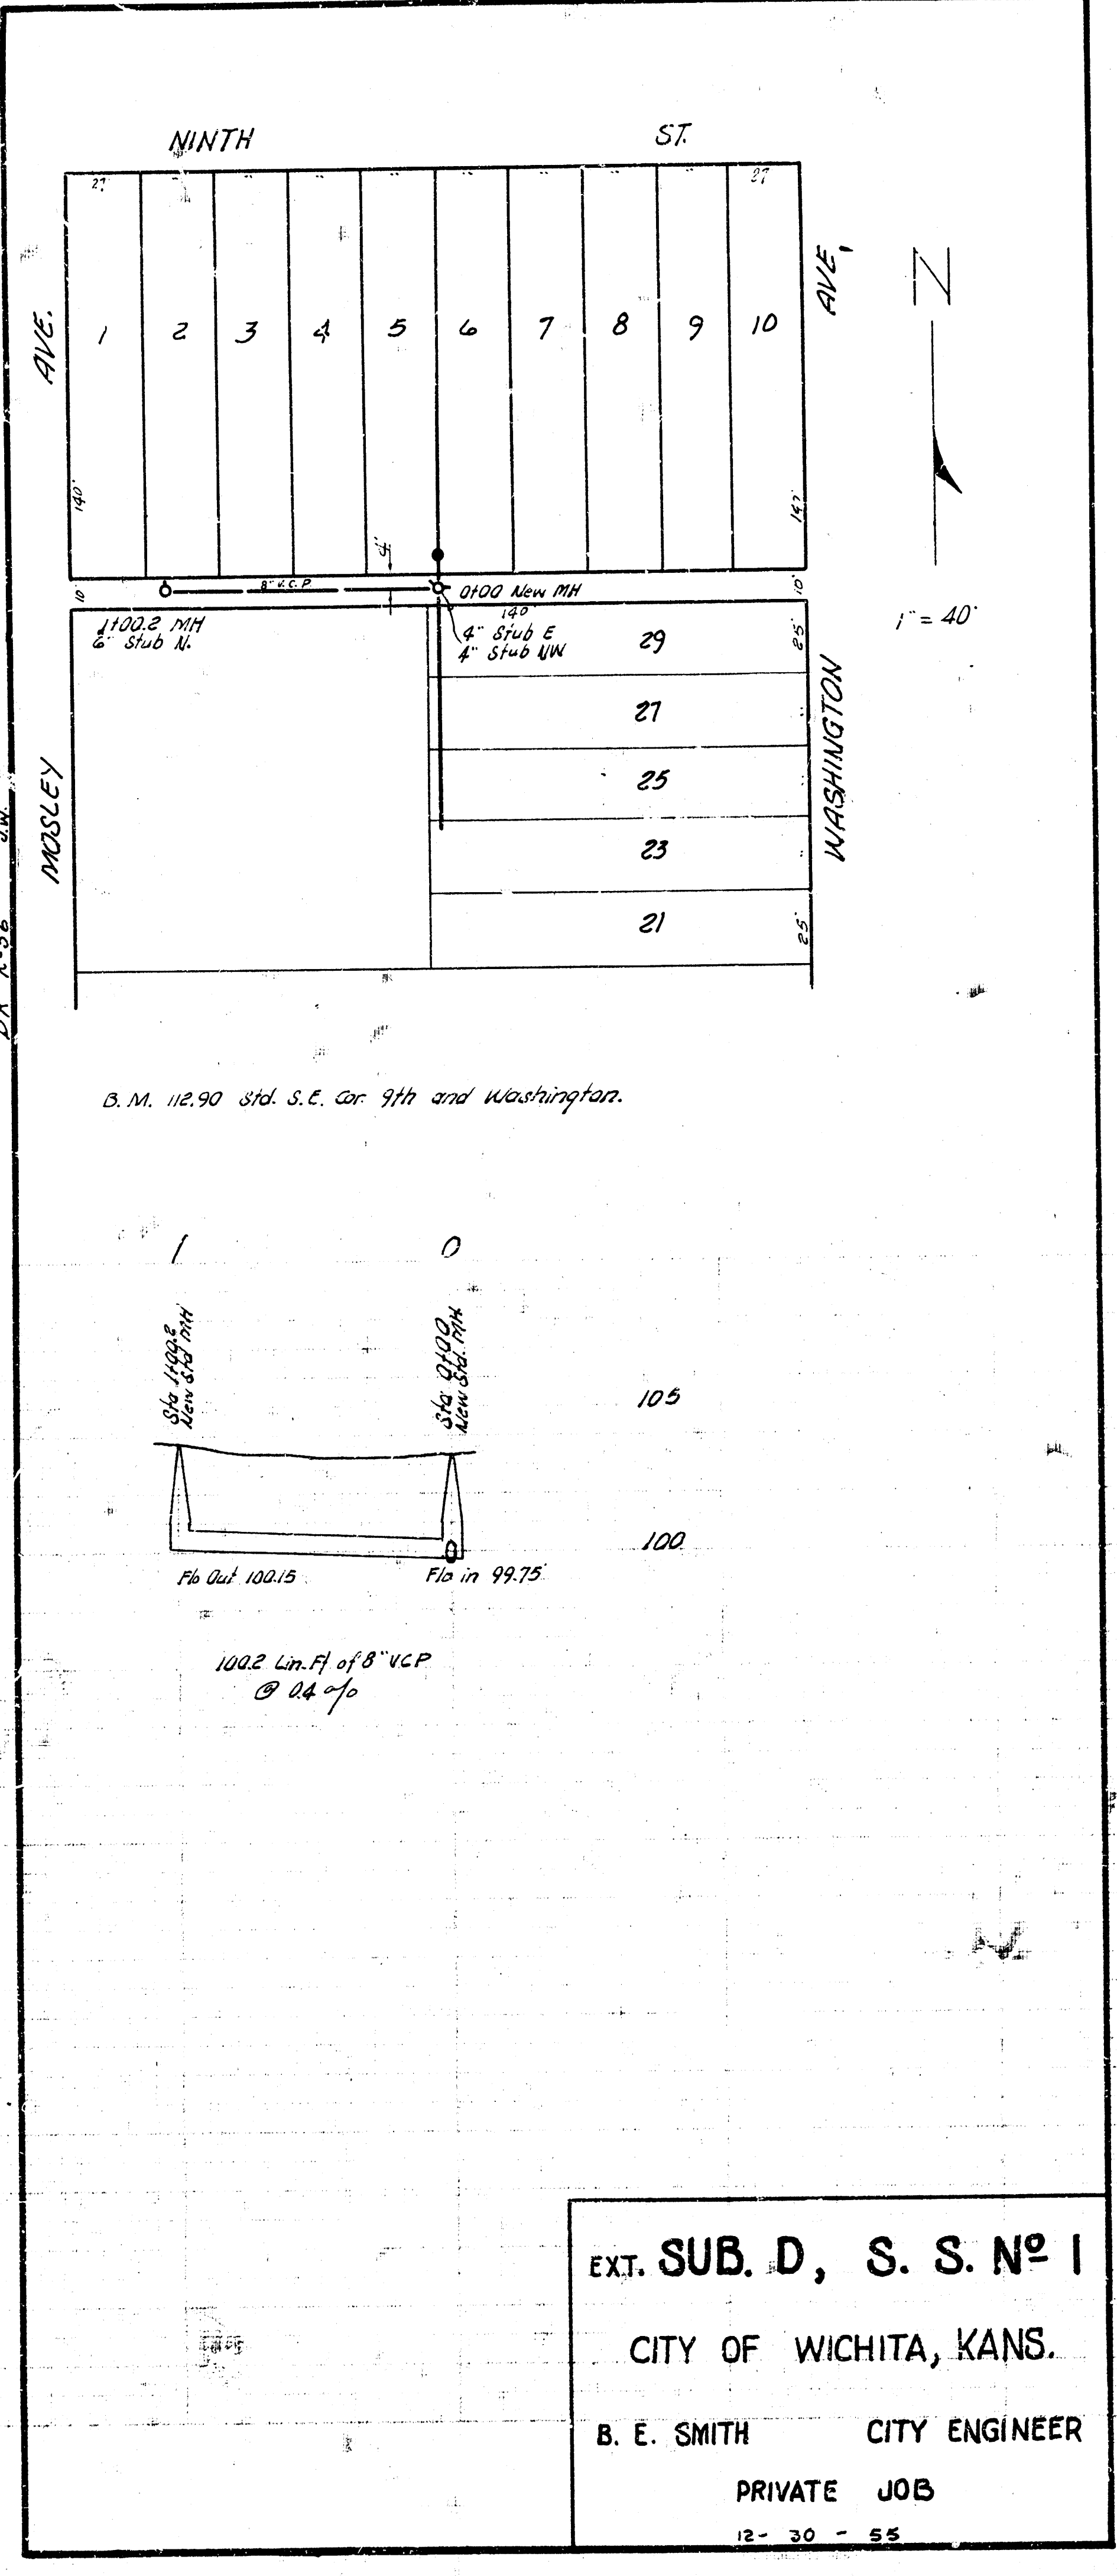

EXT. SUB. D, S. S. N^o 1
CITY OF WICHITA, KANS.
B. E. SMITH CITY ENGINEER
PRIVATE JOB
12-30-55

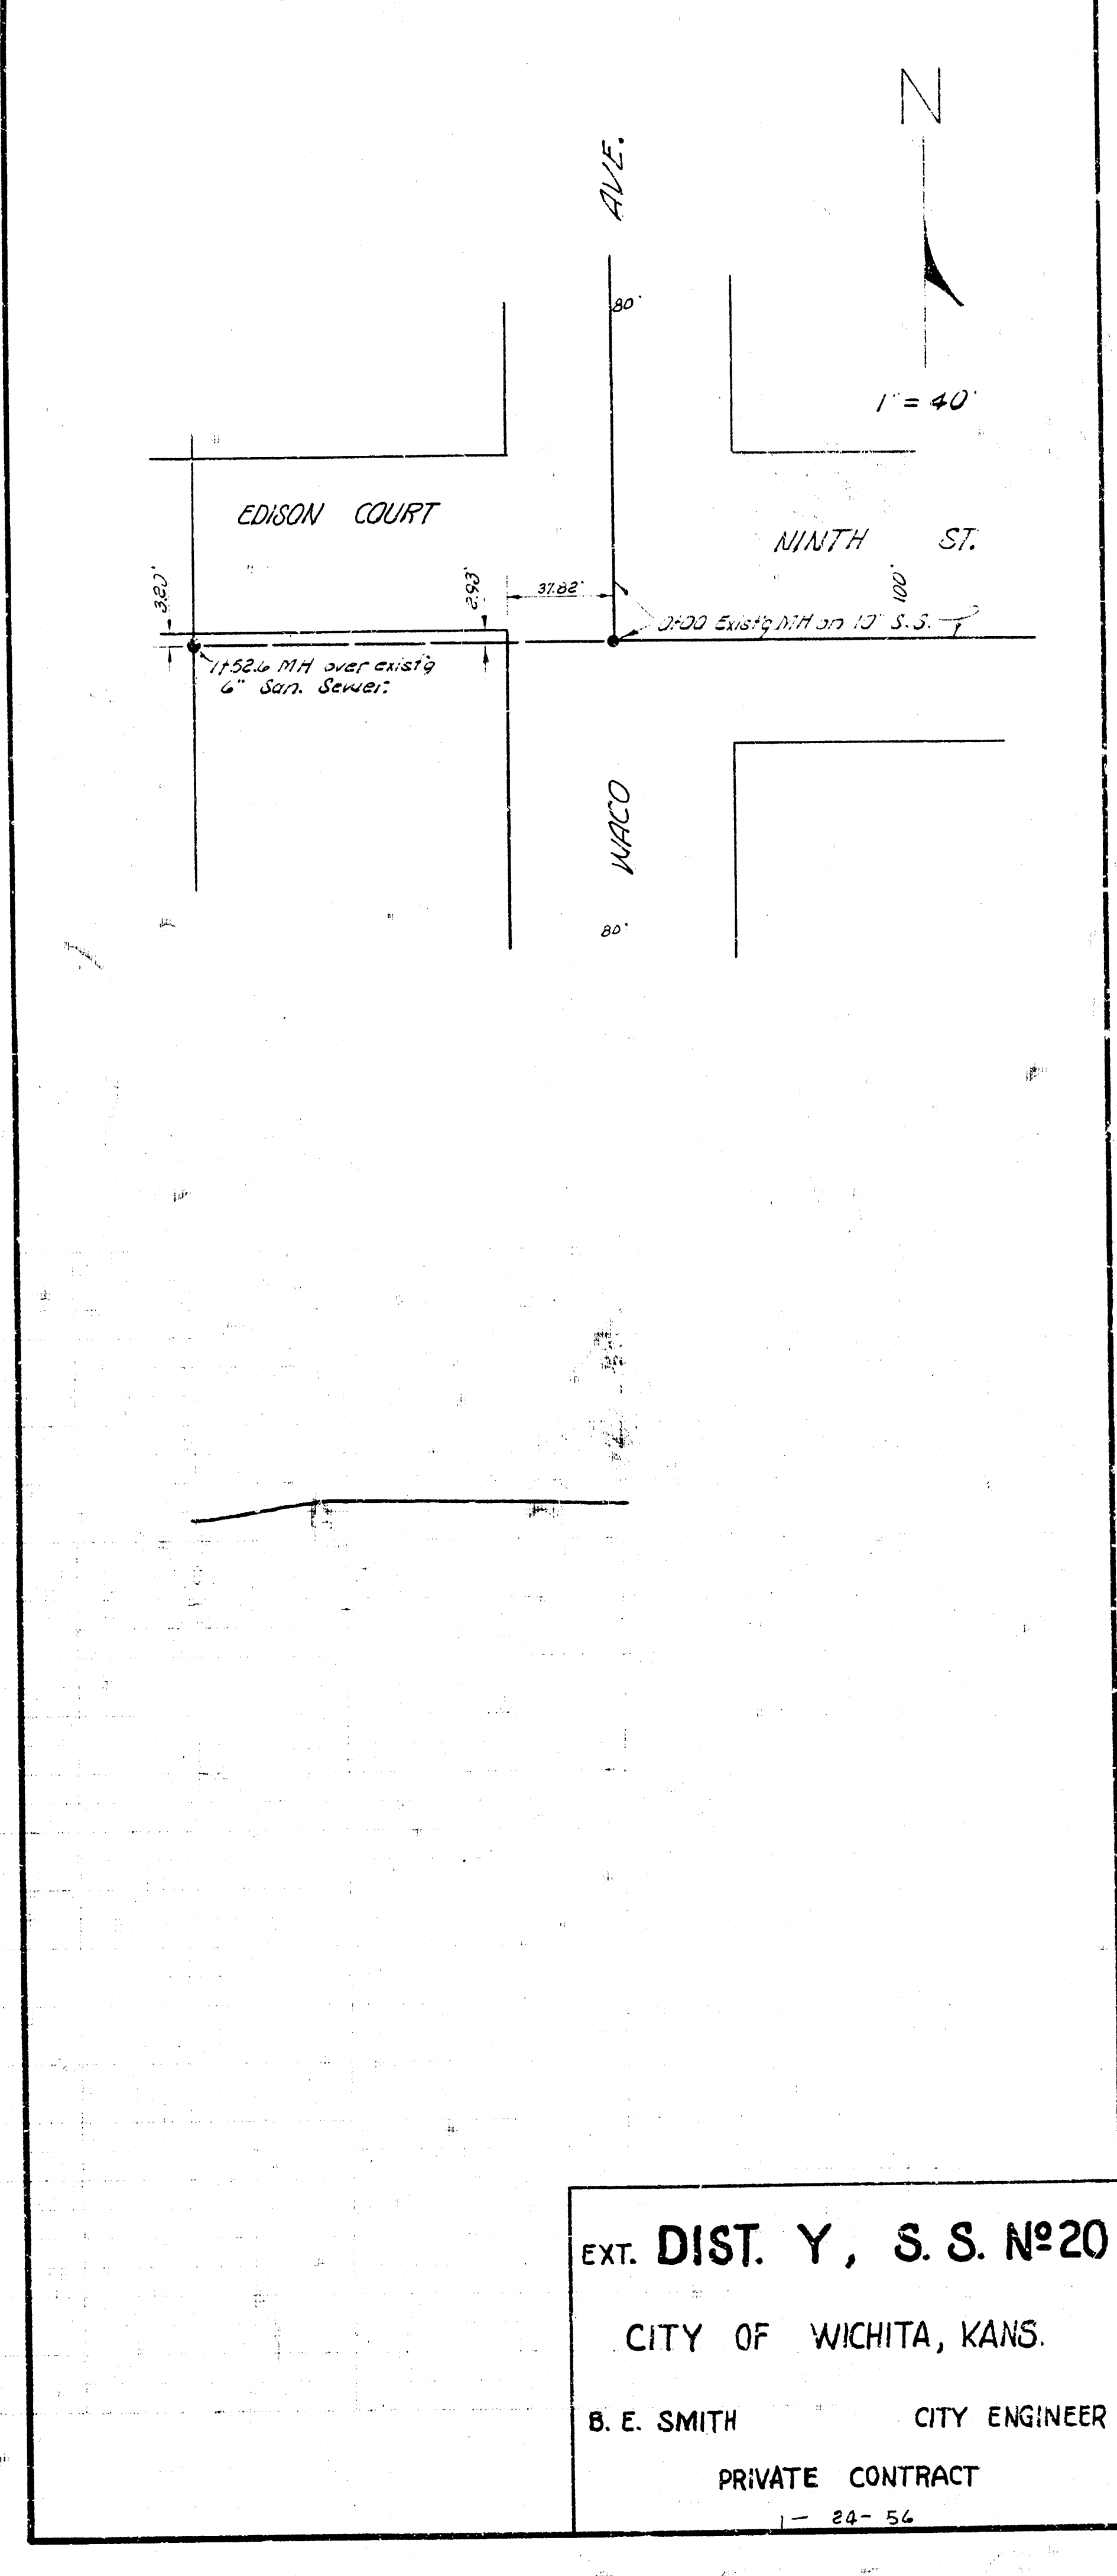

EXT. DIST. Y, S. S. N^o 20
CITY OF WICHITA, KANS.
B. E. SMITH CITY ENGINEER
PRIVATE CONTRACT
1-24-56