
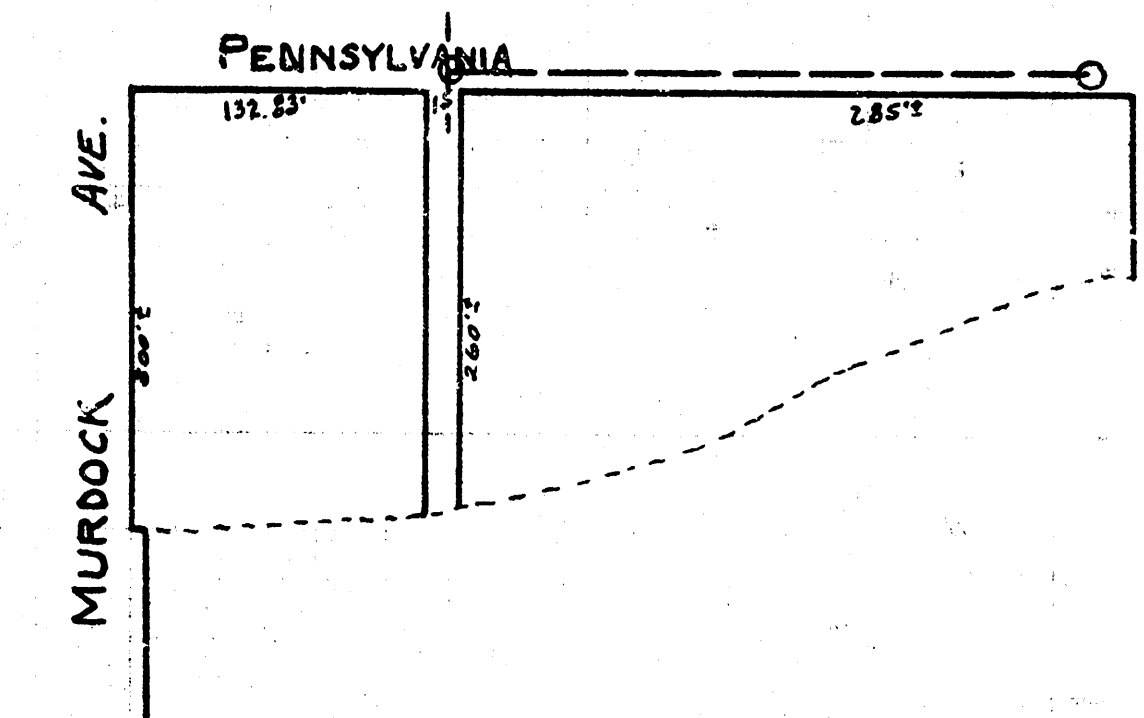
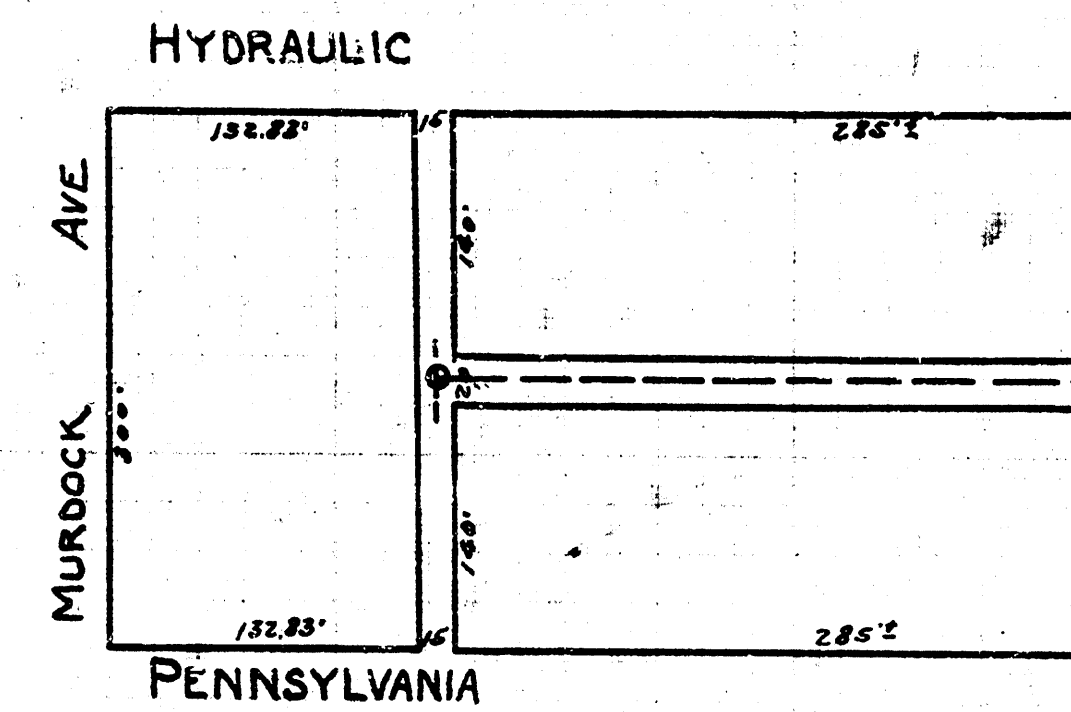
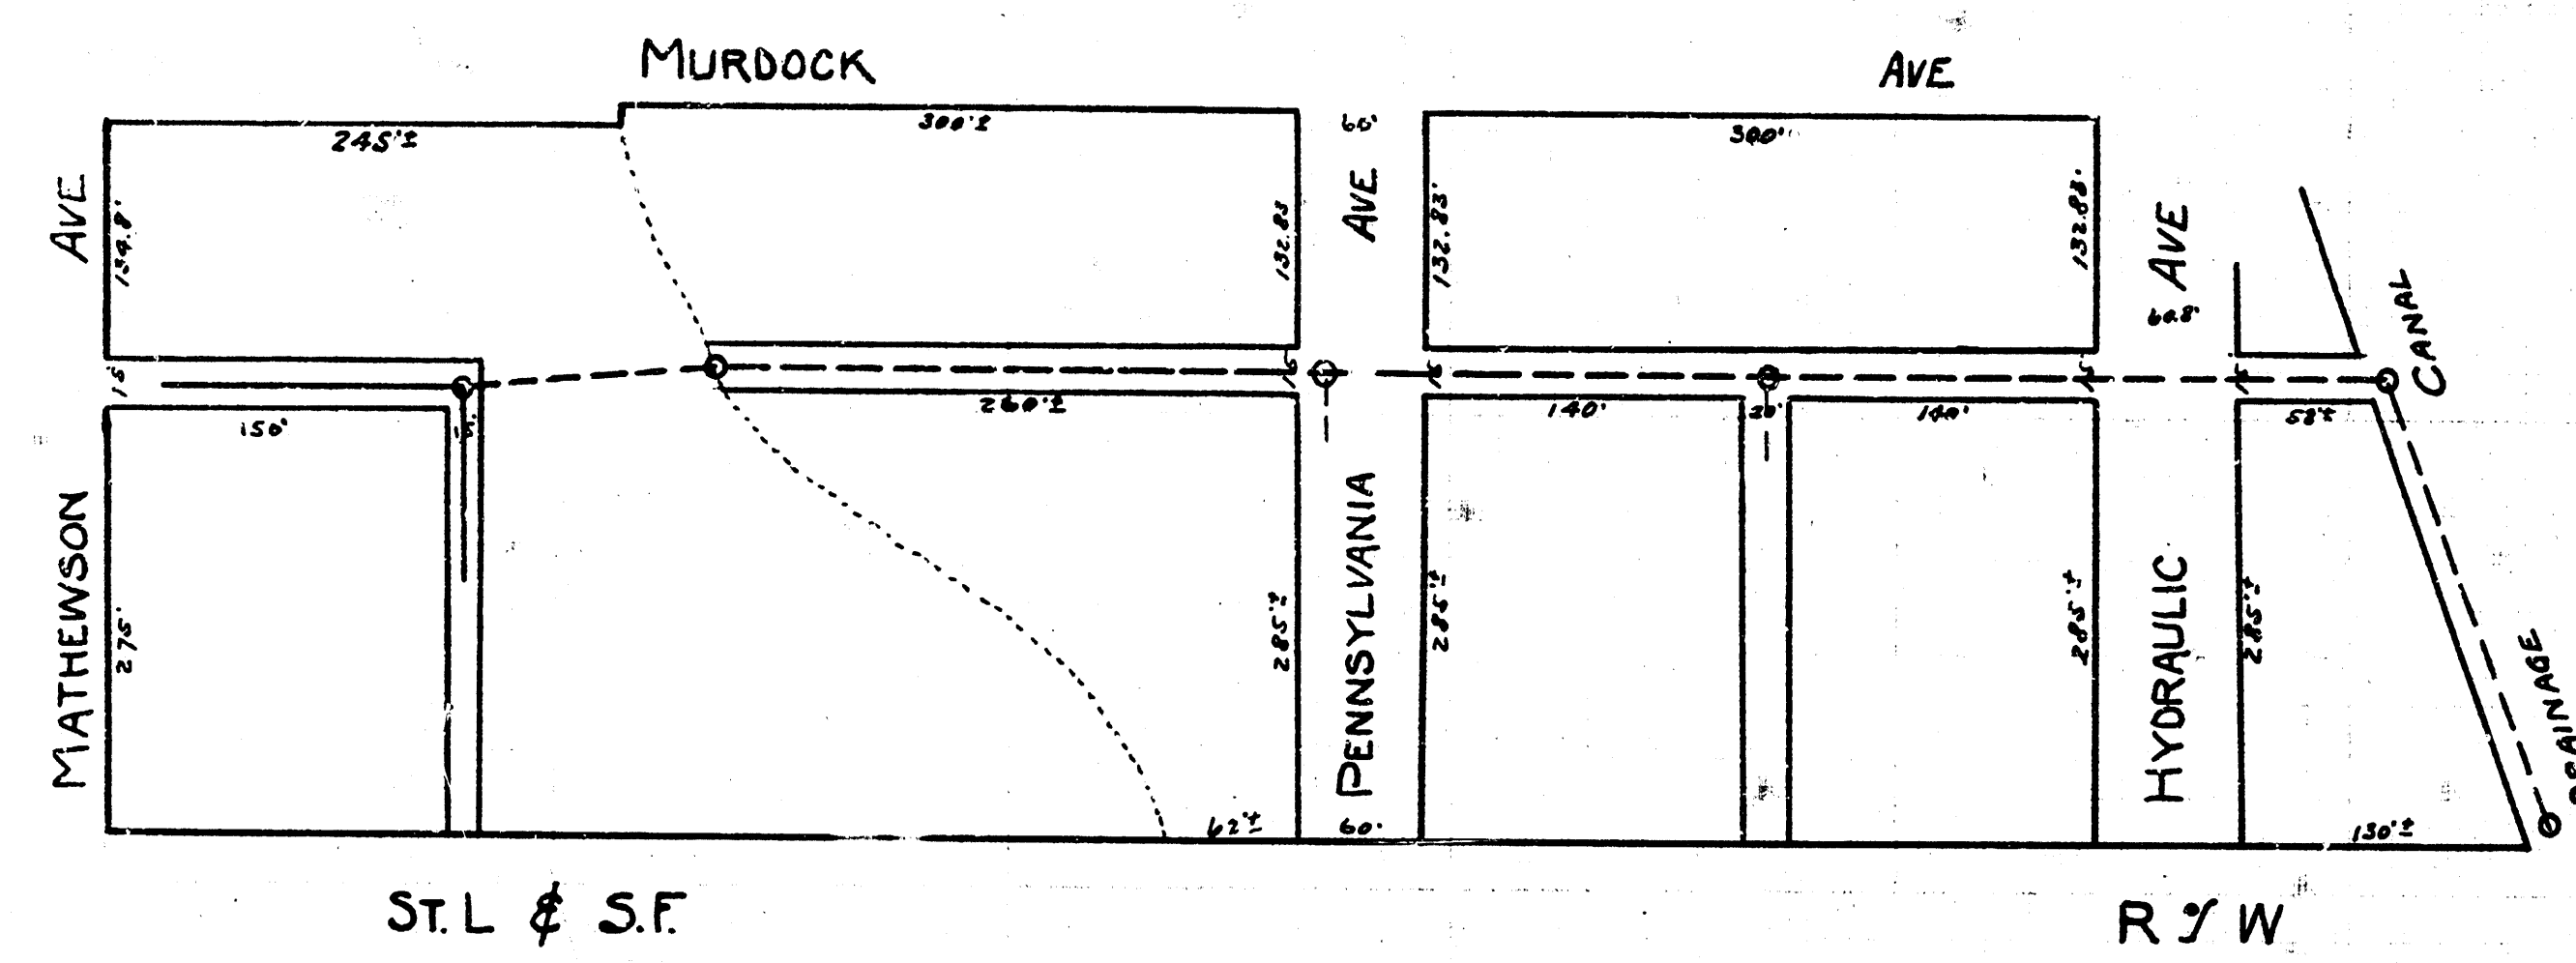
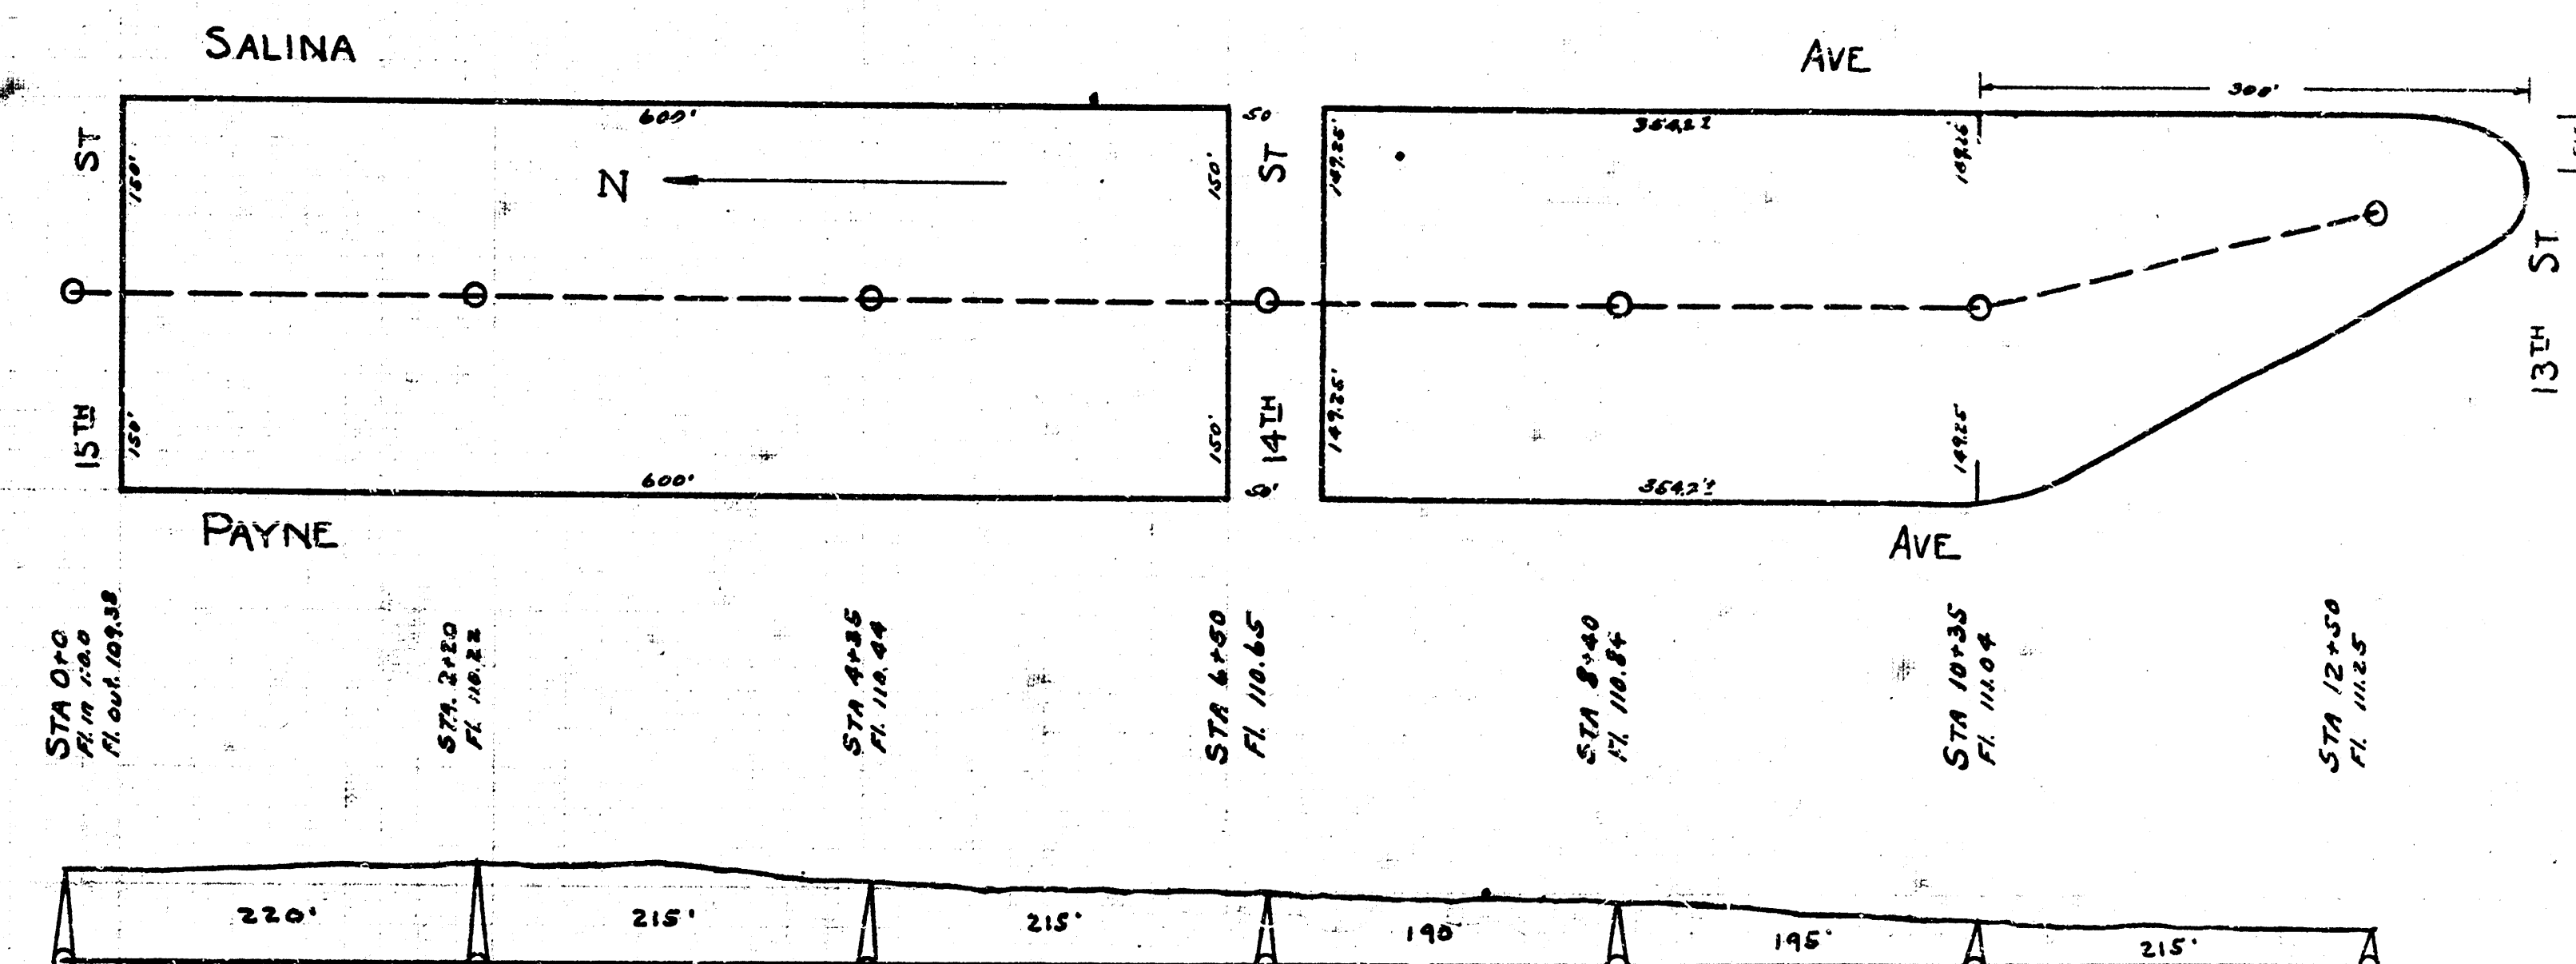


LAT 13, S.S. NO 20

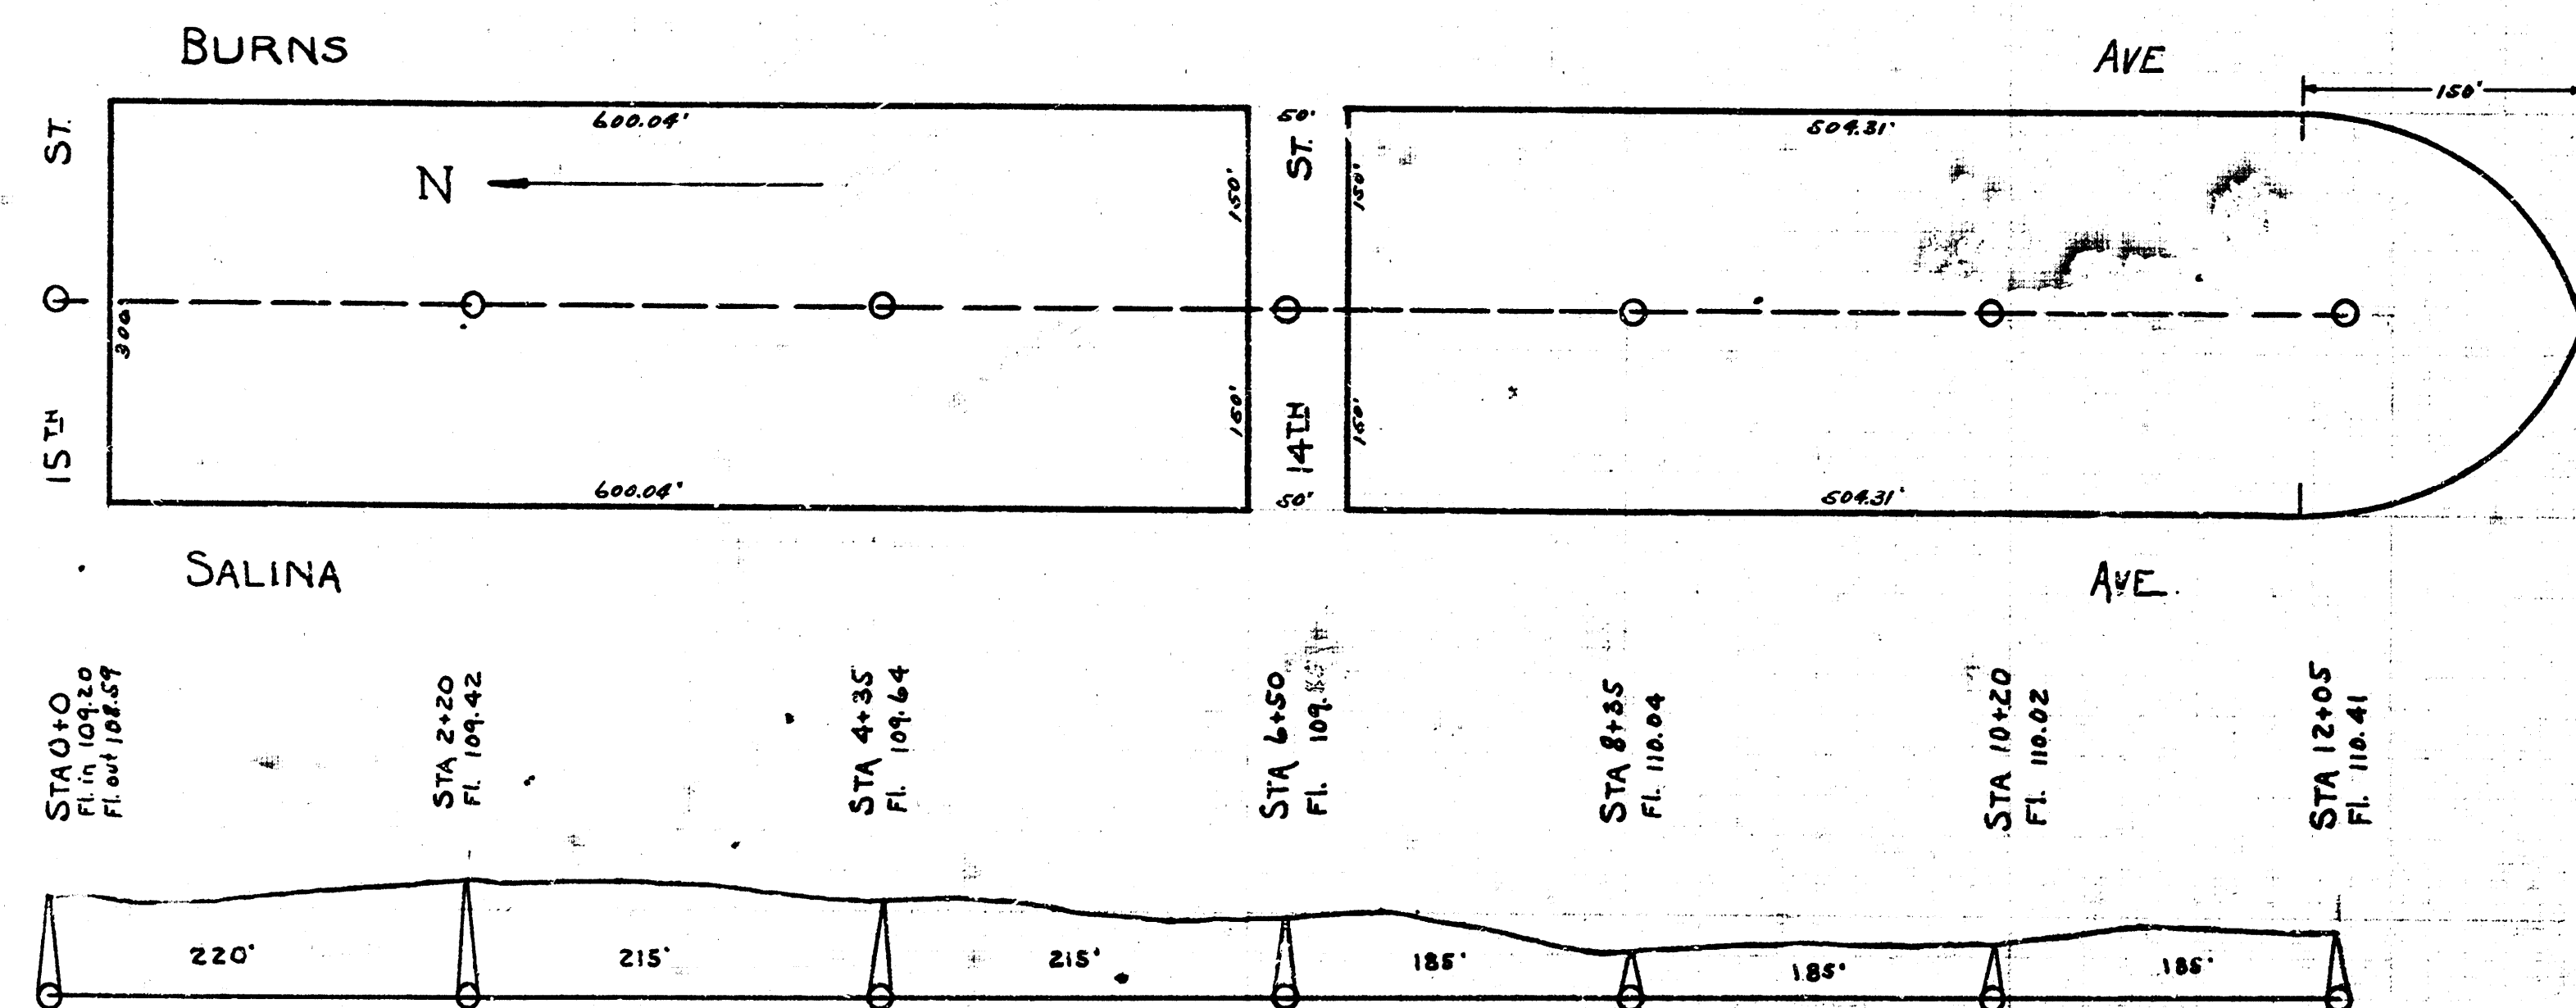

8" Line 1% Grade

LAT P, DIST. R, SS. NO 20

8" Line 1% Grade