

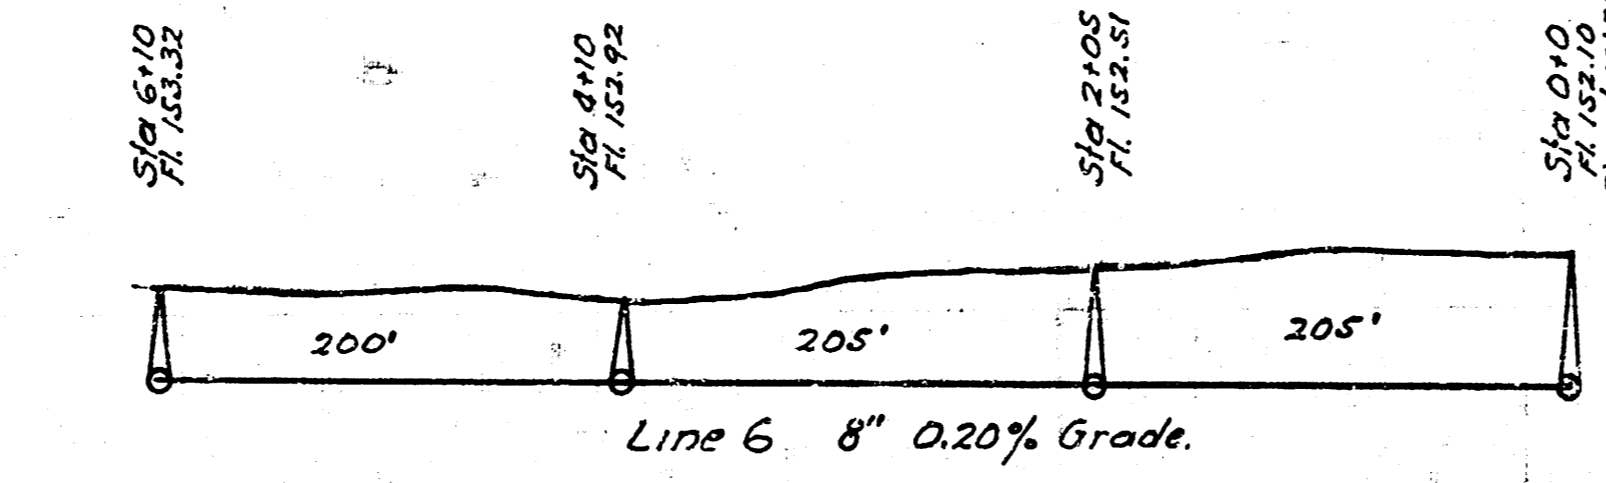
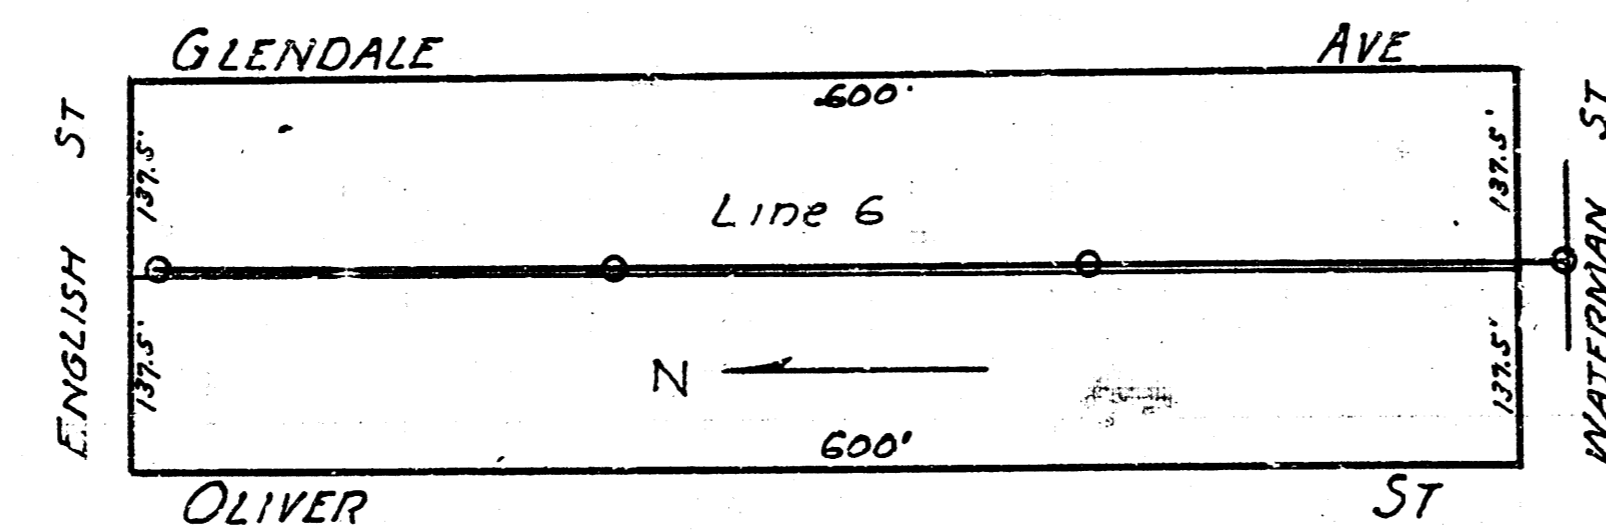
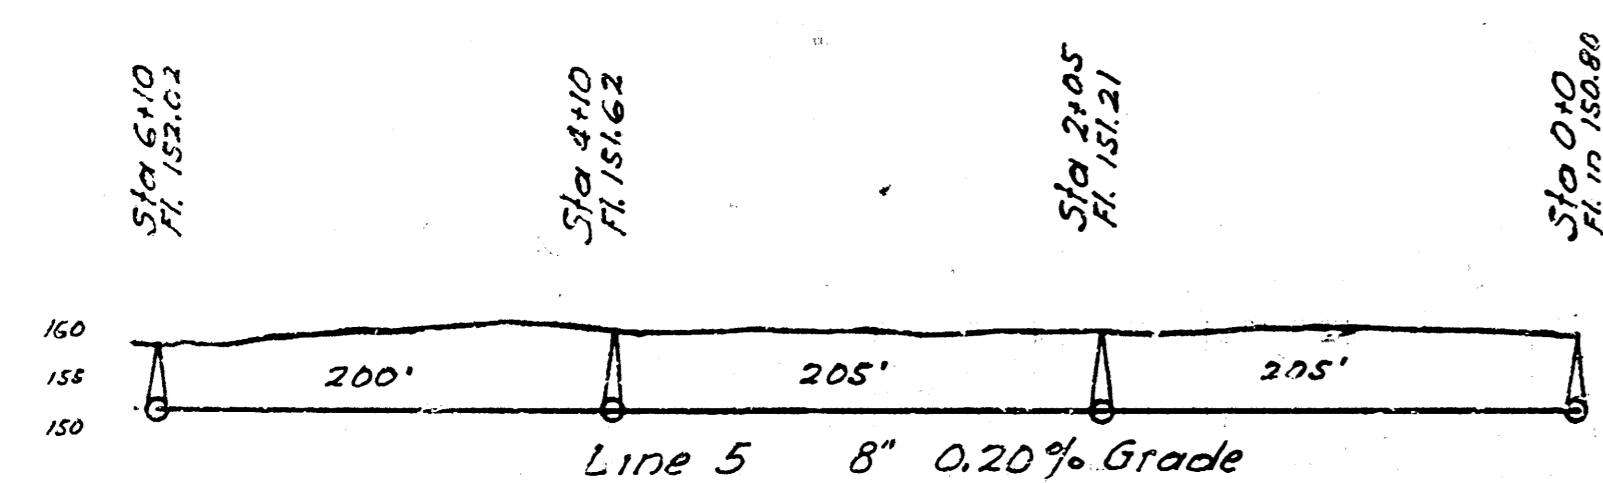
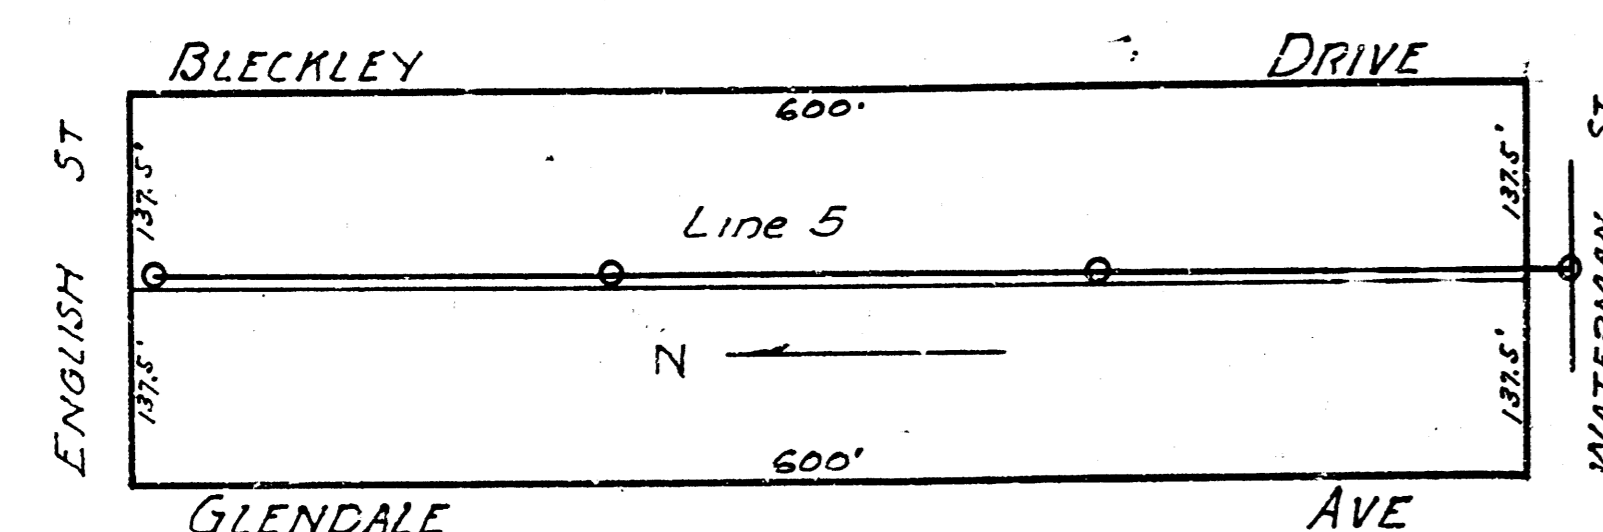
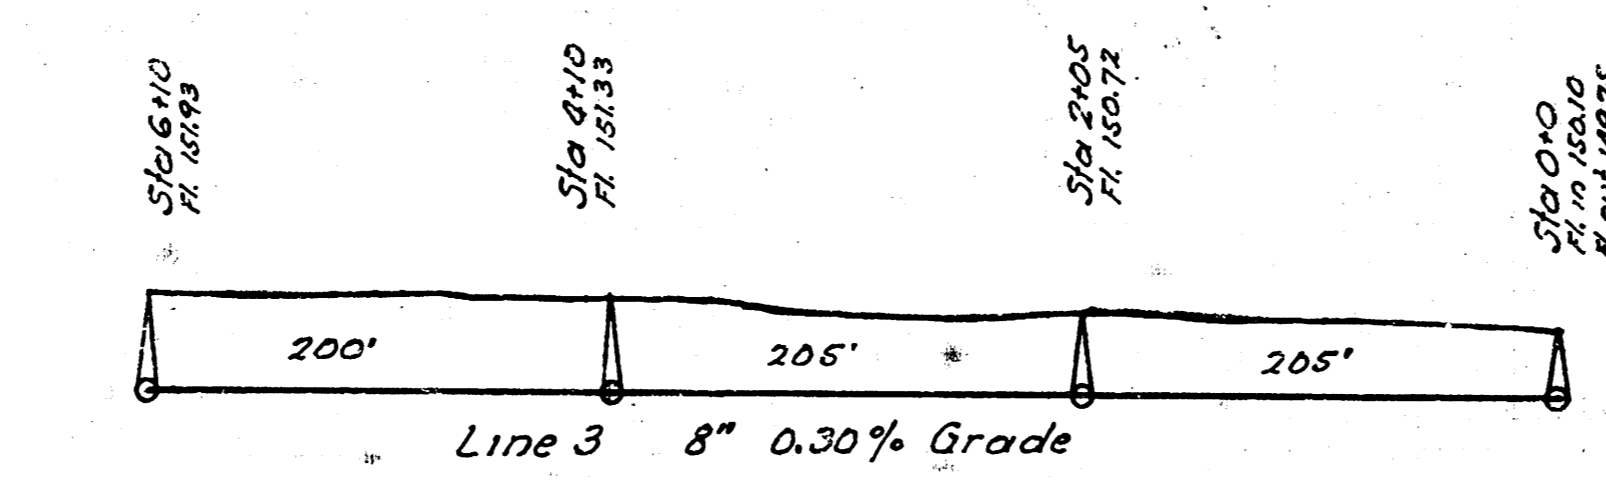
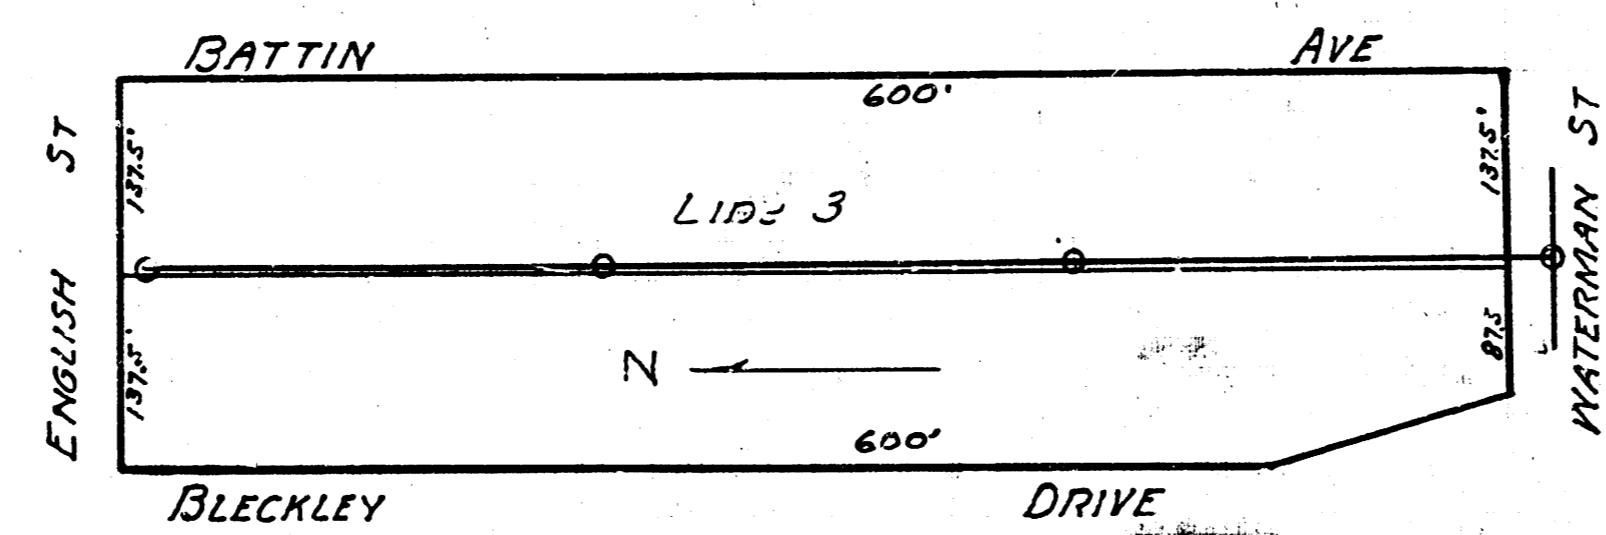
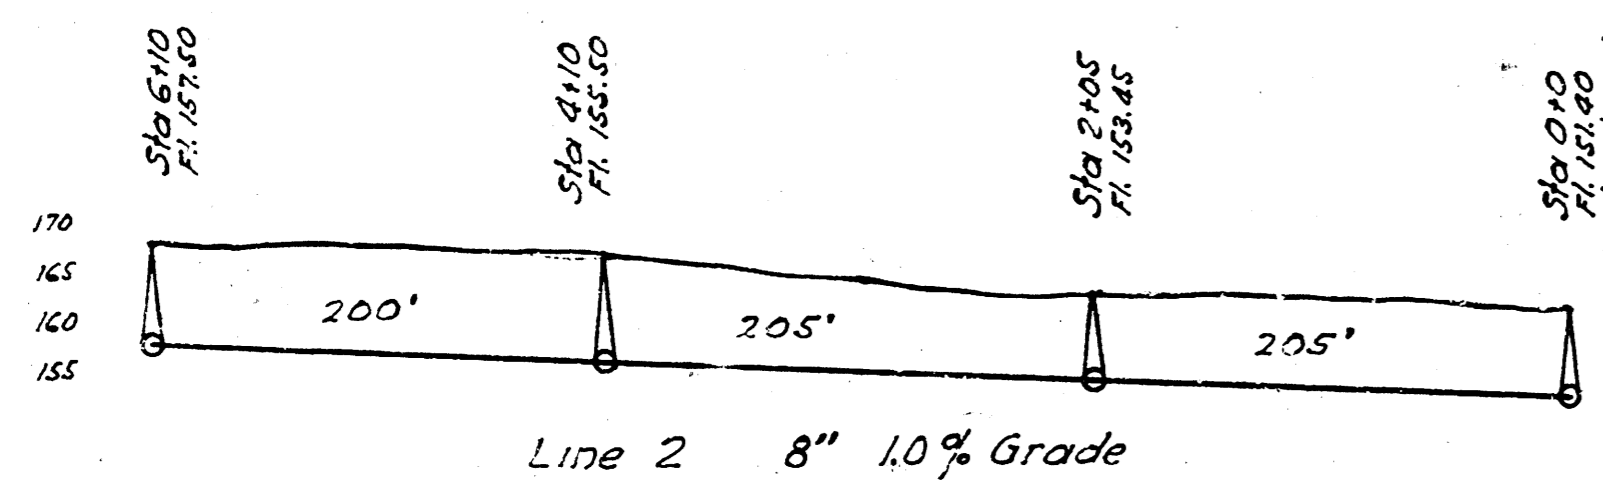
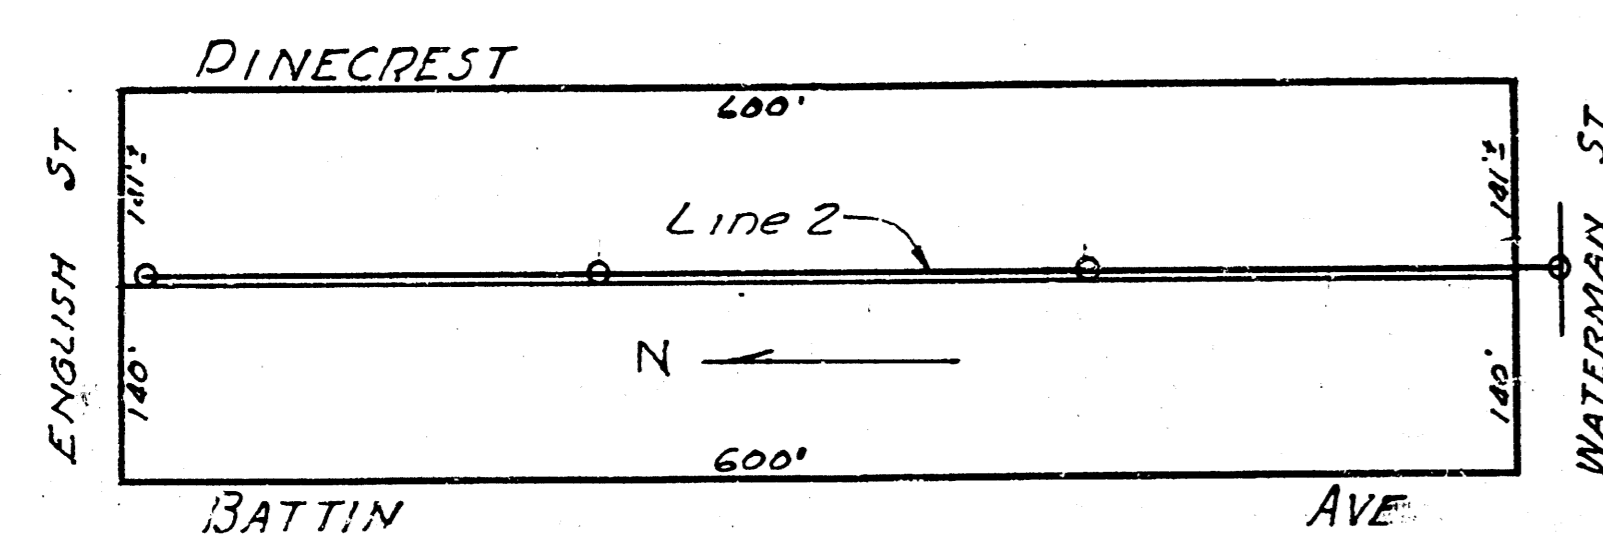
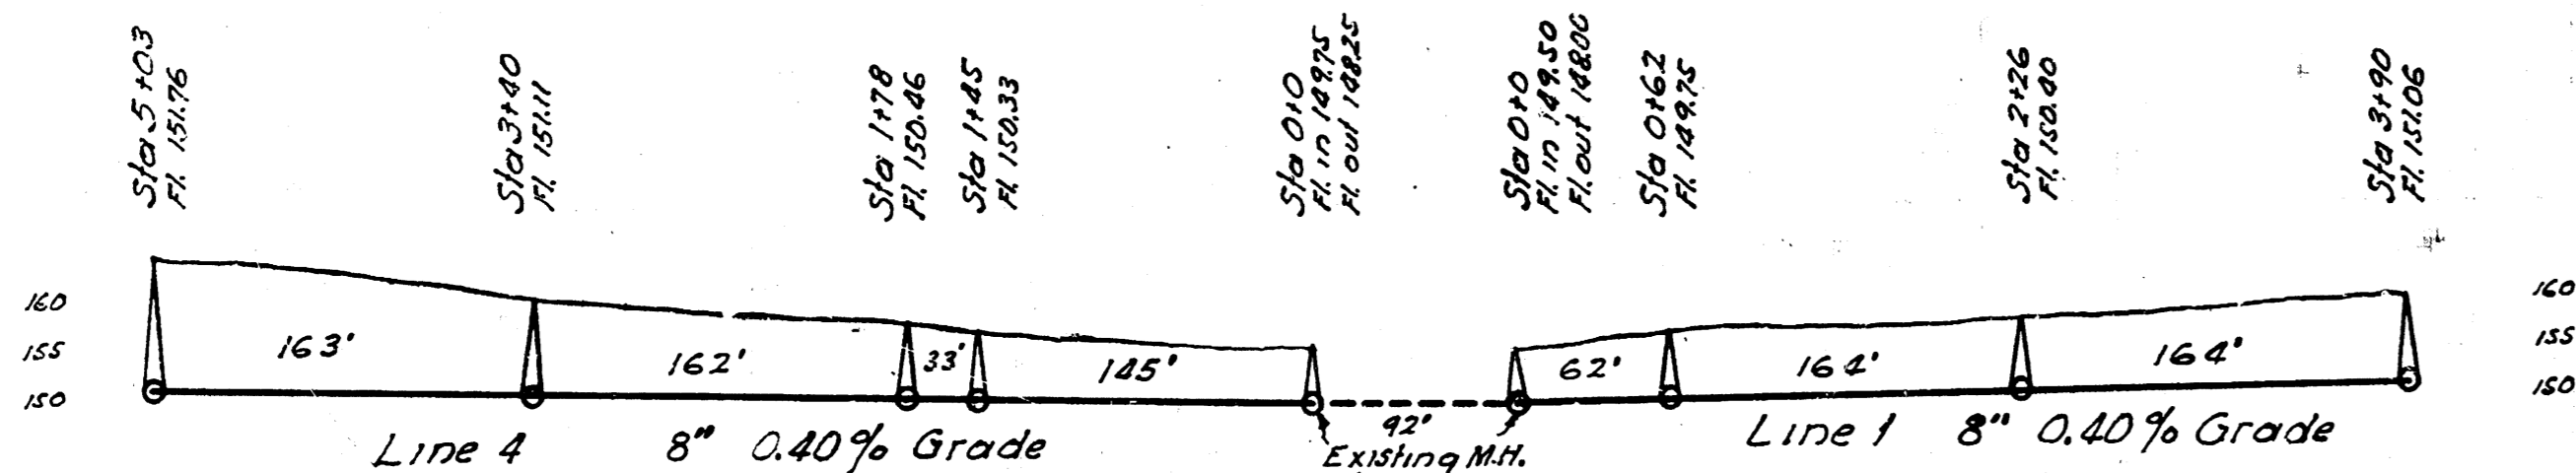
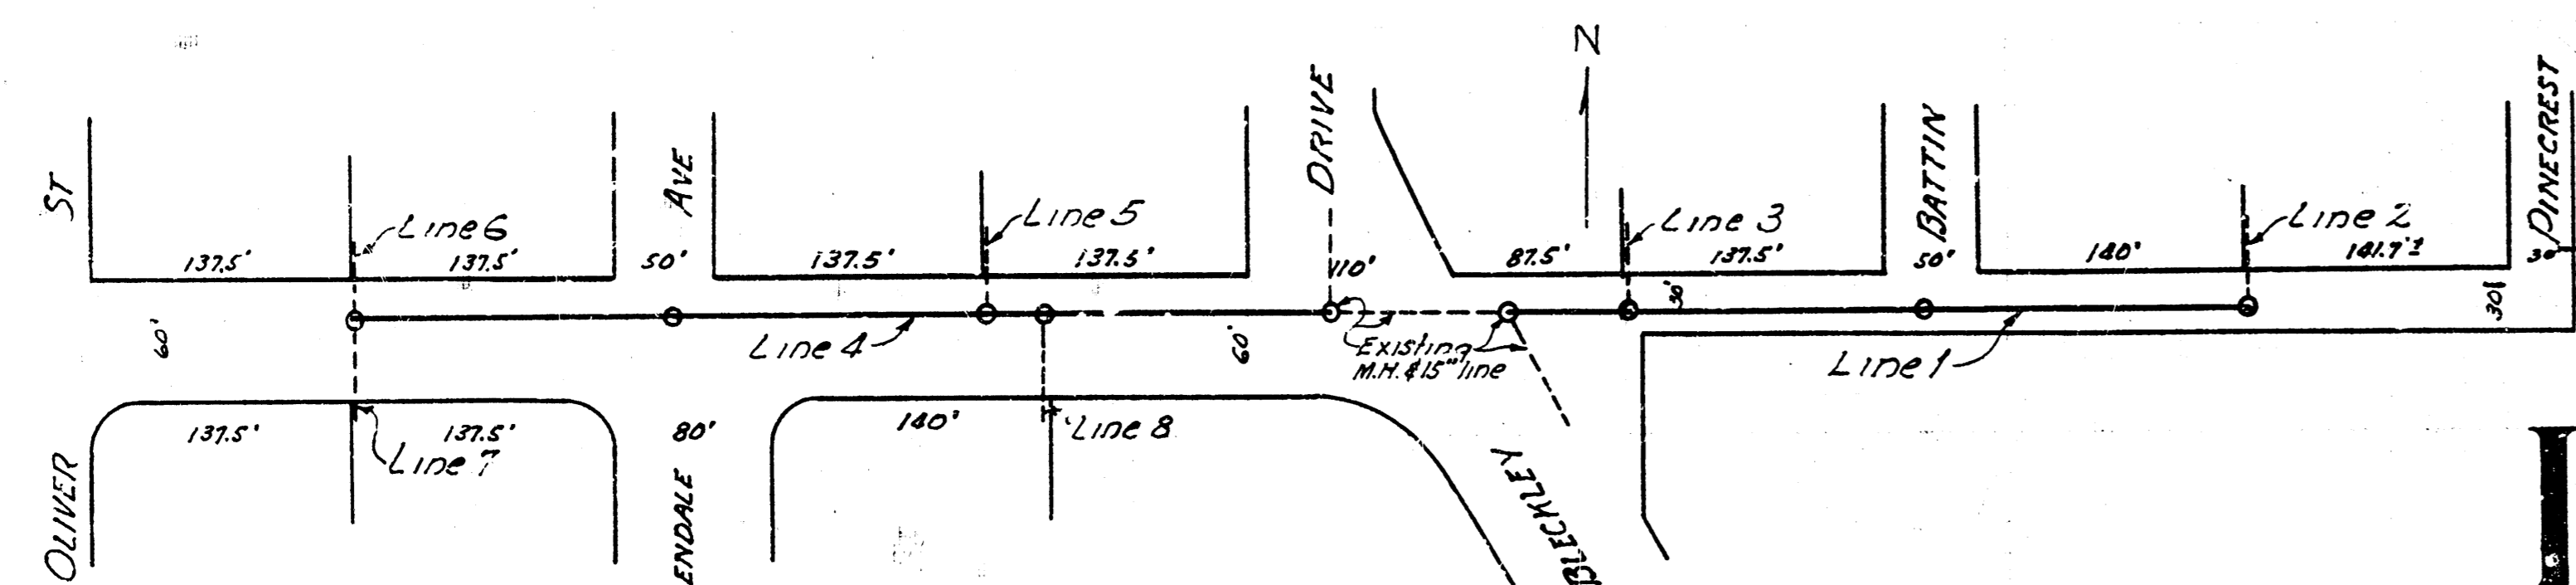
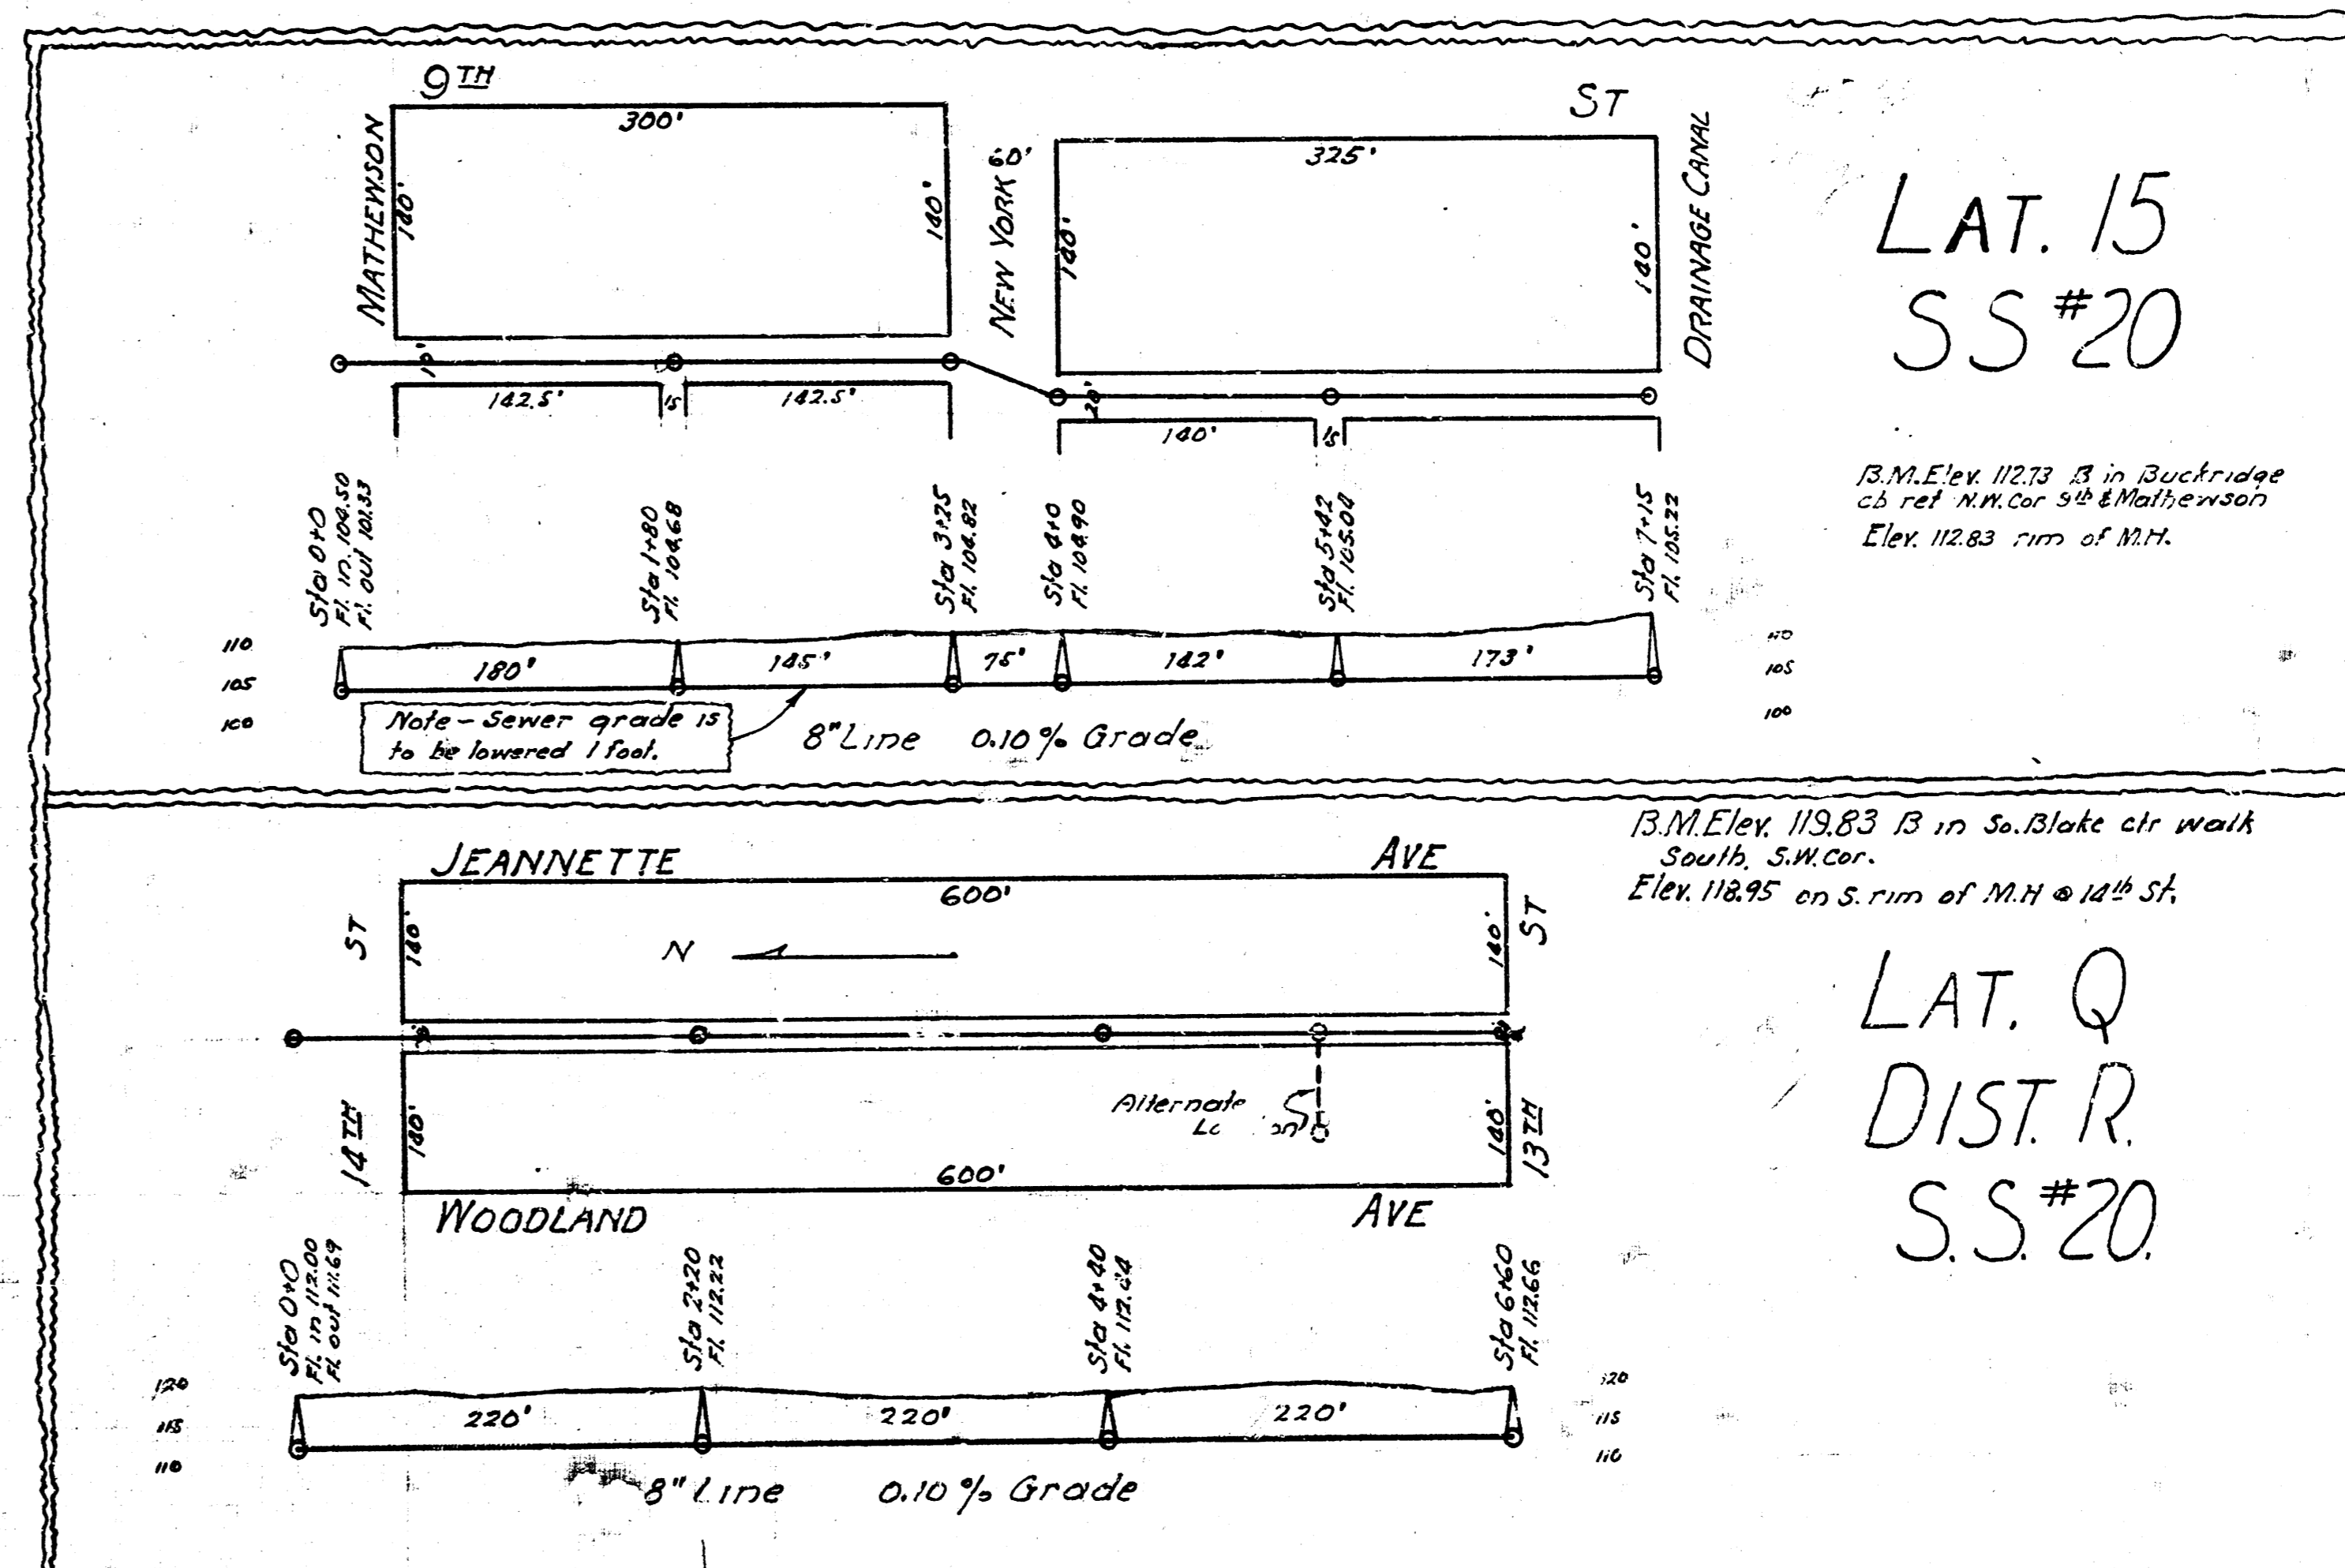
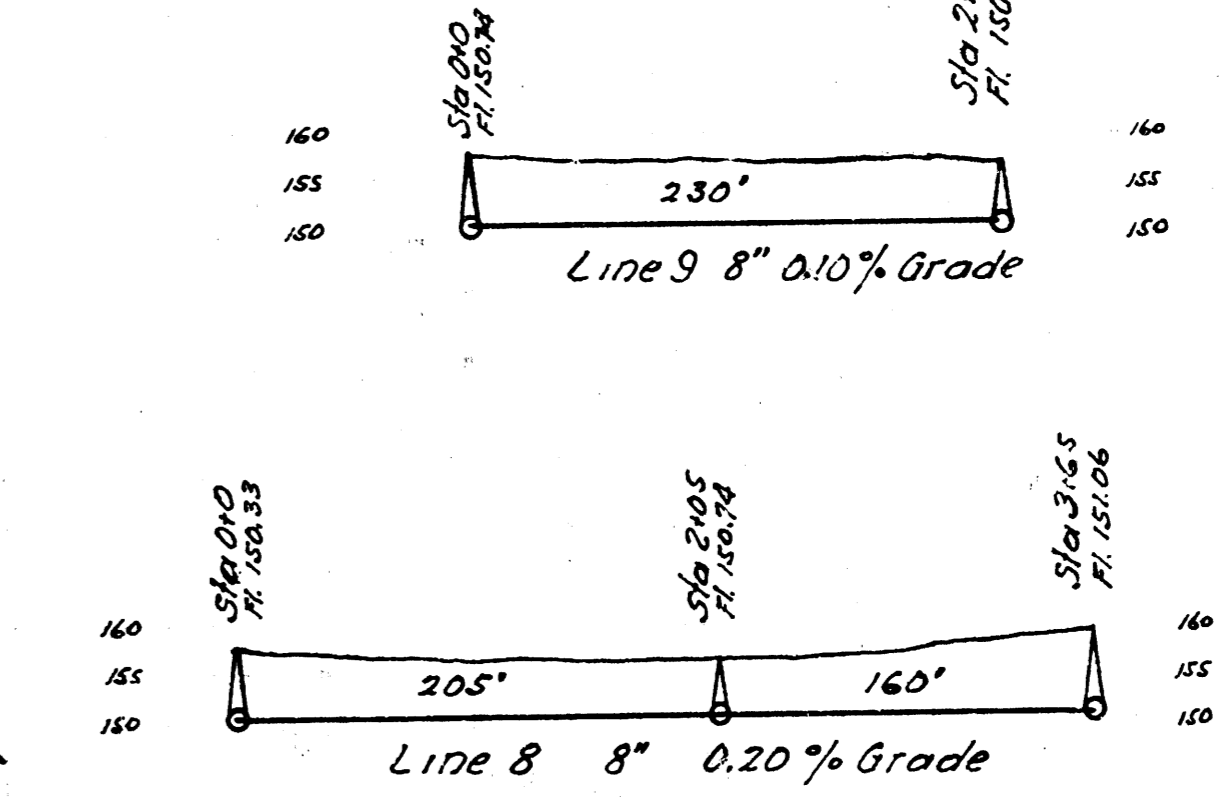


LAT. M DIST. # 6 S.S. # 12

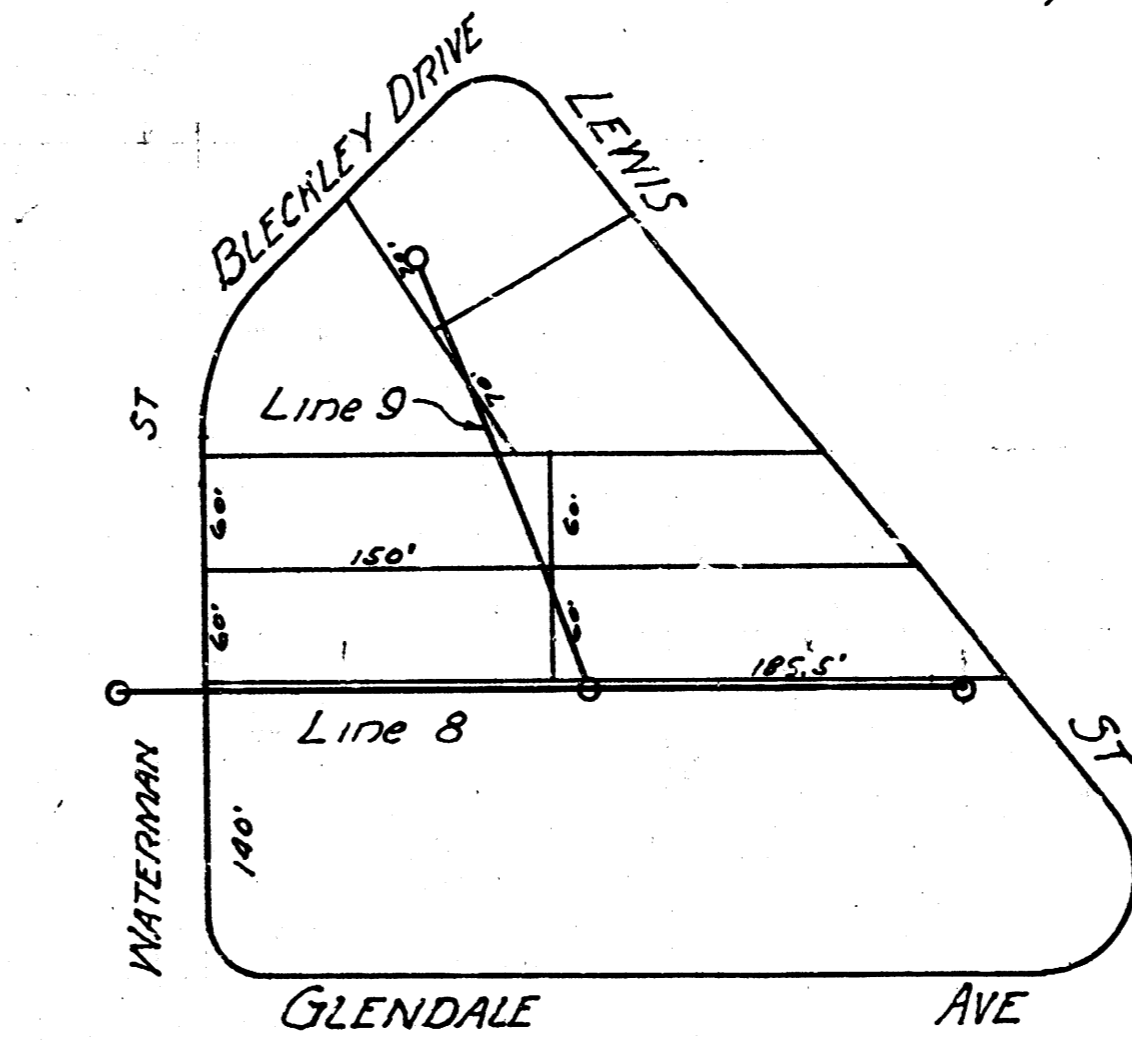

B.M. Elev. 156.07 Top of Man N.W. Cor. Waterman & Bleckley Drive.
162.67 Iron end of radius W. S.W. Glendale & Waterman

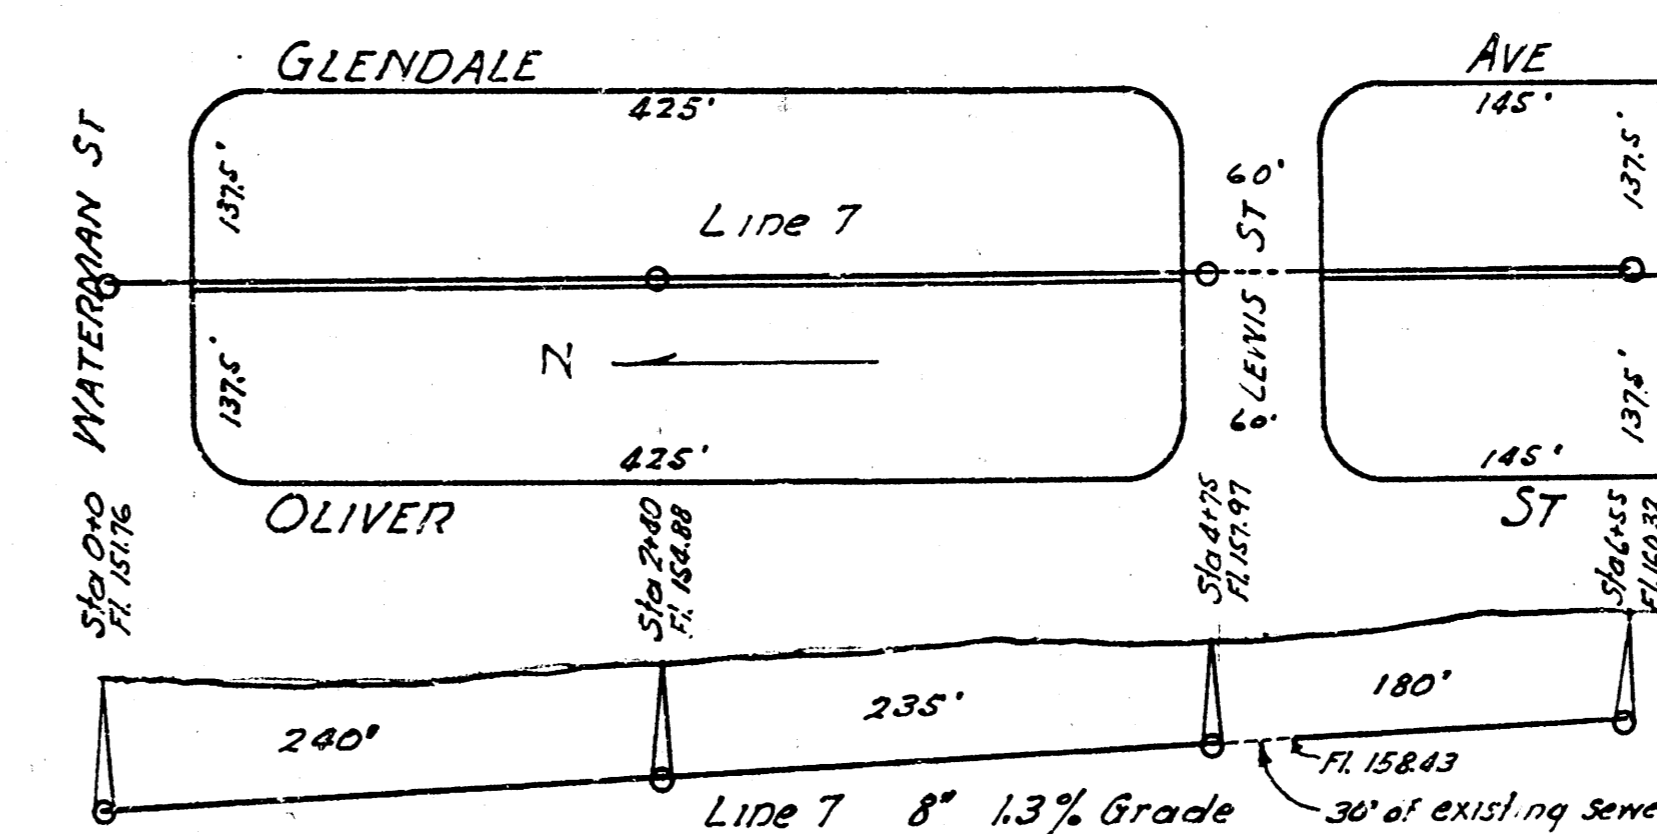

LAT. 15 SS #20

LAT. Q DIST. R. S.S. #20

B.M. Elev. 112.73 B in Buckridge
C.S. 1st N.W. Cor. 5th & Mathewson
Elev. 112.83 rim of M.H.

B.M. Elev. 119.83 B in So. Blake ctr walk
South, S.W. Cor.
Elev. 116.95 on S. rim of M.H. @ 14th St.