

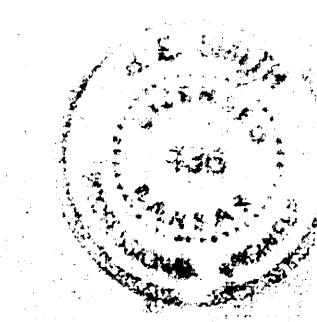


ADDITION TO SUBMAIN R SAN. SEWER 20
 CITY OF WICHITA, KANSAS
 B.E. SMITH CITY ENGINEER
 PROJECT NO. C21-69


REVISIONS TO THIS PLAN
 NO. 1 - 12-14-59
 NO. 2 - 1-15-60
 NO. 3 - 1-15-60
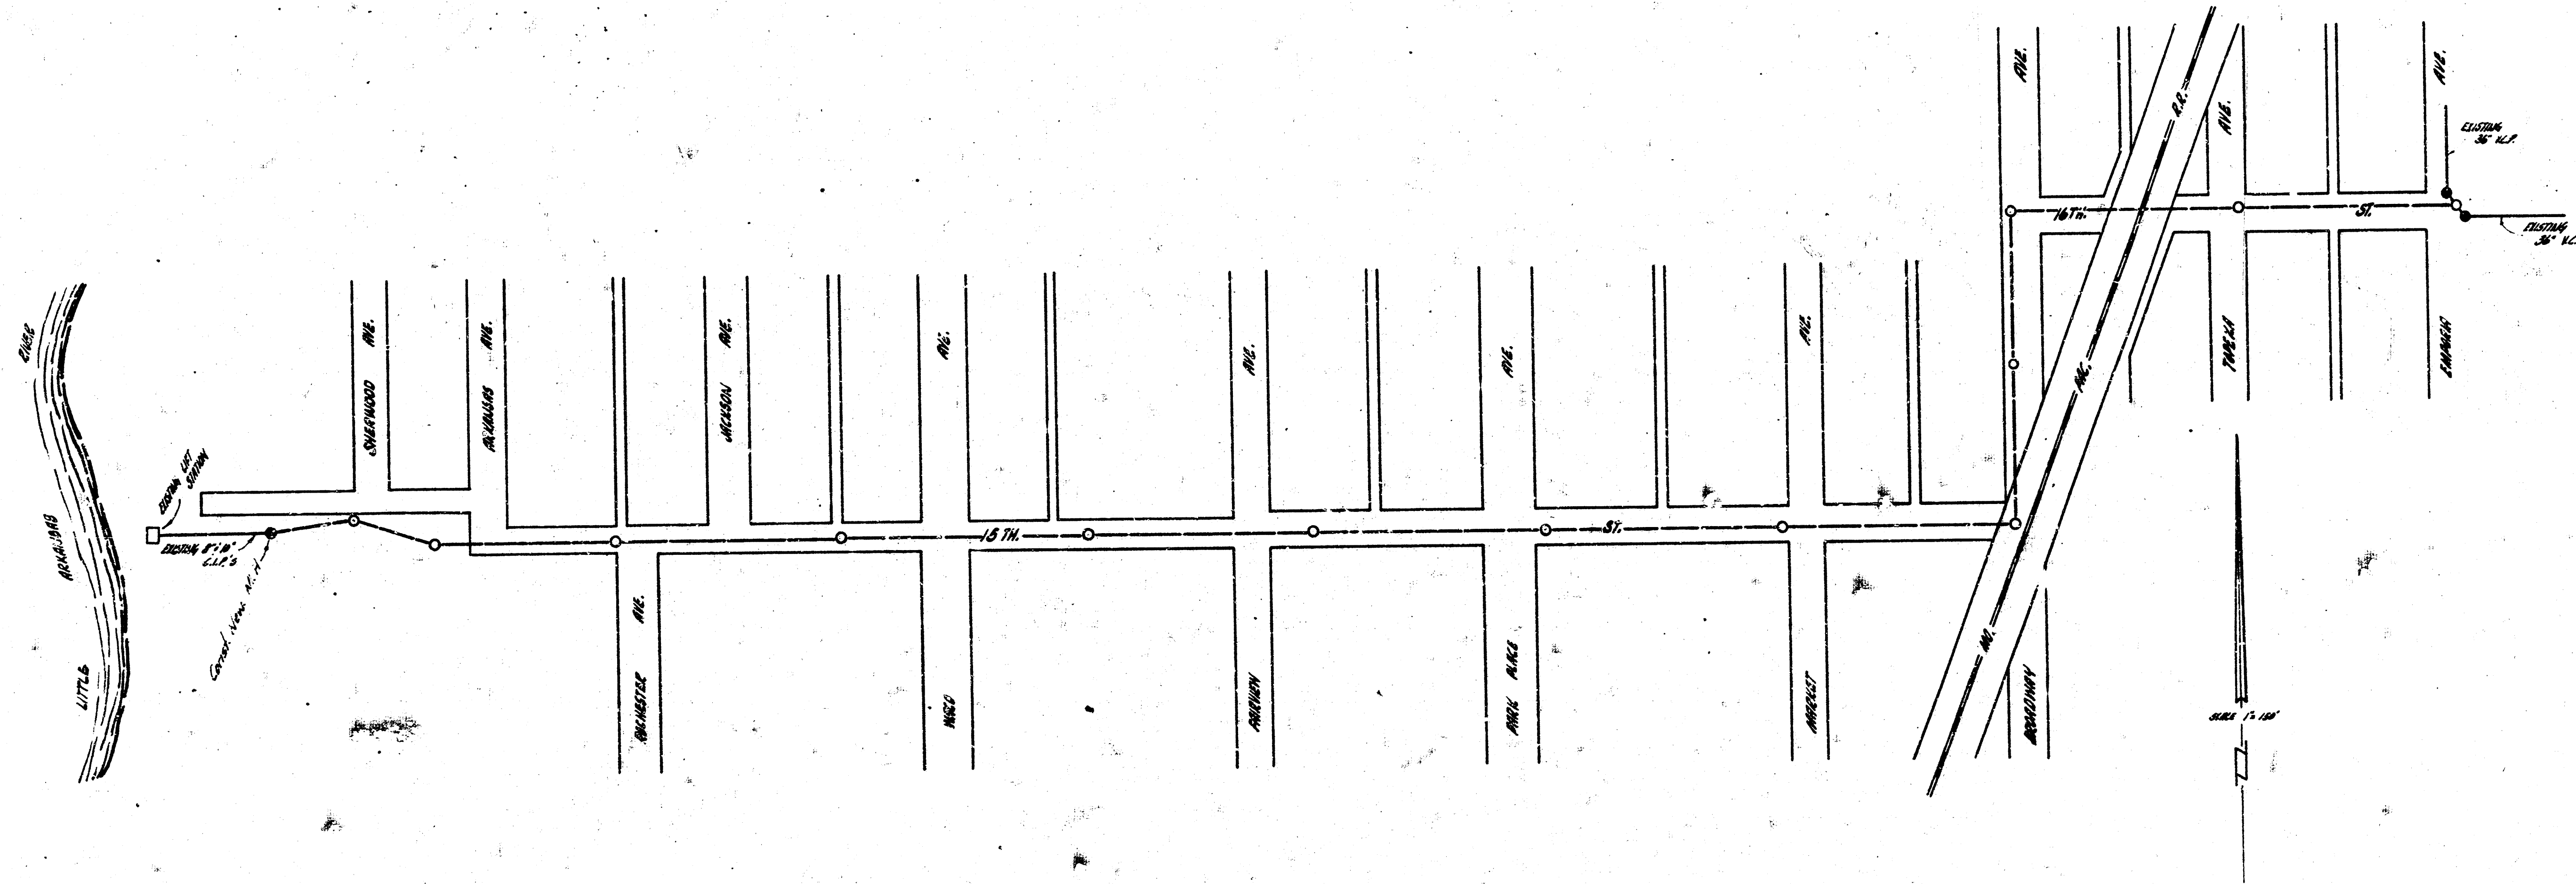


B.E. Smith
 City Engineer

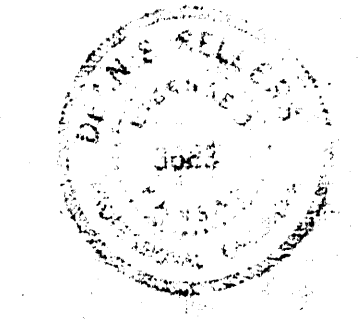


1/6 ADDITION TO SUBMAIN R SAN. SEWER 20
 PROJECT NO. C21-69 12-14-59

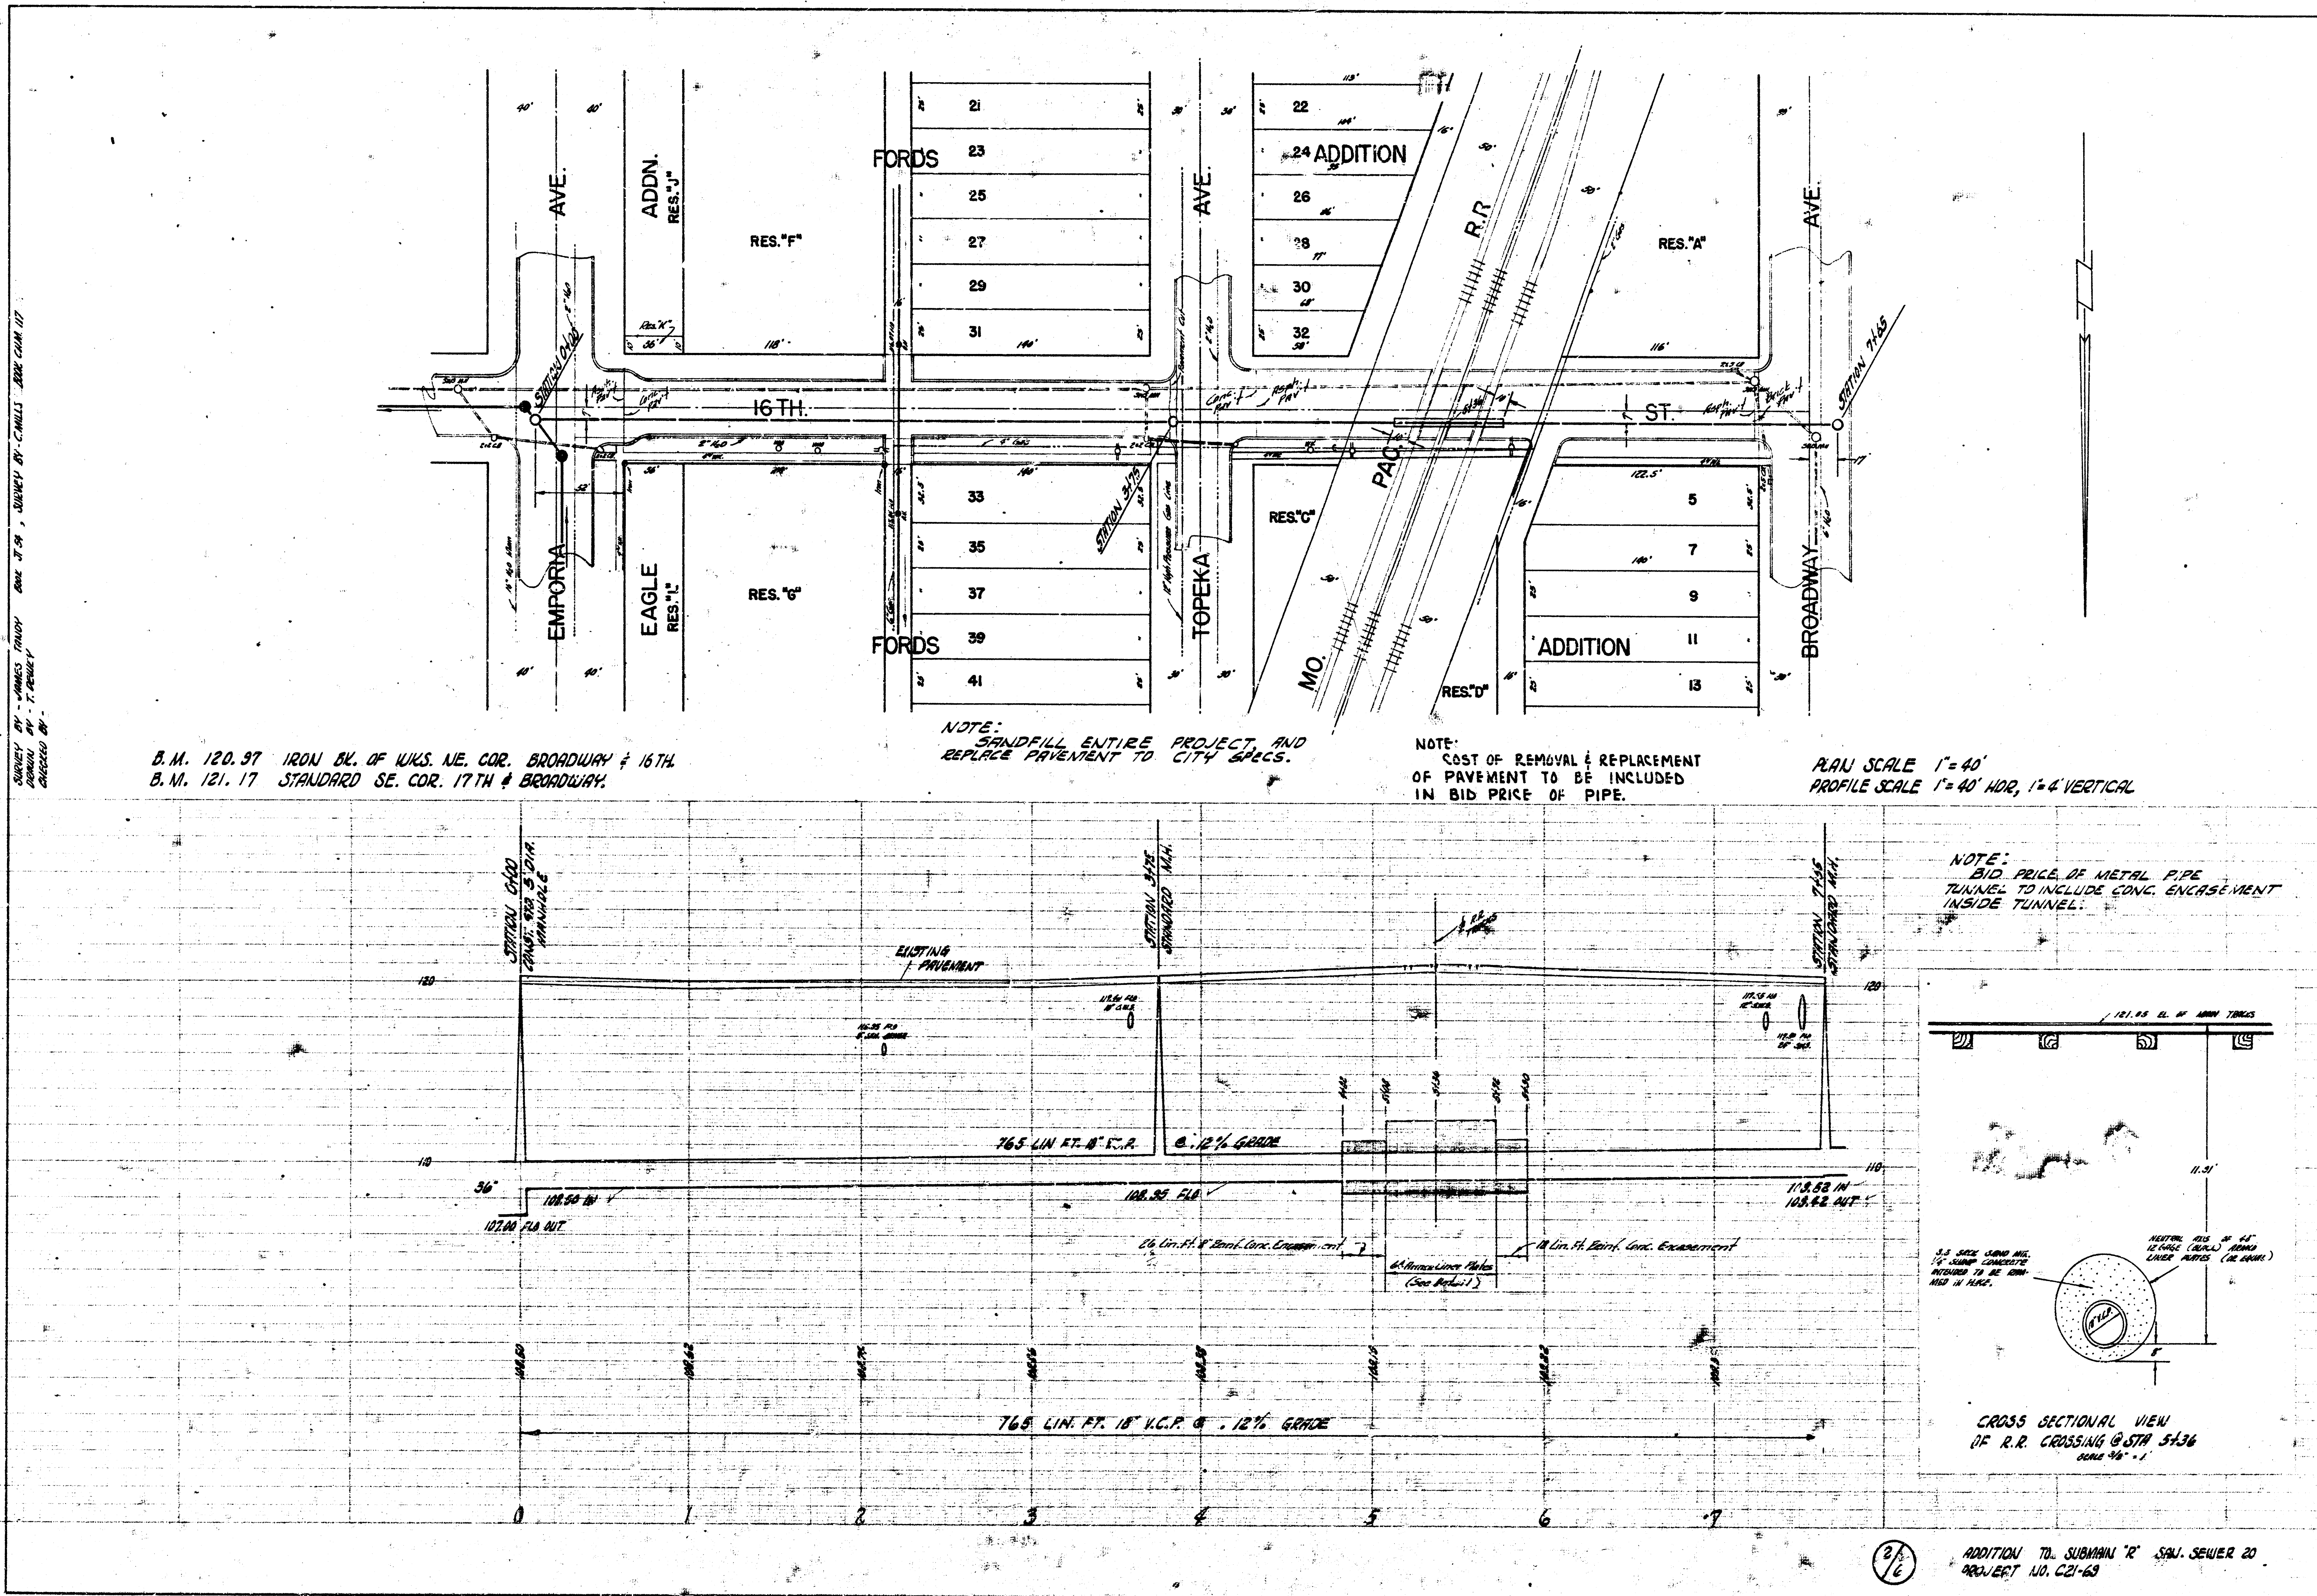

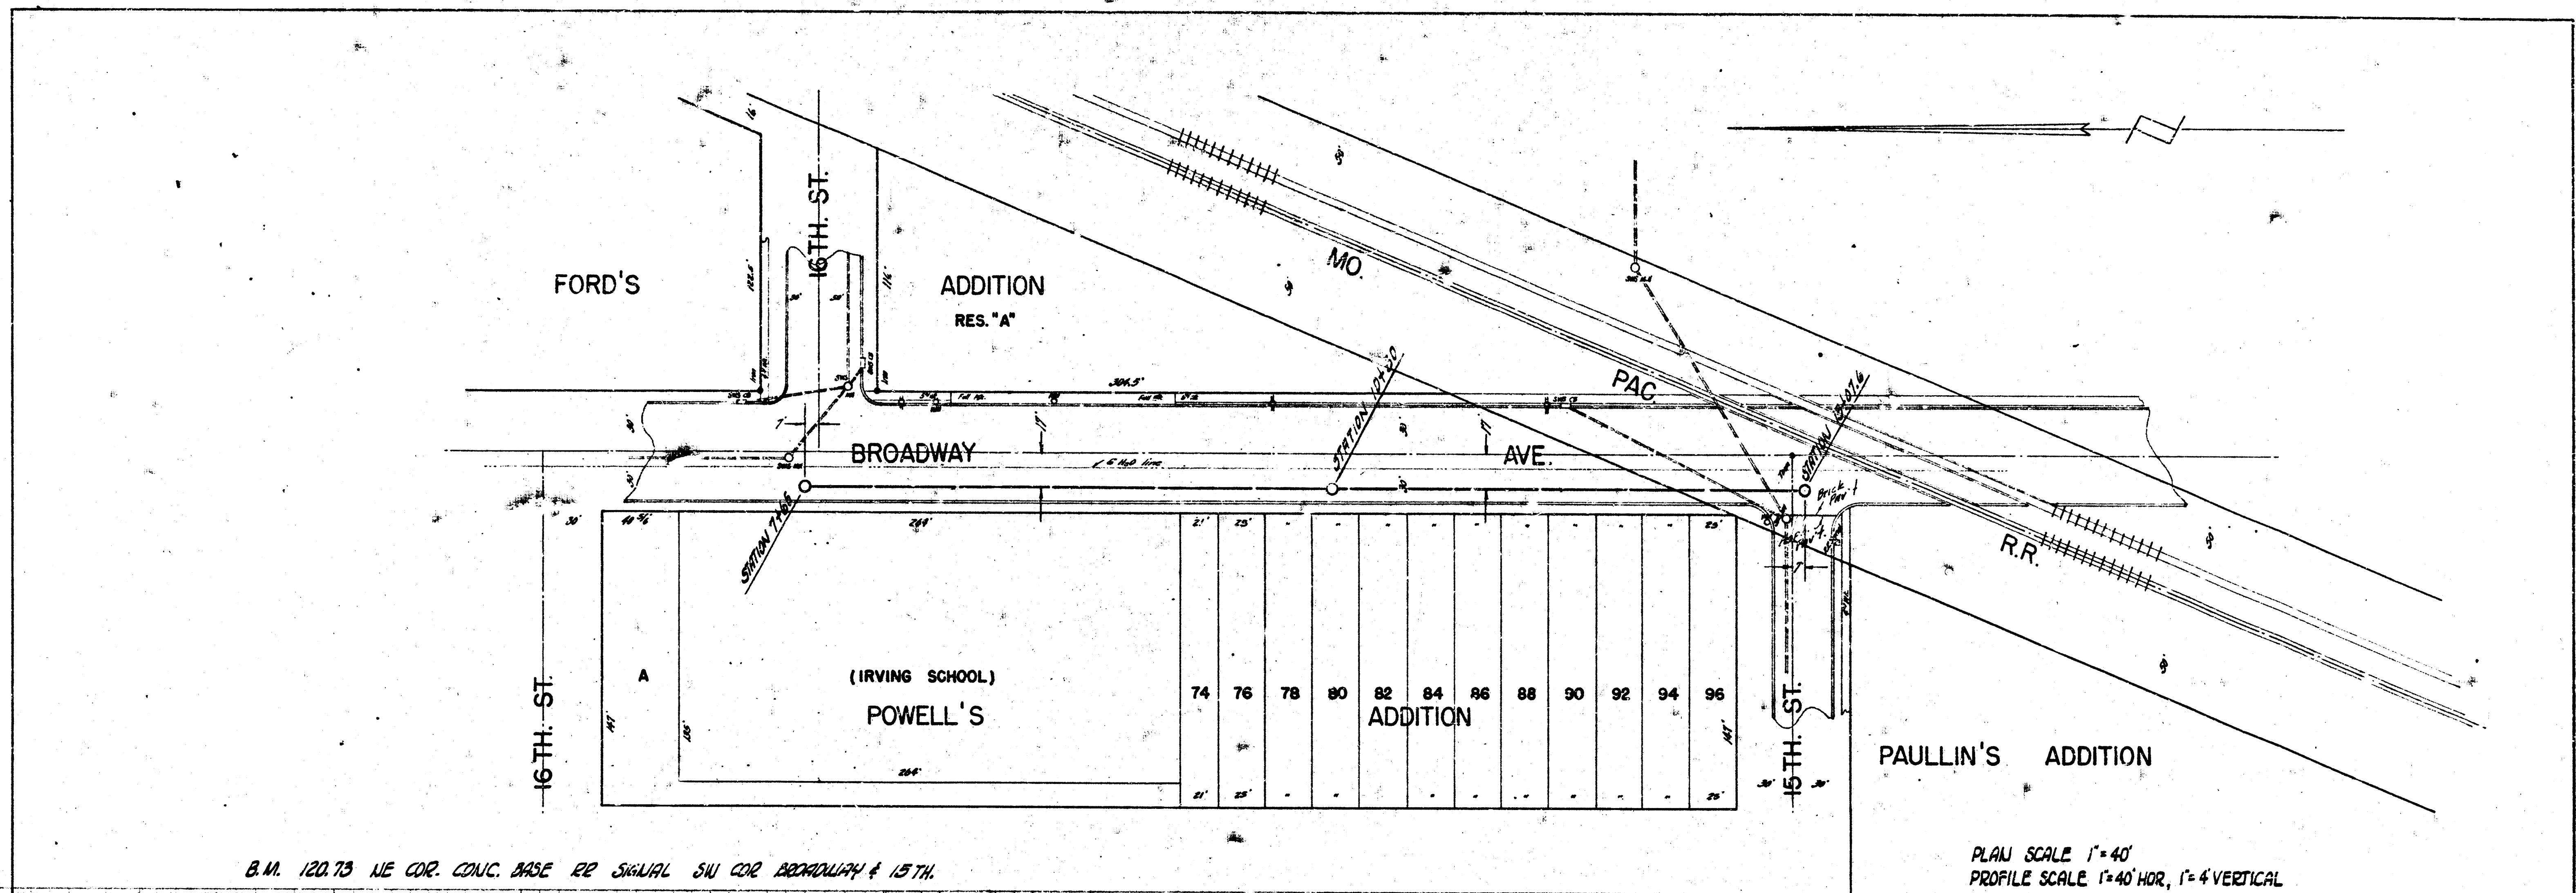


B.M. 120.73 NE COR. CONC. BASE RD. SIGNAL SW COR. BROADWAY & 15TH.

PLAN SCALE 1"=40'
PROFILE SCALE 1"=40' HOR, 1"=4' VERTICAL

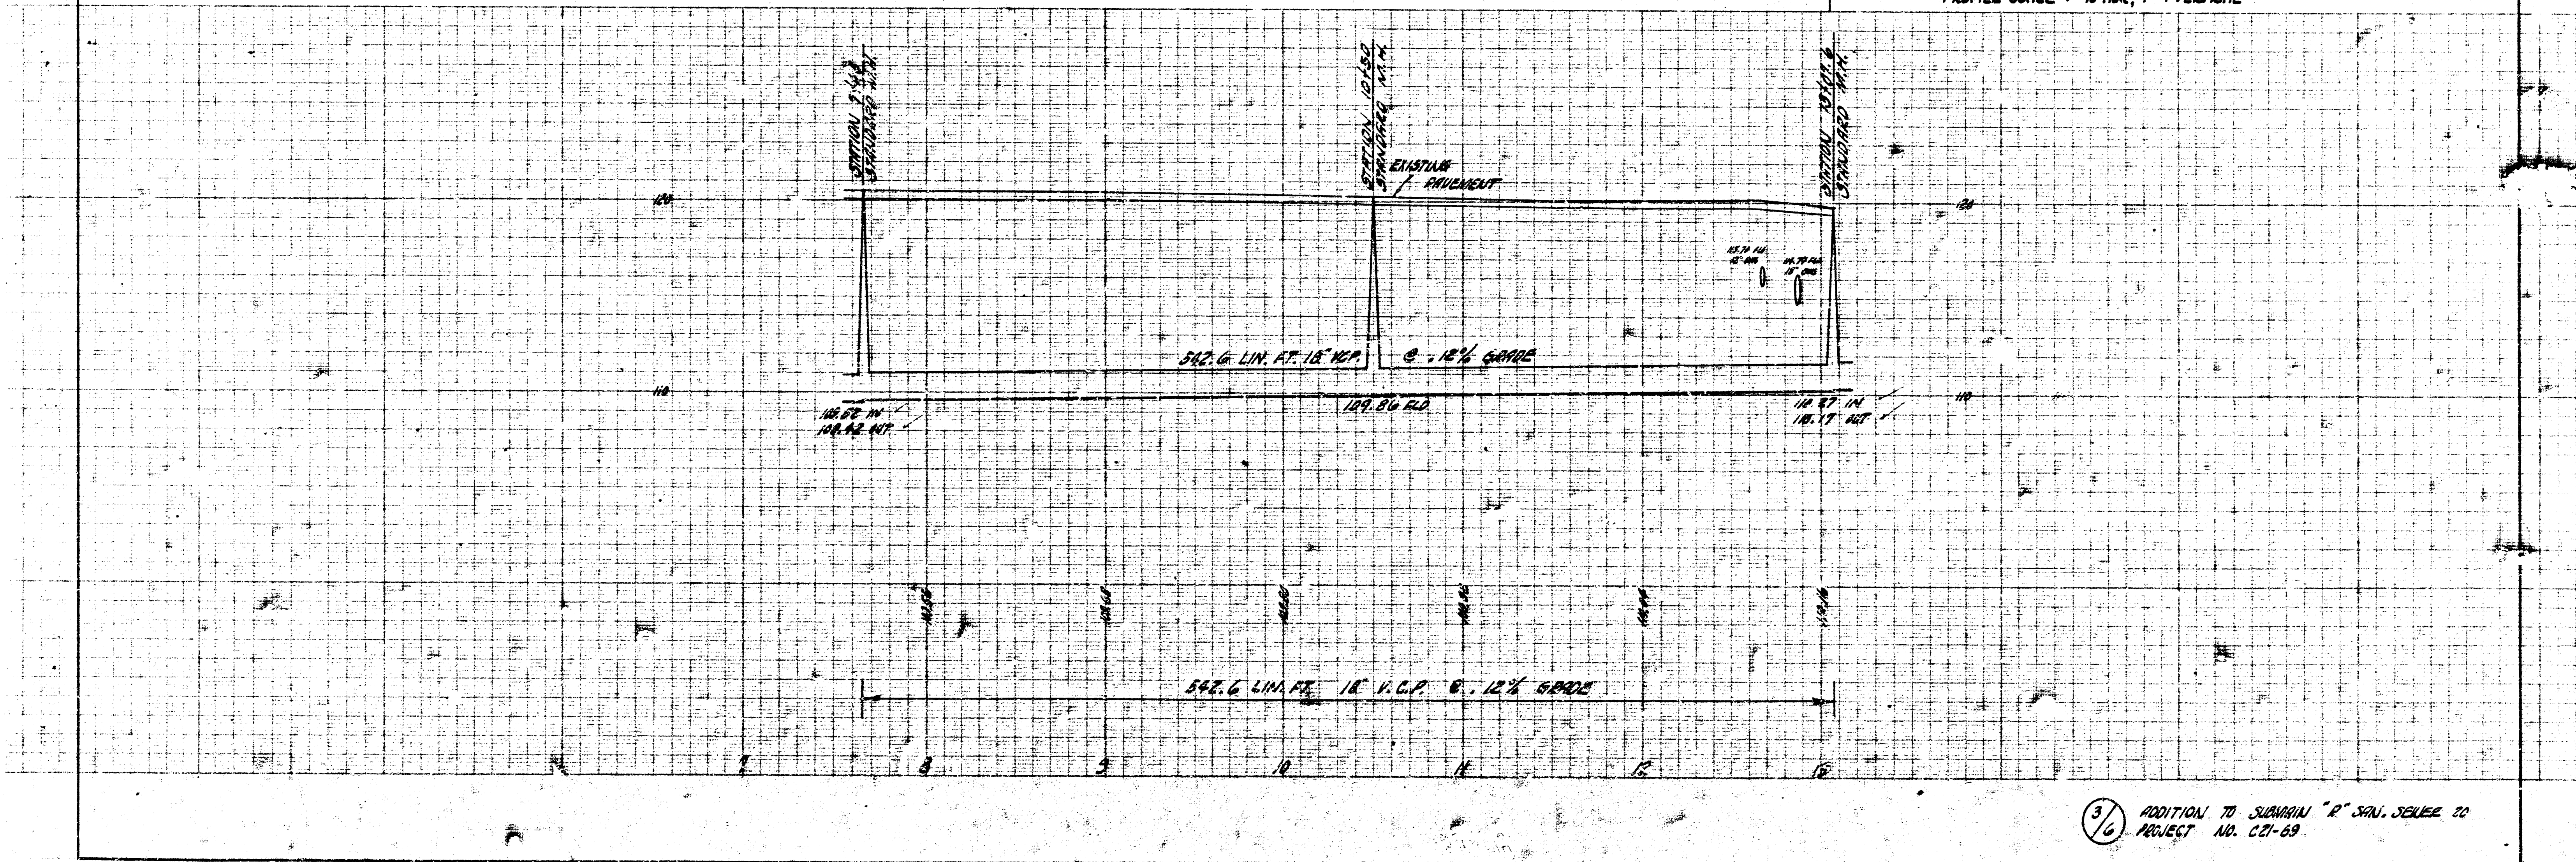


3/6 ADDITION TO SURVEY "R" SAN. SEWER TO
PROJECT NO. 021-69

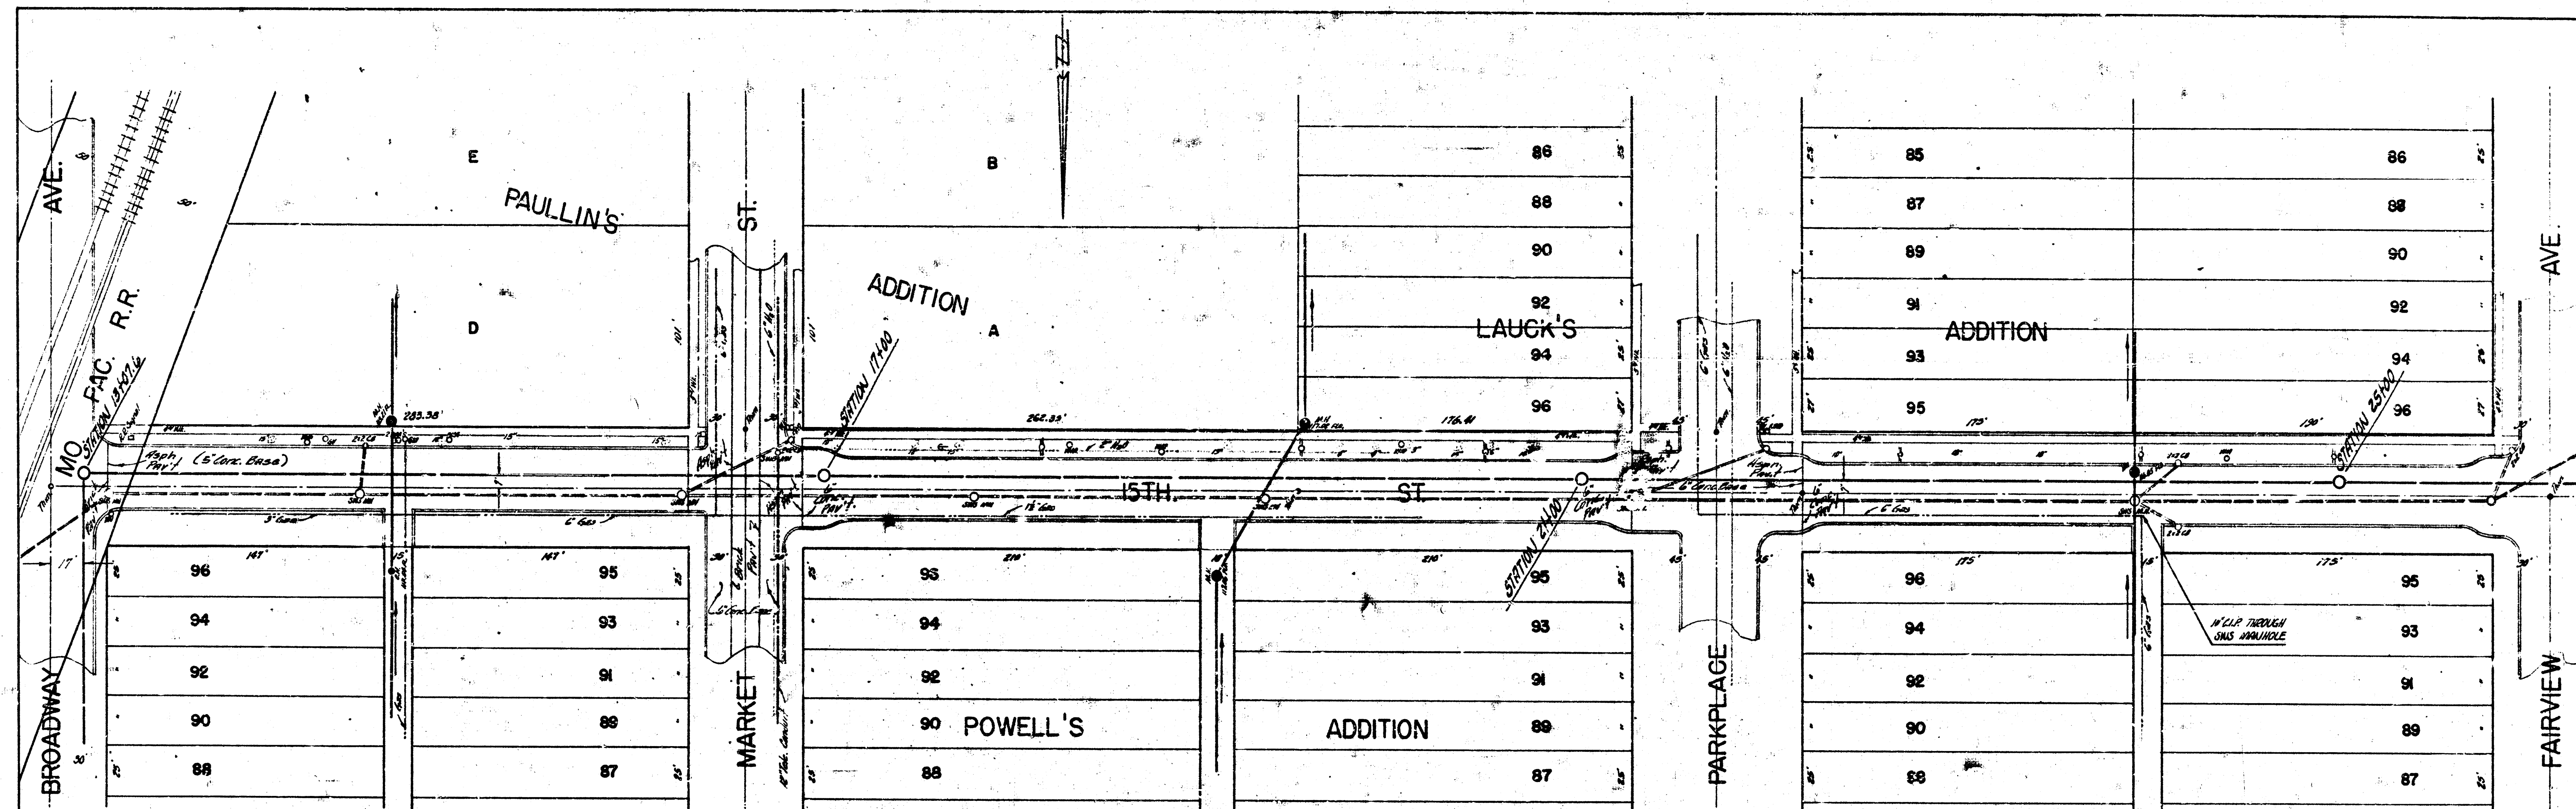



B.M. 120.32 "C" IN CARTER CTR. NW. SO. SW. COR. 15TH & PARKPLACE
 B.M. 113.65 "M" IN M'GABE W. CO. MARKET W. SIDE 15TH.

PLAN SCALE 1"=40'
 PROFILE SCALE 1"=40' HOR, 1"=4' VERTICAL

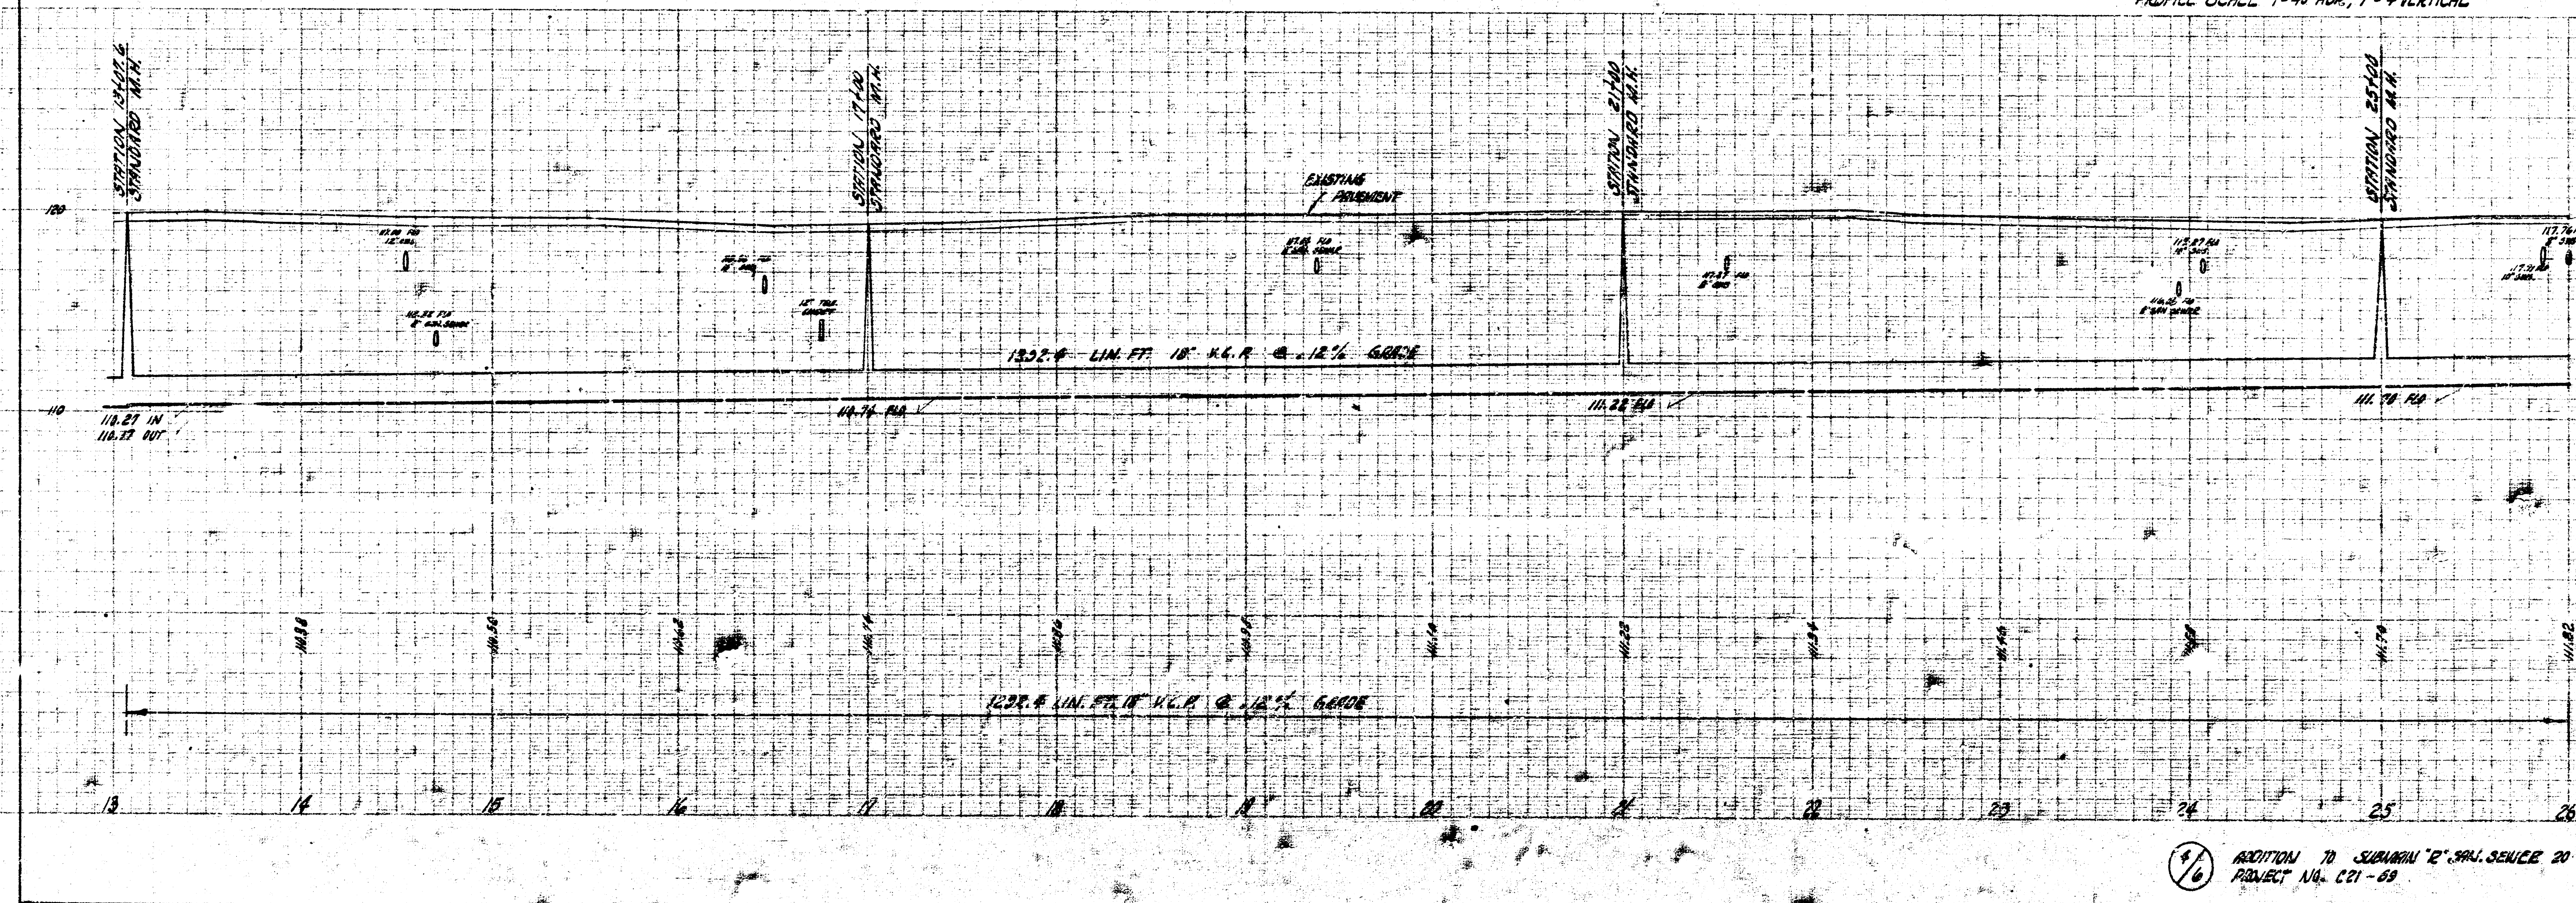


ADDITION TO SUBMITTAL "E" MAY. 1920
 PROJECT NO. C-21-09

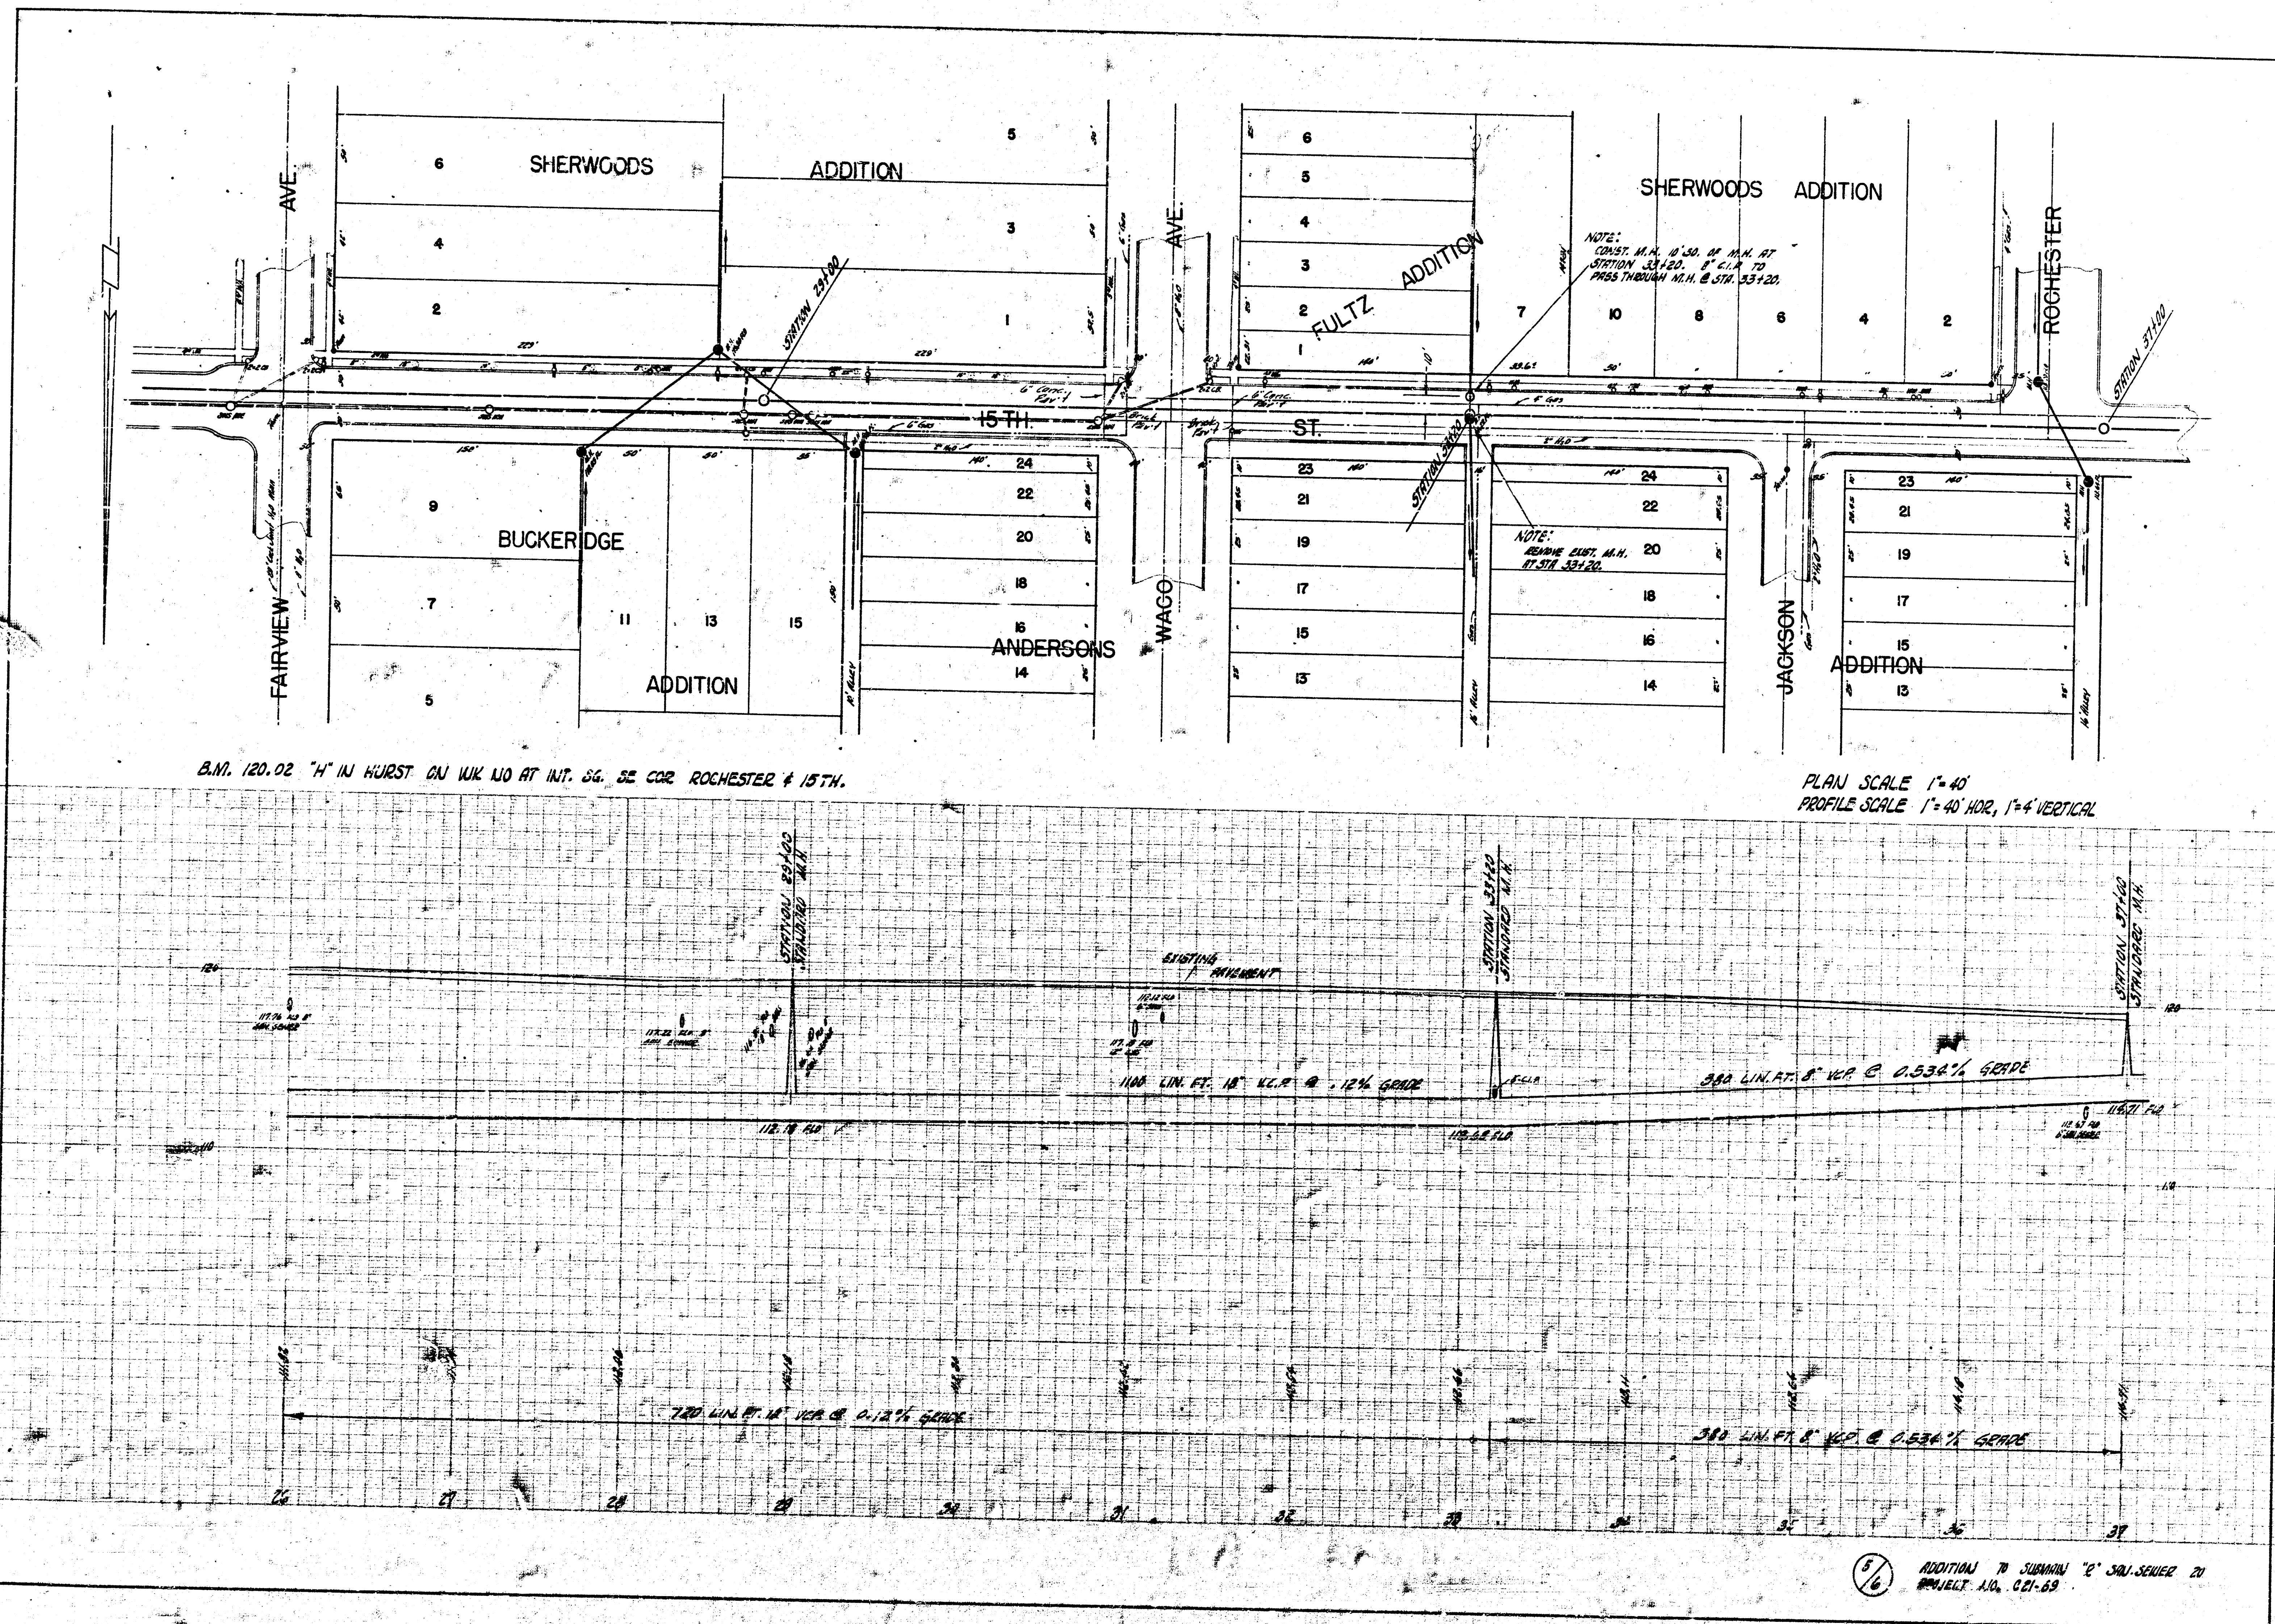

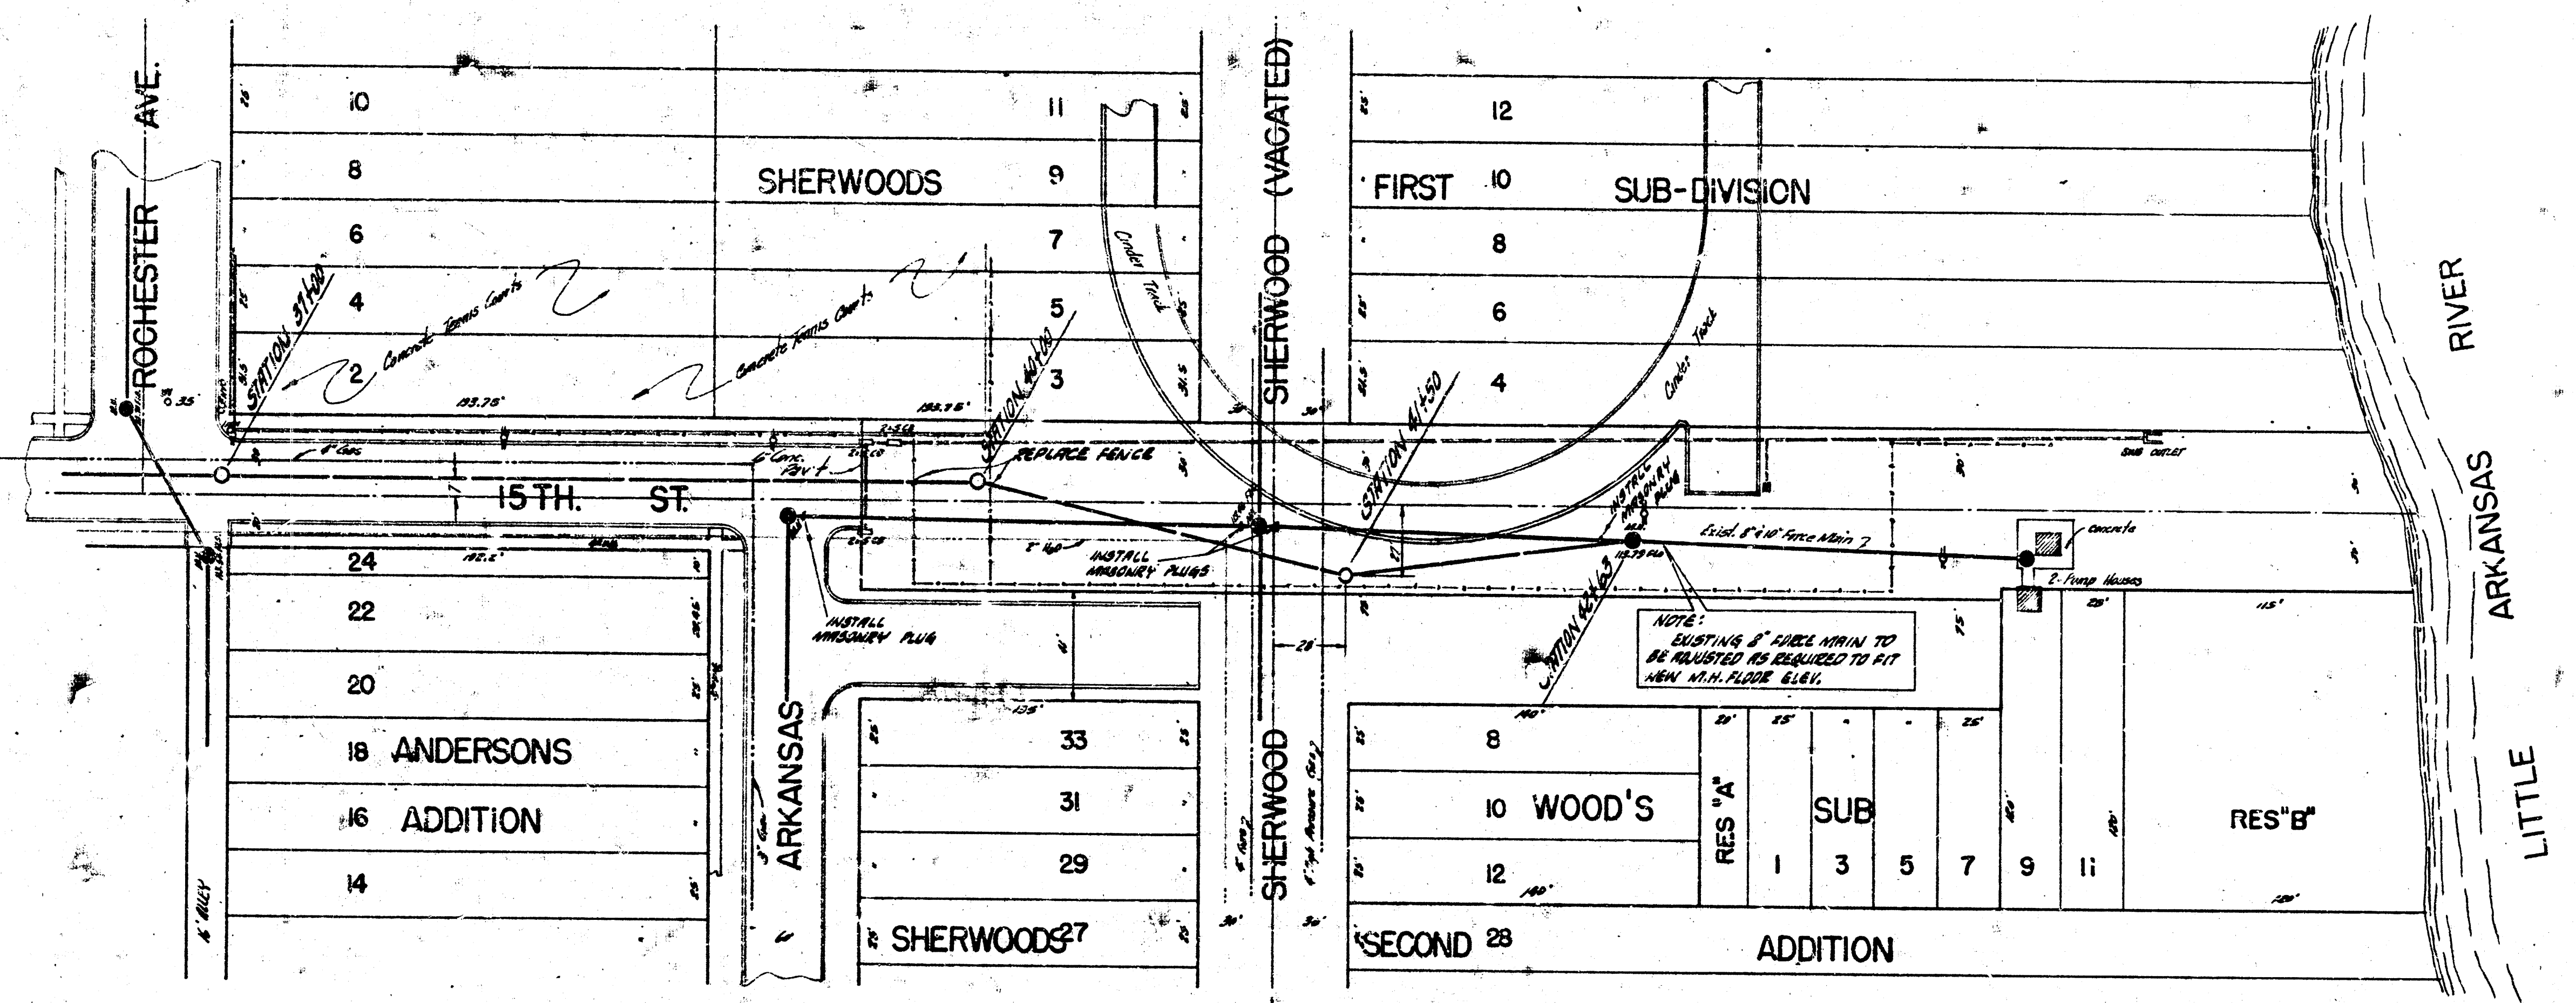

D.M. 120.33 "M" M. C. WARD 3. SIDE 15TH.

PLAN SCALE 1" = 40'
PROFILE SCALE 1" = 40' HORIZ, 1" = 4' VERTICAL

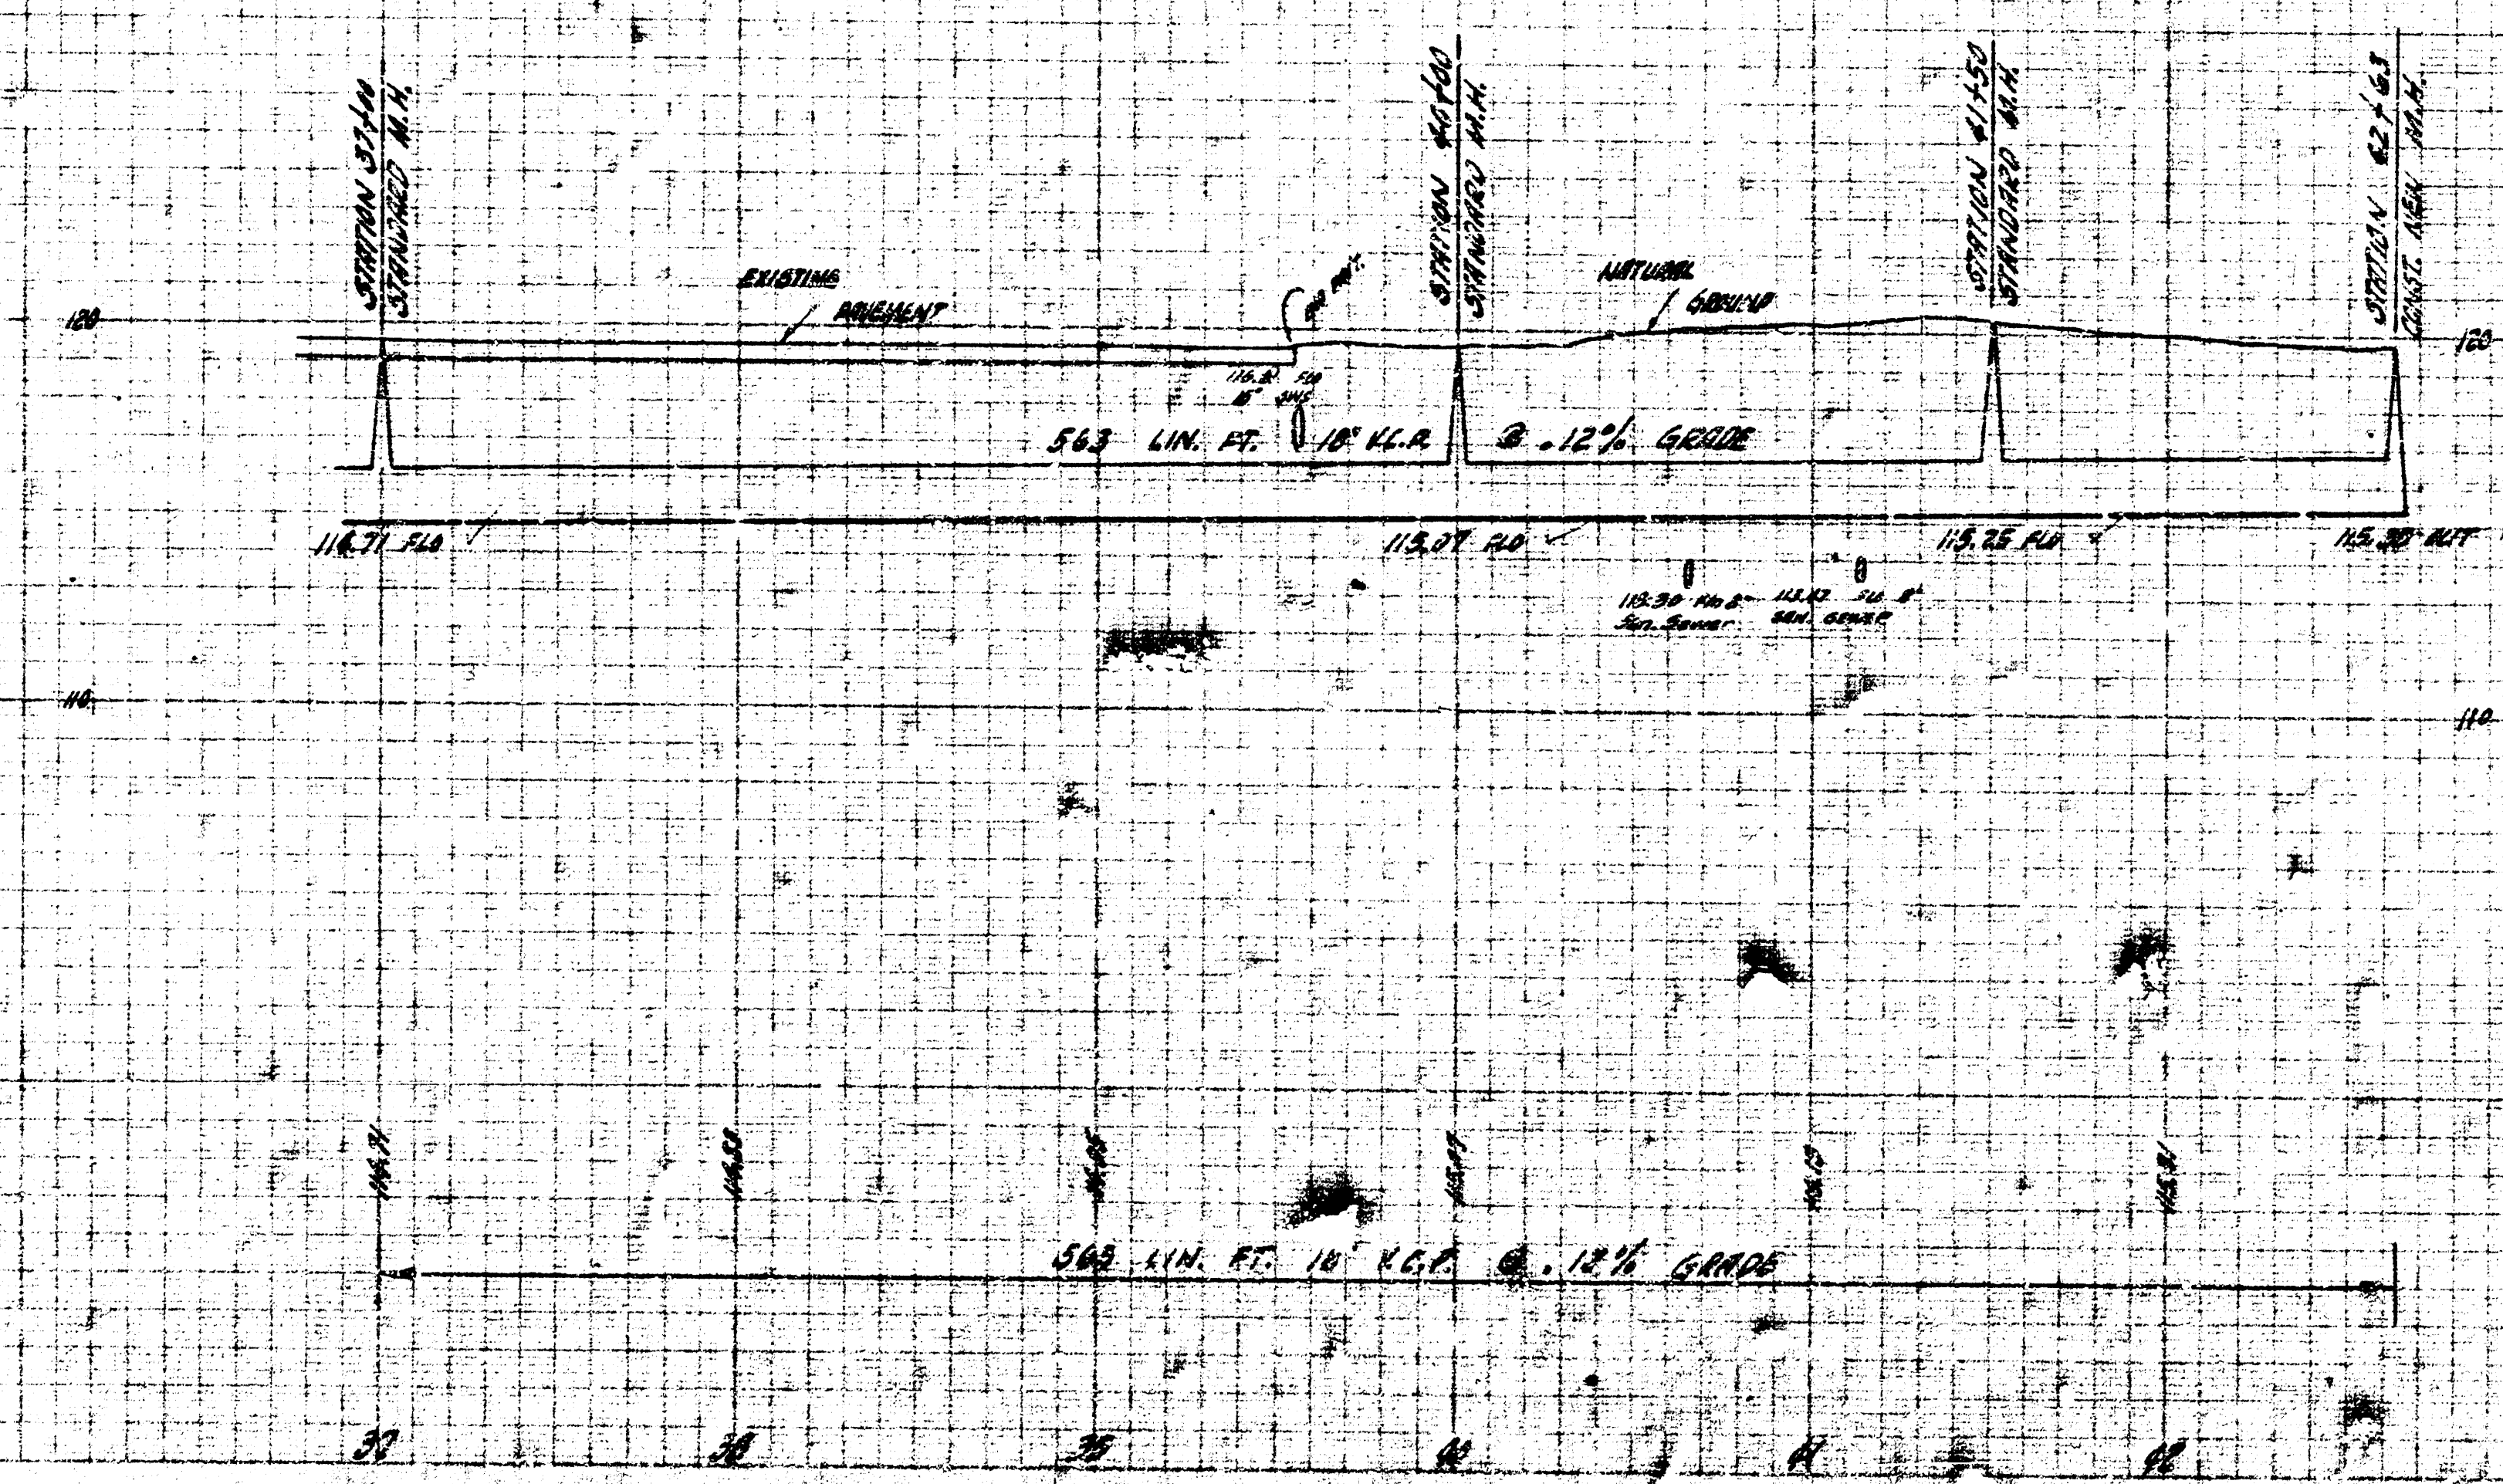

ADDITION TO SUBMITTAL "B" JAN. 1968 20
PROJECT 10, C2-68