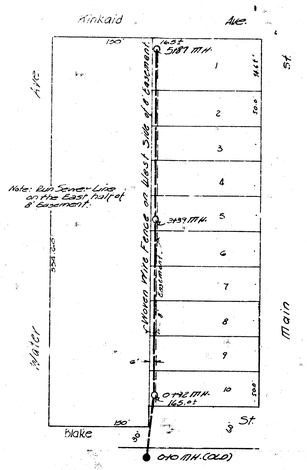


LAT. 12, DIST. A, SS # 20

STA. 101.46 N.E. Kinkaid & Main
STA. 104.18 " " " Water

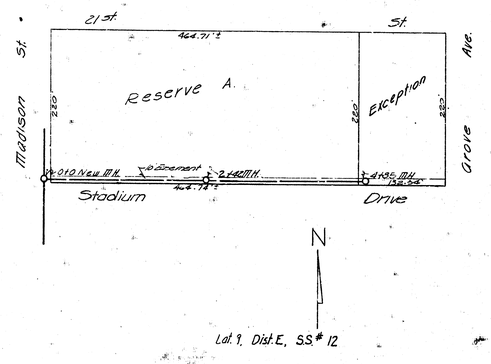


Lat 9, Dist E, SS # 12
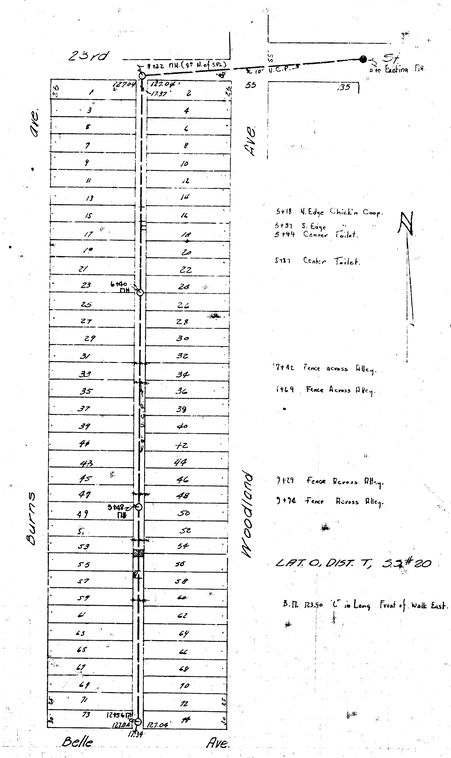
STA. 128.90 Nor. Cor. Conc. Porch, No. # 2201 Stadium
STA. "G" in Blake on WS. Int. @ Dr. # 2703 Stadium Elev. 132.52