




EX. LAT. H, DIST. R, N^o 20
 CITY OF WICHITA, KANS.
 B. E. SMITH CITY ENGINEER
 PRIVATE CONTRACT
 12-30-55

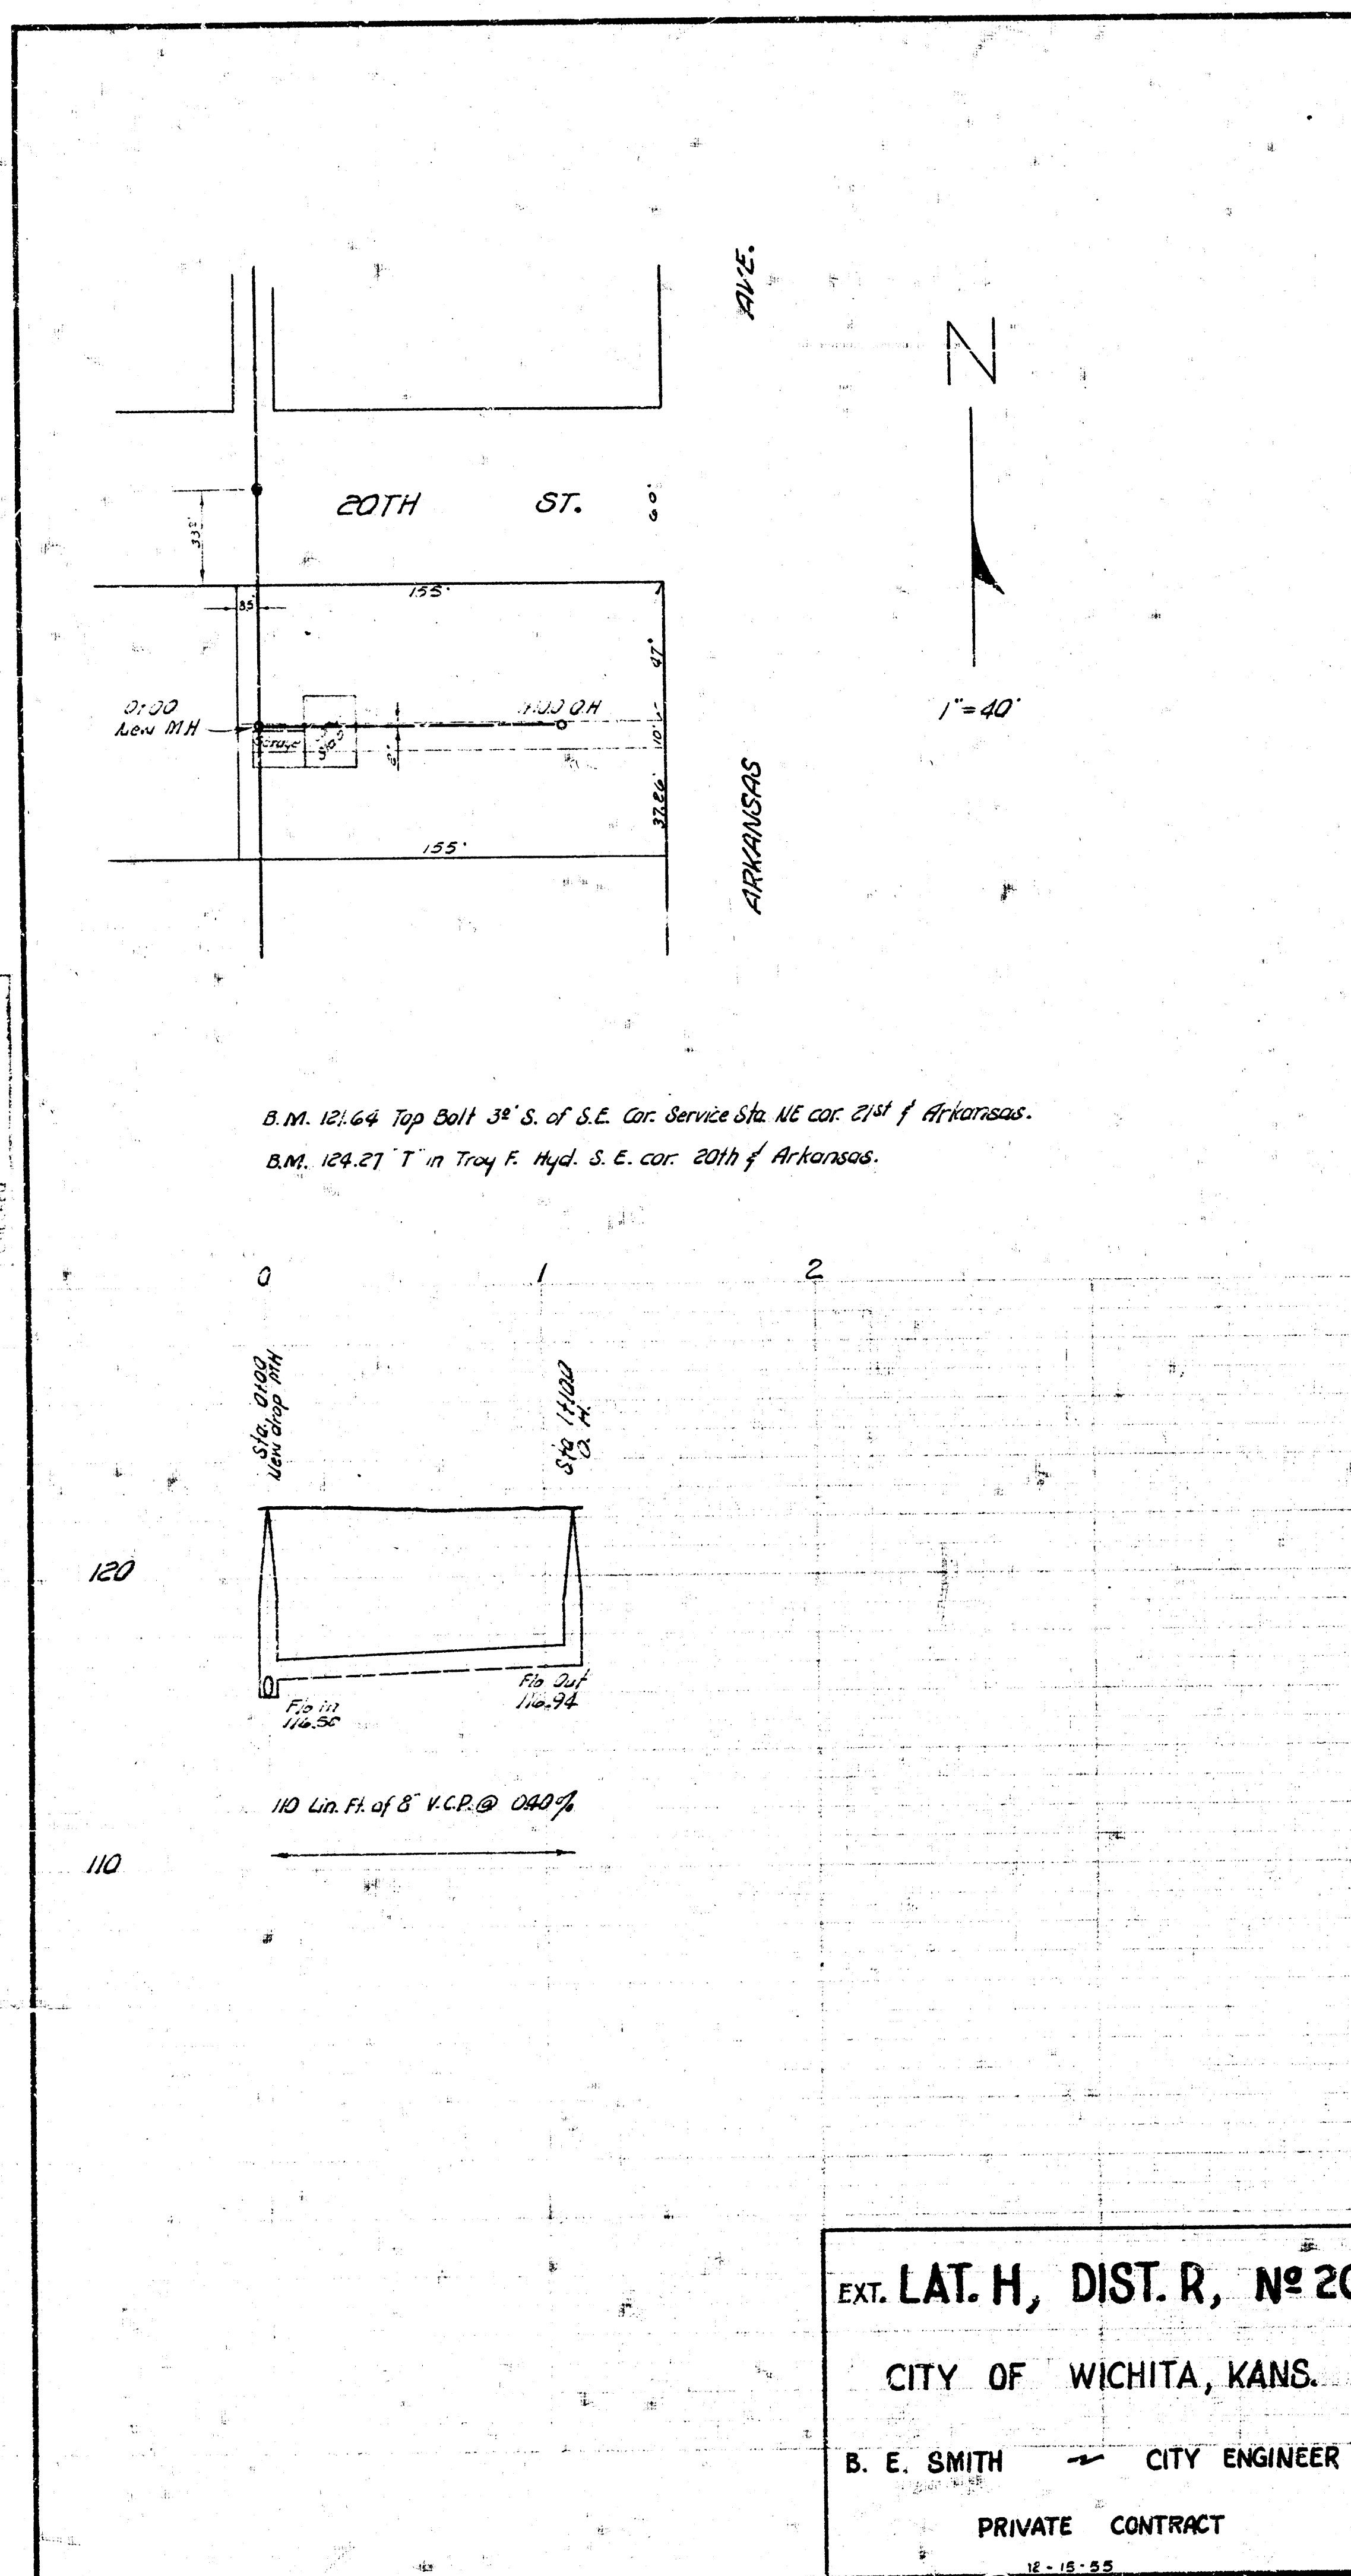

EXT. LAT. H, DIST. R, N^o 20
 CITY OF WICHITA, KANS.
 B. E. SMITH CITY ENGINEER
 PRIVATE CONTRACT

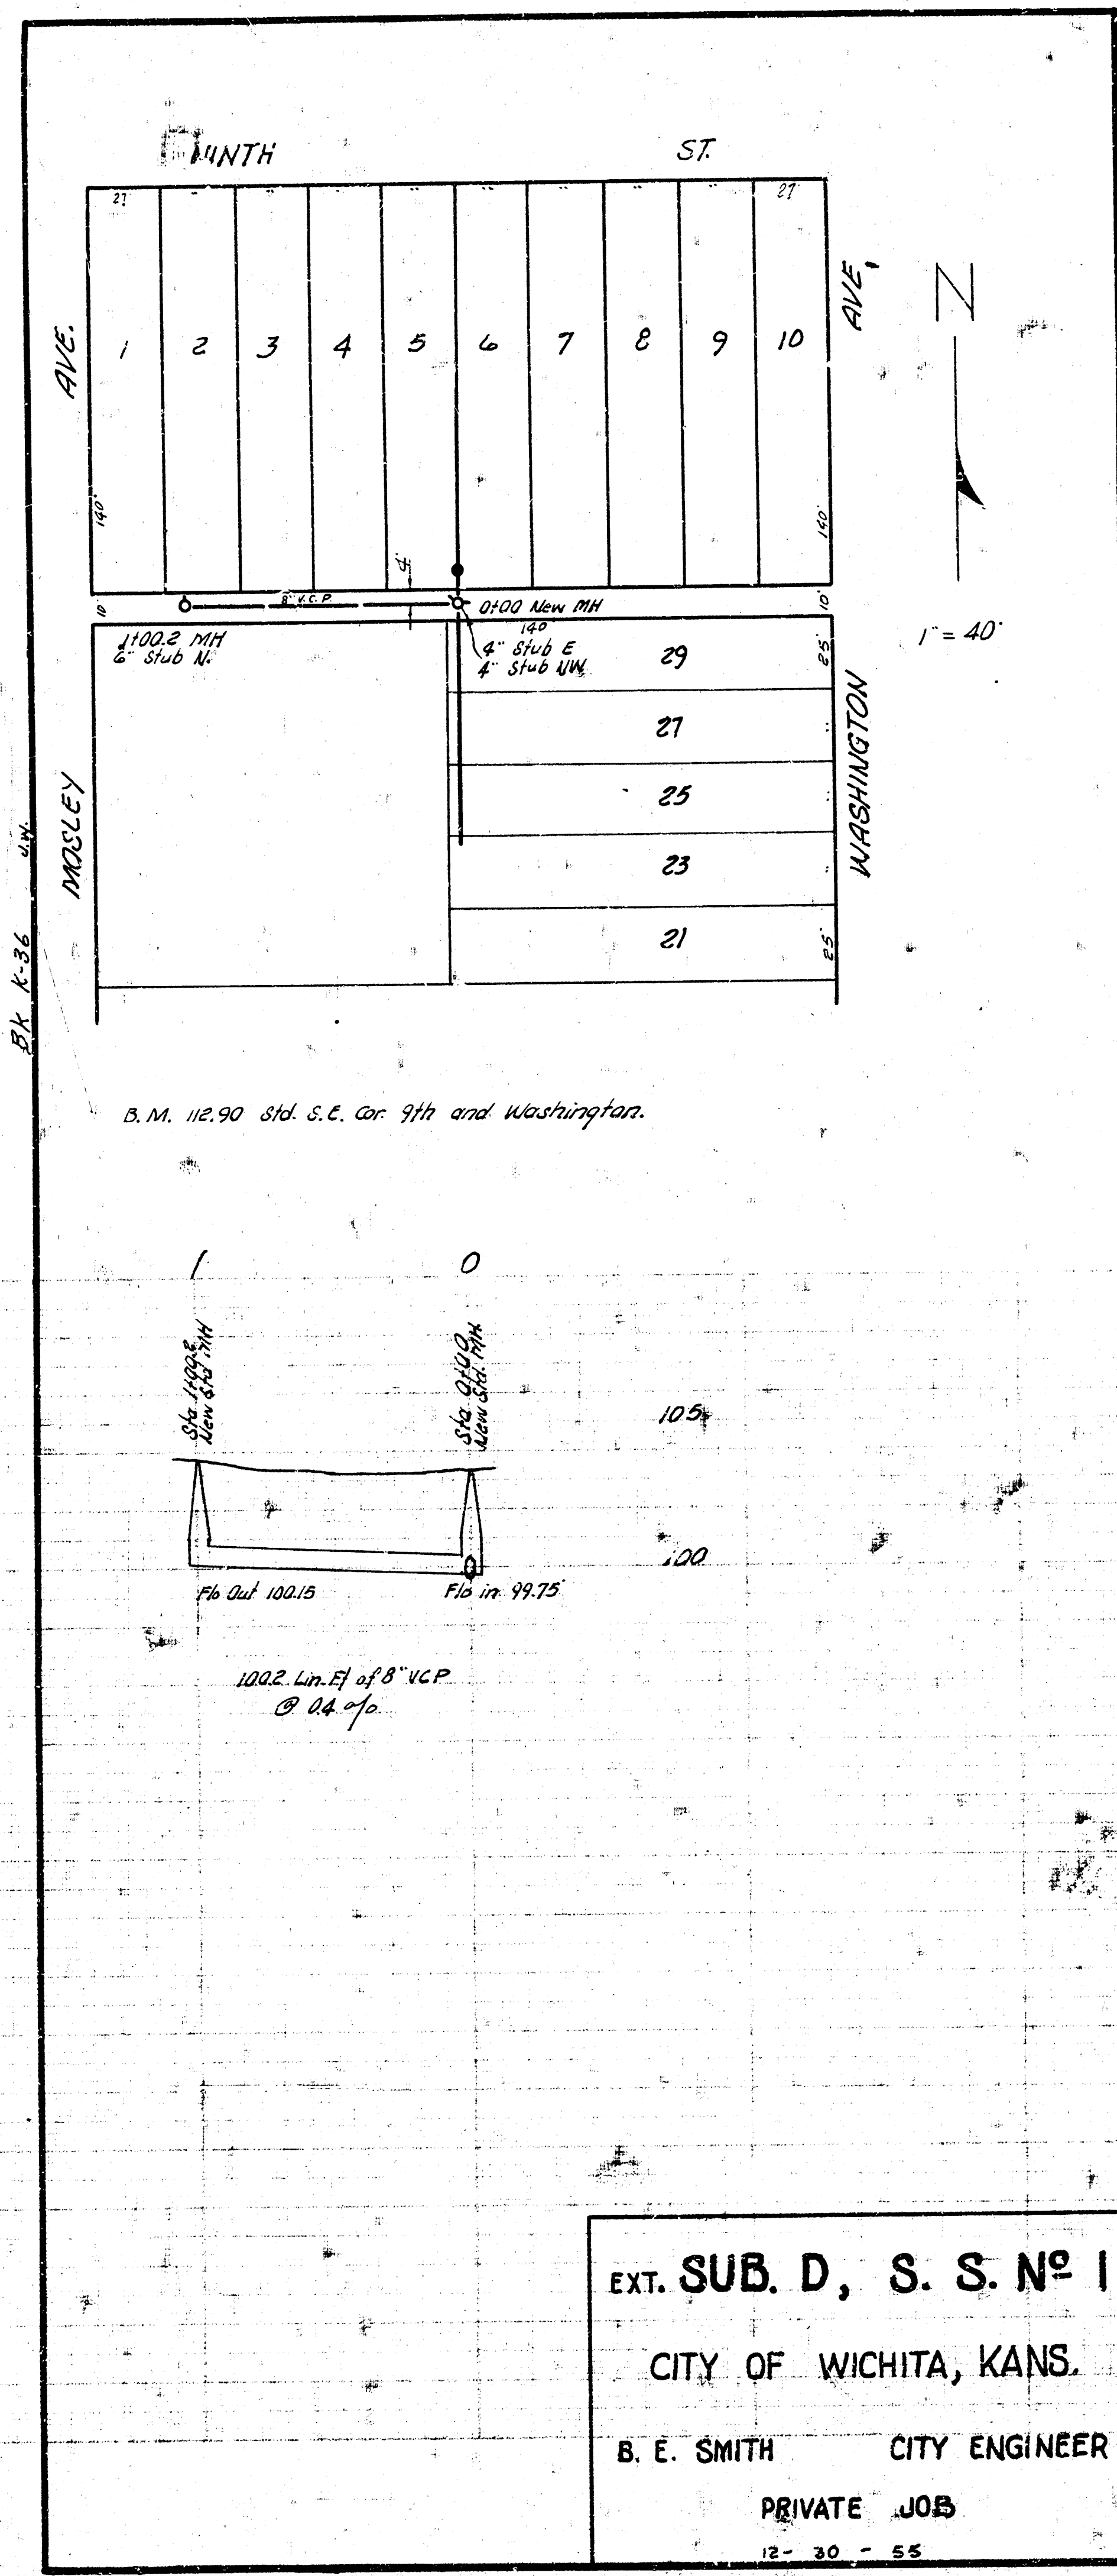

EXT. SUB. D, S. S. N^o 1
 CITY OF WICHITA, KANS.
 B. E. SMITH CITY ENGINEER
 PRIVATE JOB
 12-30-55

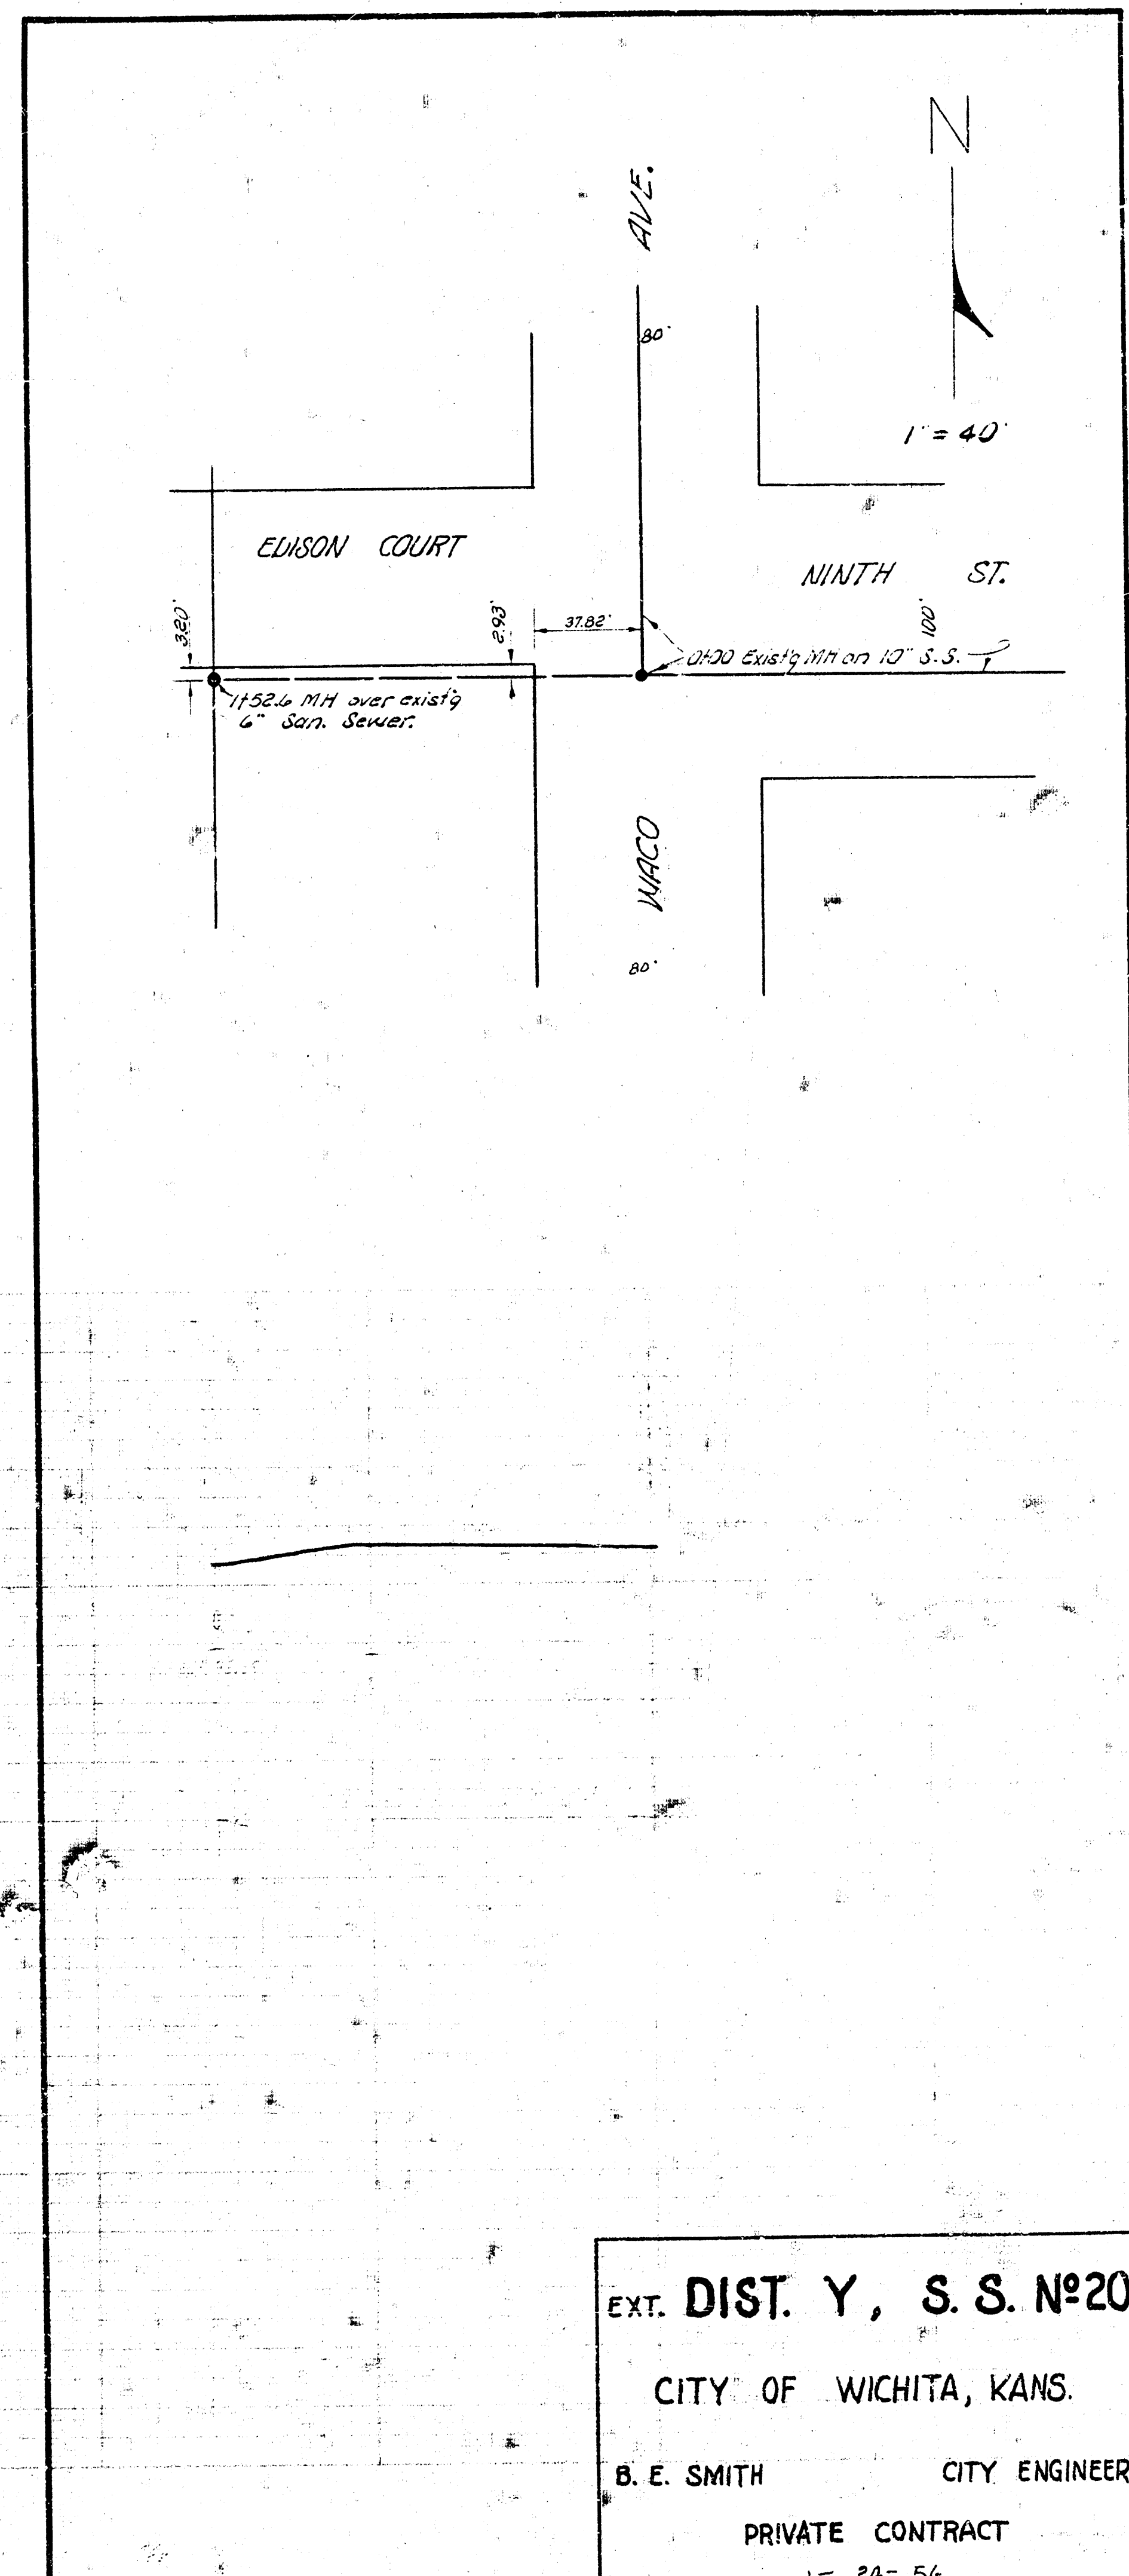

EXT. DIST. Y, S. S. N^o 20
 CITY OF WICHITA, KANS.
 B. E. SMITH CITY ENGINEER
 PRIVATE CONTRACT
