



B.M. 10912 '17' Top Curb N Side 2nd St 15' East of Alley
 B.M. 10931 '17' Top Curb S Side 3rd St 15' East of Alley
 @ is E Alley

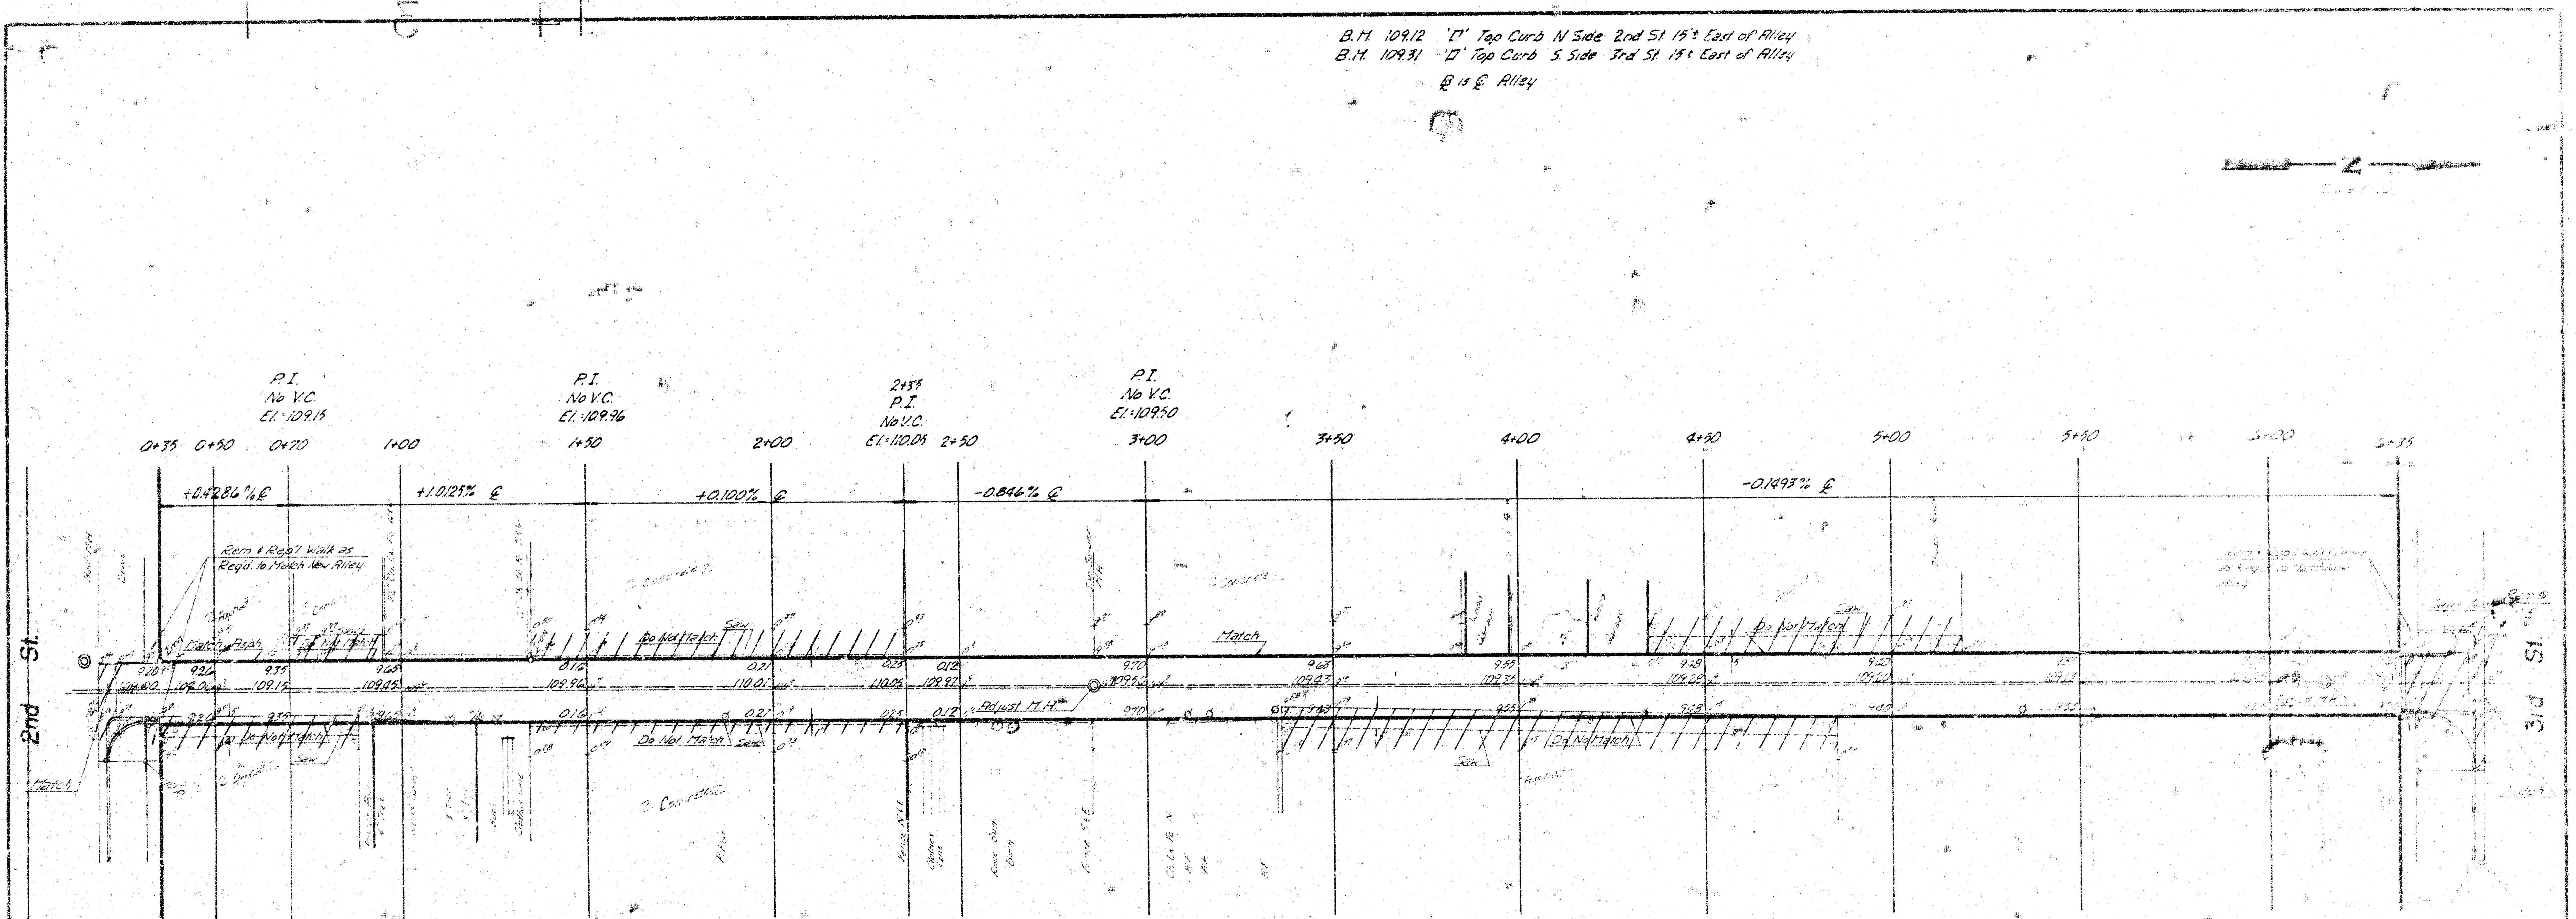

Remove 1/2" Curb & Gutter to
 1st Lane Beyond Top of Return

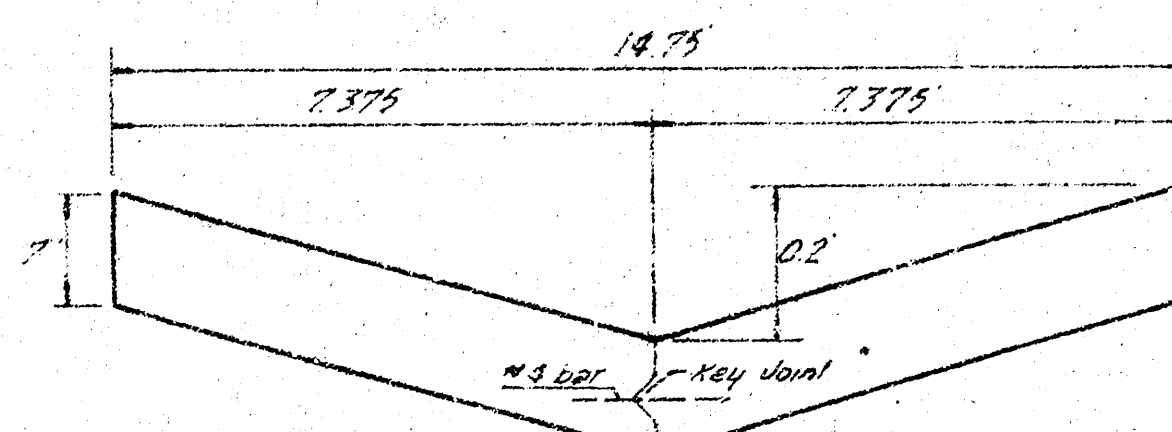


TYPICAL SECTION
 No Scale

EARTHWORK


Excav	Property	City
+10%	284.8	4.1
Total	313.3CY	45 CY
Comp. Fill	0.0	0.0
Manp.	987.35Y	8735.4

GENERAL NOTES

1. Removal Limits Shown are Approx. only. Removal Limits are to be Determined in Field by Field Engineer.
2. Parking Lots Removed behind Property Line are to be Replaced with Like Material. No Removal is to Take Place behind Property Line without Written Approval of Property Owner.
3. Concrete Parking Lots are to be Replaced as S.F.L. Concrete Drive. Asphalt Parking Lots are to be Replaced as S.Y. & Asphalt Surface Mix.
4. Tree Removal is Marked thus , except that any tree which in the Opinion of the Field Engineer can be Saved shall be Saved.
5. Alley is not to be Paved until San Sewer has been Reconstructed.
6. Paving Contractor to use Caution when Working Subgrade Due to Extremely Shallow San Sewer.


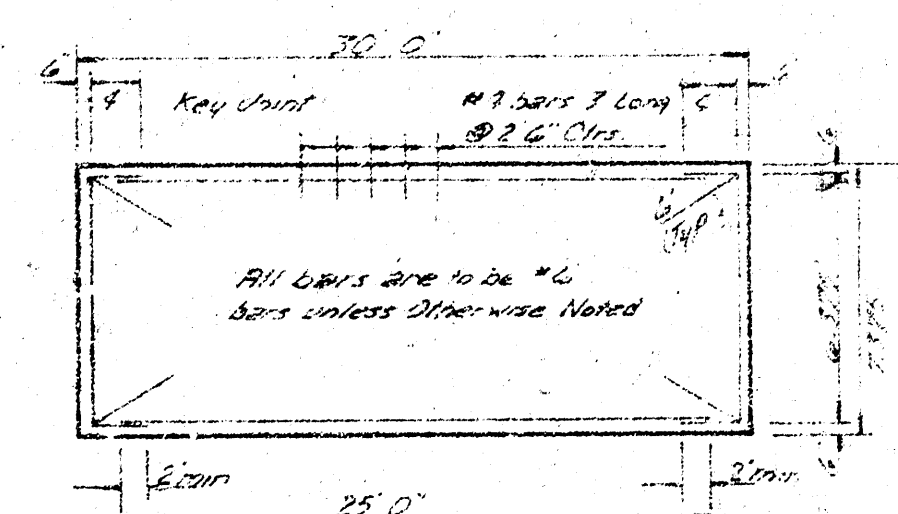


STEEL PATTERN
 No Scale

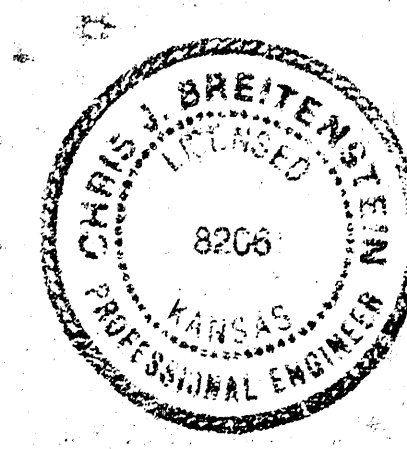

'ALLEY' between Wabash & Ohio
 N.L. 2nd — S.L. 3rd
 CITY of WICHITA, KANSAS
 R. W. LINN — City Engineer
 DATE _____


WABASH

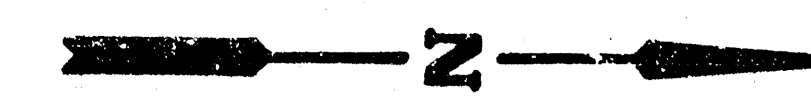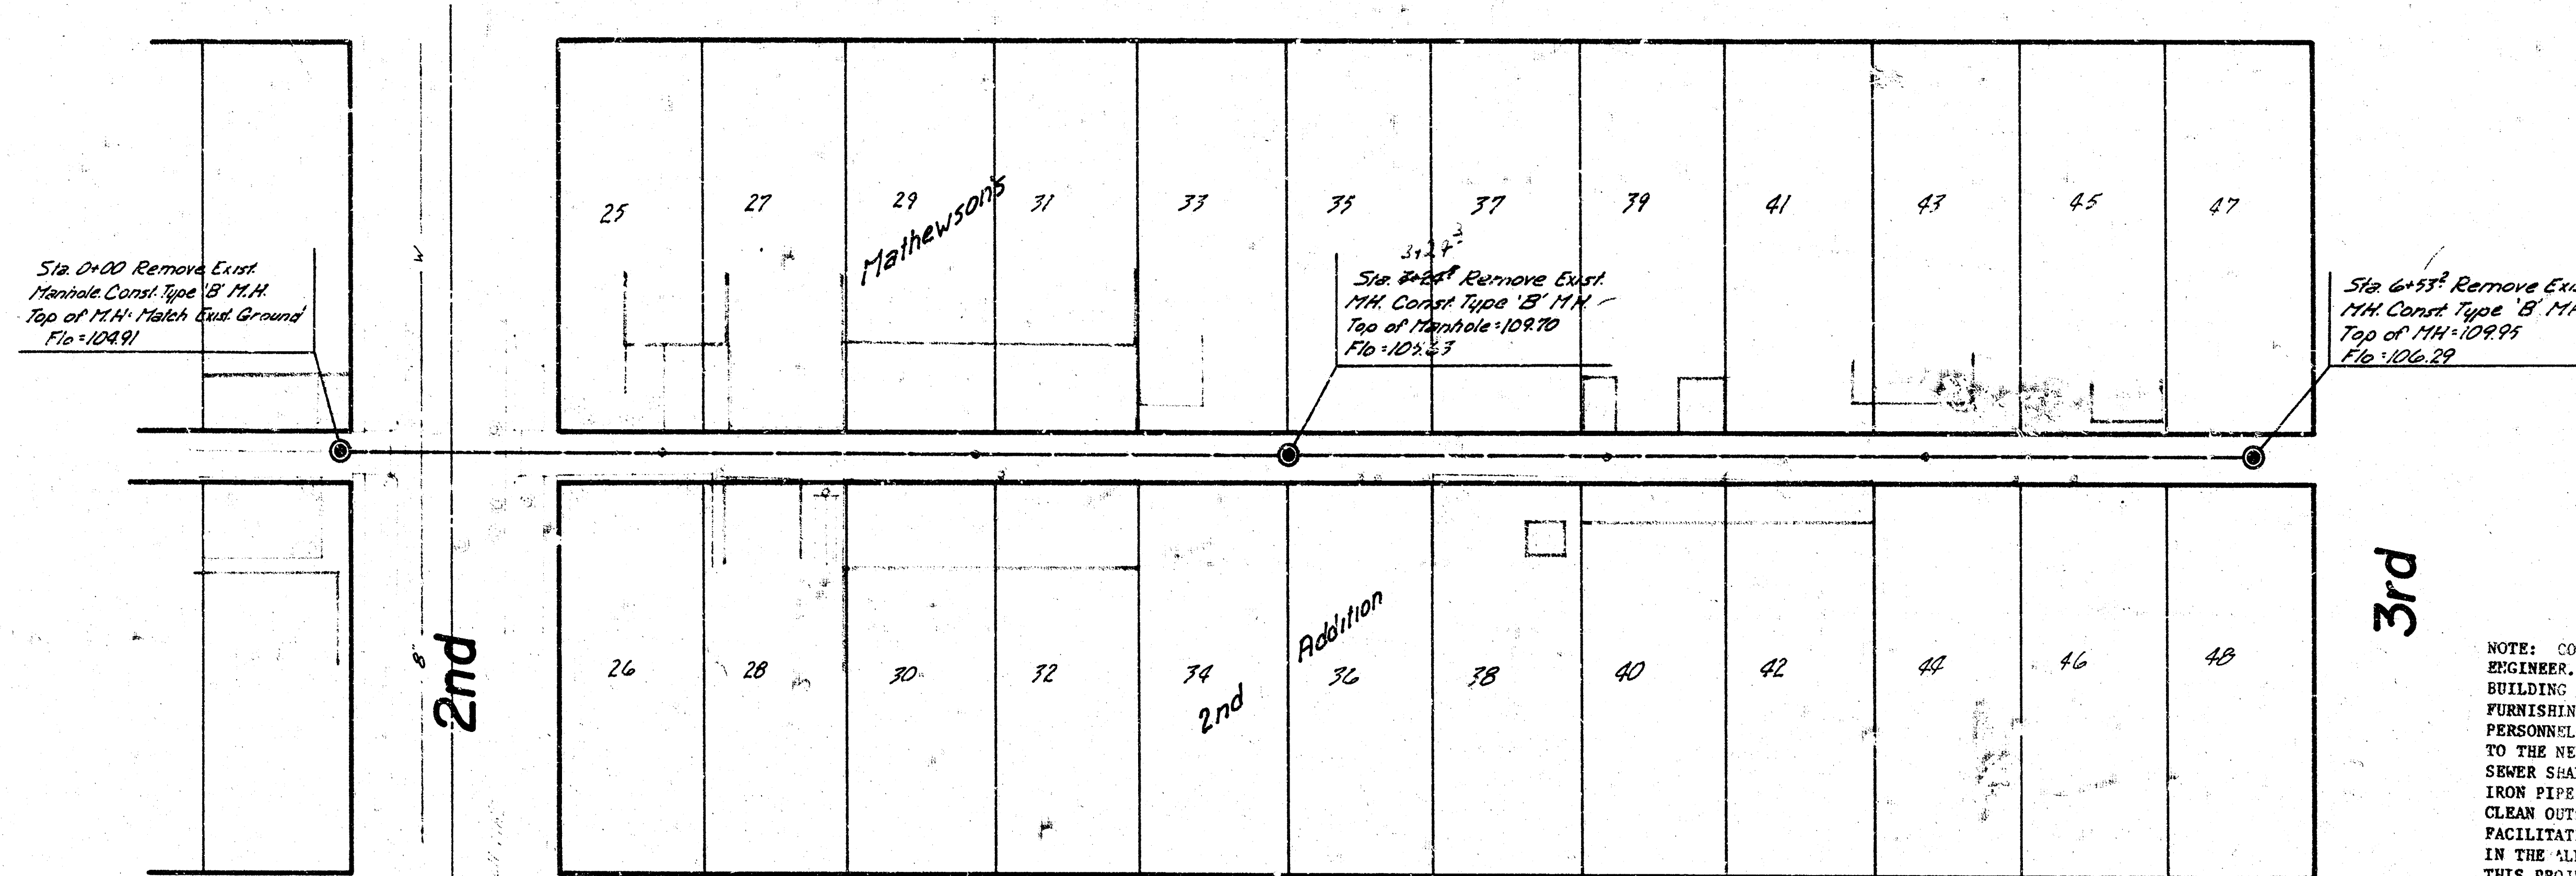

B.M. 109.12 'D' Top of Curb N. Side 2nd St.
15' East of Alley

NOTE: CONTRACTOR'S METHOD FOR HANDLING SEWAGE FLOWS DURING CONSTRUCTION OF THIS PROJECT SHALL BE APPROVED BY THE ENGINEER. CONTRACTOR WILL BE REQUIRED TO OBTAIN PERMITS FROM PUBLIC WORKS ADMINISTRATION BEFORE RECONNECTING BUILDING SERVICE LINES. PERMIT FEE WILL BE WAIVED. BID ITEM FOR SERVICE CONNECTIONS SHALL COVER ALL COSTS FOR FURNISHING AND INSTALLING SADDLE INCLUDING TAPPING FEE. PIPE TAPS ARE TO BE MADE BY CITY MAINTENANCE DEPARTMENT PERSONNEL UNLESS APPROVED OTHERWISE BY THE ENGINEER. ONLY ACTIVE BUILDING SANITARY SEWER LINES ARE TO BE RECONNECTED TO THE NEW SEWER. CONTRACTOR SHALL VERIFY WHICH LINES ARE ACTIVE. EVERY BUILDING SEWER RECONNECTED TO THE NEW SEWER SHALL BE TRAPPED. CLEAN OUTS SHALL BE INSTALLED WITH THE TRAPS. TRAPS AND CLEAN OUTS SHALL BE CLASS 42 CAST IRON PIPE AND WILL BE PAID FOR AT THE UNIT PRICE BID PER LINEAL FOOT OF CAST IRON PIPE. LOCATION OF TRAPS AND CLEAN OUTS SHALL BE AS APPROVED BY THE ENGINEER. THE ALLEY PAVING PLAN SHEET HAS BEEN INCLUDED IN THIS PLAN TO FACILITATE SETTING TOPS OF CLEAN OUTS TO MATCH PAVEMENT ELEVATIONS WHERE IT MAY BE NECESSARY TO INSTALL CLEAN OUTS IN THE ALLEY RIGHT-OF-WAY. CONTRACTOR SHALL GIVE ALL PROPERTY OWNERS AND TENANTS AFFECTED BY THE CONSTRUCTION OF THIS PROJECT A MINIMUM OF 24 HOURS ADVANCE NOTICE PRIOR TO START OF CONSTRUCTION.

Scale
Plan 1"=40'
Profile Hor. 1"=40'
Vert 1"=5'

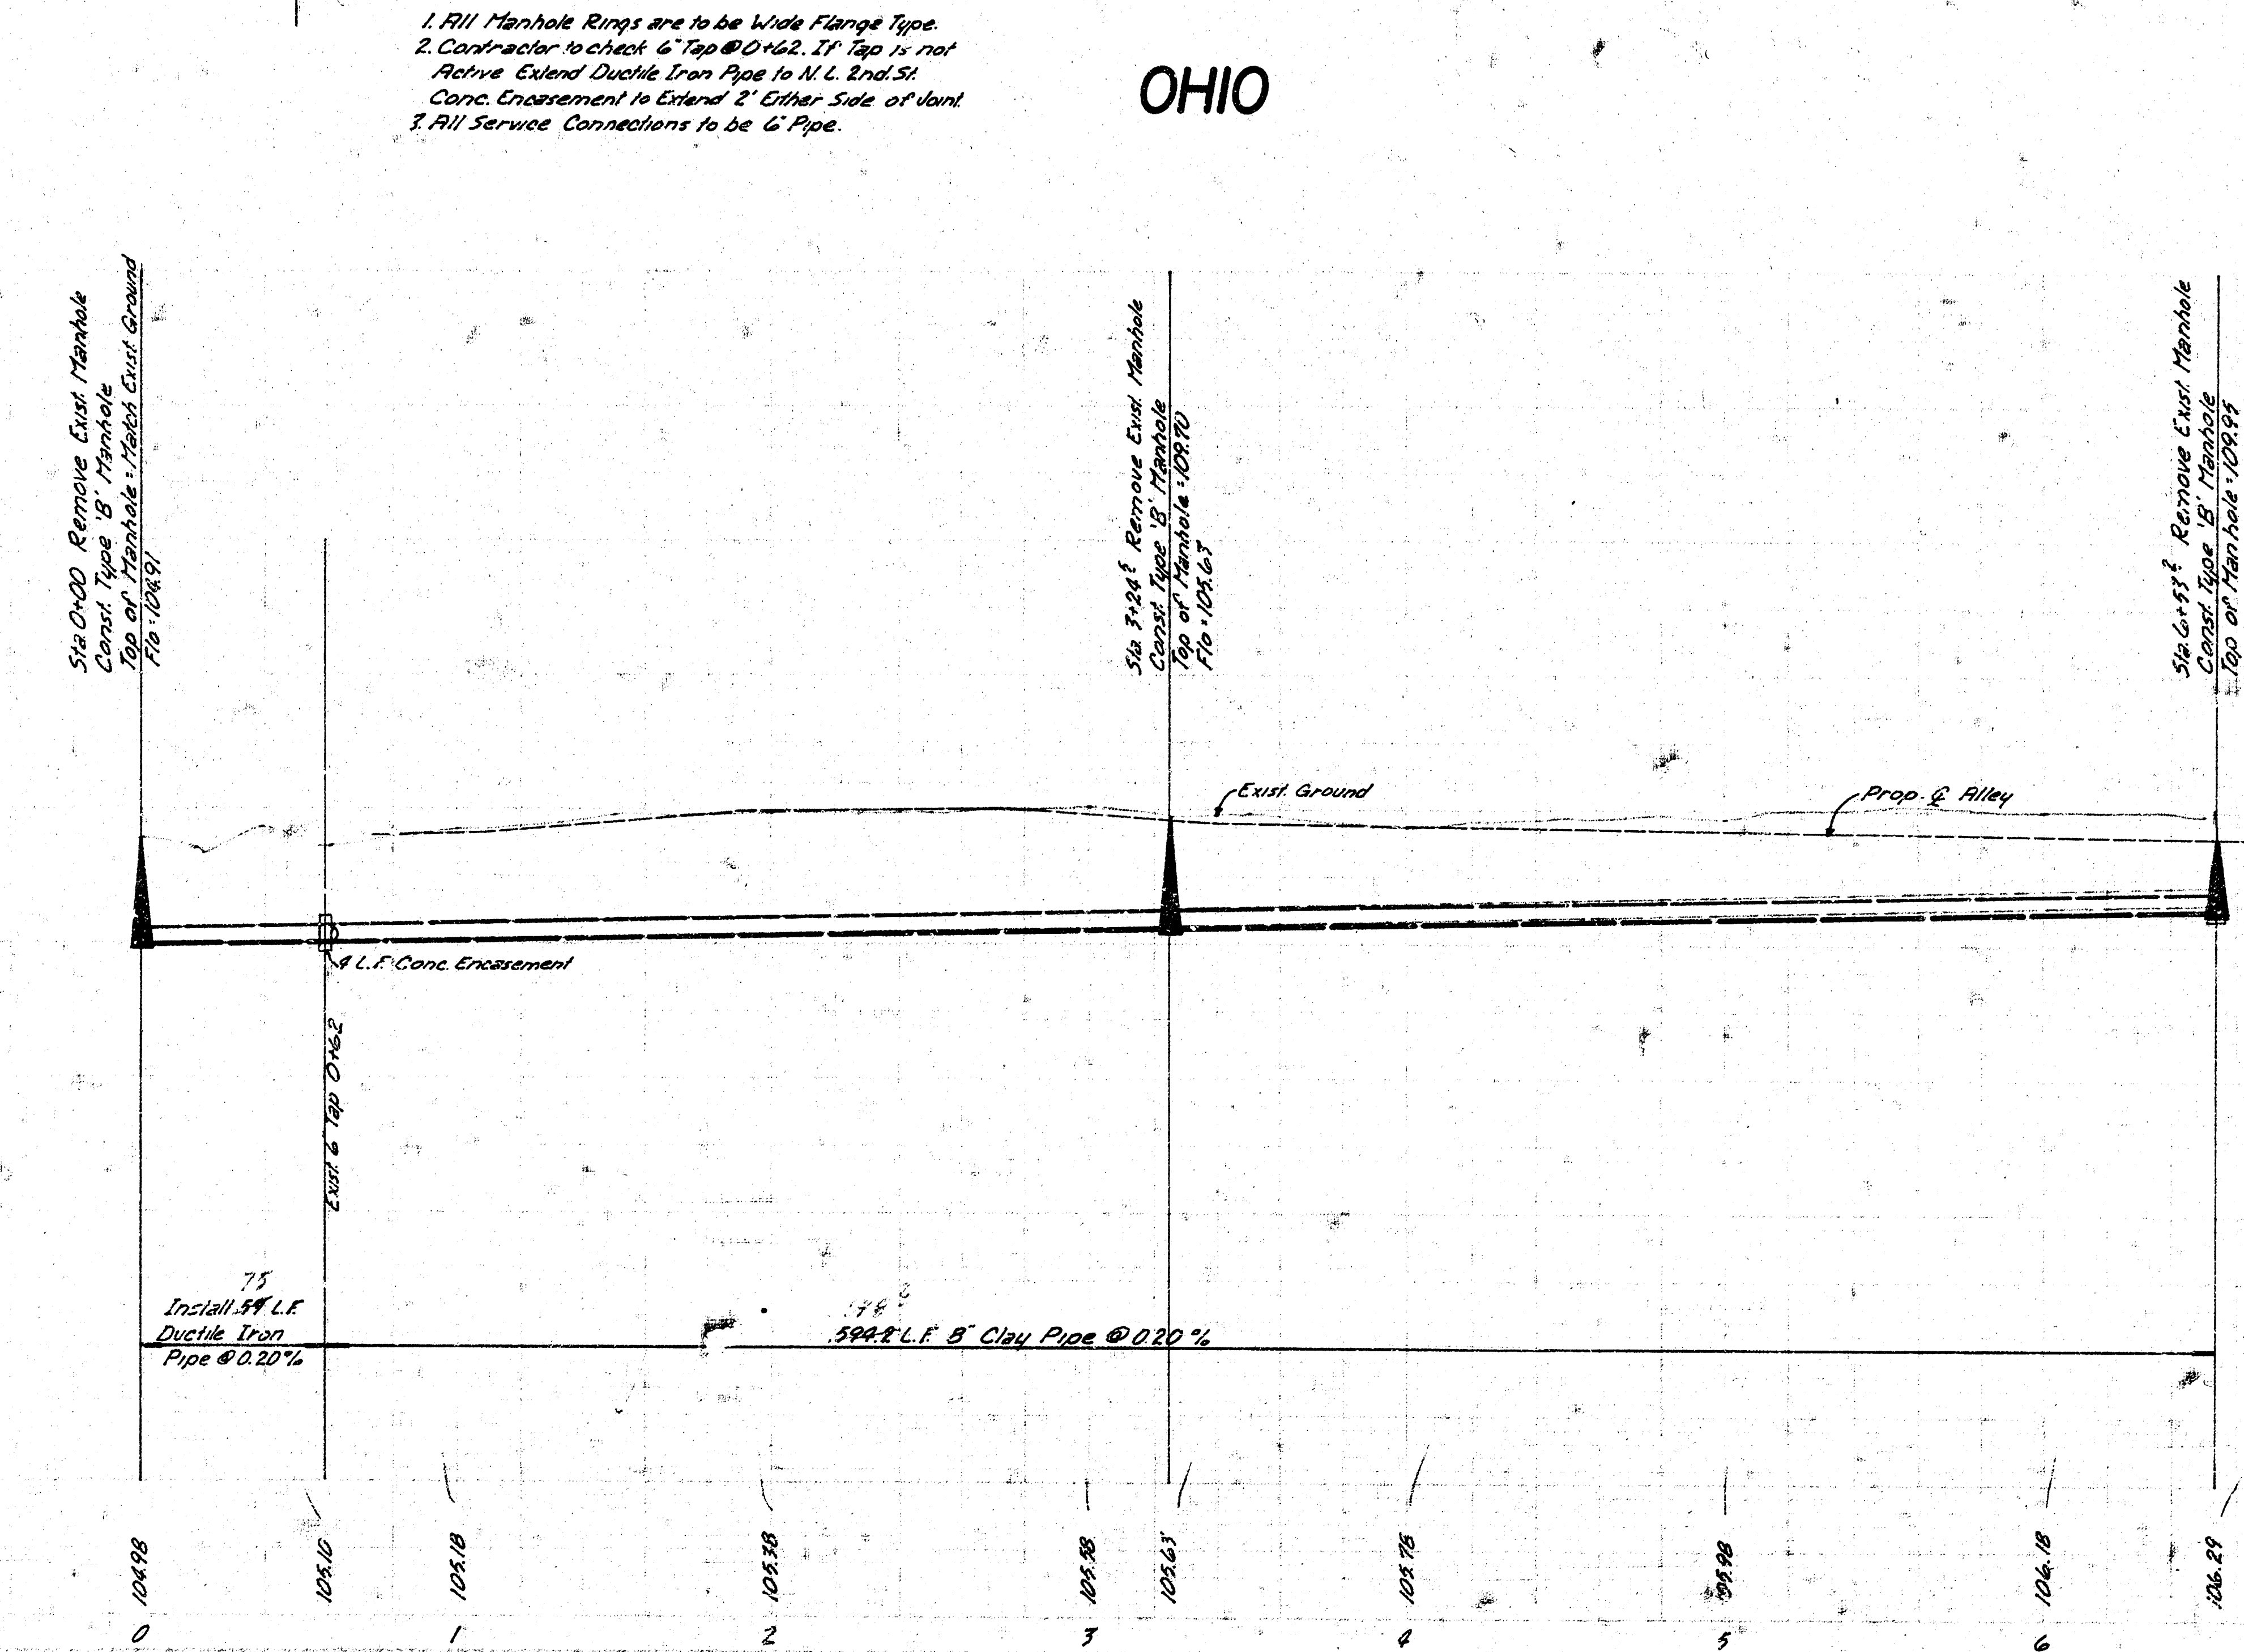

Reconstruction of a Portion
of District Y, San. Sewer 20 in
the Alley bet. Wabash & Ohio from
2nd to 3rd
592-80-245-80026-000-000-001
City of Wichita, Kansas
Public Works - Engineering Div.
Dean S. Sellers - Acting City Engineer
Date _____

FILMED FROM THE BEST
AVAILABLE COPY