
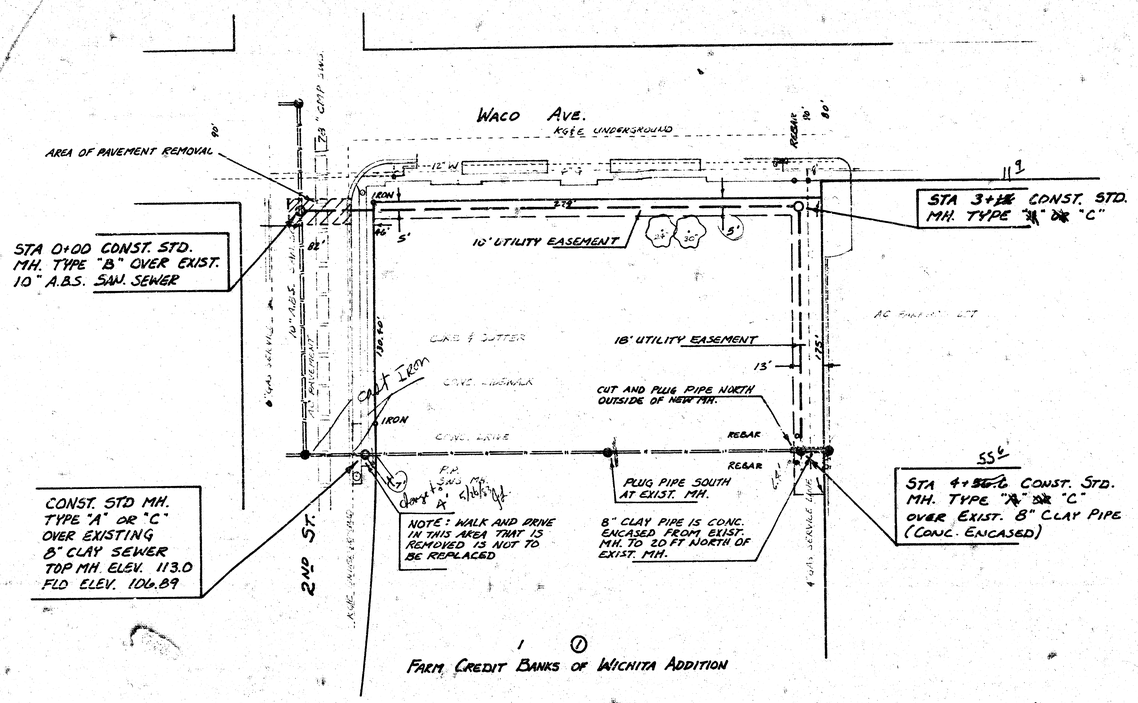


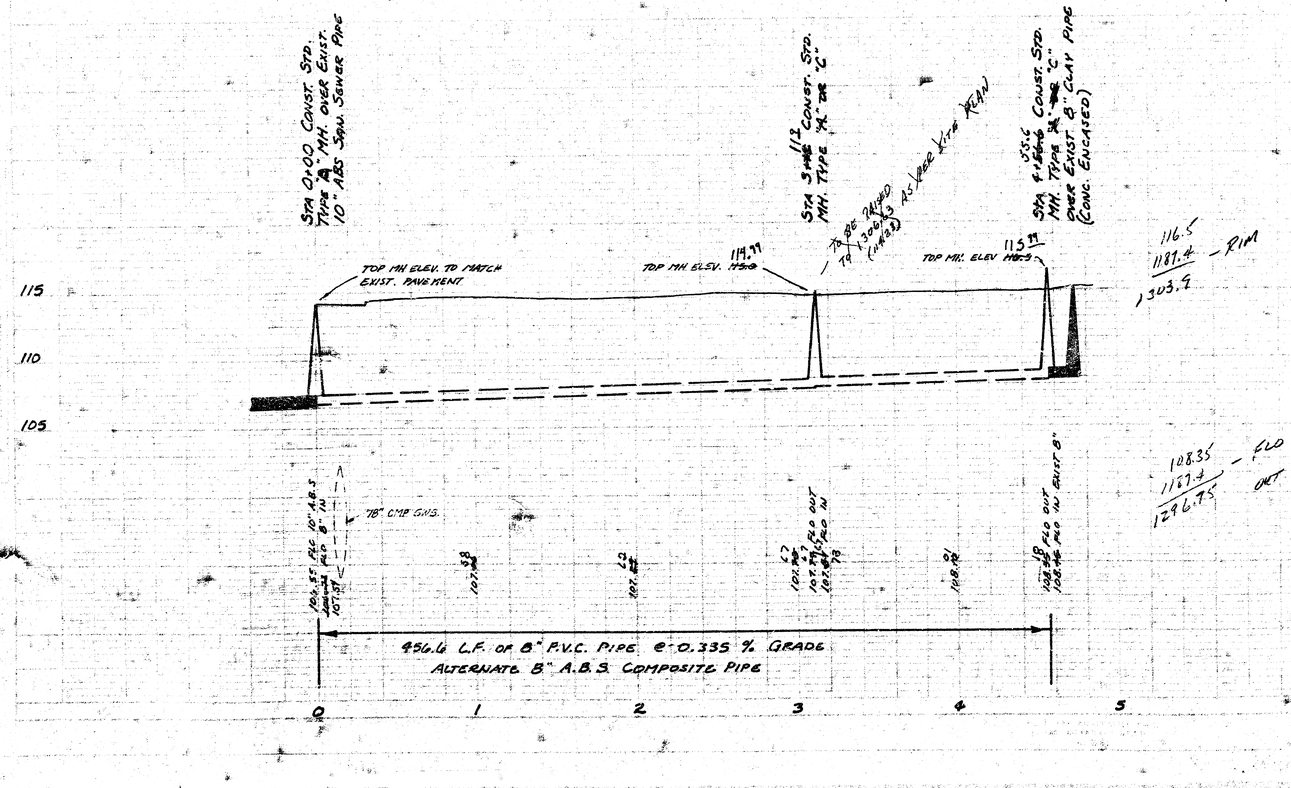

CAUTION
UNDERGROUND UTILITIES
Please check with K G & E or Southwestern Bell Telephone Co. for Location

THE CONTRACTOR SHALL BE RESPONSIBLE FOR PRESERVING PROPERTY IRONS. THE CONTRACTOR SHALL BE REQUIRED TO RE-ESTABLISH ANY PROPERTY IRONS WHICH ARE DAMAGED OR DESTROYED BY HIS CONSTRUCTION OPERATIONS. SUCH IRONS SHALL BE RE-ESTABLISHED BY A LICENSED LAND SURVEYOR OR A LICENSED PROFESSIONAL ENGINEER IN ACCORDANCE WITH STATE LAWS.

N

SCALE PLAN 1" = 40'
PROFILE 1" = 40' HOR.
1" = 5' VERT.

A.S. Boicht
J.L.L.
12-83

B.M. 111.75 R.R. SPIKE S. FACE P.P. AT NW. CORNER OF WACO AND THIRD ST.

B.M. 114.89 "X" CUT ON WEST SIDE OF TRAFFIC SIGNAL BASE AT NW. CORNER WACO AND SECOND ST.

1306.63 - 1187.4 = 119.23

116.5 - 1187.4 = 1303.9 - RIM

108.35 - 1187.4 = 1296.75 - FLD OUT

PROJECT DESCRIPTION
LATERAL RELOCATION IN DISTRICT Y, S. S. NO. 28 ON WACO SOUTH OF 2nd ST. IN CONN. WITH FARM CREDIT BANKS OF WICHITA ADDITION
PROJECT NUMBER 824-36-626-58131-438-865-000
BOOK NO. TCD-4 | APPROVED BY | DATE 4/83
DRAWN BY LOOMIS | REVISED
CITY OF WICHITA
DEPARTMENT OF ENGINEERING
DIRECTOR OF ENG./CITY ENGINEER R. W. BRIDGEMAN | SCALE 1/1

KANSAS REGISTERED PROFESSIONAL ENGINEER 8217