




PART OF C.F. FOWLER ADD.

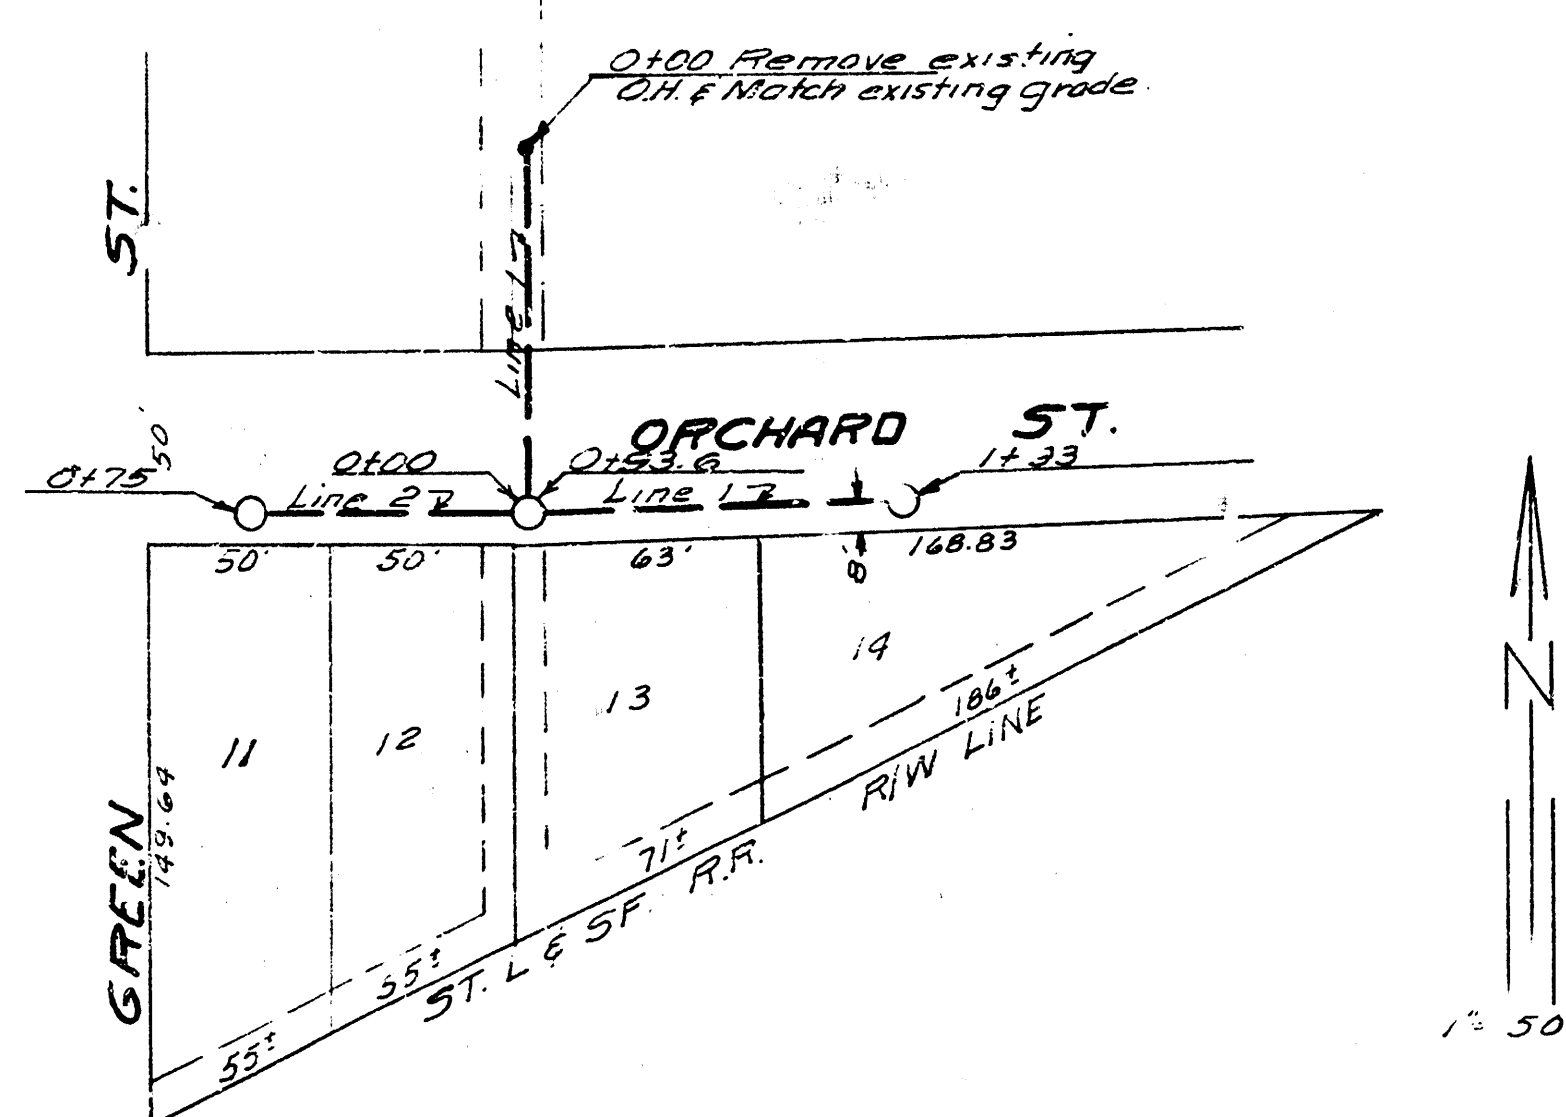


B.M. 123.46 NE cor. conc. walk to house
827 No. Green

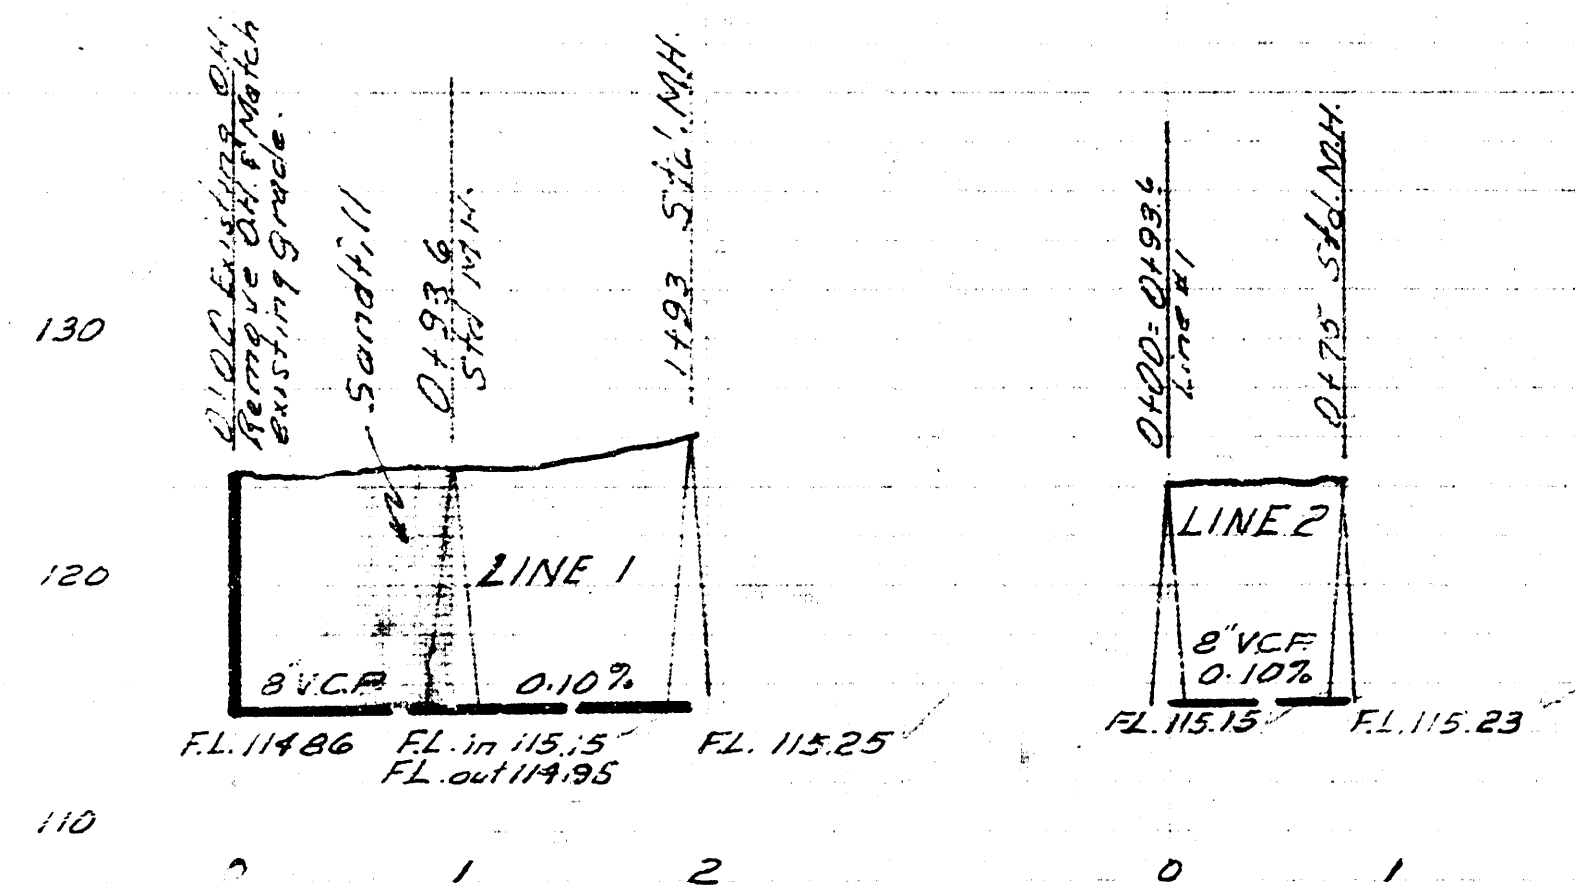


LAT 25 DIST. E 55.12
CITY OF WICHITA KANSAS
B.E. SMITH CITY ENGINEER
Proj. No. C-24-46

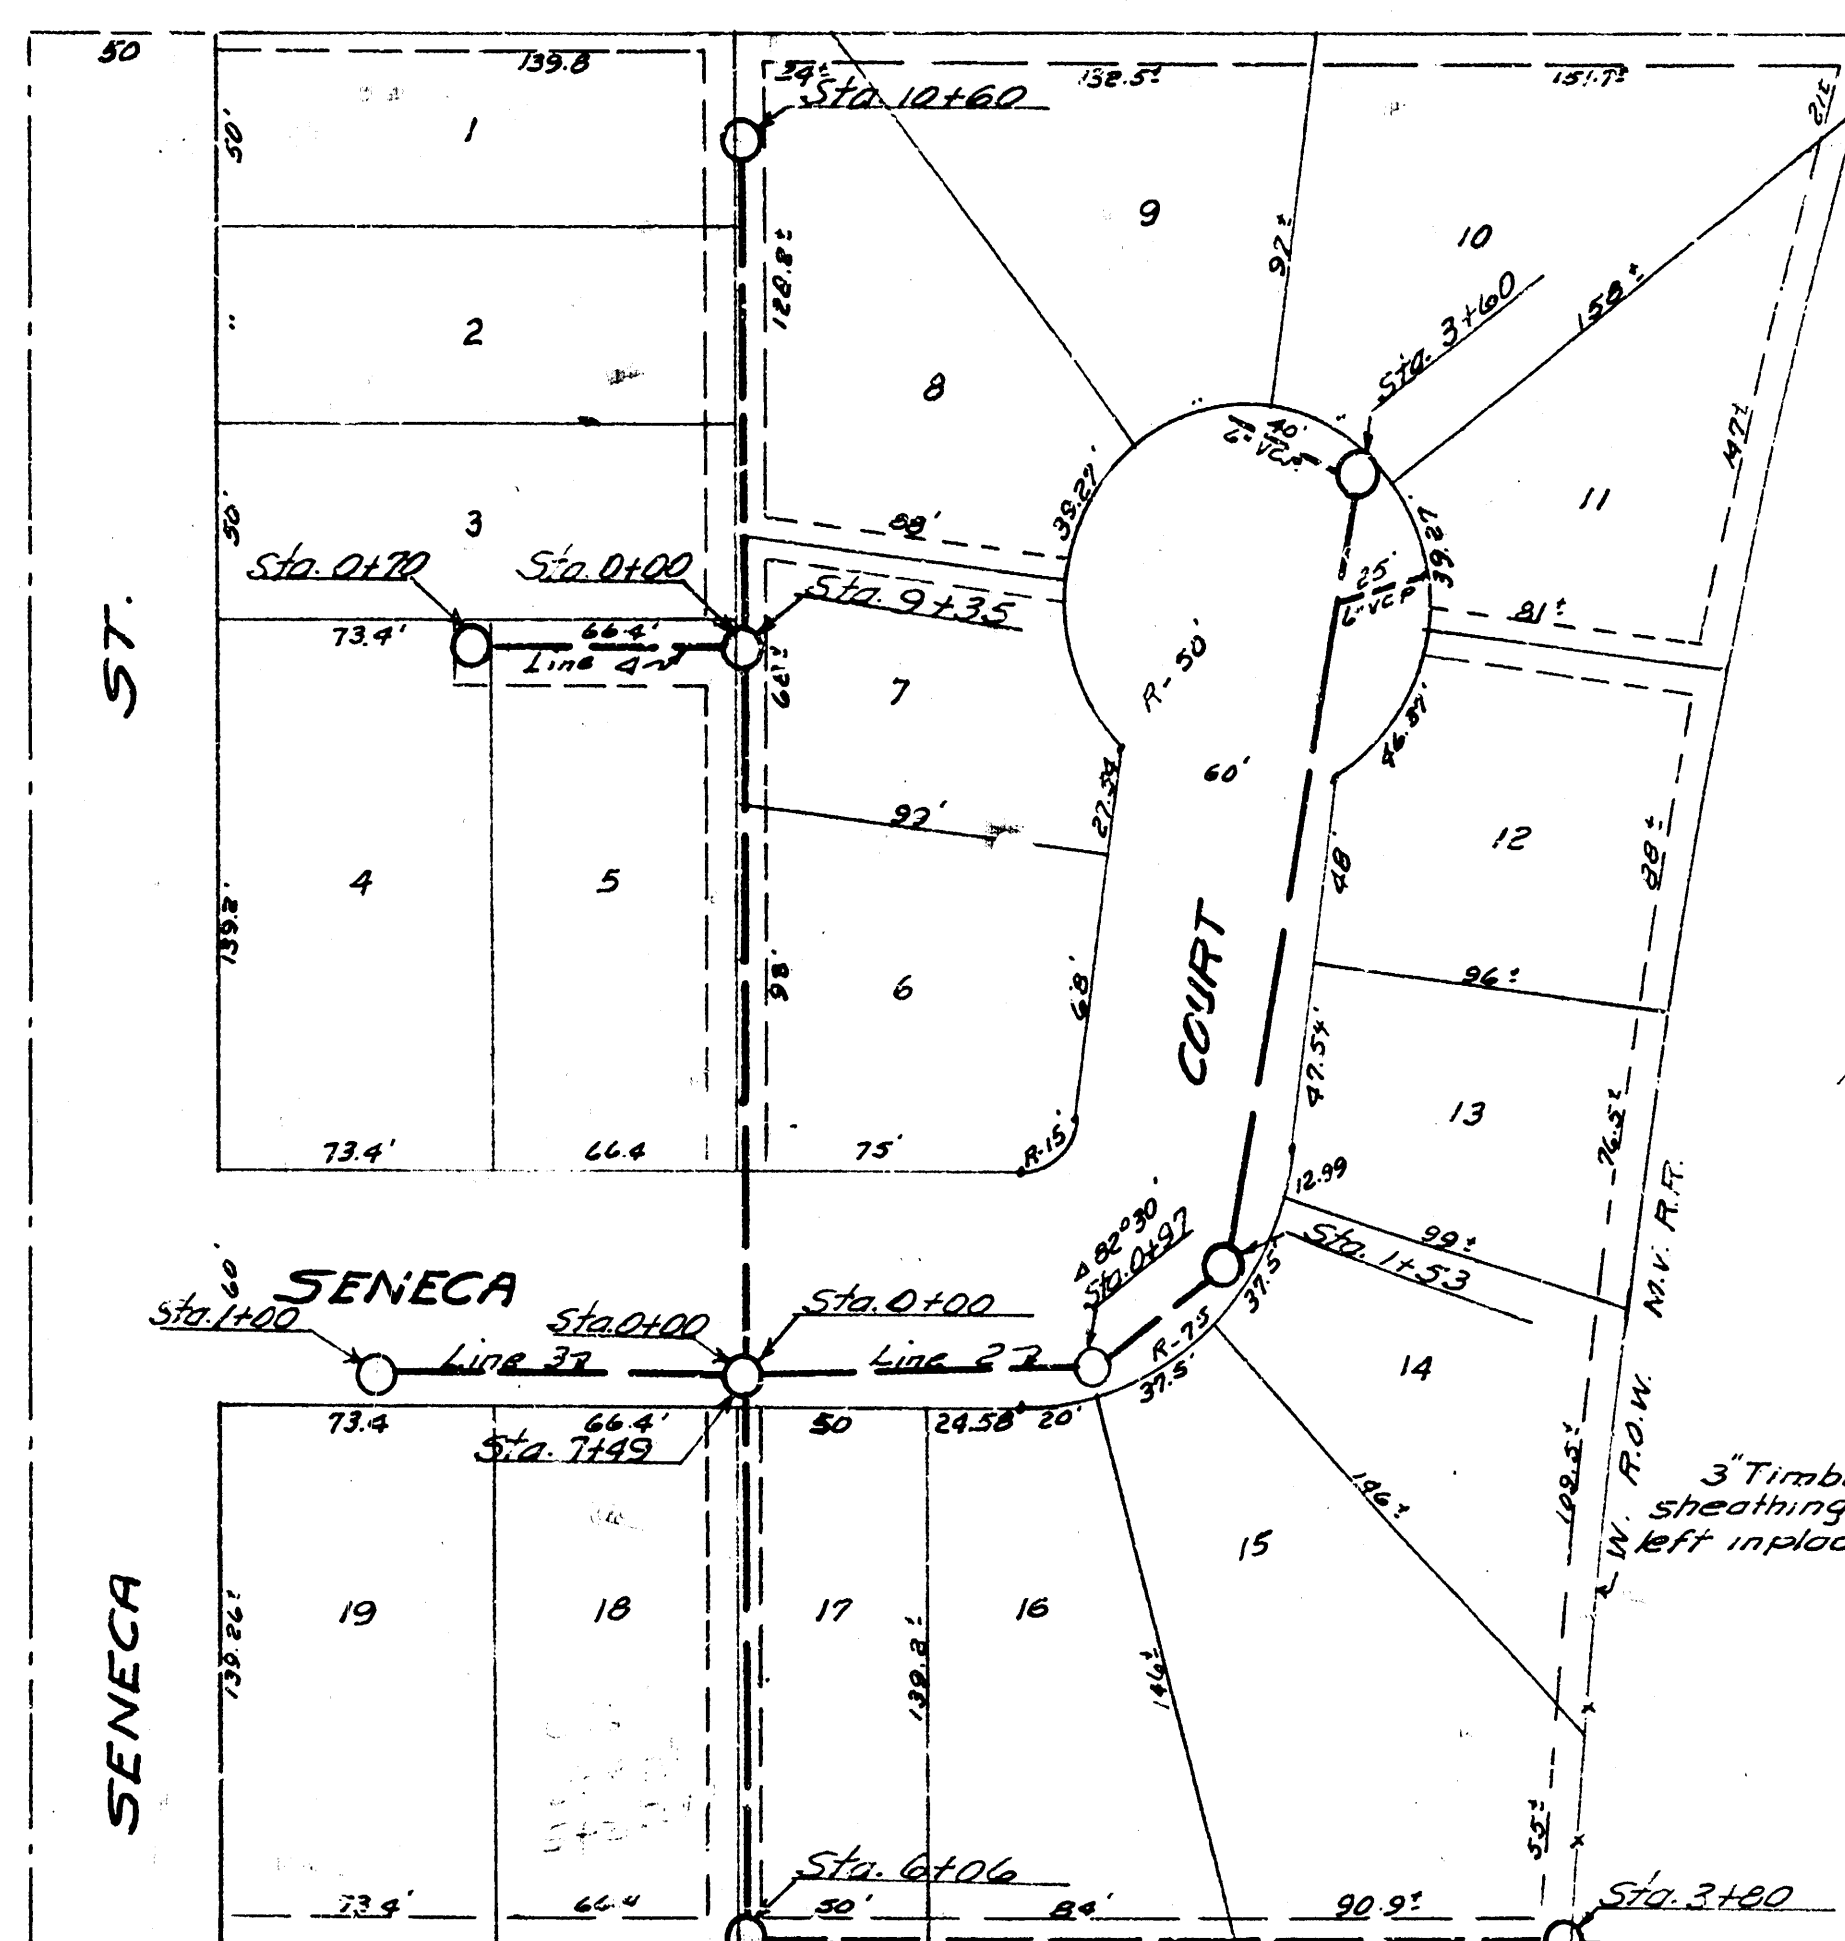

FULGROAT ADDITION

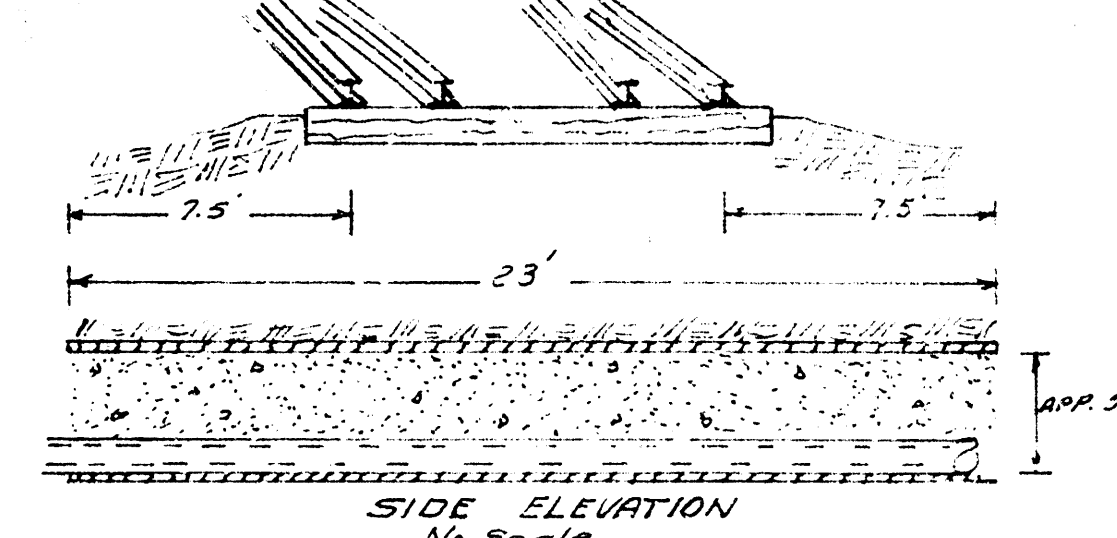


Top of rail El. 108.287
Bottom of rail El. 107.750
Bottom of track El. 107.250

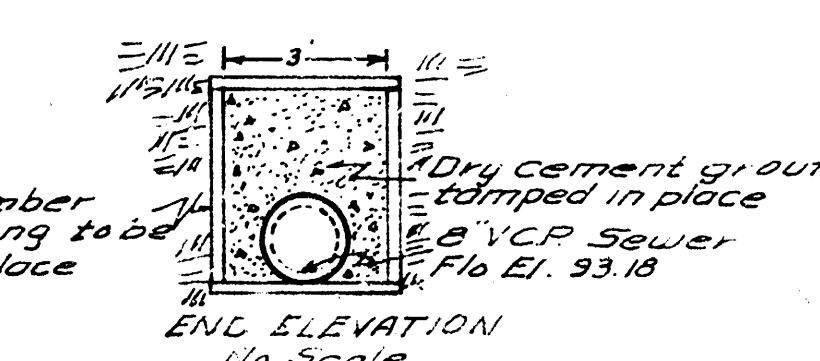

TUNNEL DETAIL

B.M. 101.20 "X" on S.C.B. Estimer & W.S. Seneca
100.74 South rim of Mtl. 12.78 north 0400
Line #1

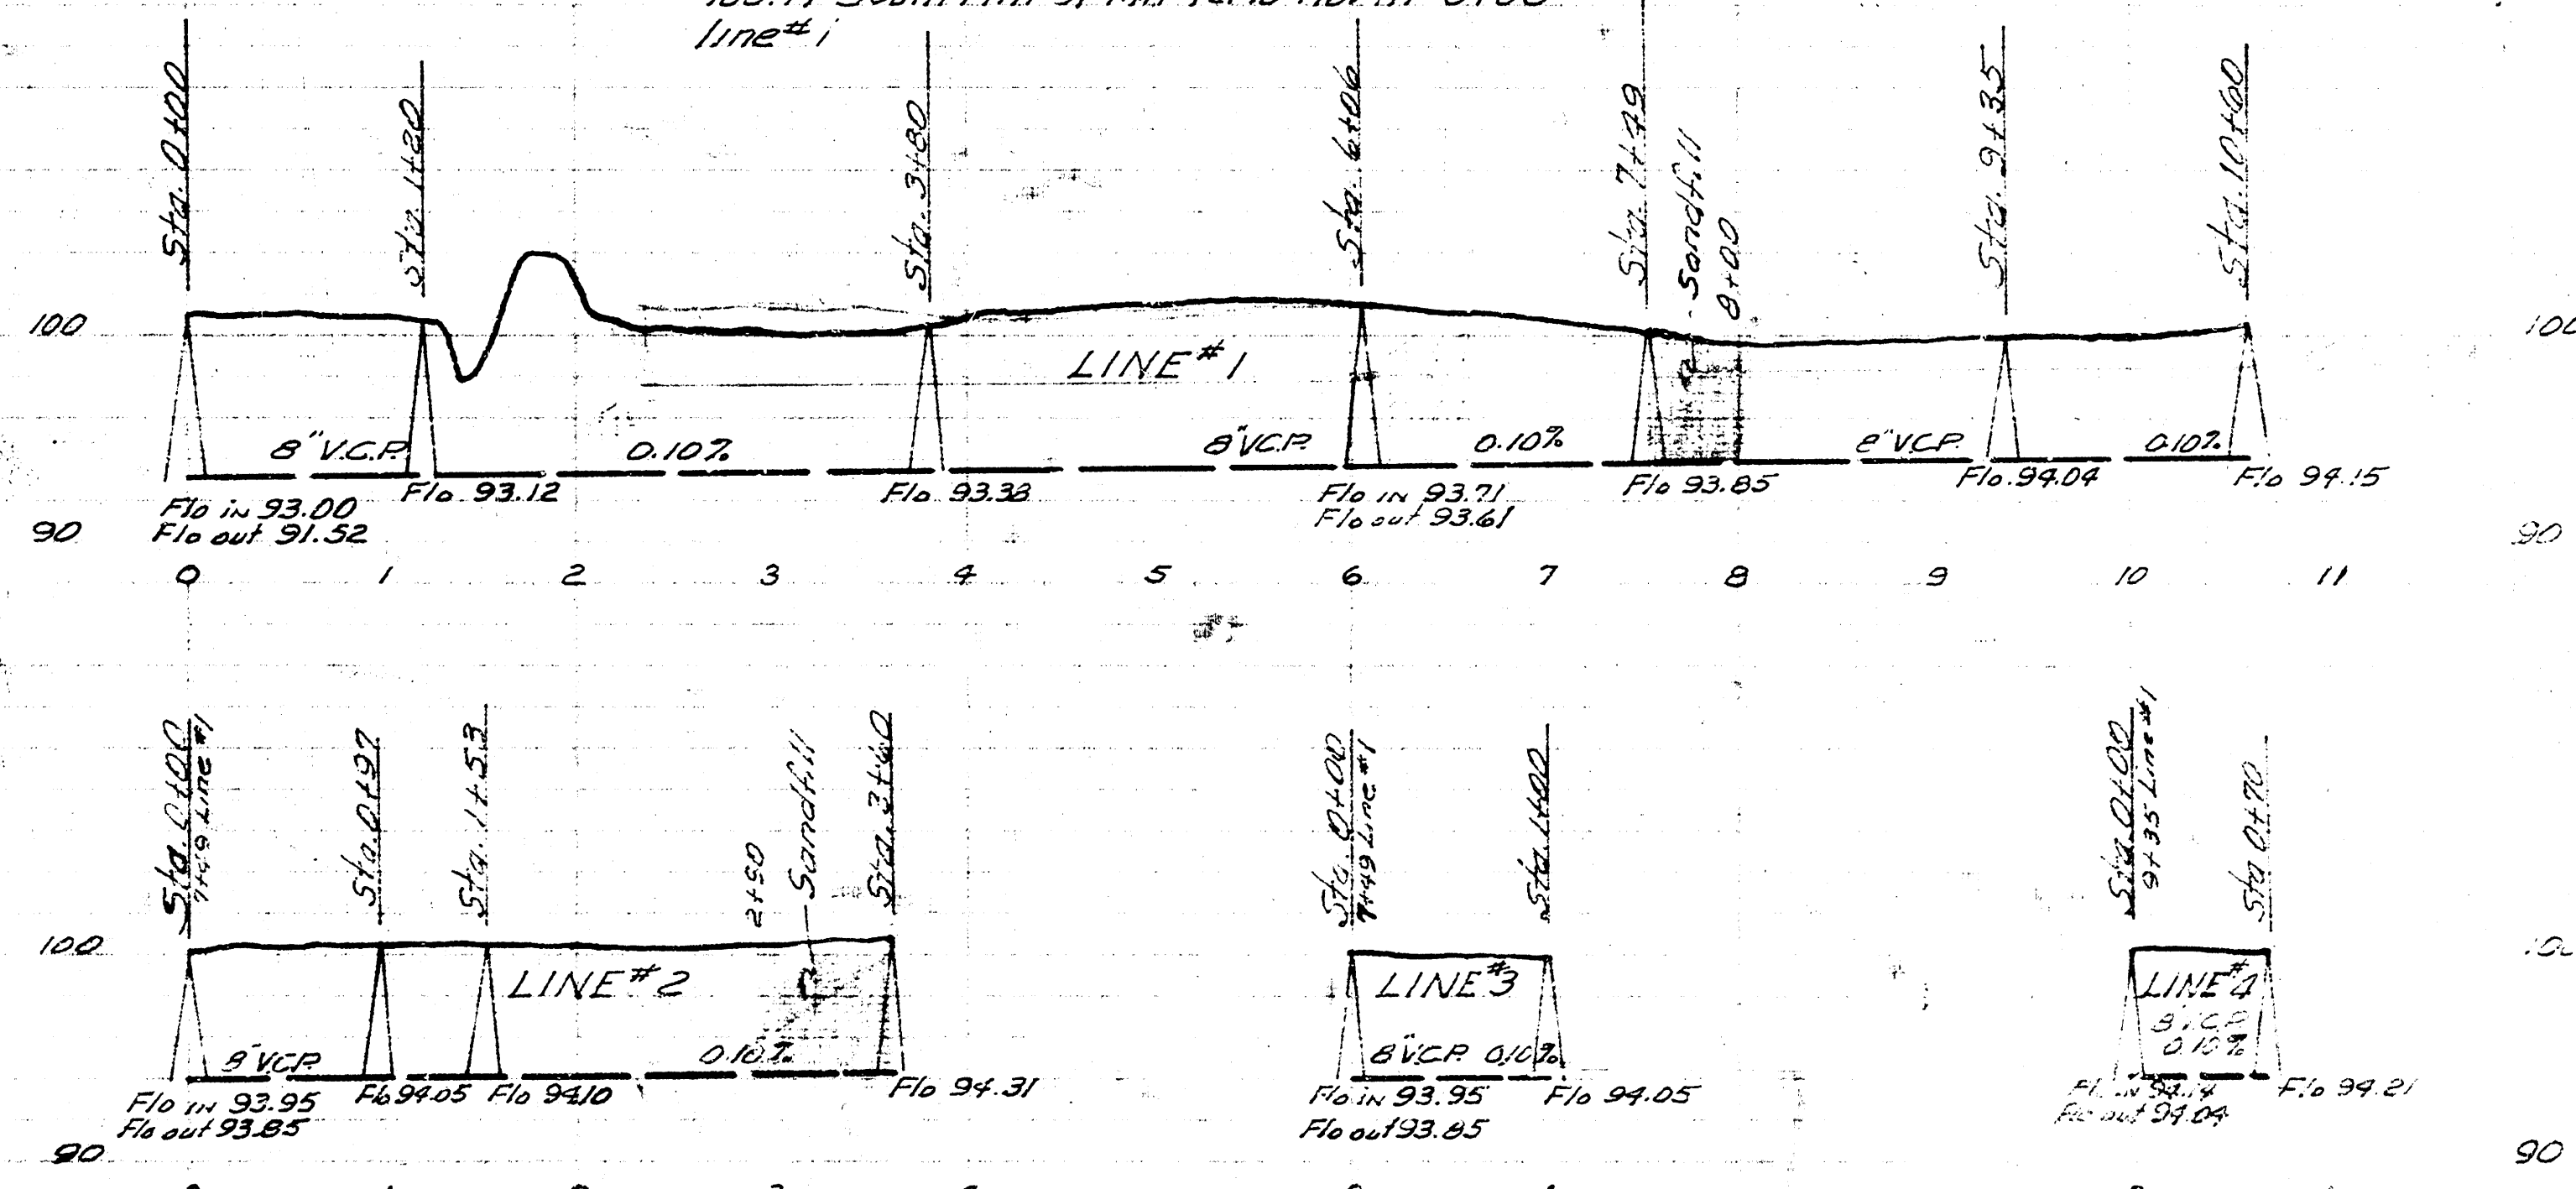

LAT 4 DIST. E 55.21
CITY OF WICHITA KANSAS
B.E. SMITH CITY ENGINEER
Proj. No. C-24-52