




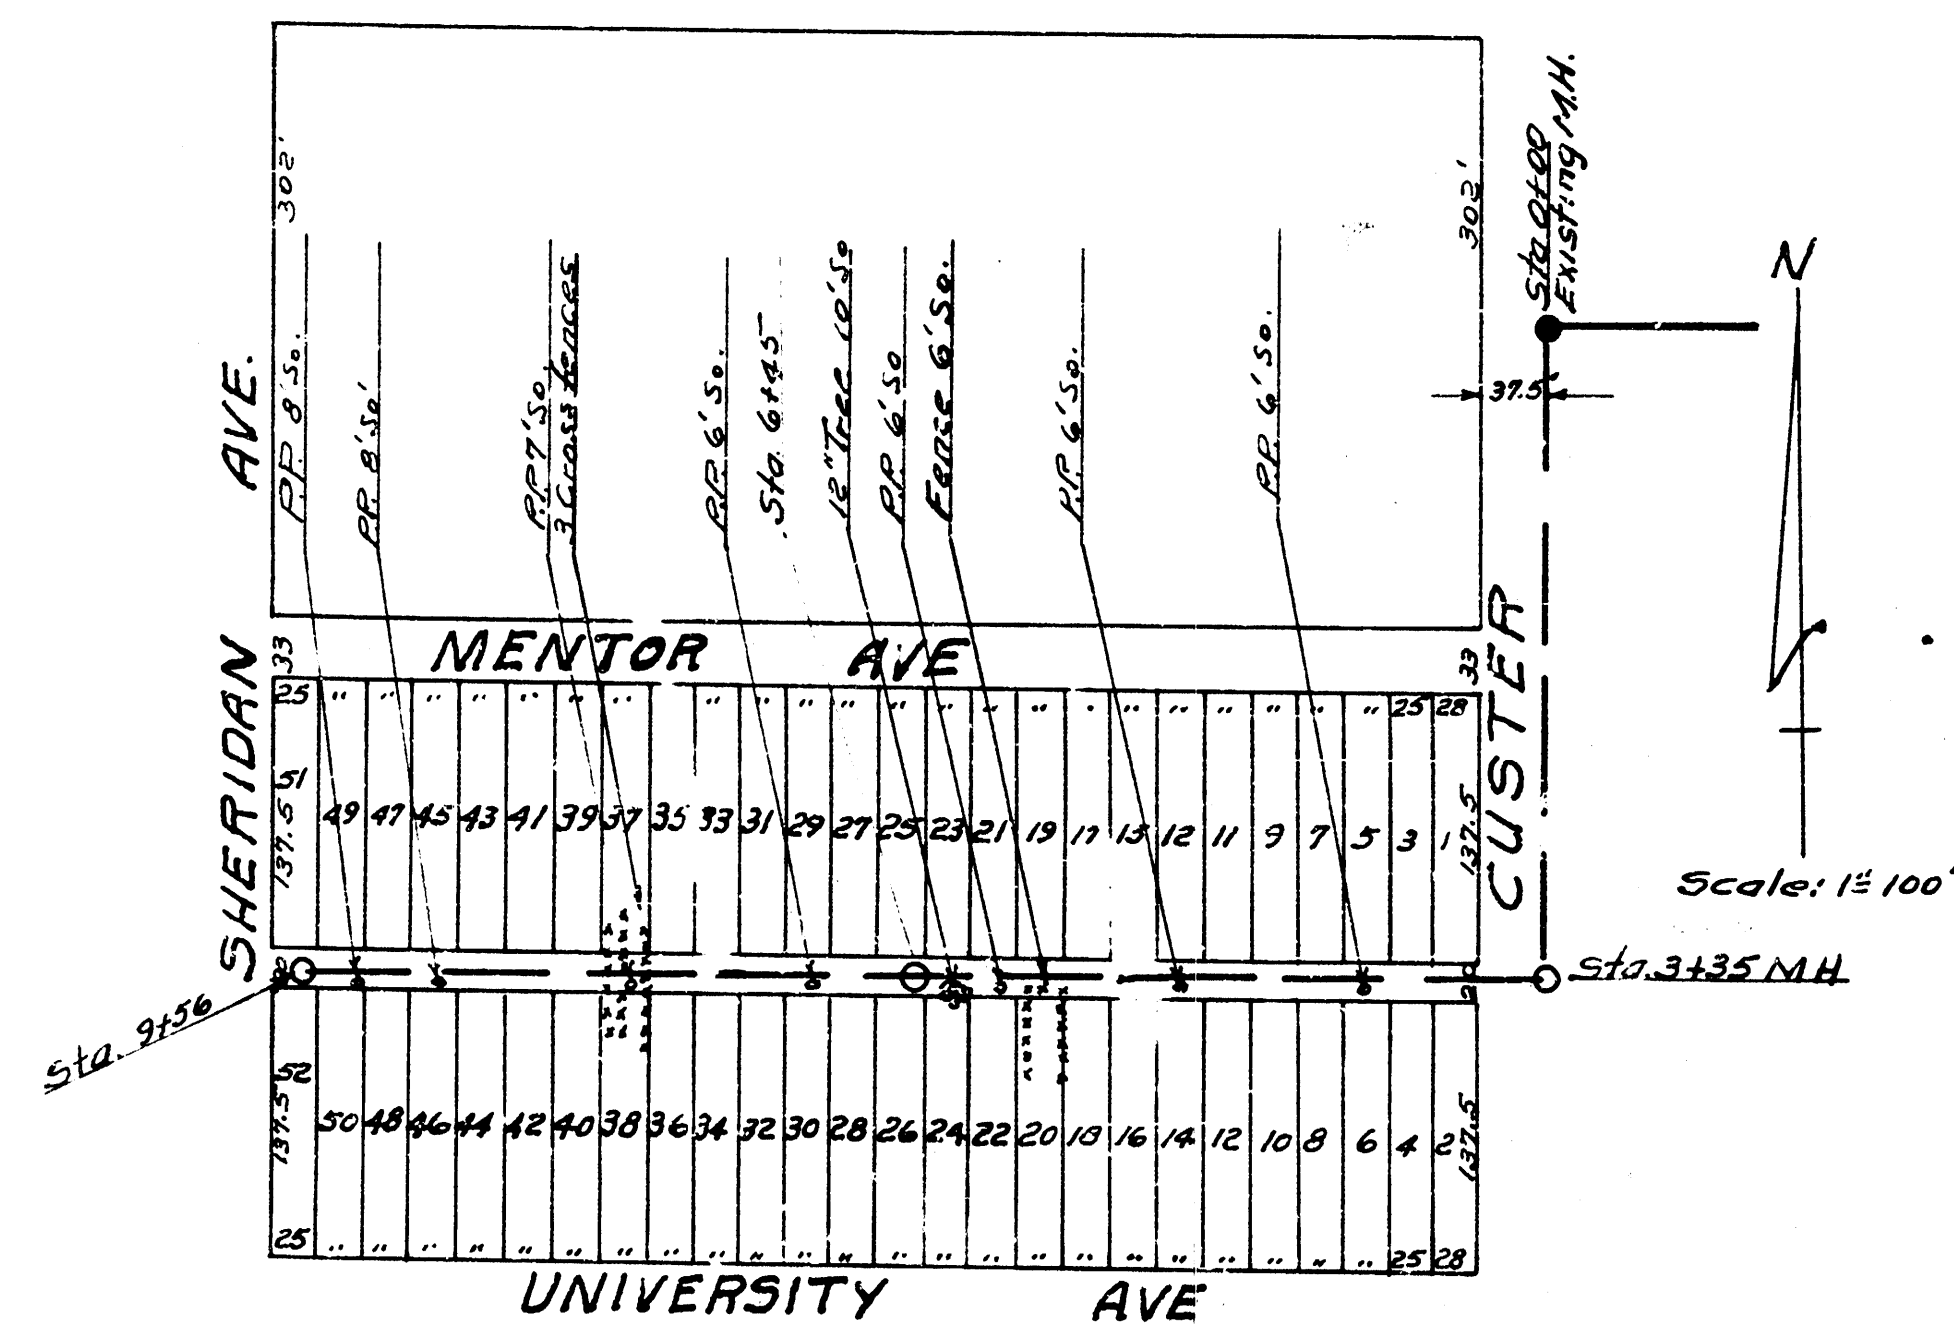


BM. 114.18 T.p. MH 0+00 So. Rim.

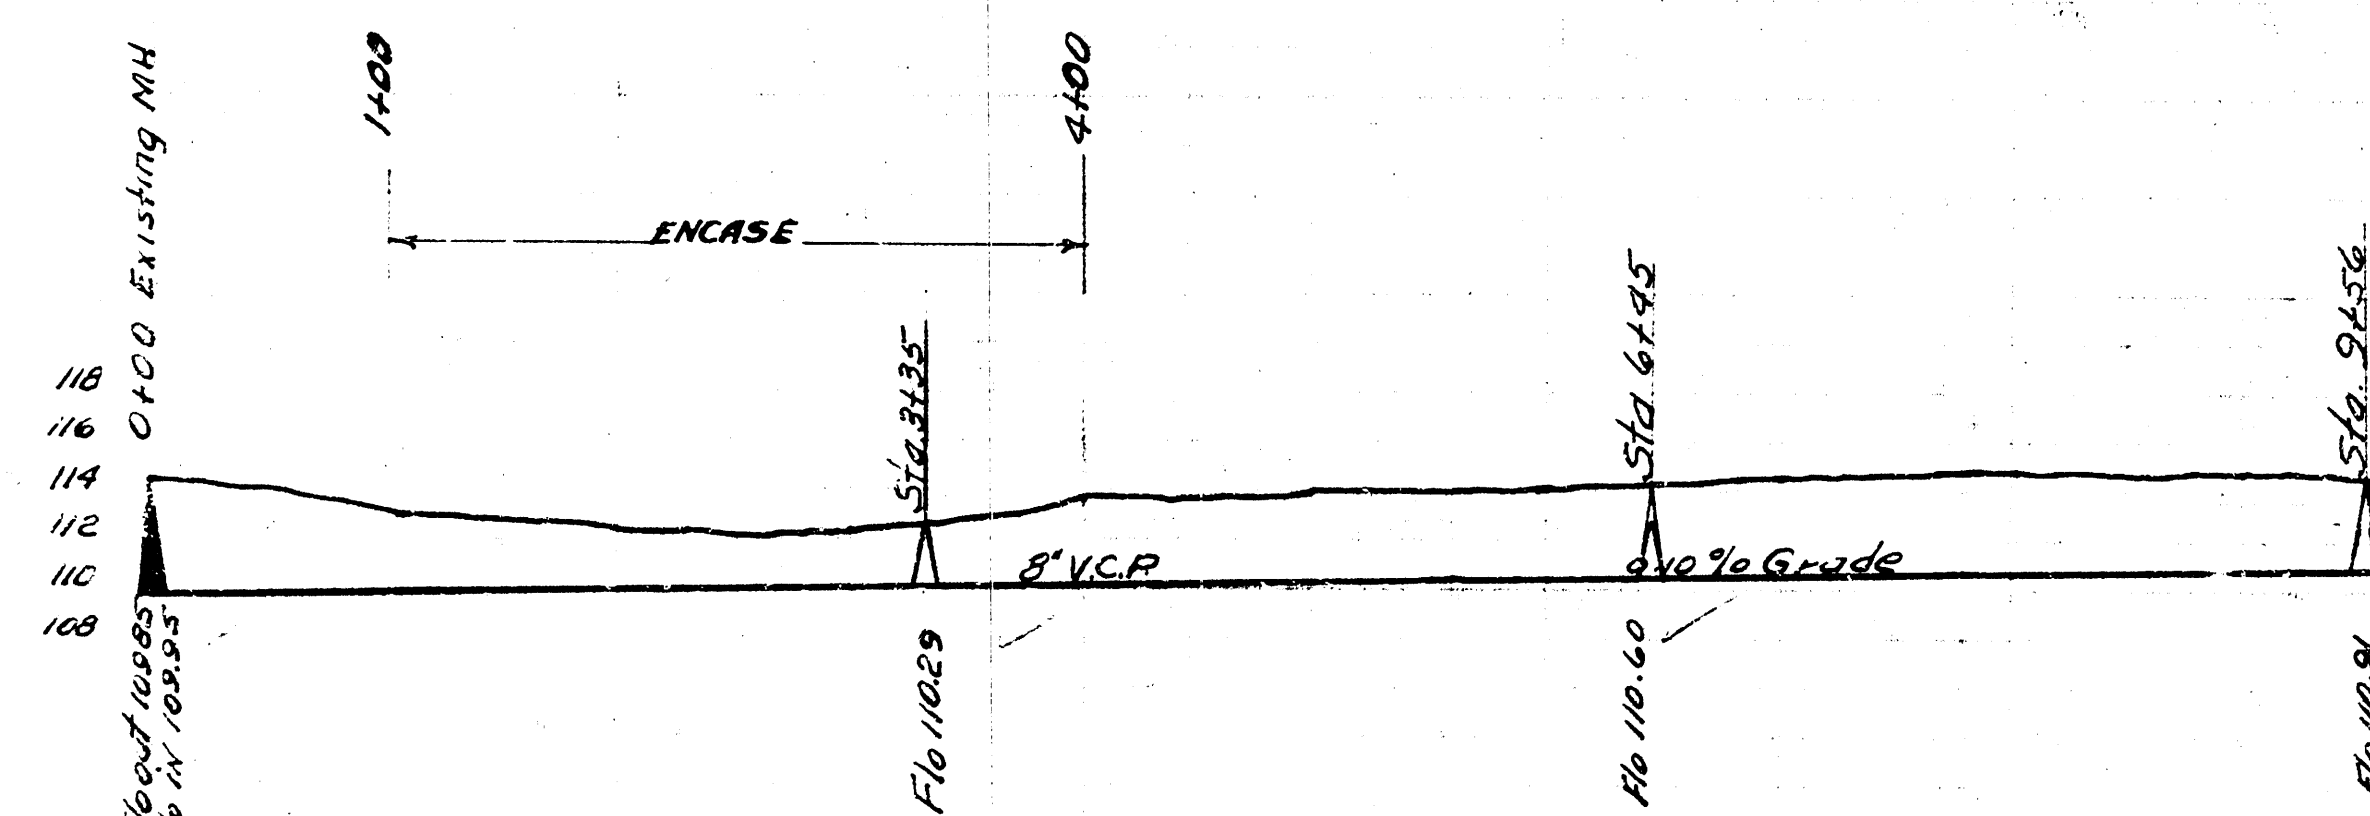

LAT 29 DIST A SS#21
CITY OF WICHITA KANSAS
LX WHITE CITY ENGINEER
Proj No. C-21-55

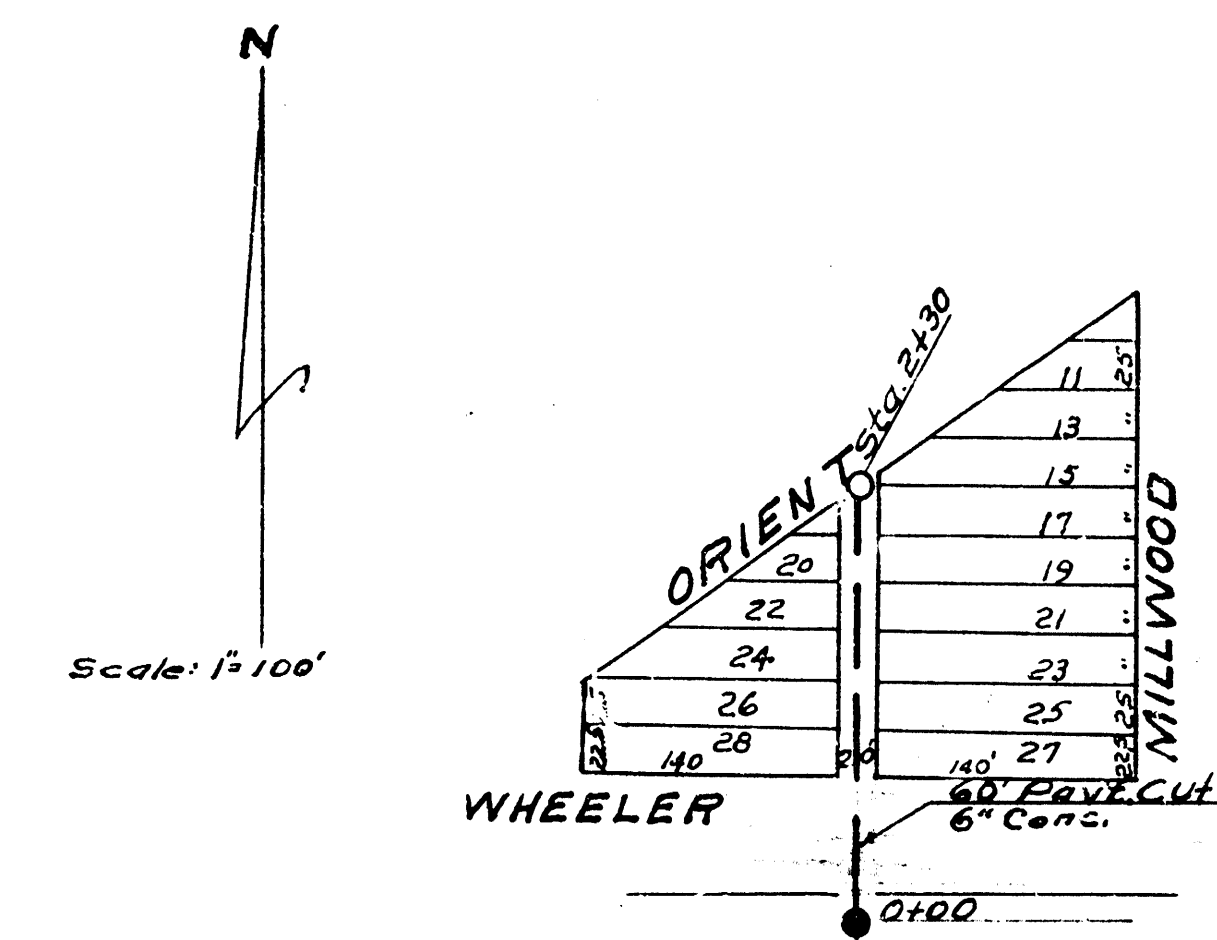

BM. 104.40 So. Rim M.H. 0+00

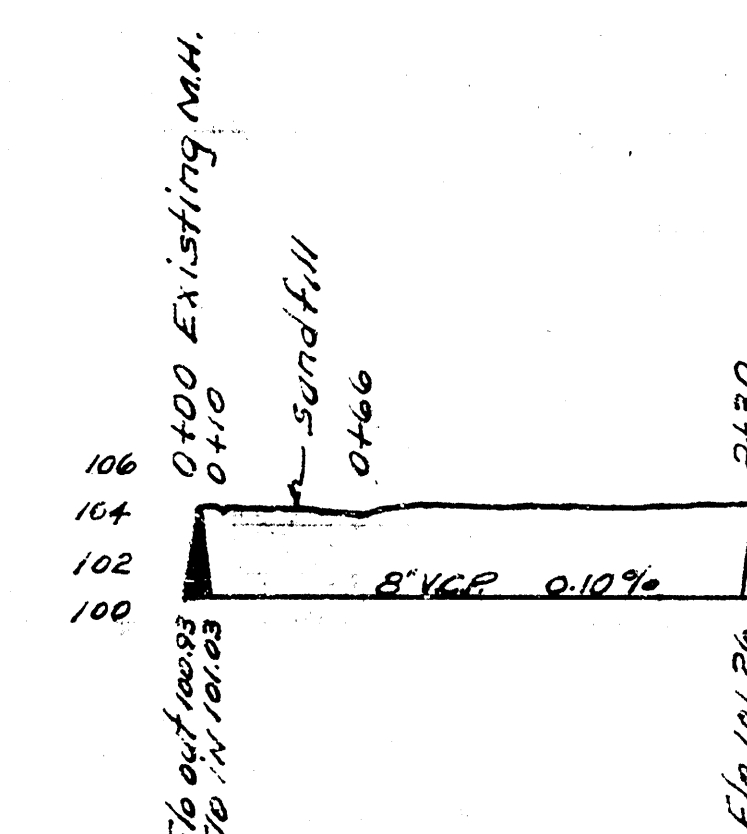

LAT. T. DIST. E. SS#21
CITY OF WICHITA KANSAS
LX WHITE CITY ENGINEER
Proj No. C-21-67

Date 2-4-52
Drawn by L. McCL
Checked by G-1
Book No.

Date 2-4-52
Drawn by L. McCL
Checked by G-1
Book No.