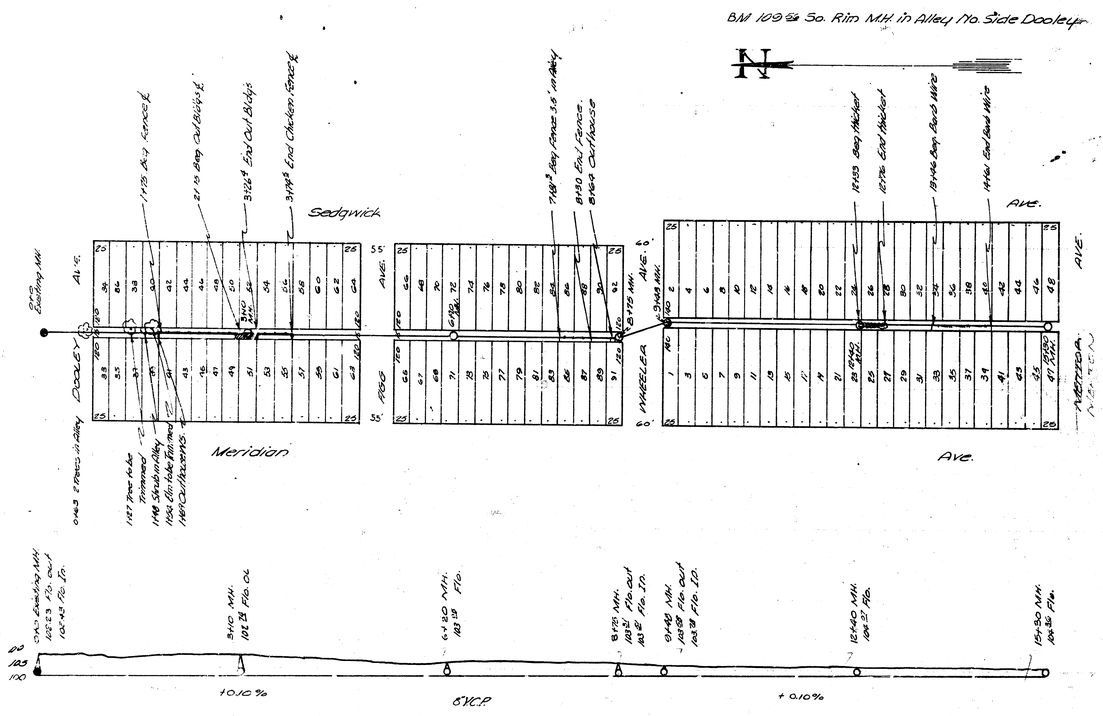

Lot 4, Dist B, Main 21

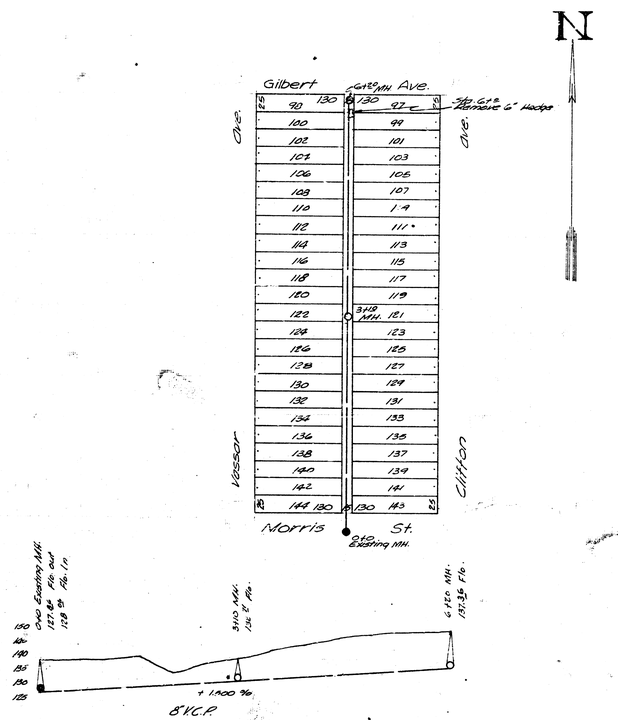

Lot 13, Dist. G, Main 12

LAT. 4, DIST. B, MAIN 21
LAT. 13, DIST. G, MAIN 12

CITY OF WICHITA, KANSAS
L.R. White — City Engineer
July 1948 Proj. Nos. C 28-1r
C 28-18