


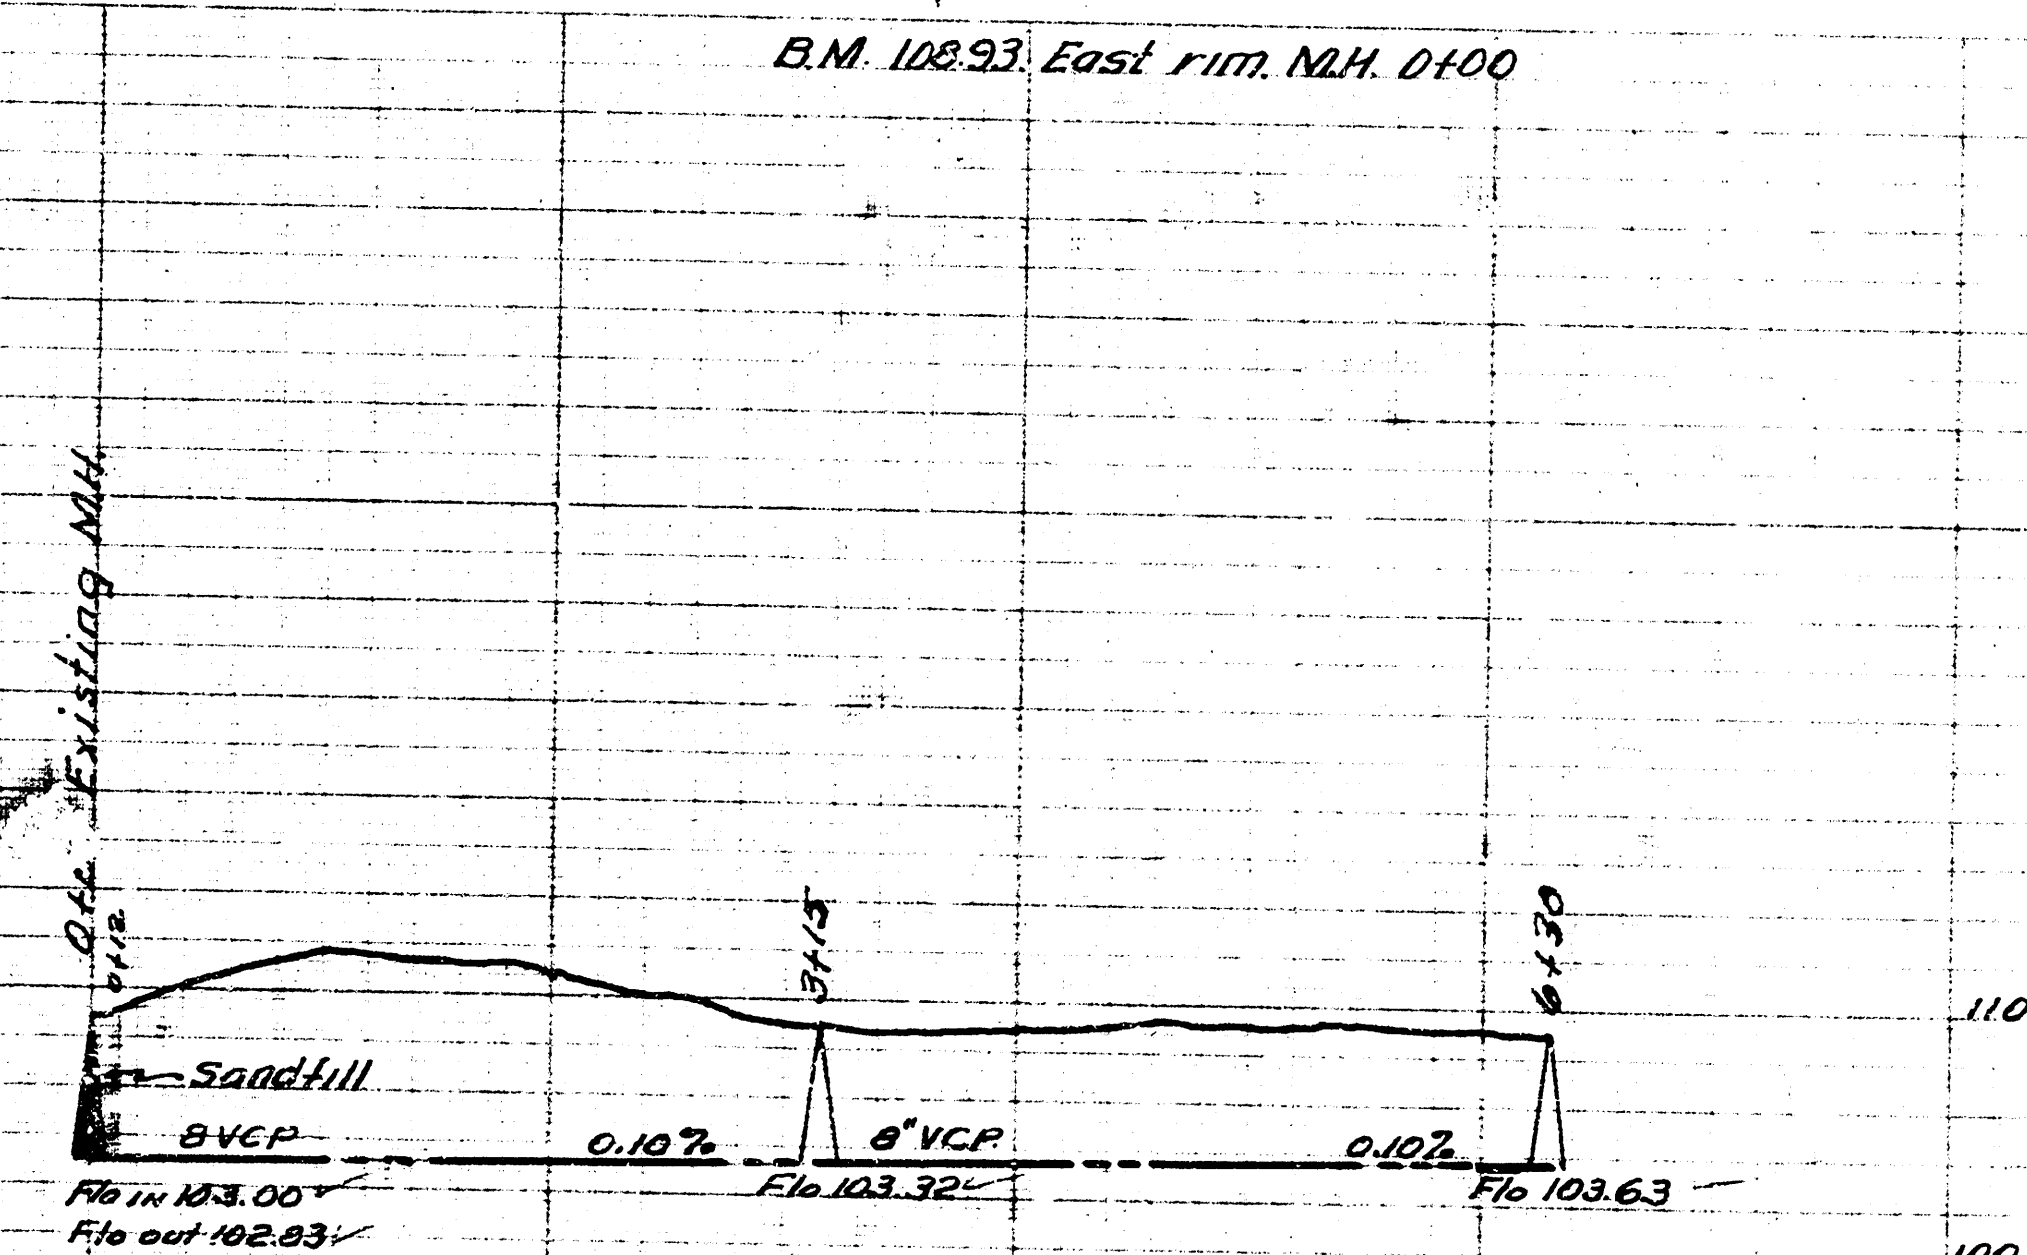
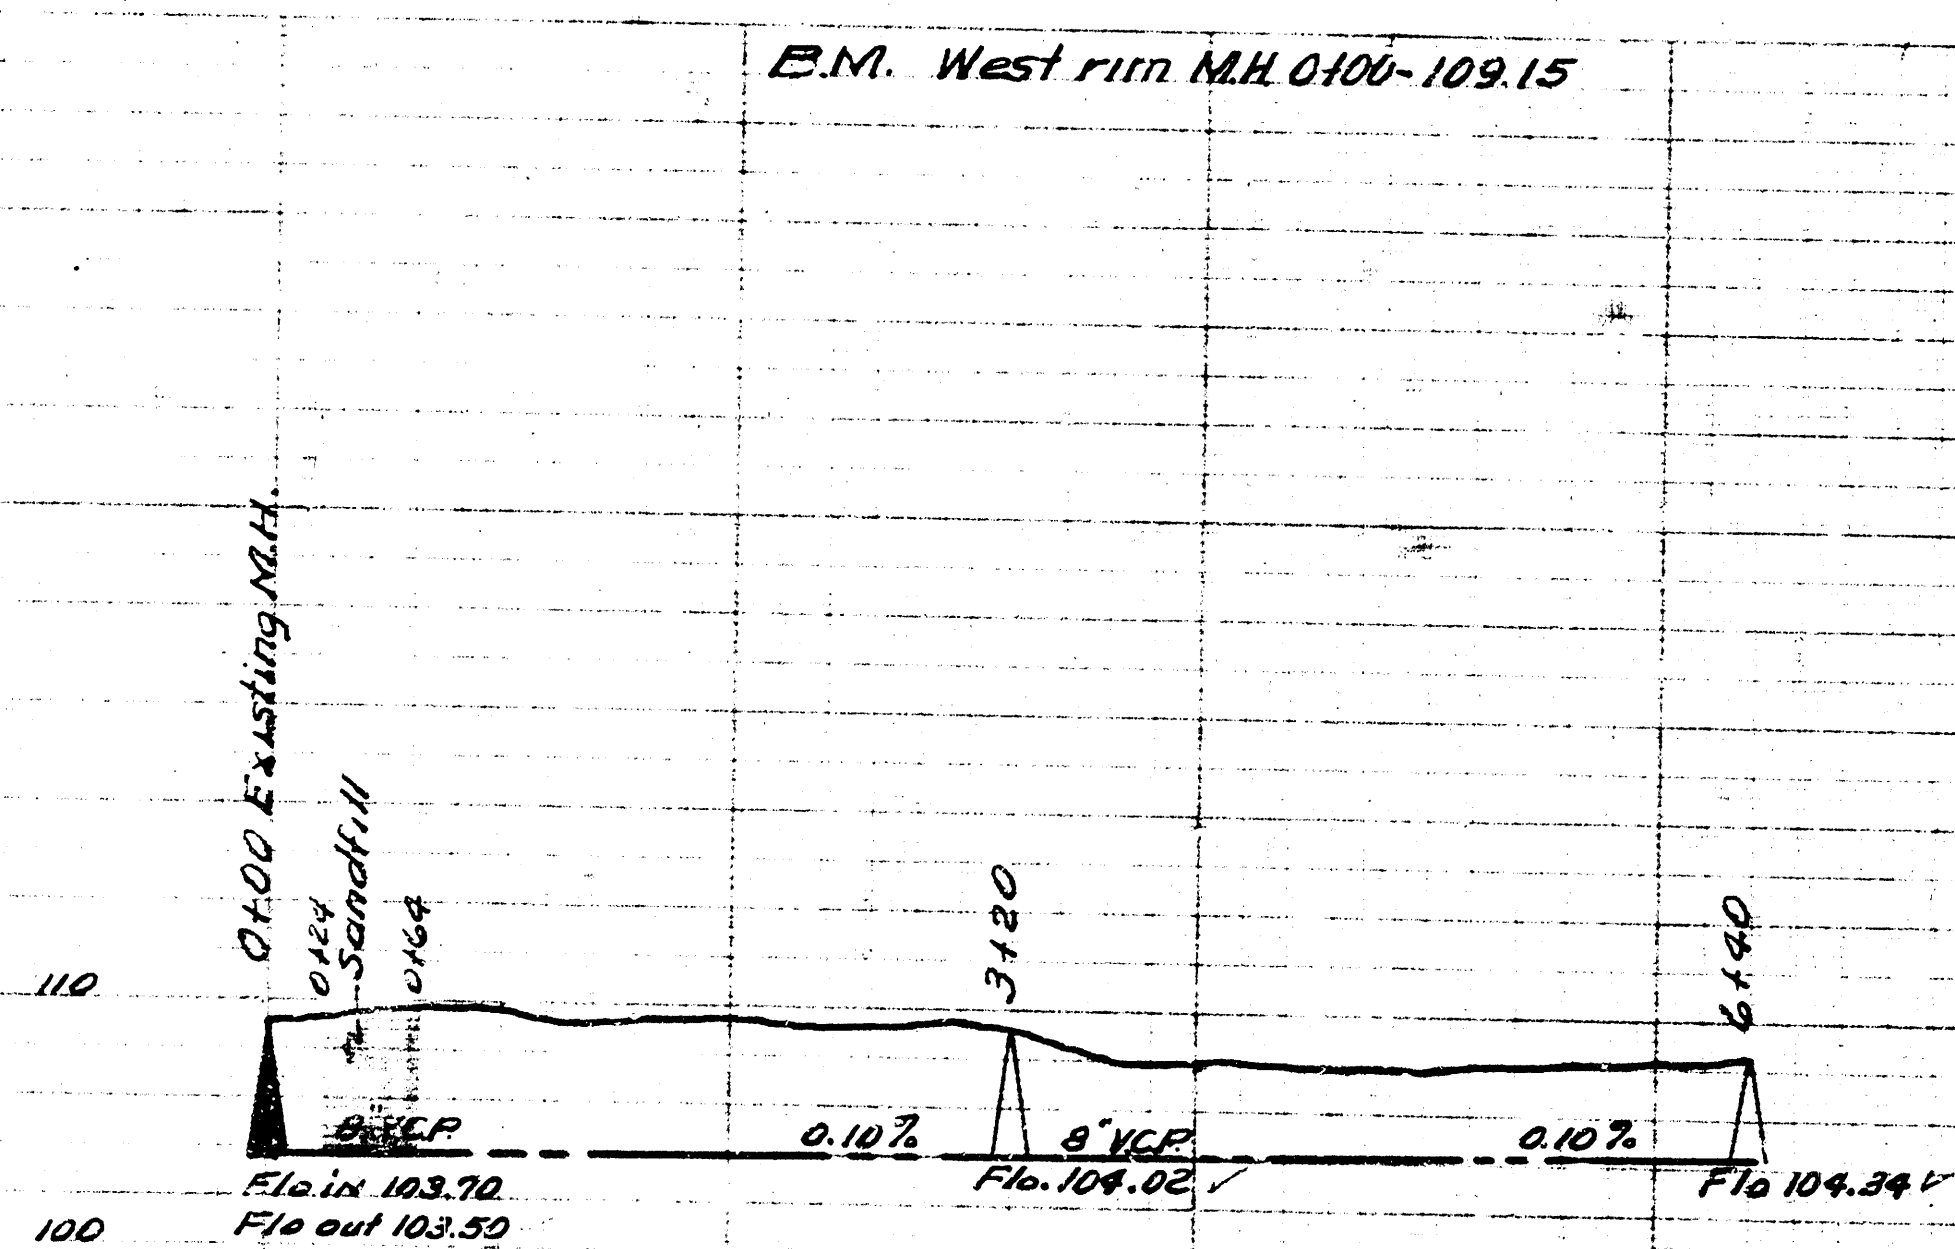


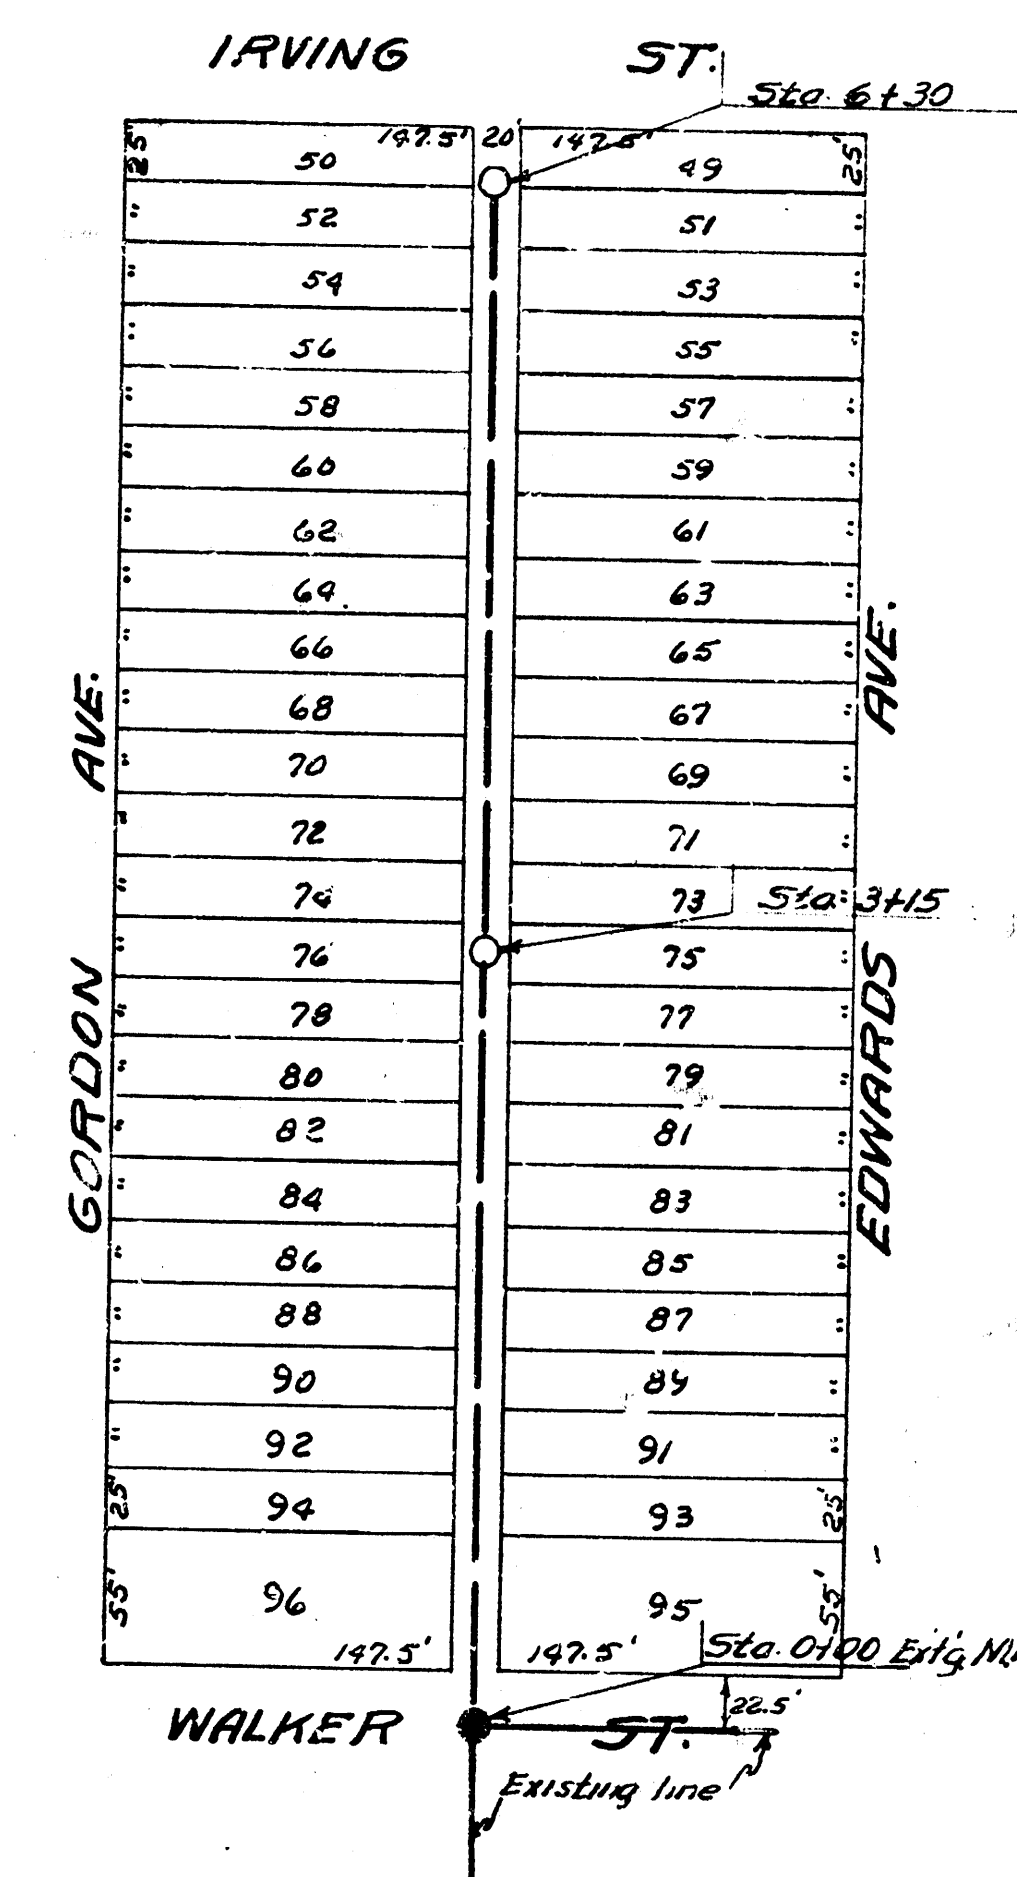

LAT. 12 SUBMAIN B. S.S. 21
CITY OF WICHITA KANSAS
B.E. SMITH CITY ENGINEER
Proj. No. C-23-65

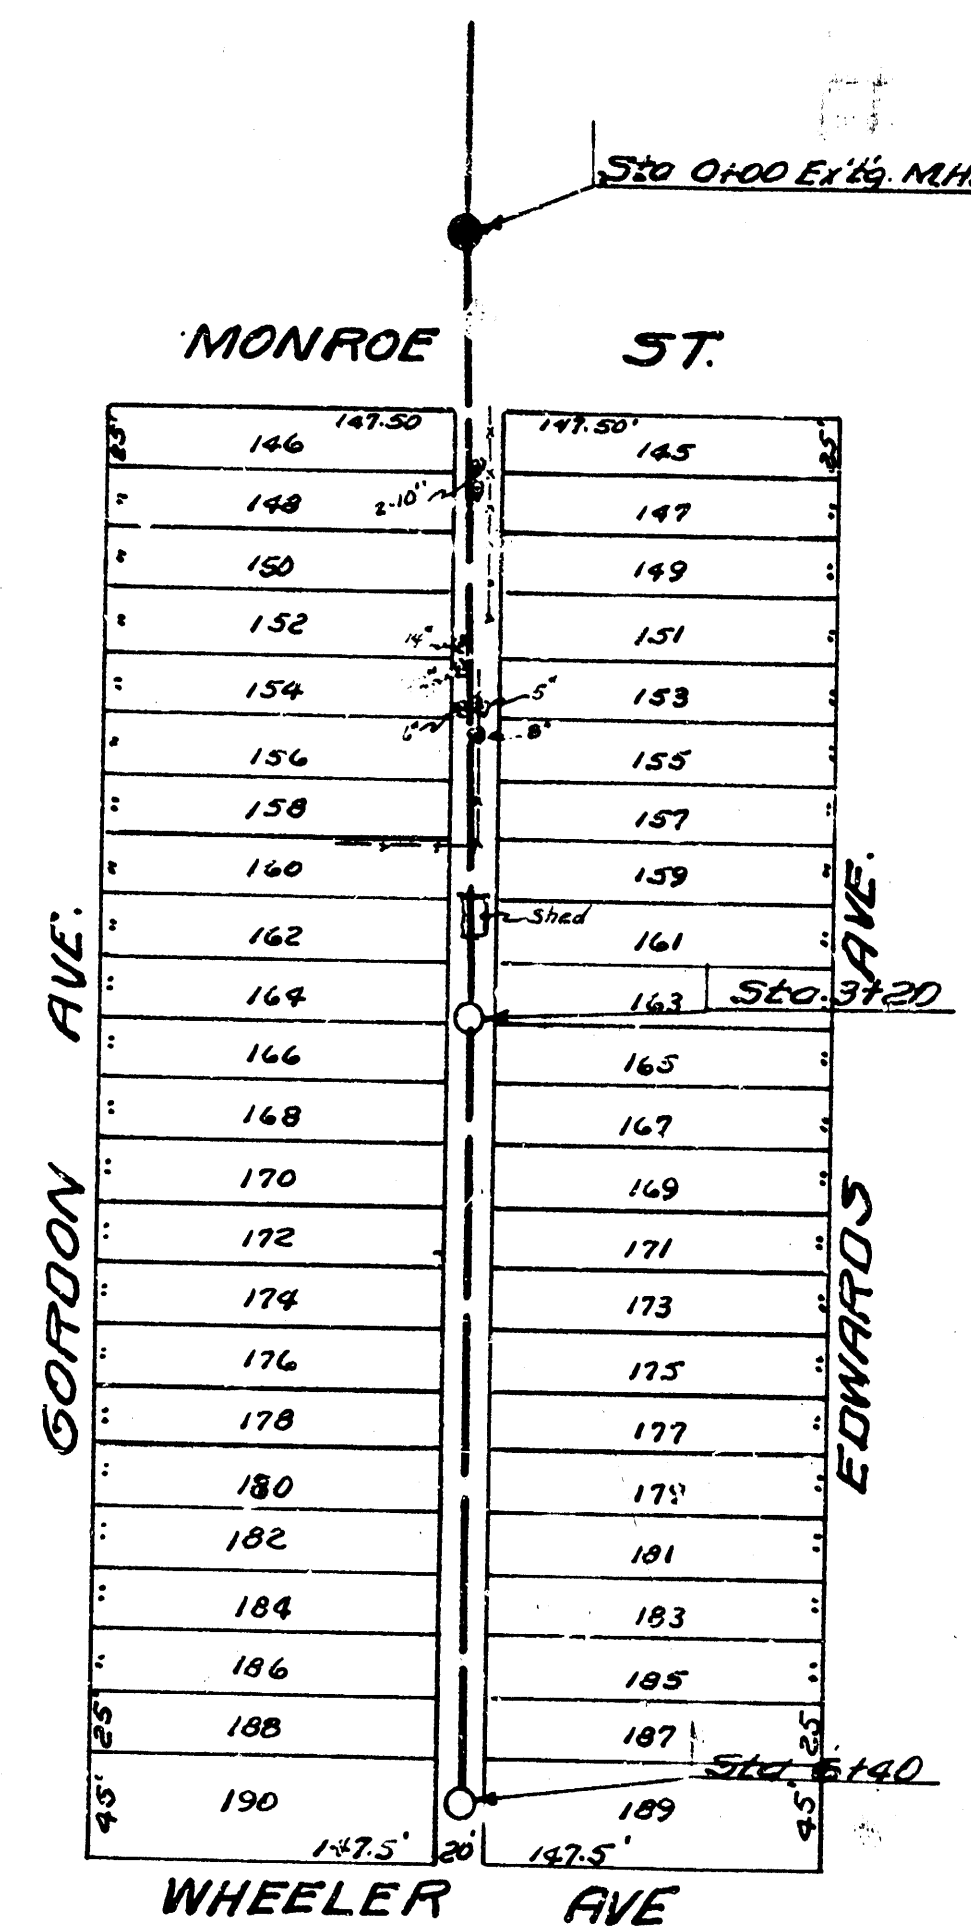

LAT. 13 SUBMAIN B. S.S. 21
CITY OF WICHITA KANSAS
B.E. SMITH CITY ENGINEER
Proj. No. C-23-66

 

Date
12-31-53
Drawn by
McClain
Checked by
Beck No.
H. 60

Date
1-11-54
Drawn by
McClain
Checked by
Beck No.
H. 60