
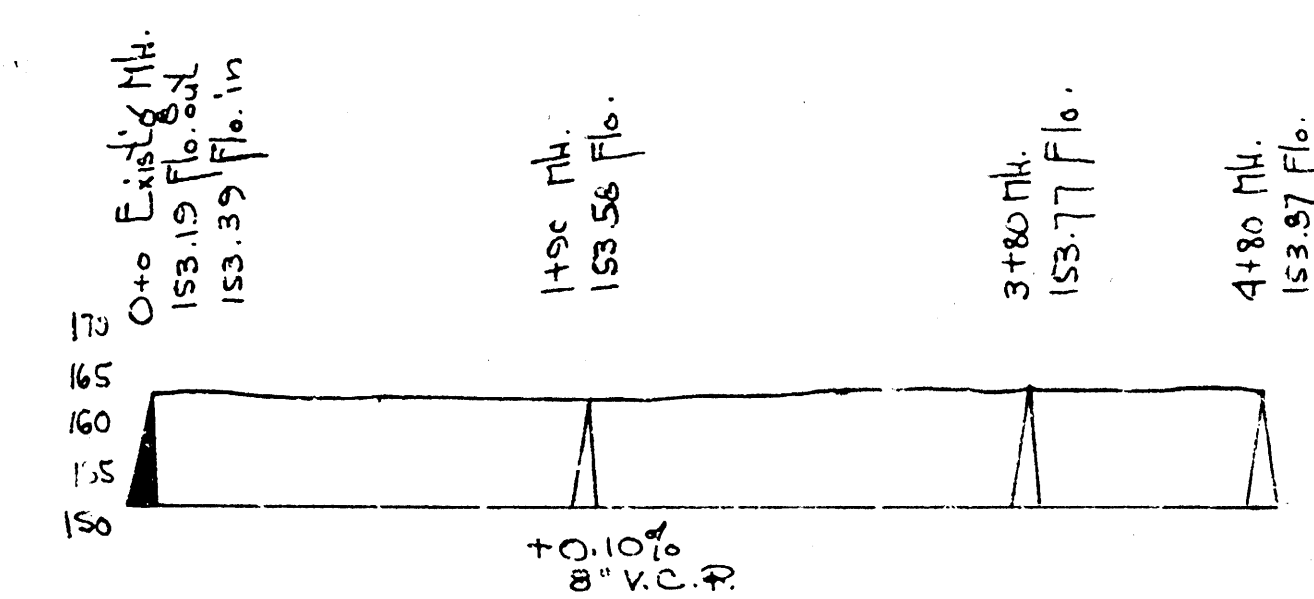
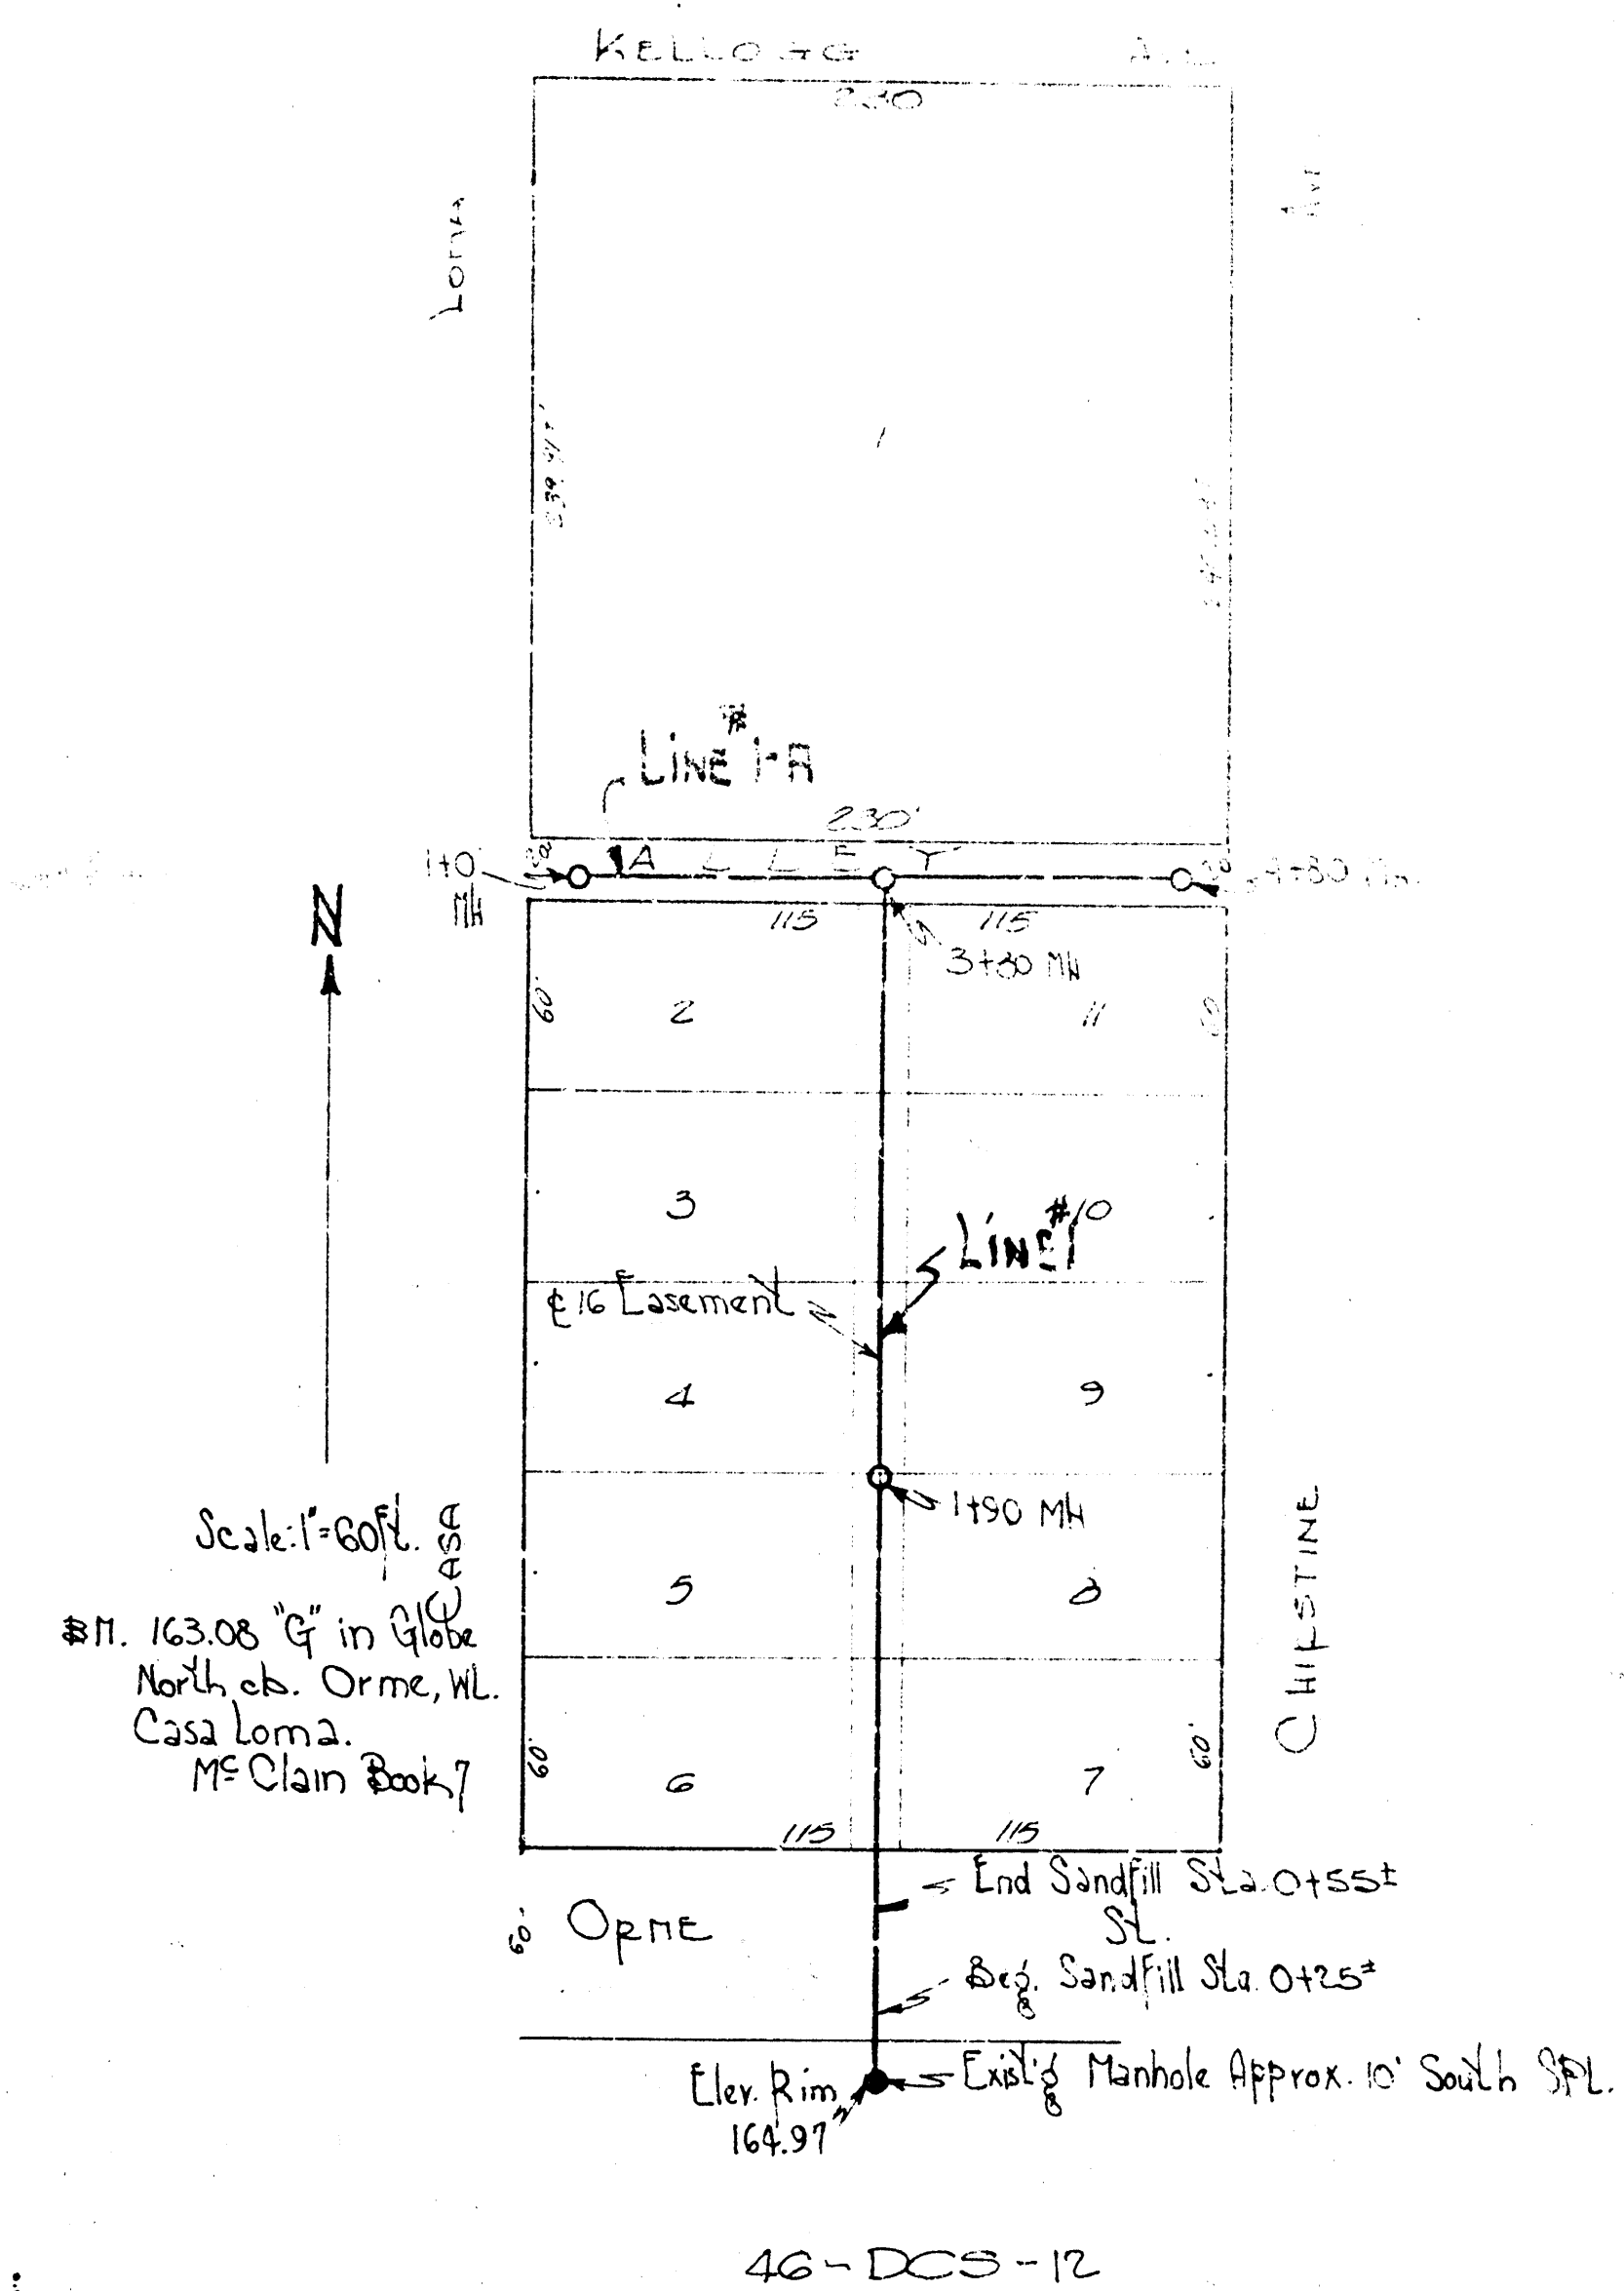
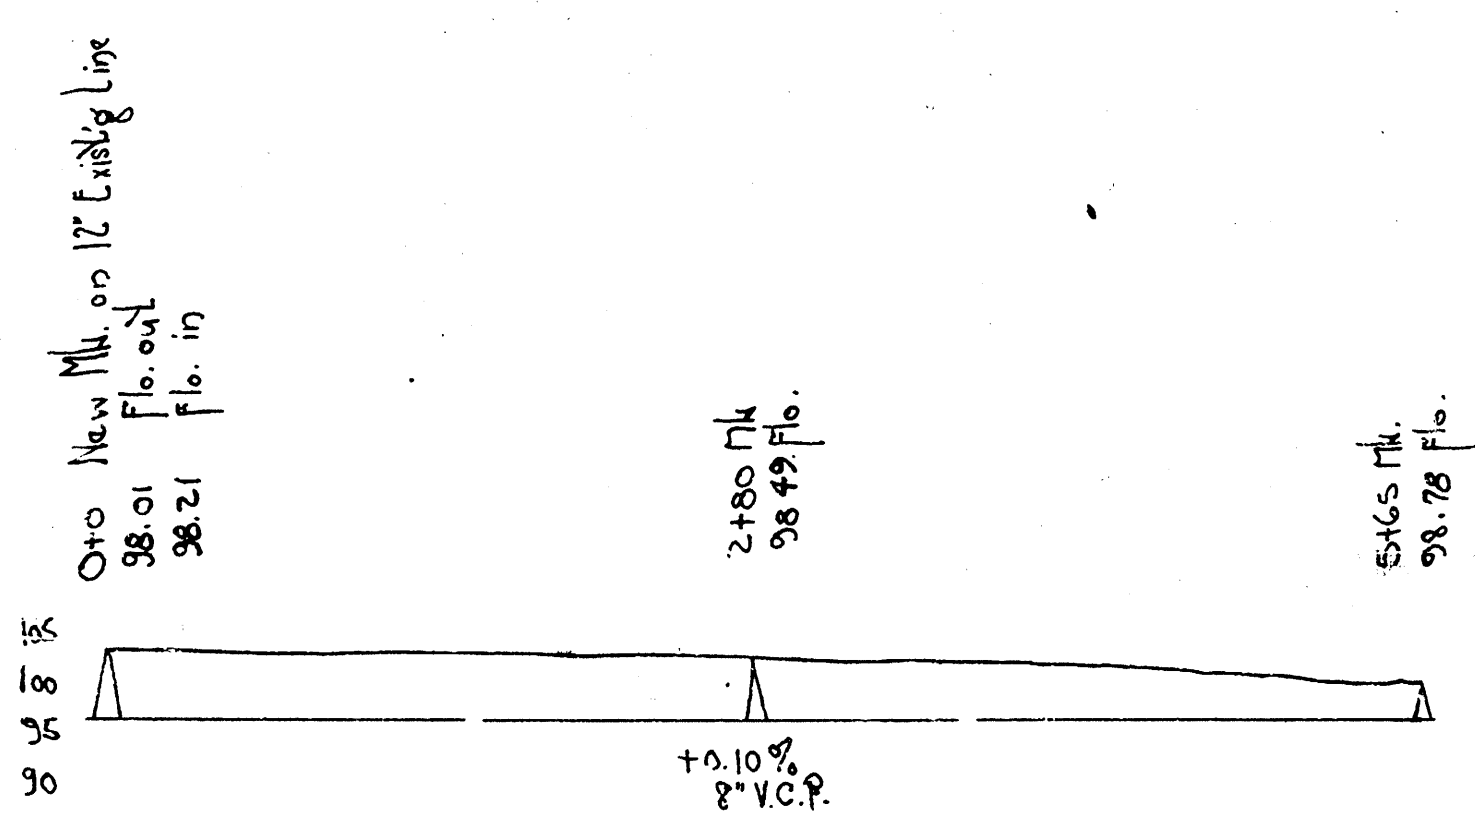
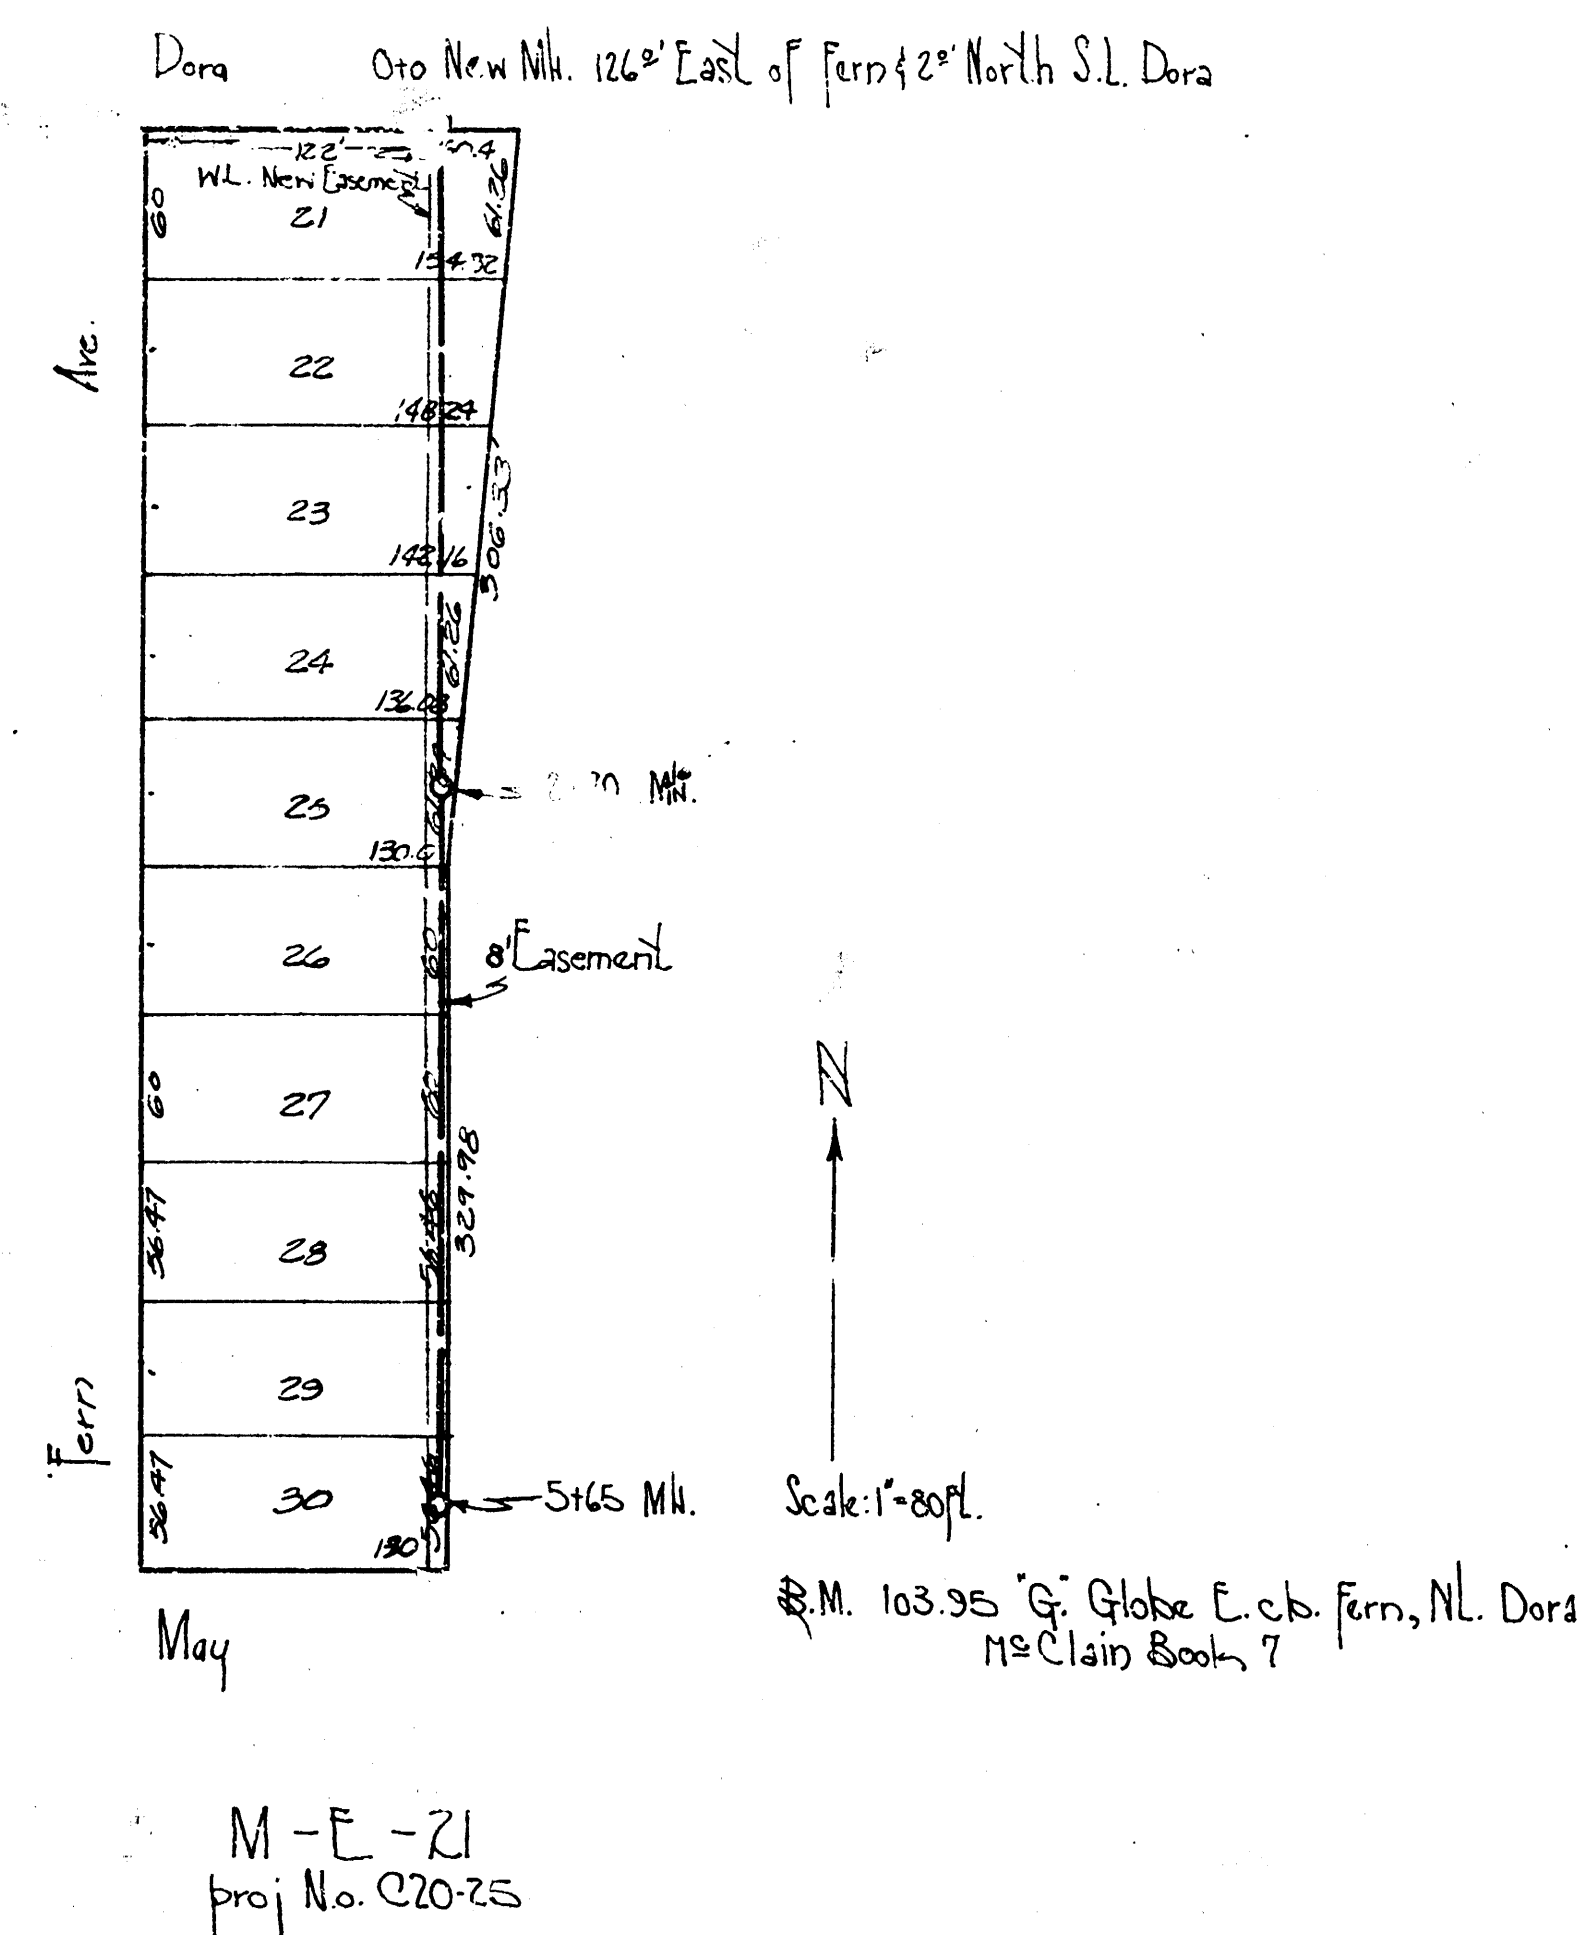
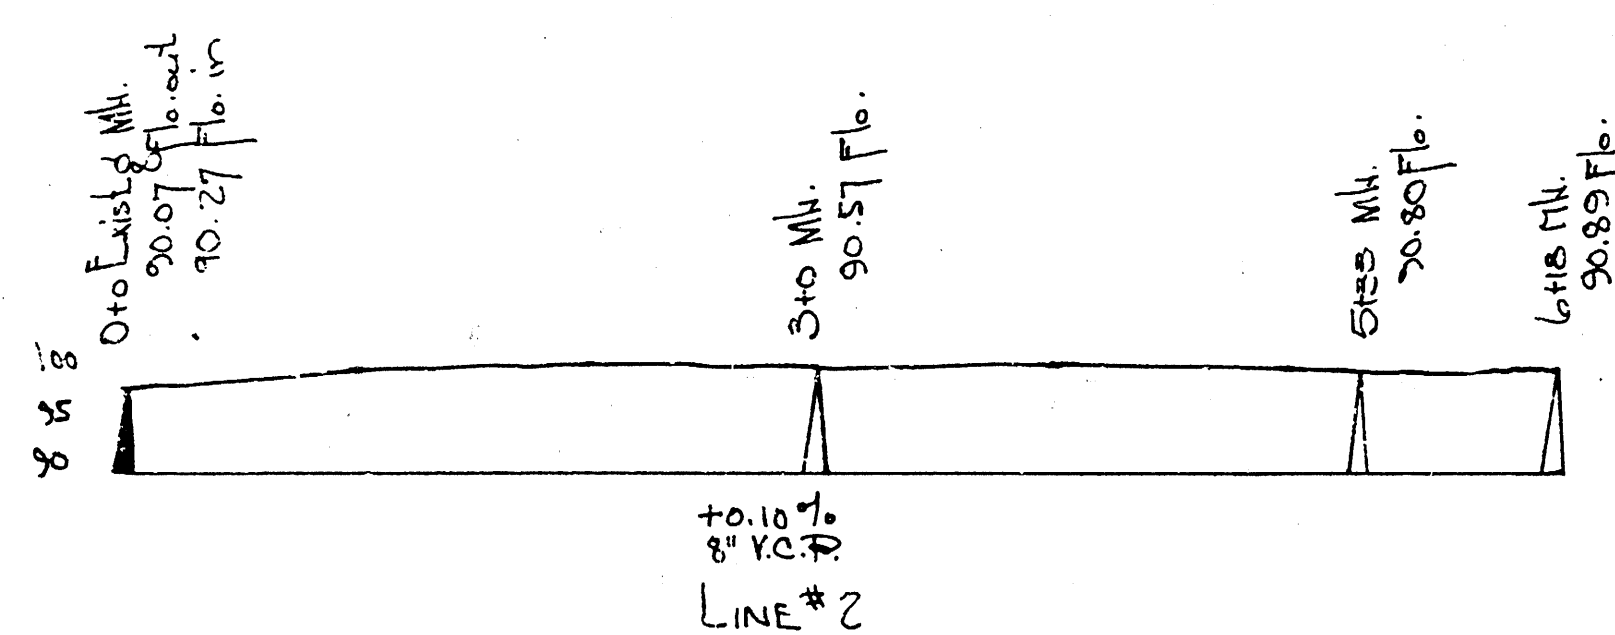
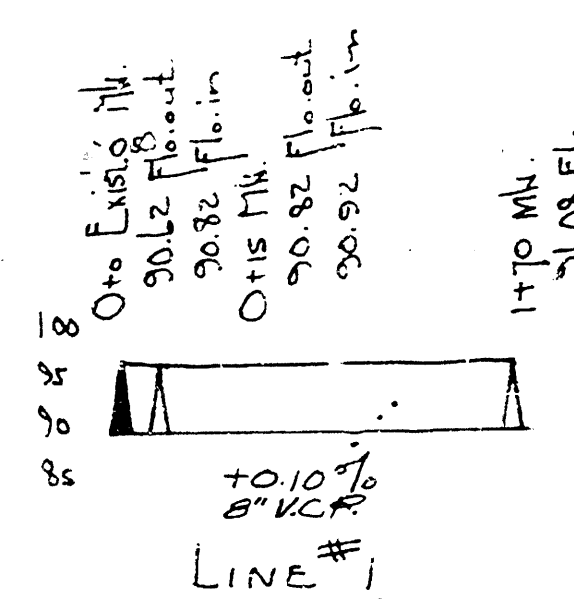


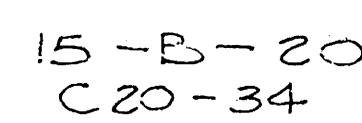

LAT. 16, DIST. 3, SS# 20
" 14, " 2, " 21
" 46, D.C.S., " 12
City of Wichita, Kansas
L.E. White - City Engineer
Date-5-25-50