

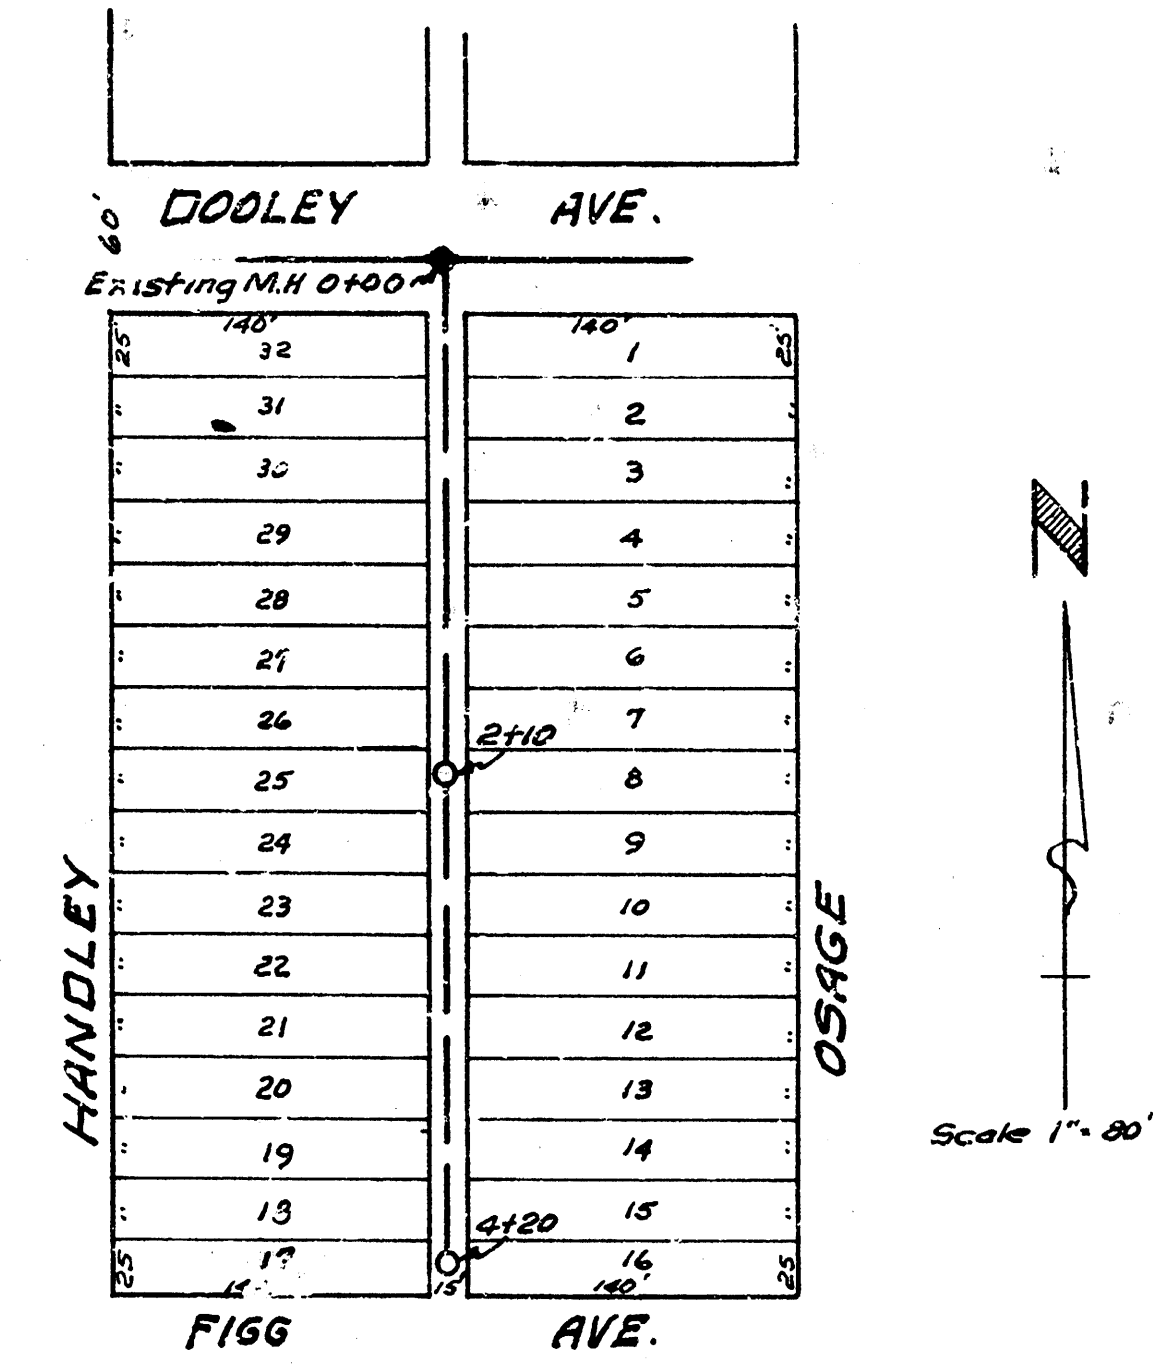


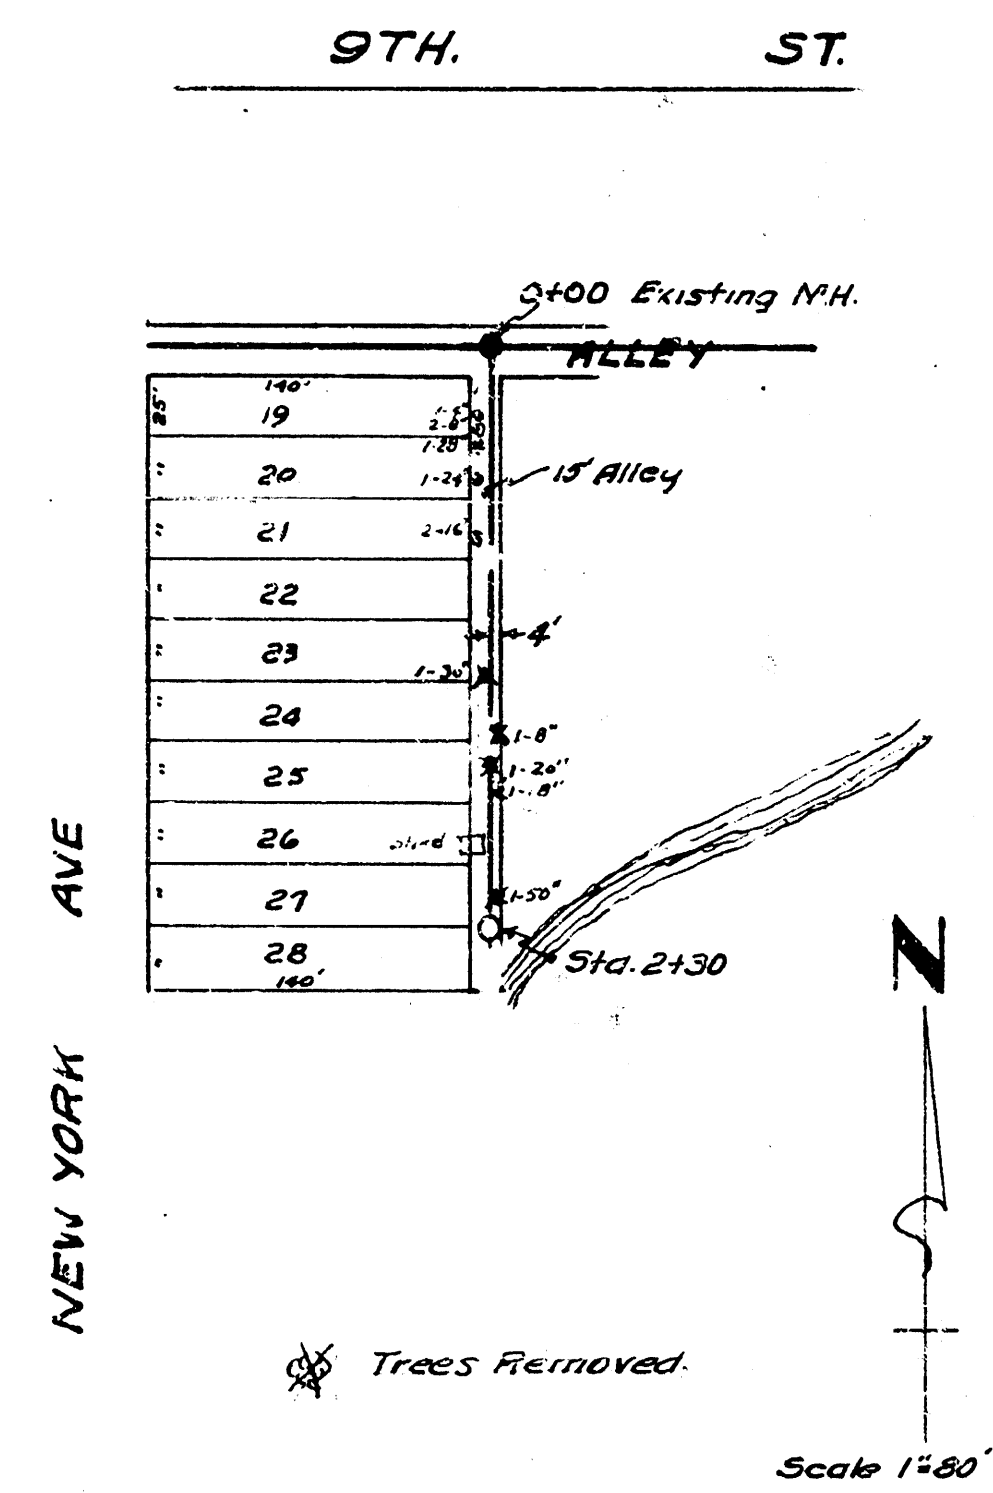


B.M. 111.92 W.R.M. M.H. 0100

Note: Engineer note all trees removed

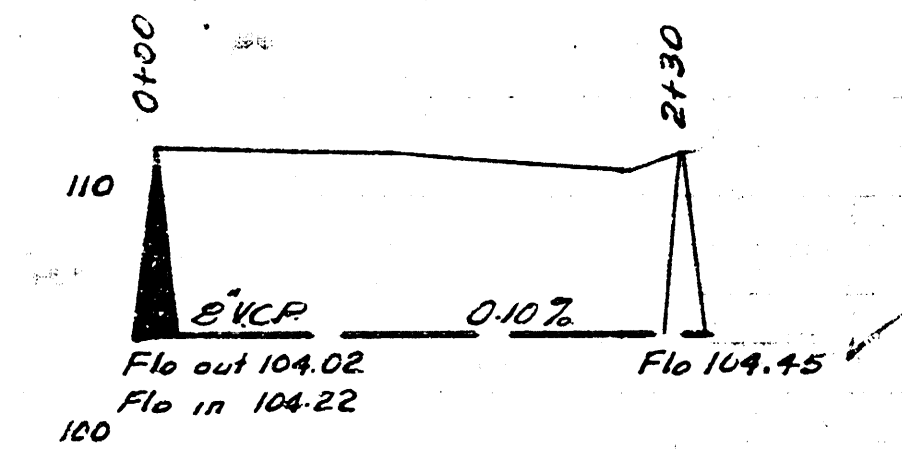

B.M. 103.44 R.R. Spike S.V. Side Twp pole
N.S. Dooley E.S. Alley cut Handley & Osage

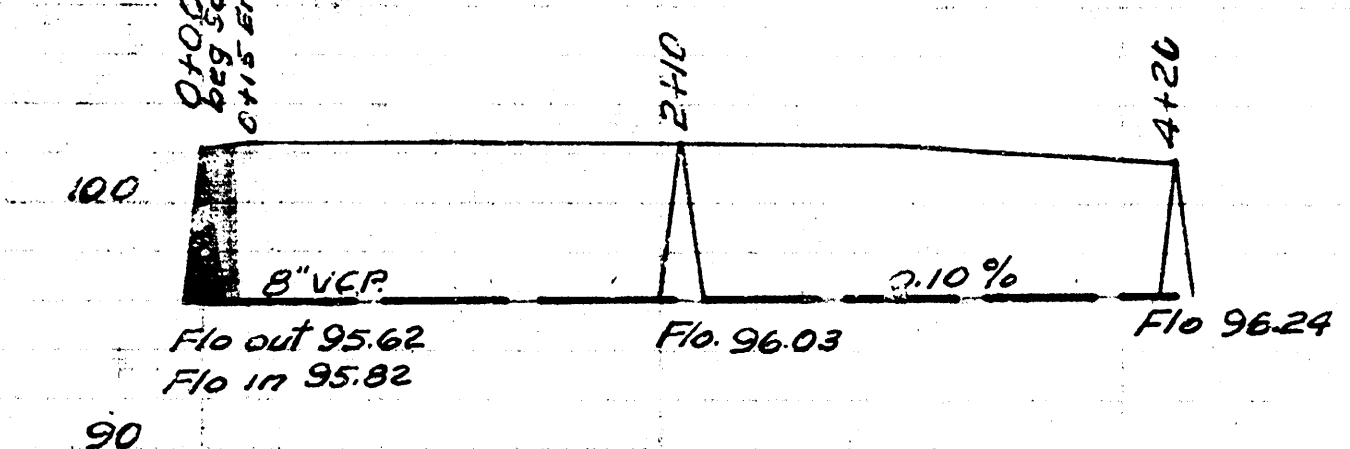

Date 5-13-52
Drawn by L. White
Checked by R. H. H.
Y-45

Date 12-21-52
Drawn by M. J. H.
Checked by R. H. H.
Book No. 1300

LAT. 38. SS. 20
CITY OF WICHITA KANSAS
L.R. WHITE CITY ENGINEER
Proj No. C-23-22



LAT. 1 DIST. E MAIN 21
CITY OF WICHITA KANSAS
L.R. WHITE CITY ENGINEER
Proj No. C-22-31

