



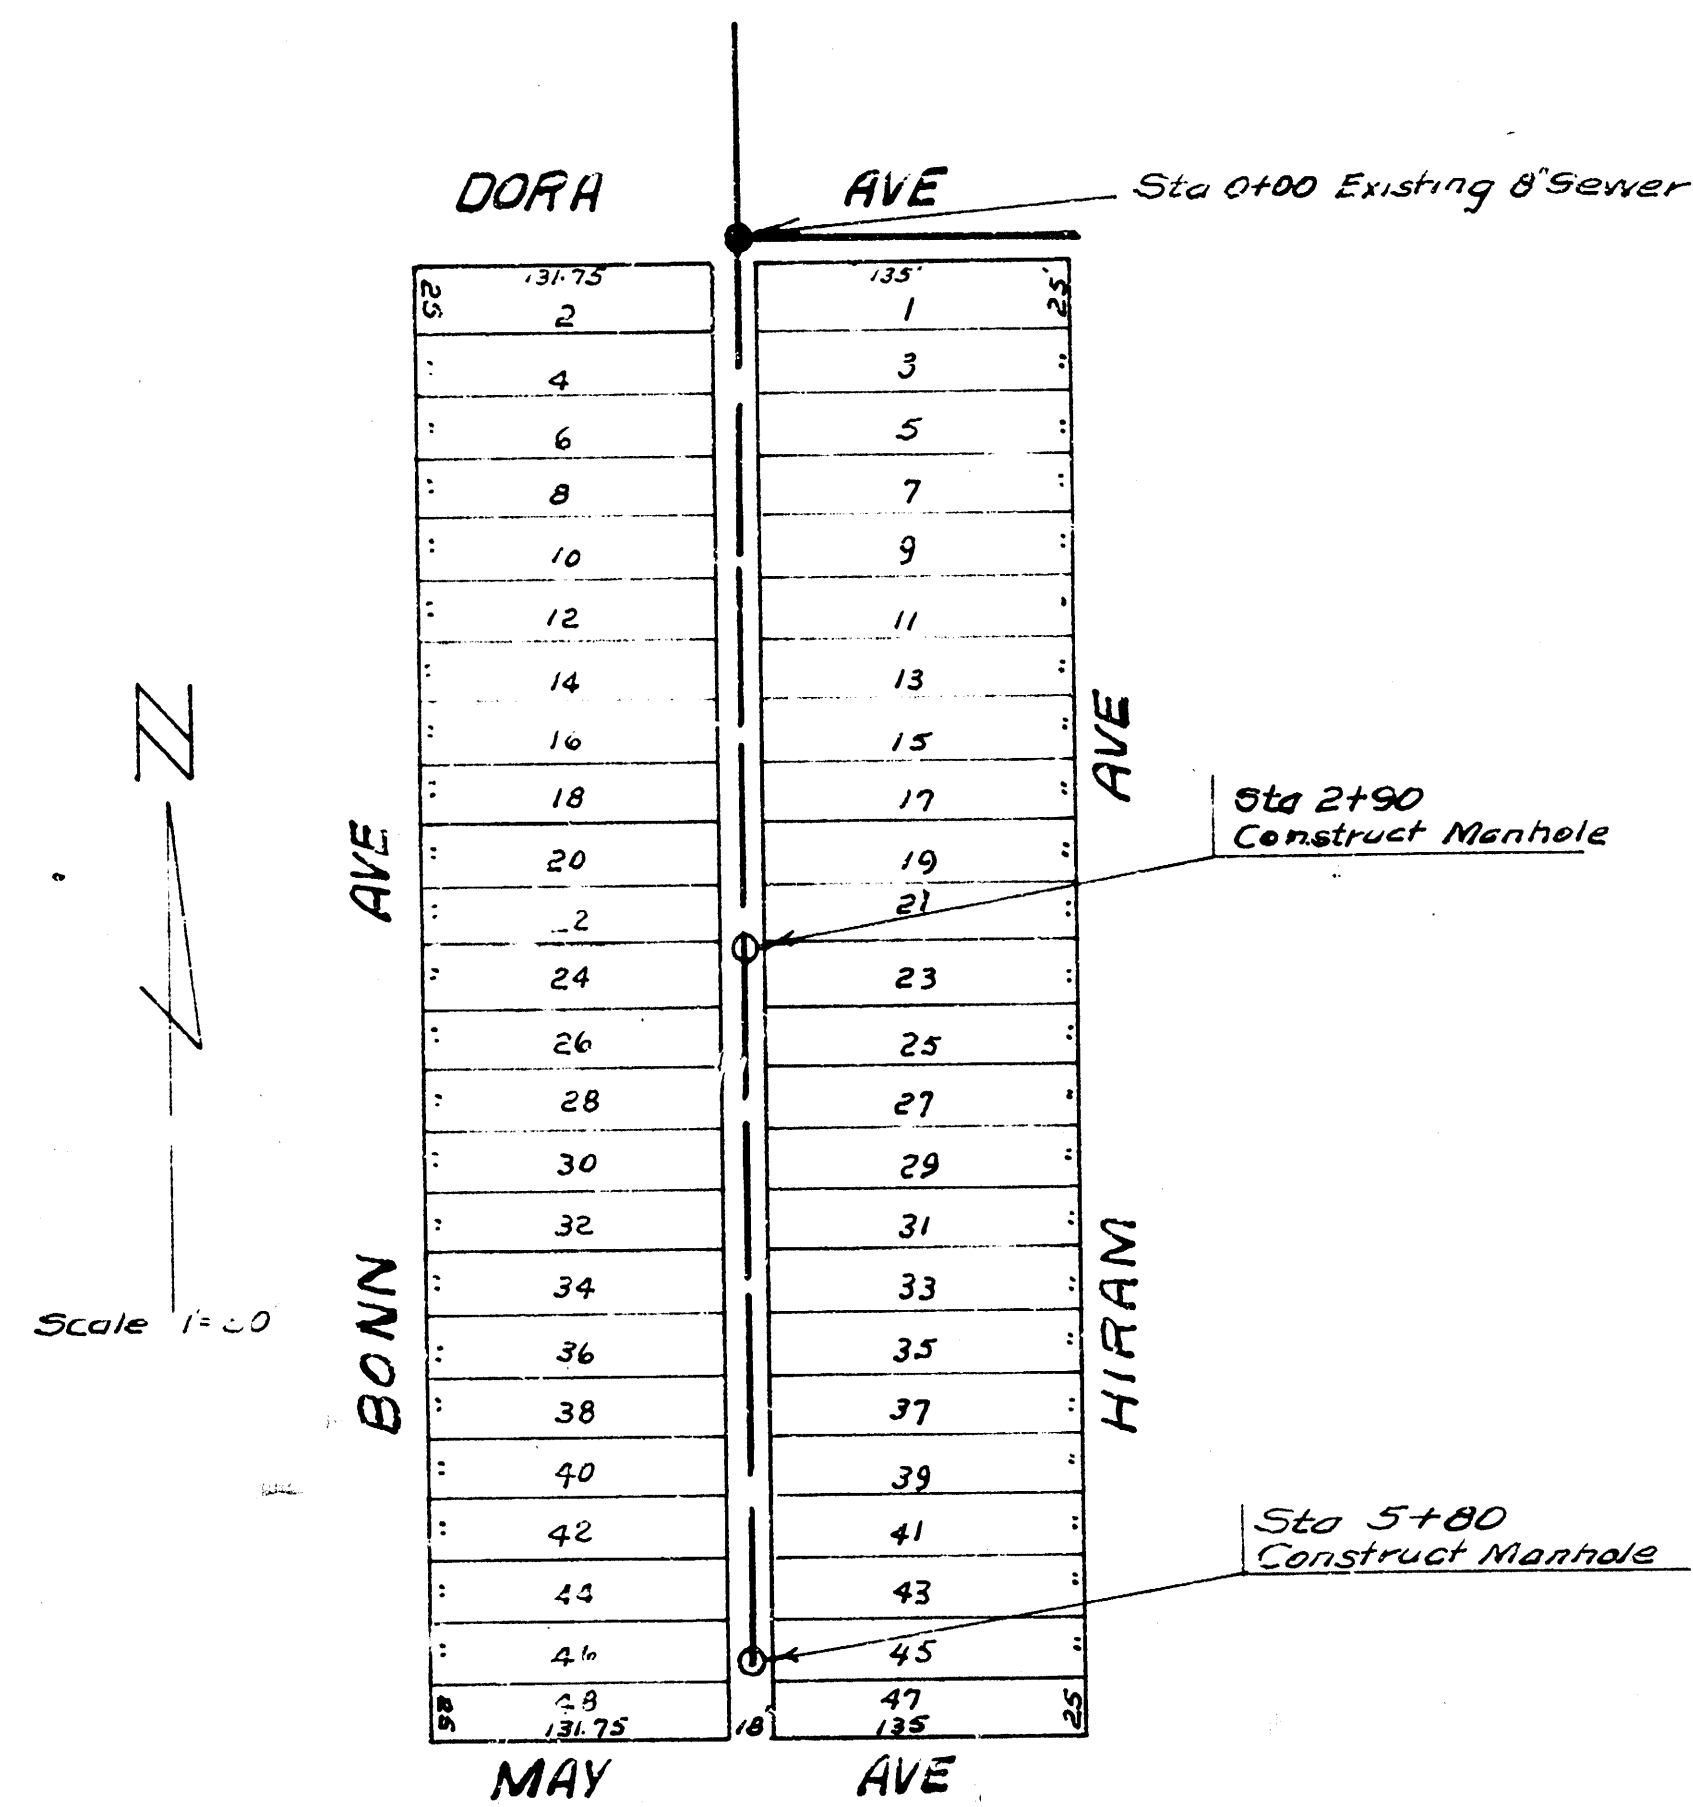


BM 105.49 RR Spike PP NE cor. Hiram & Dora

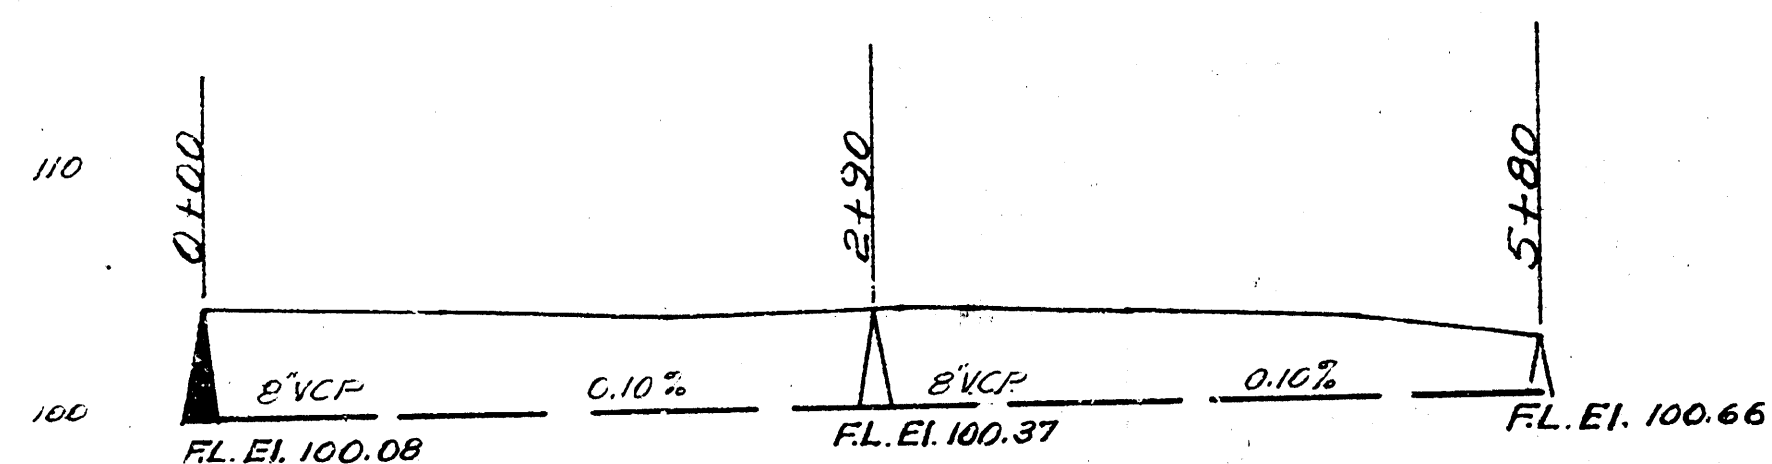


11-21-52
L.W.N.
Y.90

Date
Drawn by
Checked by
Book No.

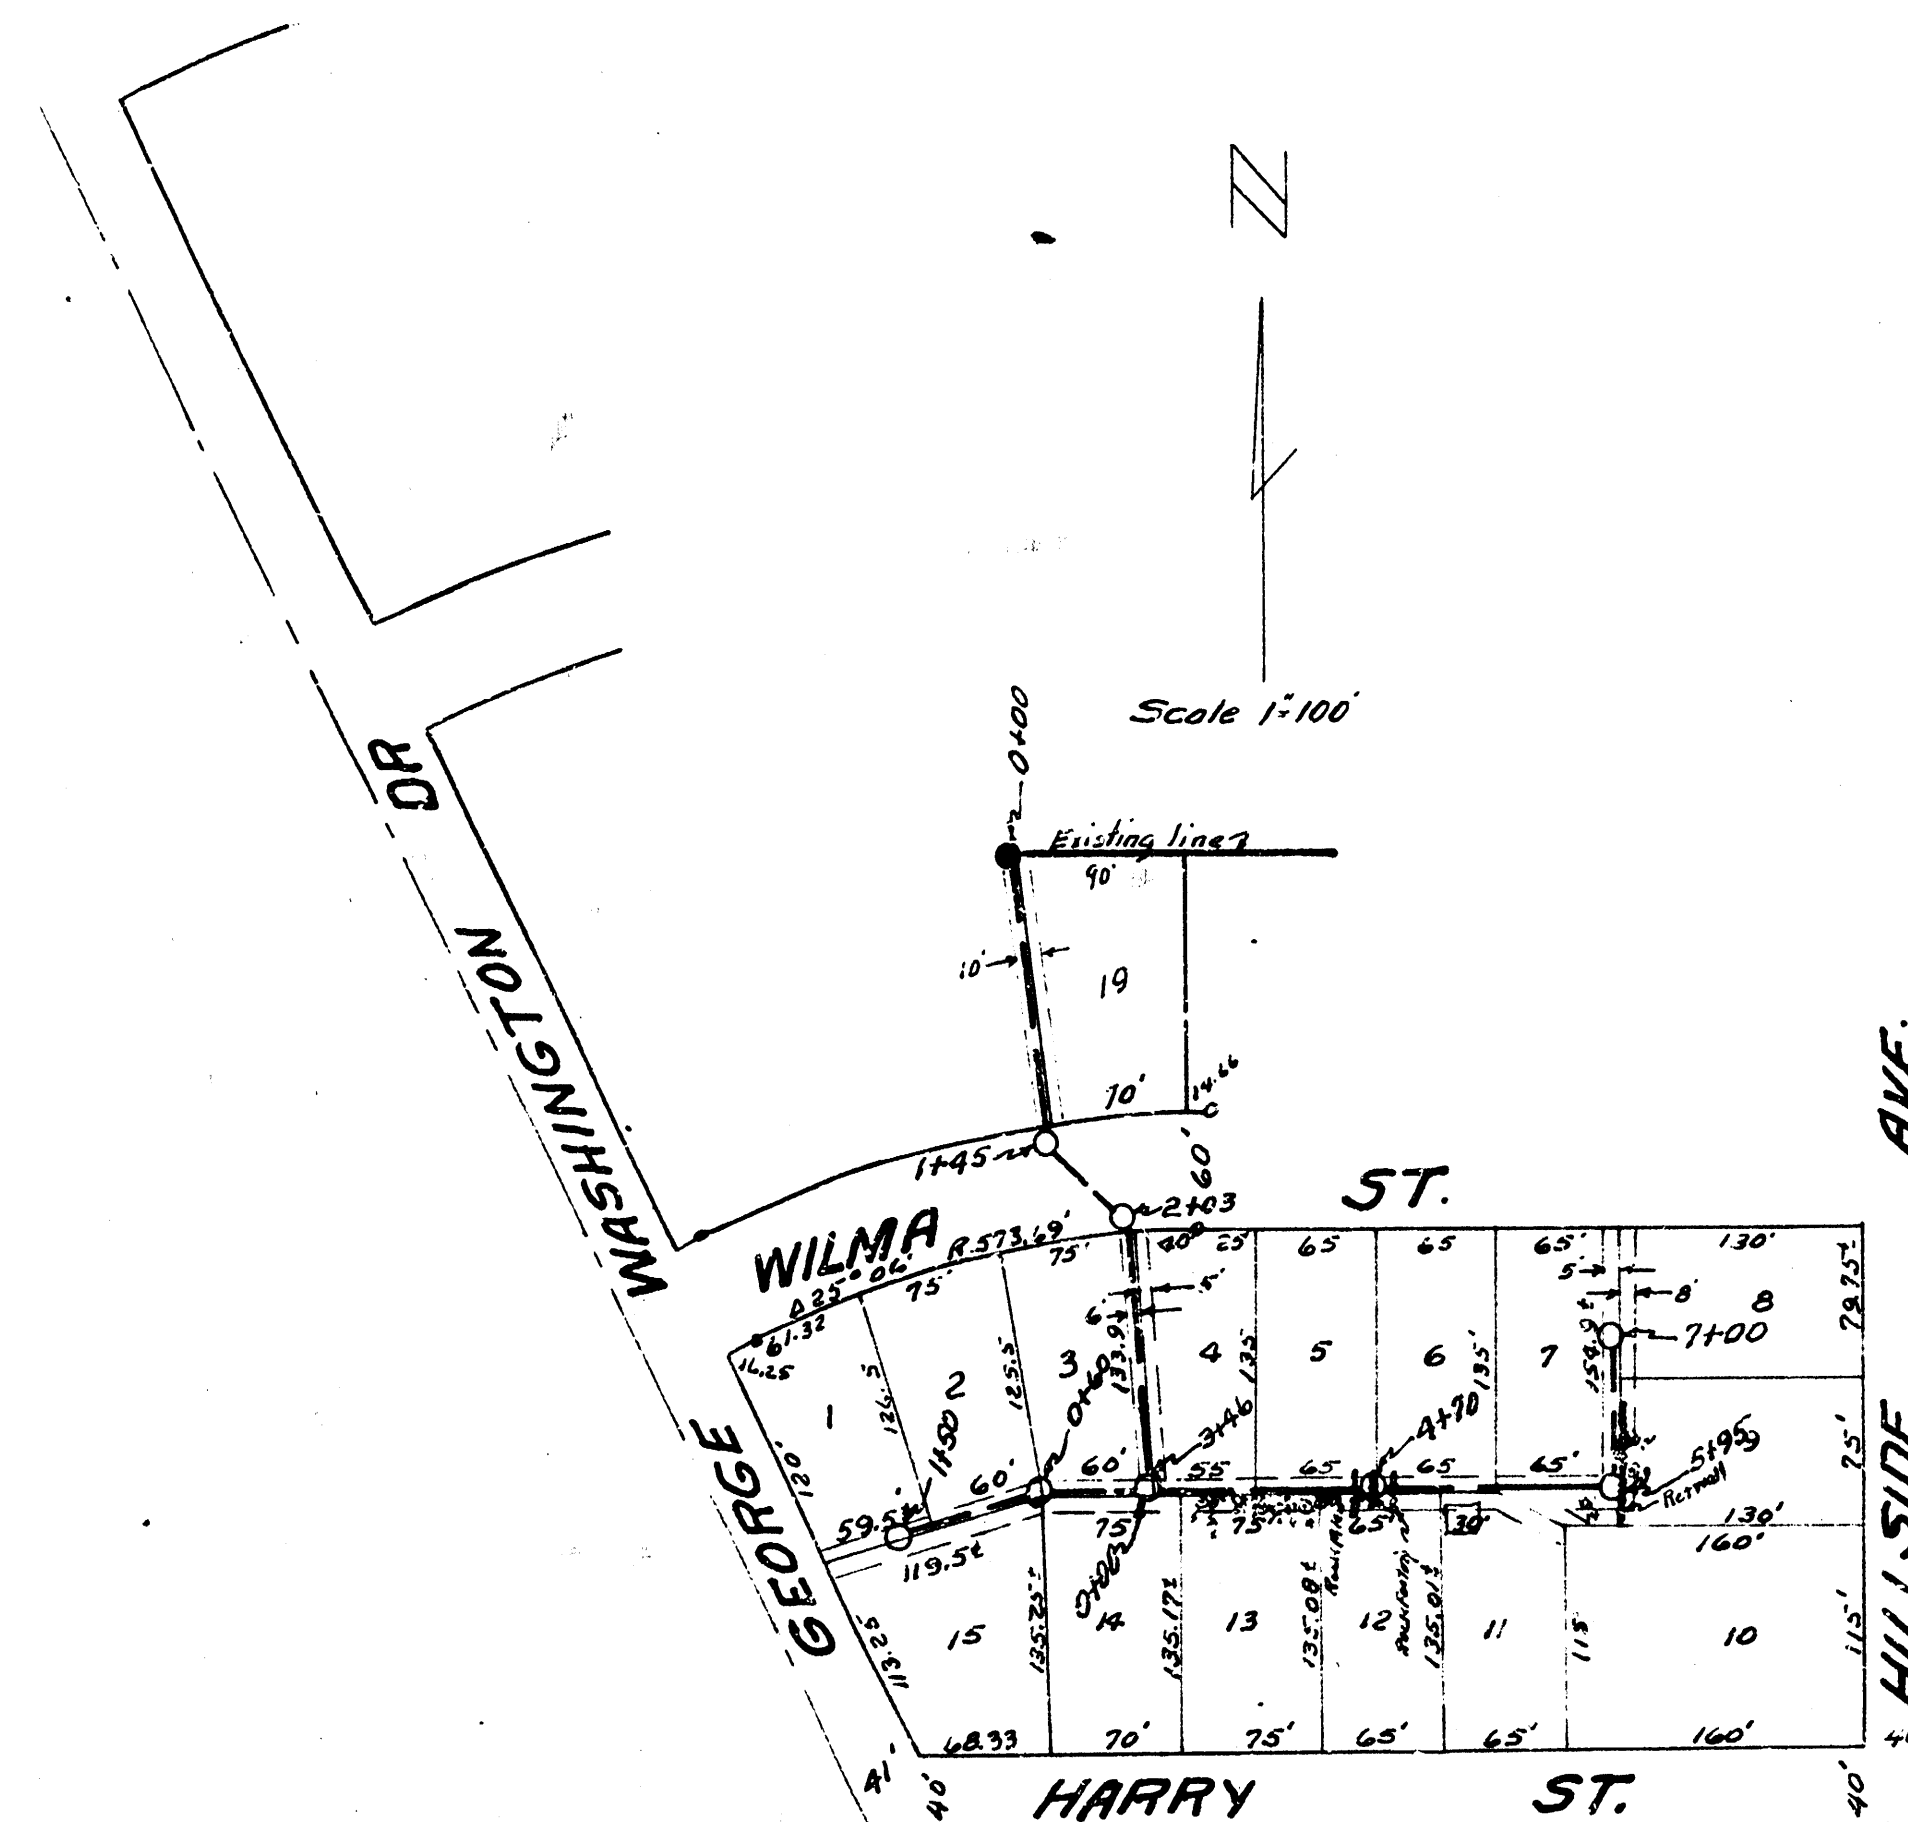


BM. M. in Mueller Fire Plug W. side Geo. Washington at Sennett. El. 104.25

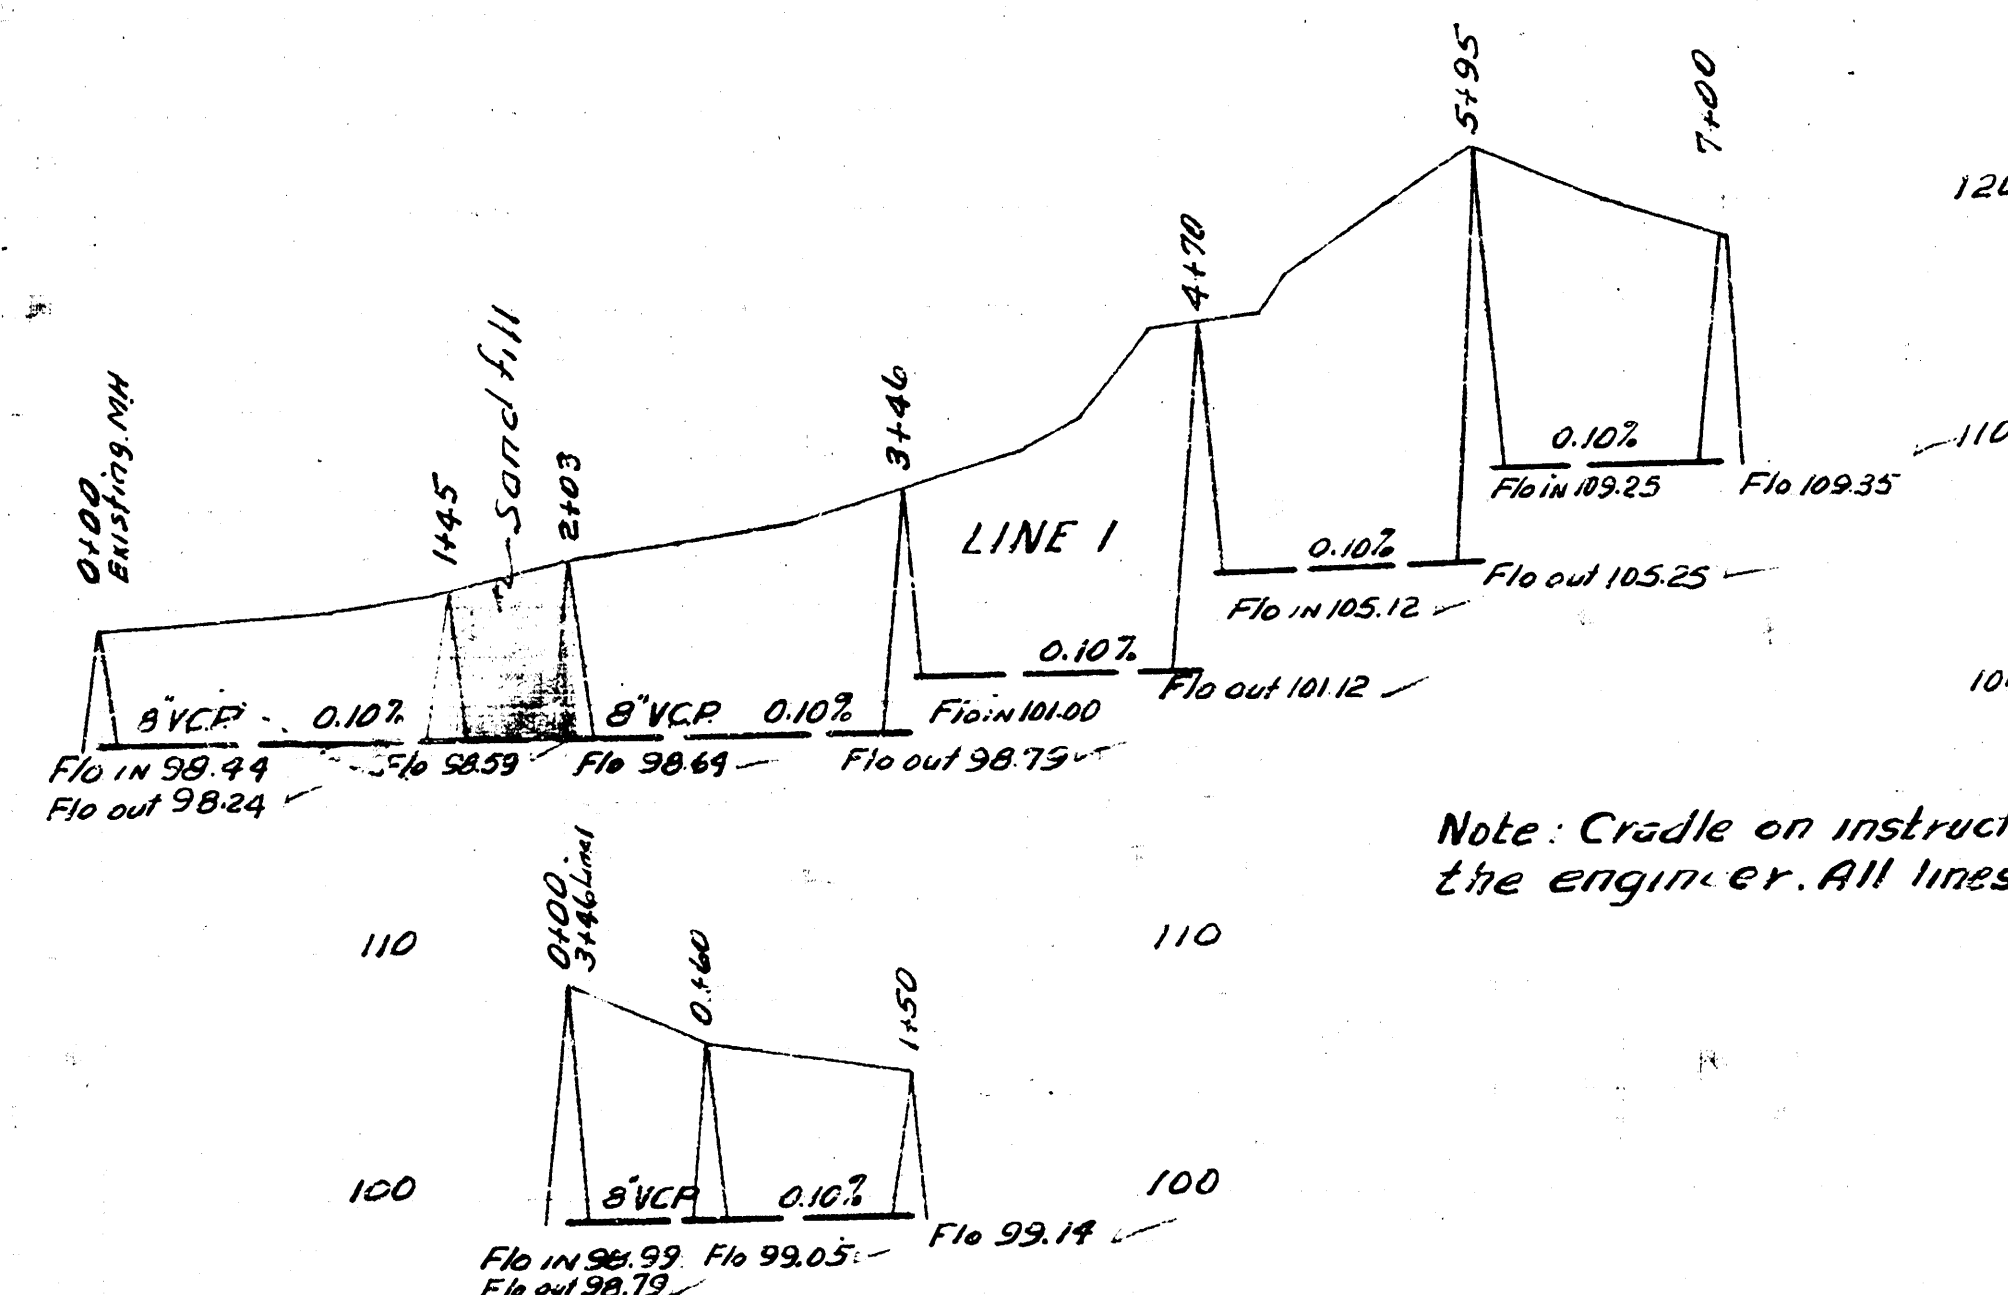


Note: Cradle on instructions from the engineer. All lines over 12' cover

LAT. 2 DIST. E MAIN 21
CITY OF WICHITA KANSAS
L.K. WHITE CITY ENGINEER
Proj. C-22-53

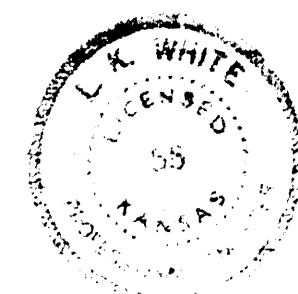

LAT. 6 DIST. 10 SS. 12
CITY OF WICHITA KANSAS
L.K. WHITE CITY ENGINEER
Proj. No. C-20-71

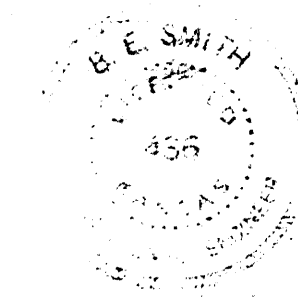

5-23-52
Drawn by
Checked by
Book No.