

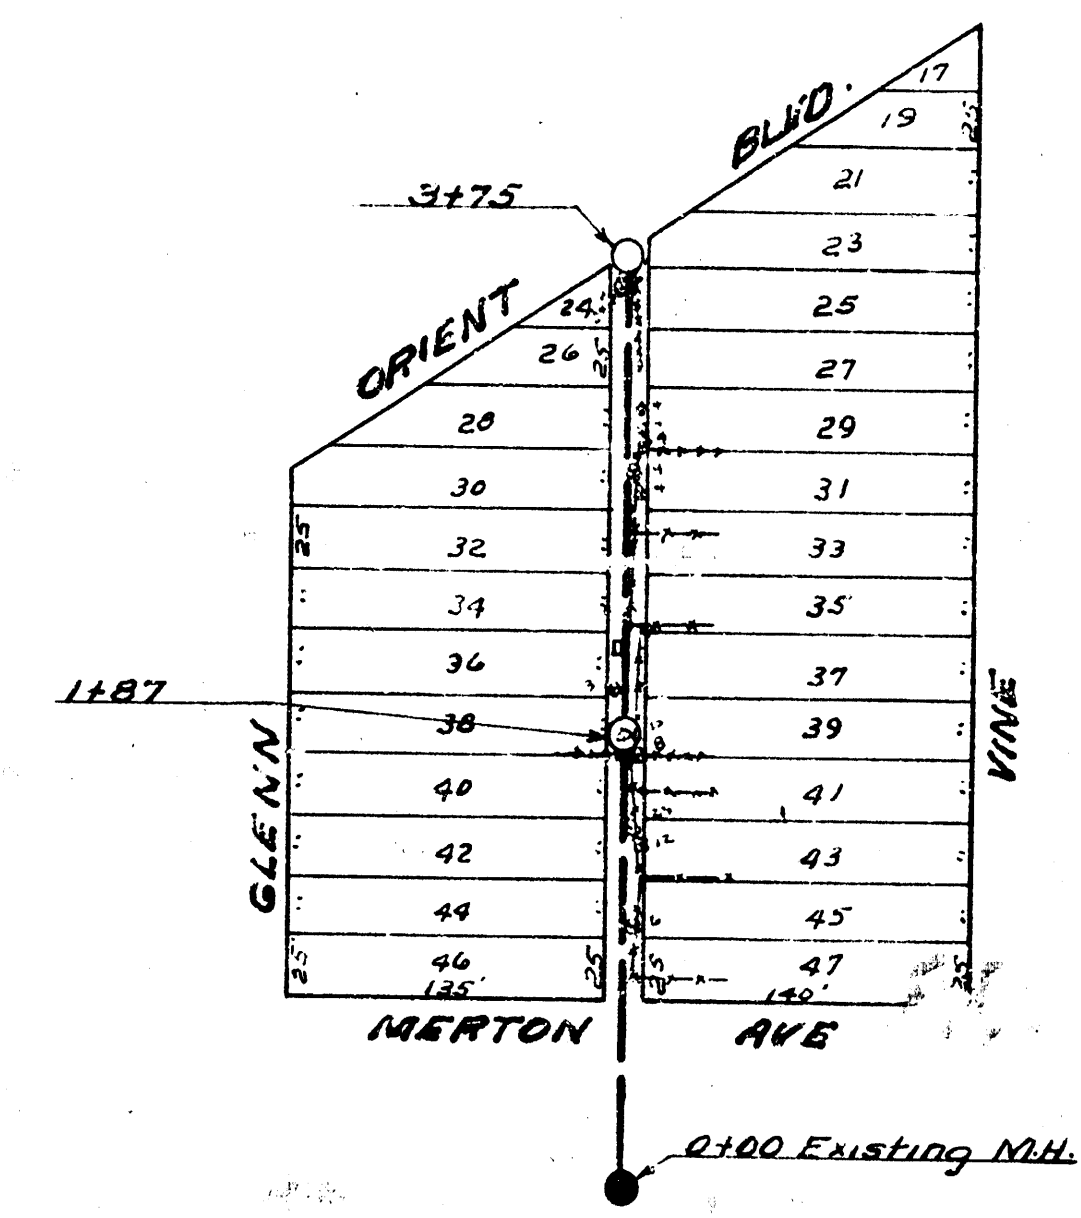


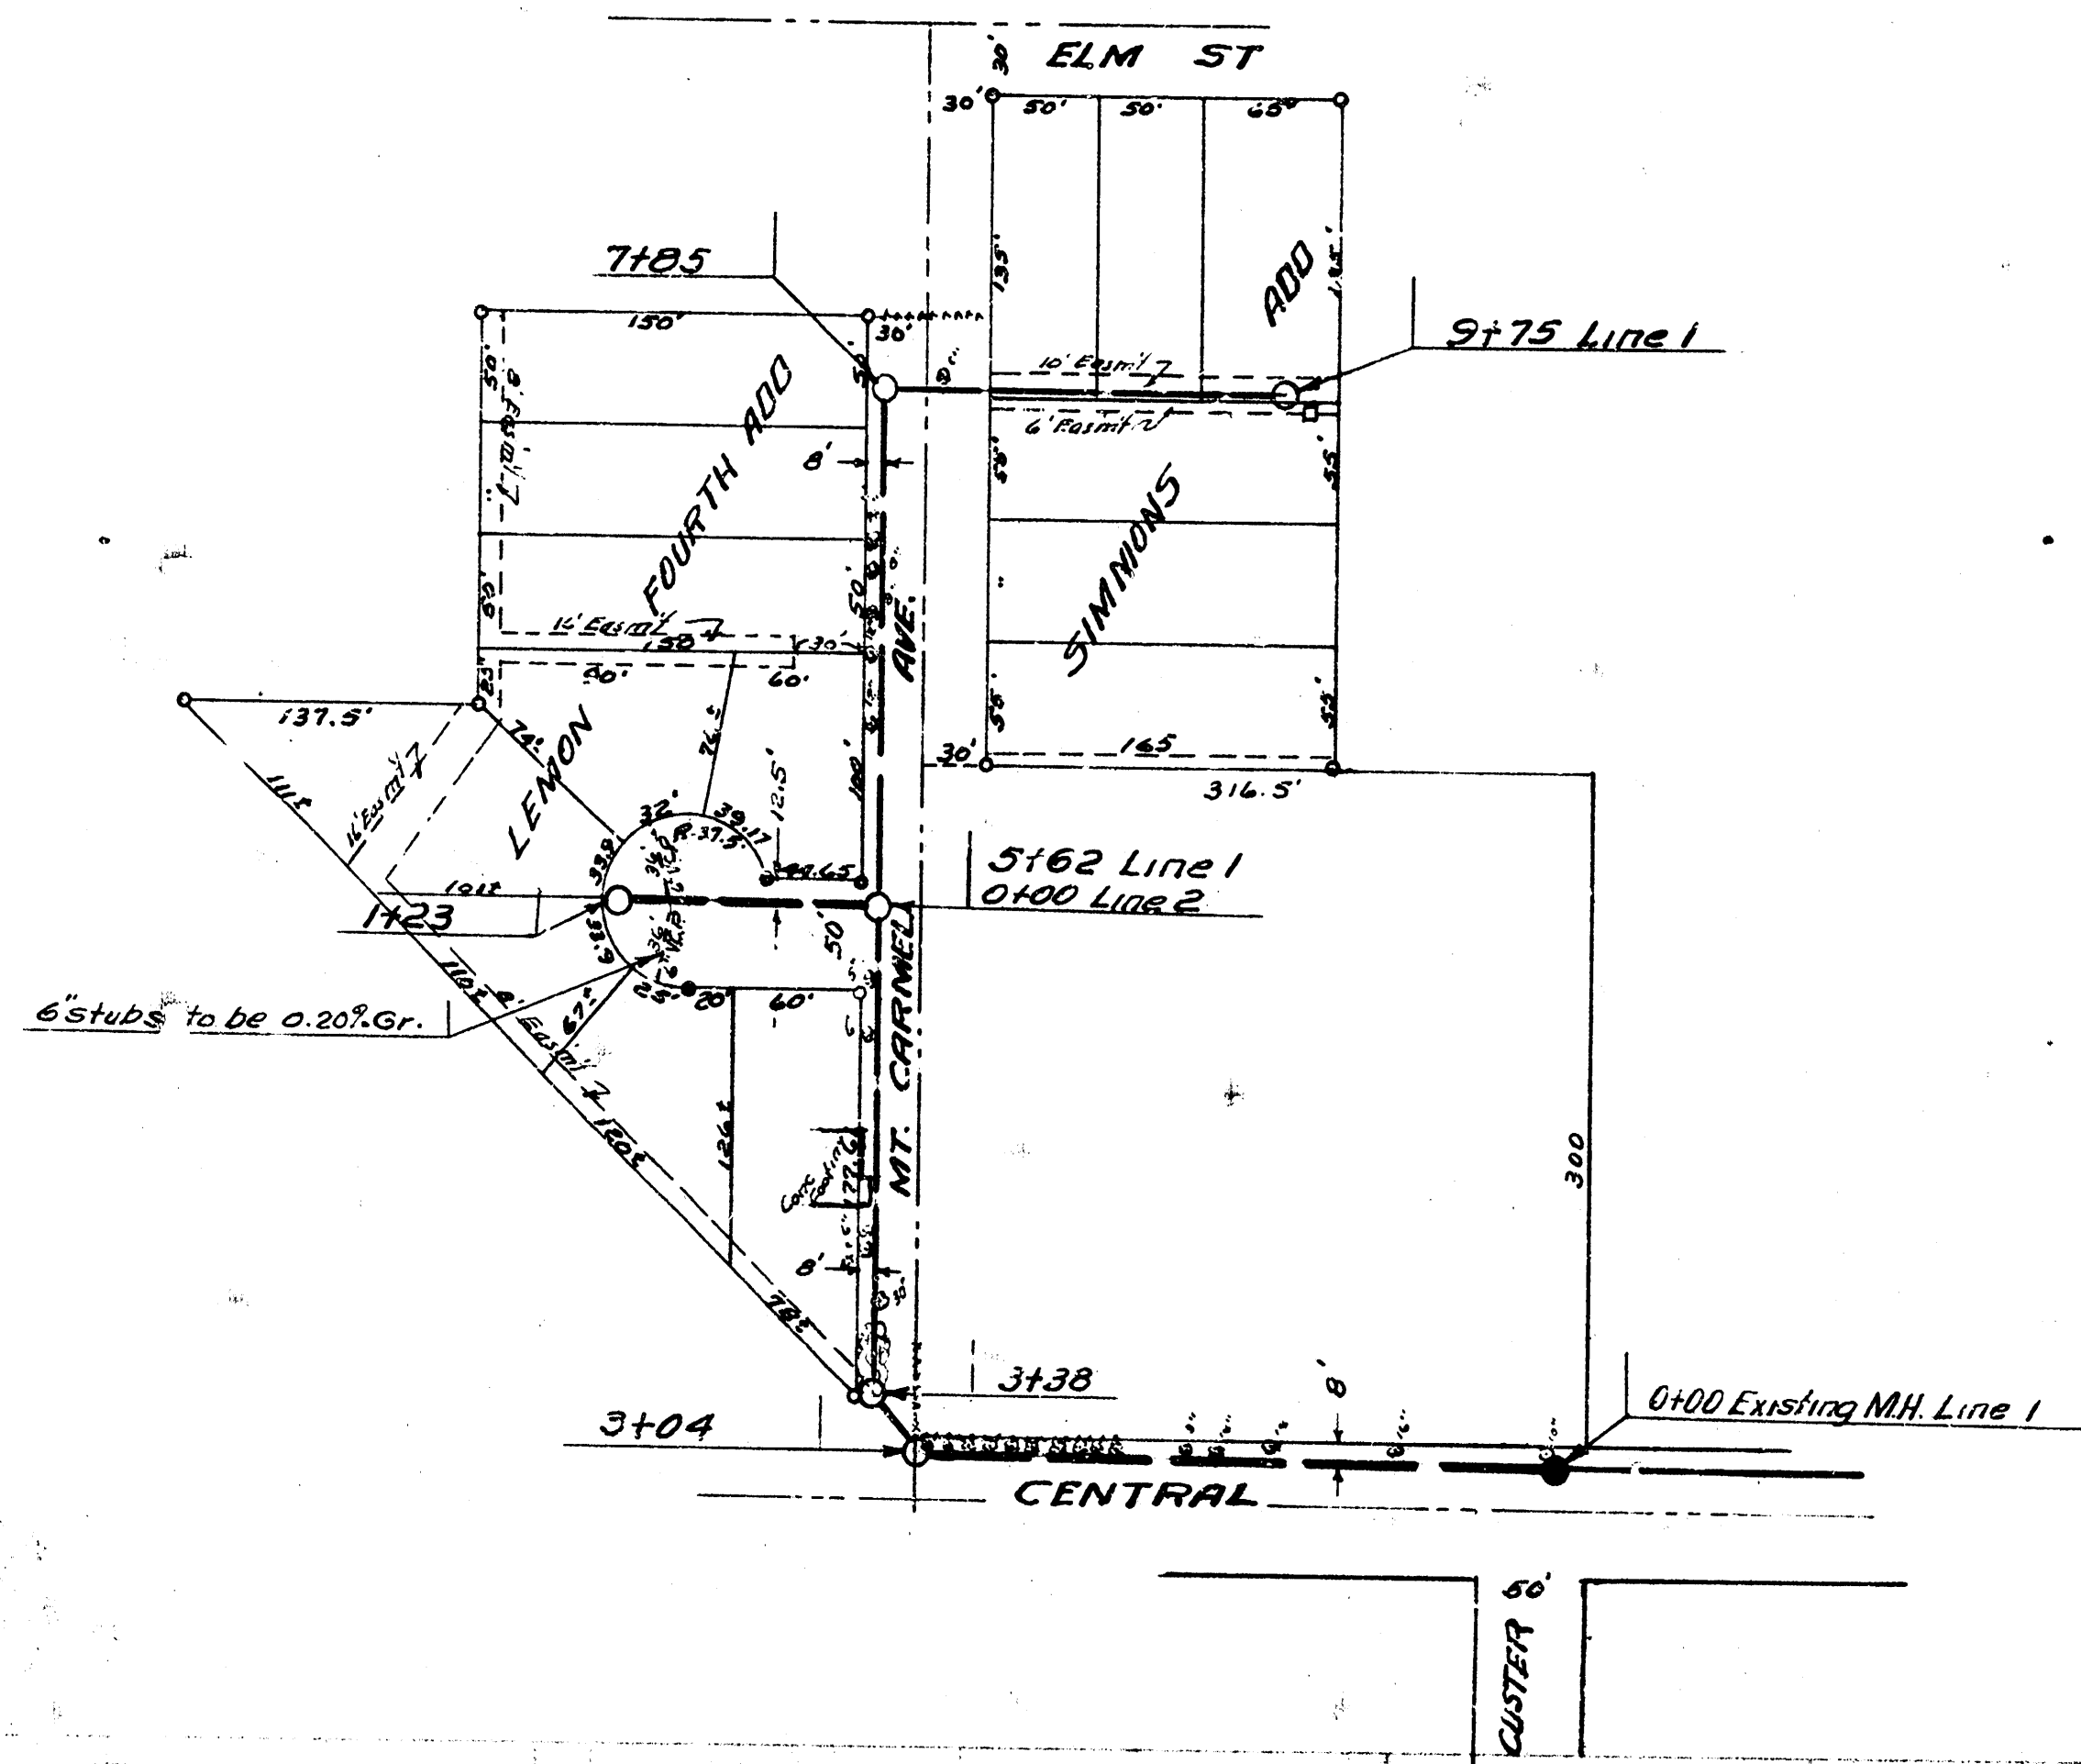


NOTE: Engineer shall note all trees and fence removal payment will be made on his report.

Date 7-15-53
Drawn by M. C. Smith
Checked by J. E. Smith
Block No. 511

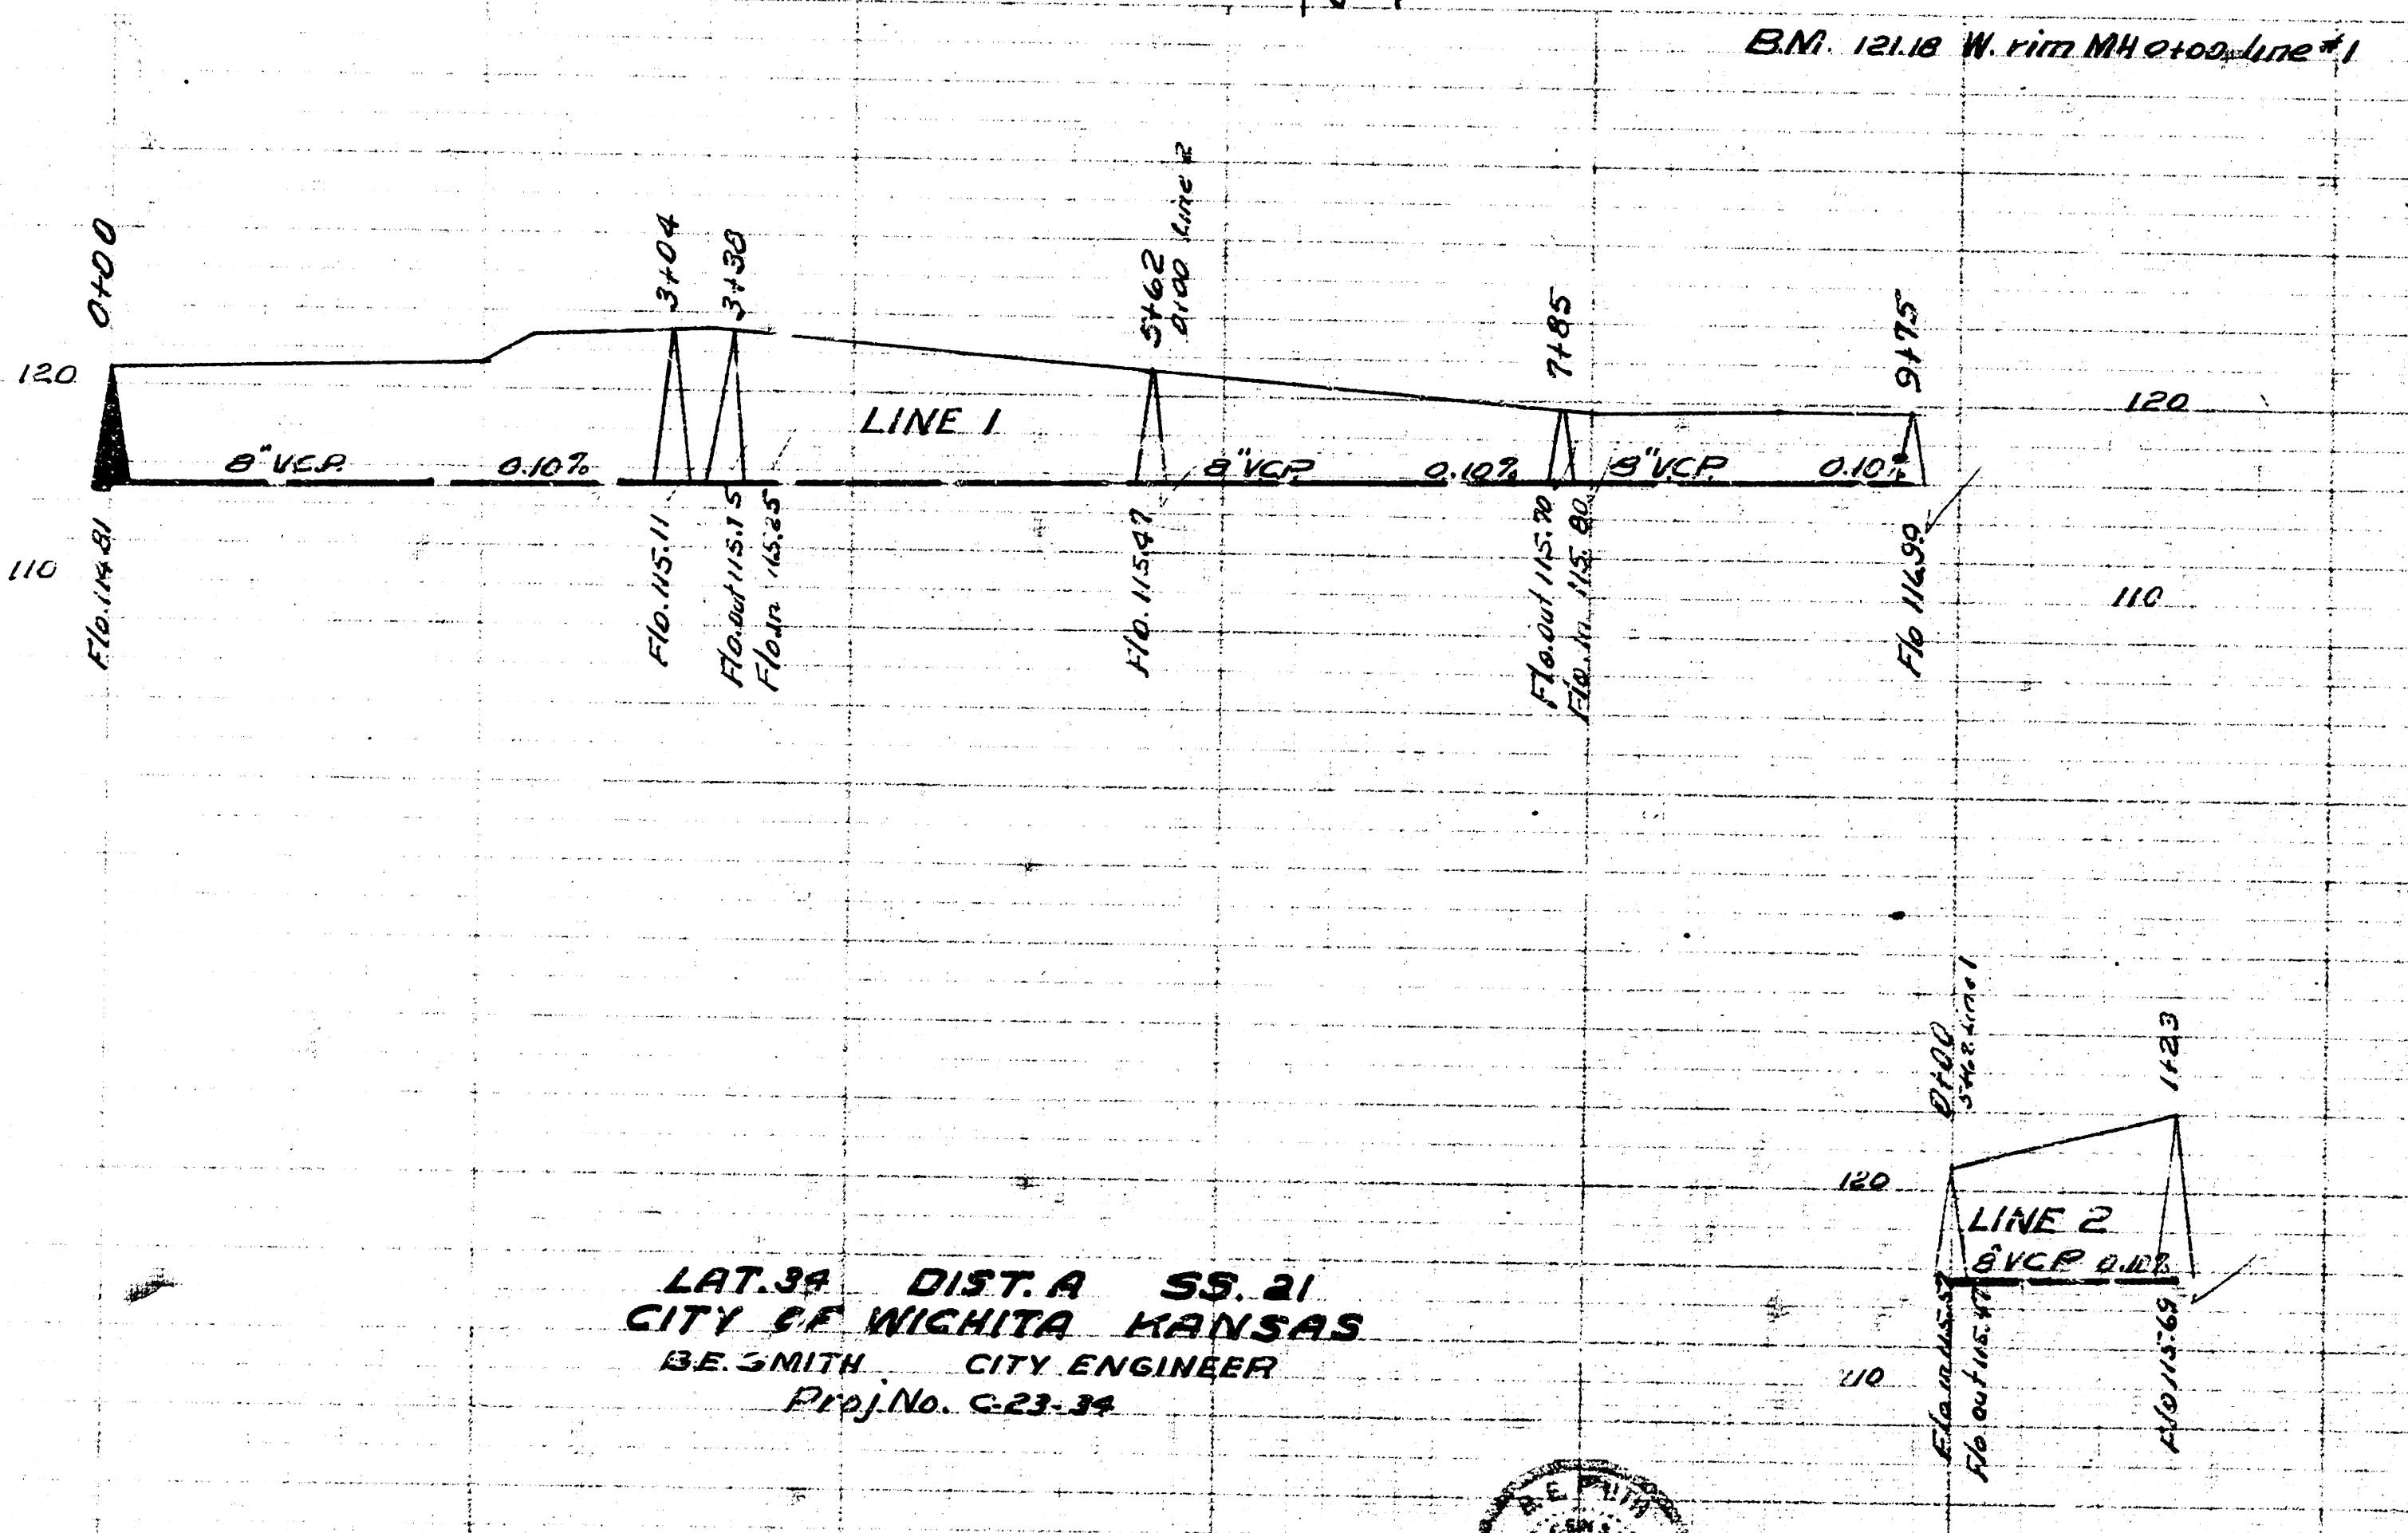

Date 7-15-53
Drawn by M. C. Smith
Checked by J. E. Smith
Block No. 511

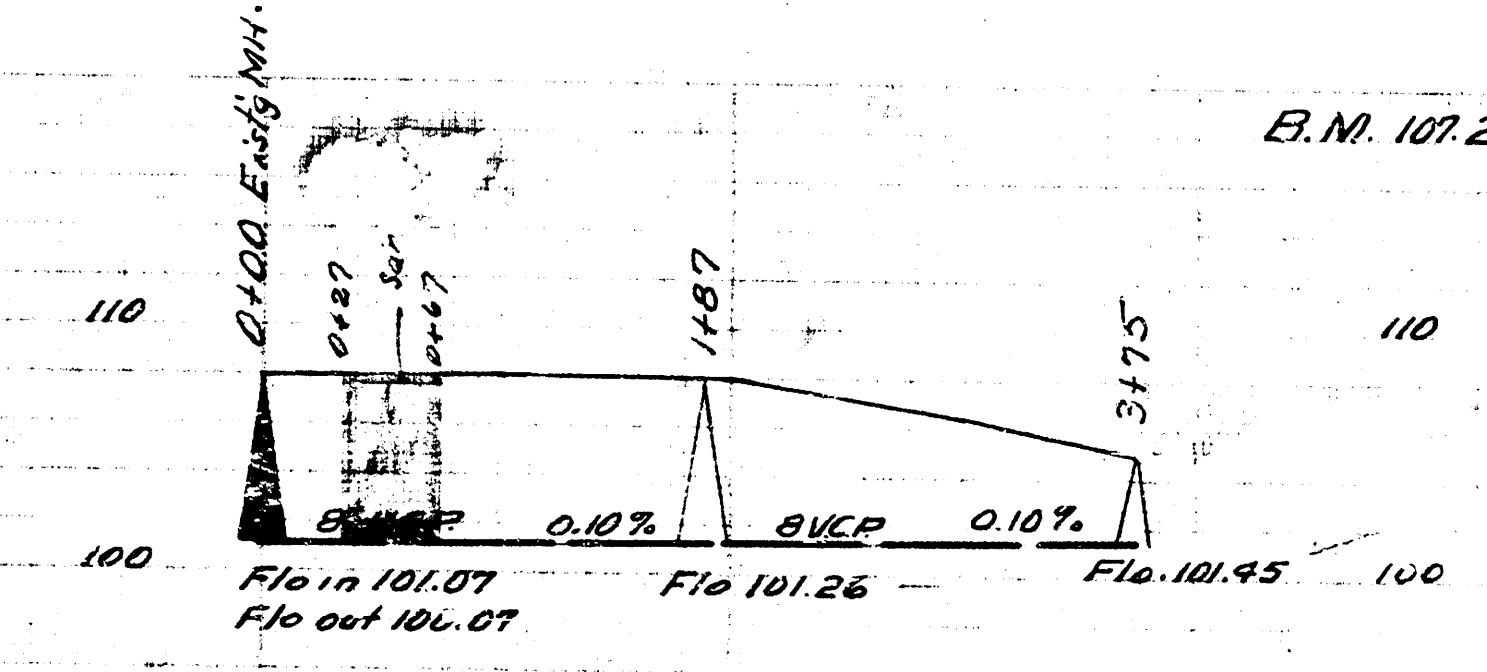

CITY OF WICHITA KANSAS
B. E. SMITH CITY ENGINEER
Proj. No. C-23-34

LAT. 39 DIST. E SS. 21
CITY OF WICHITA KANSAS
B. E. SMITH CITY ENGINEER
Proj. No. C-23-35