B.M. 102.87 N.S. Cor. 1st Step on back porch of House S.E. Cor. Wildwood & St. Paul
B.M. 98.40 "4" E. end S.E. Curb Return S.E. Cor. 30th & Gordon

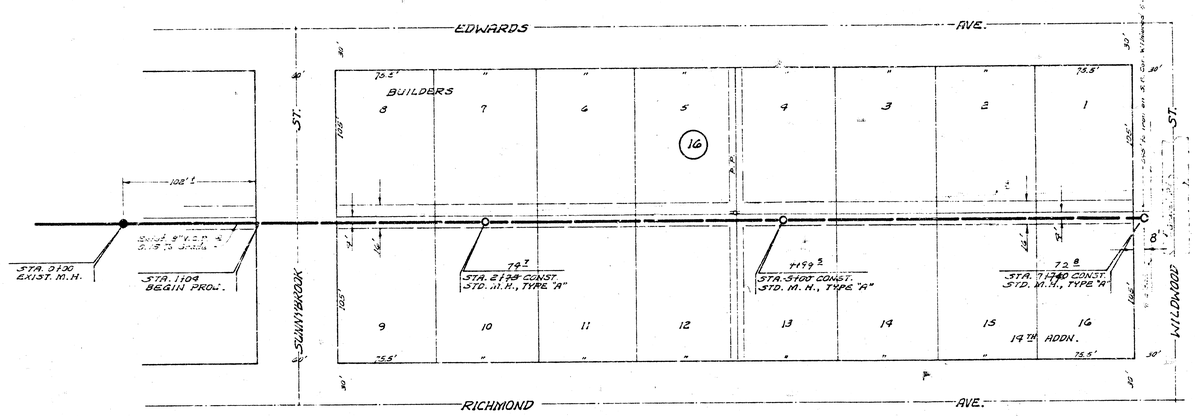

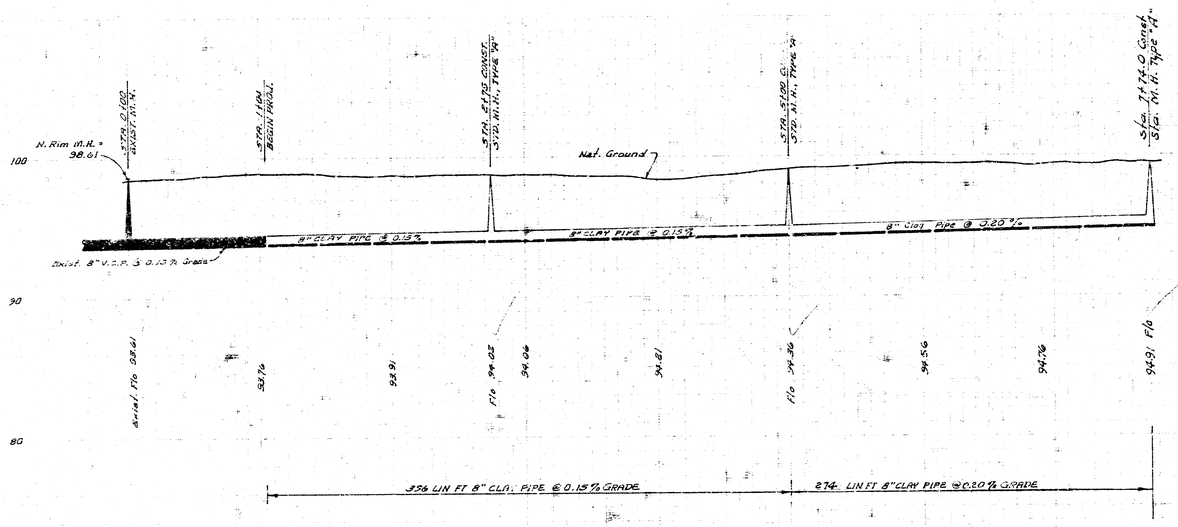

Plan Scale (1" = 40') Hor.
Profile Scale (1" = 4' Vert.)

"As Built" Final Mea. 5-8-11 JAK

LAT. 105, SAN. SEWER 22
CITY OF WICHITA, KANSAS
R. W. LINN, CITY ENGINEER
PROJ. NO. DBKL5G8005
DATE: NOV. 1973