B.M. 98.40 '1' E. End S.E. Curb Return S.E. Cor. 30th & Gordon
B.M. 102.87 N.E. Cor. 1st Step on back porch of Ho. S.E. Cor. Wildwood & St. Paul

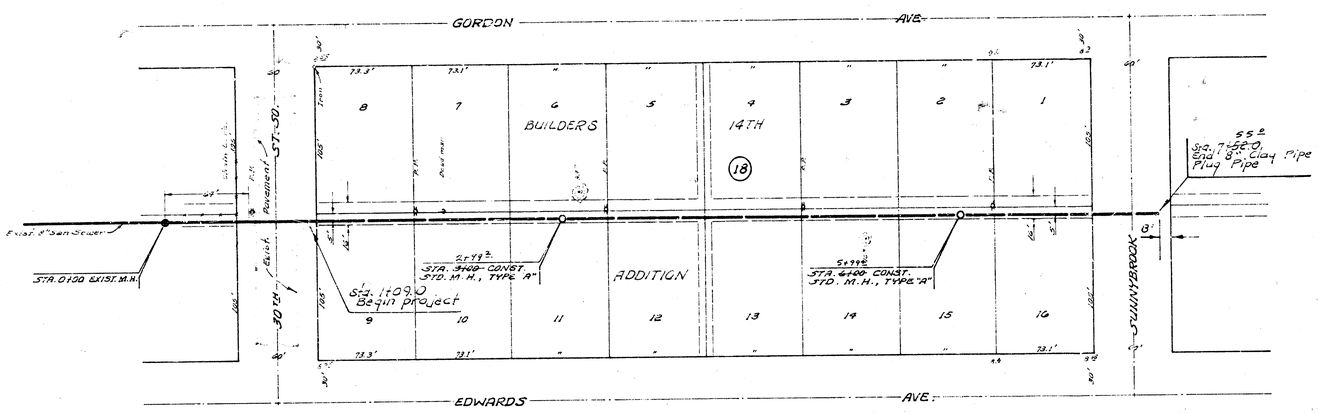

Plan Scale 1" = 40'
Profile Scale 1" = 40' Hor.
1" = 4' Vert.

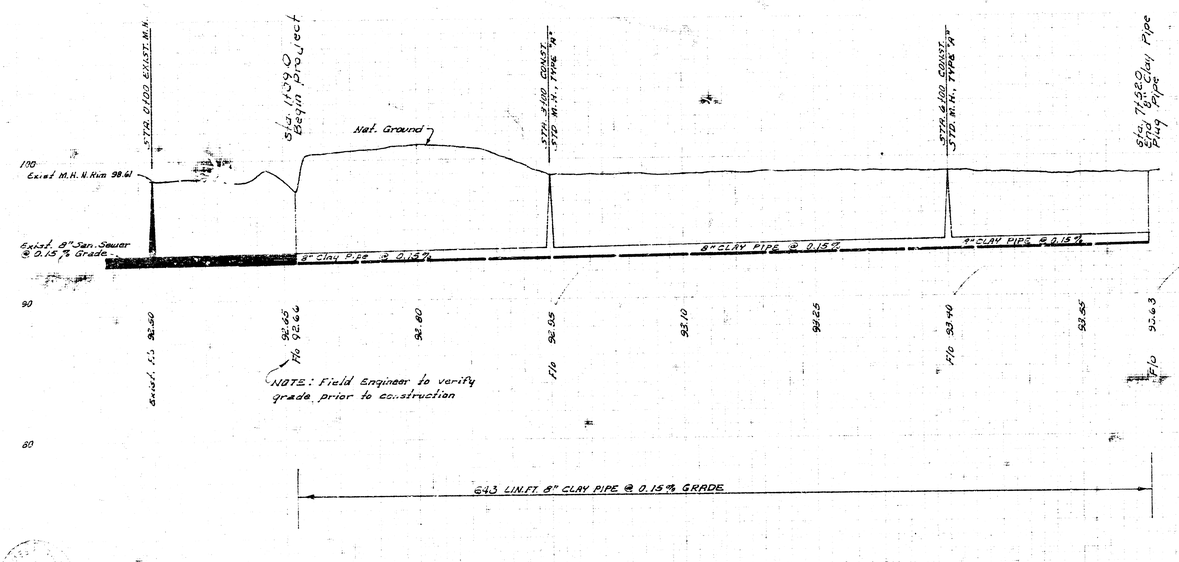

As Built Field Map 55 #13

LAT. 109, SAN. SEWER 22
CITY OF WICHITA, KANSAS
R. W. LINN, CITY ENGINEER
PROJ. NO. D8KL568009
DATE: NOV. 1973