
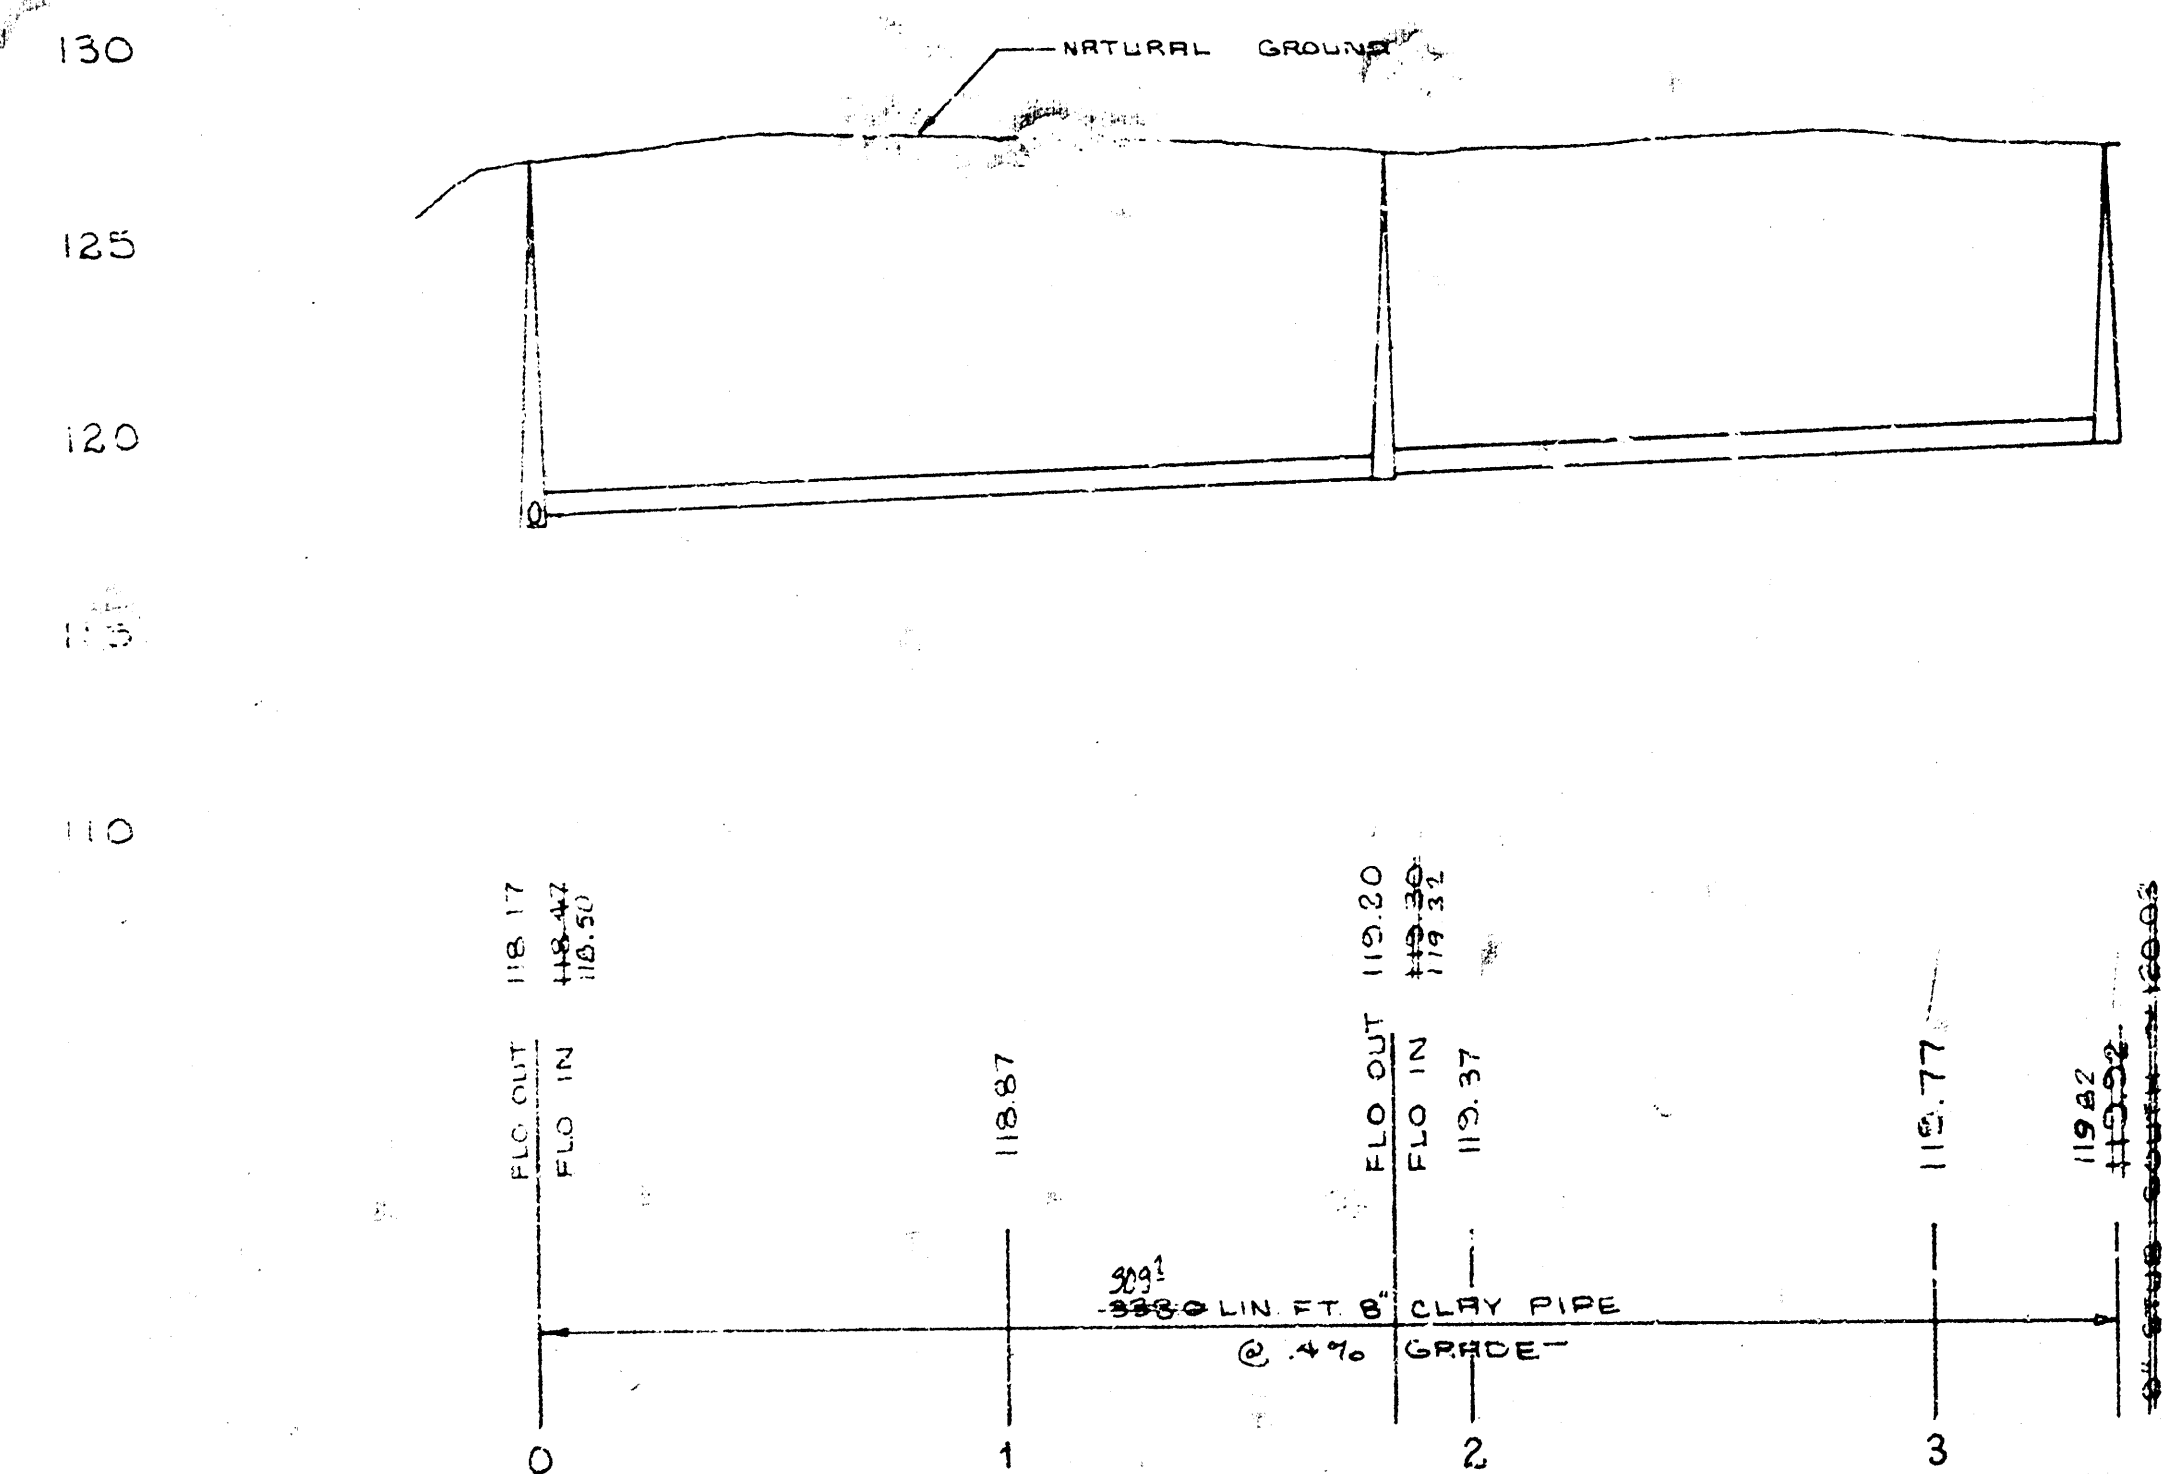


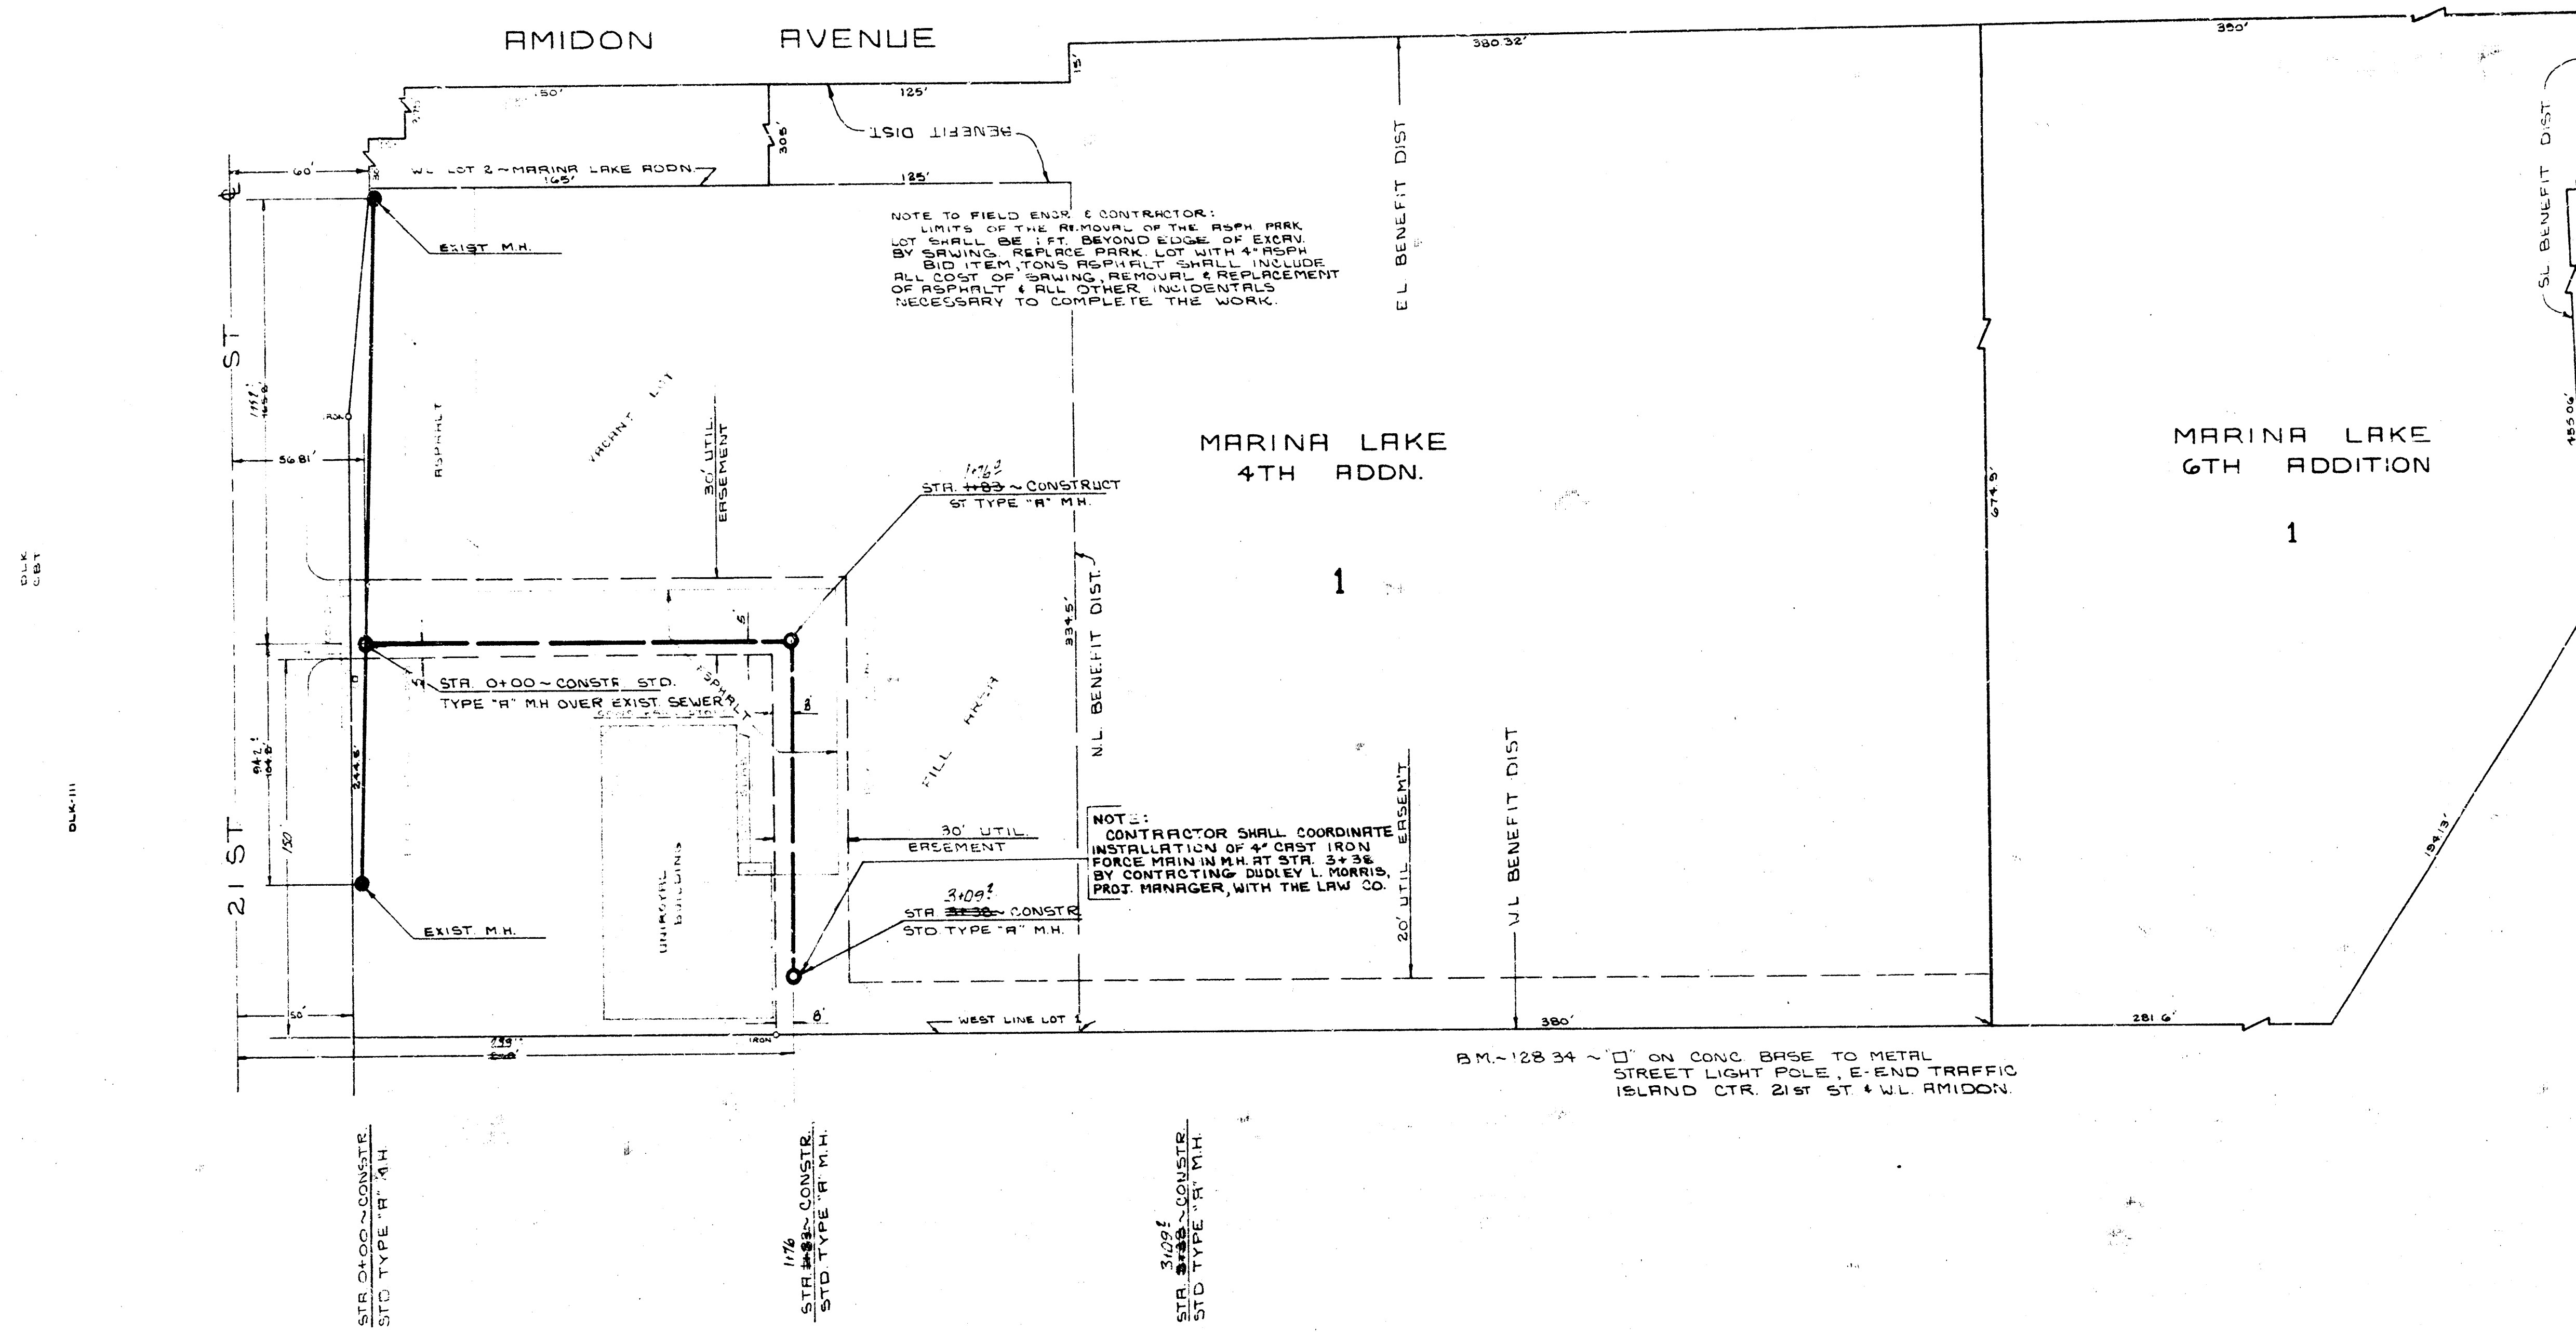

13 JUL 72 CIVIL ENGINEER

LAT 117 SS 22
CITY OF WICHITA
R.W. LINN CITY ENGINEER
DATE Aug. 1972 PROJECT NO. DBKL571029