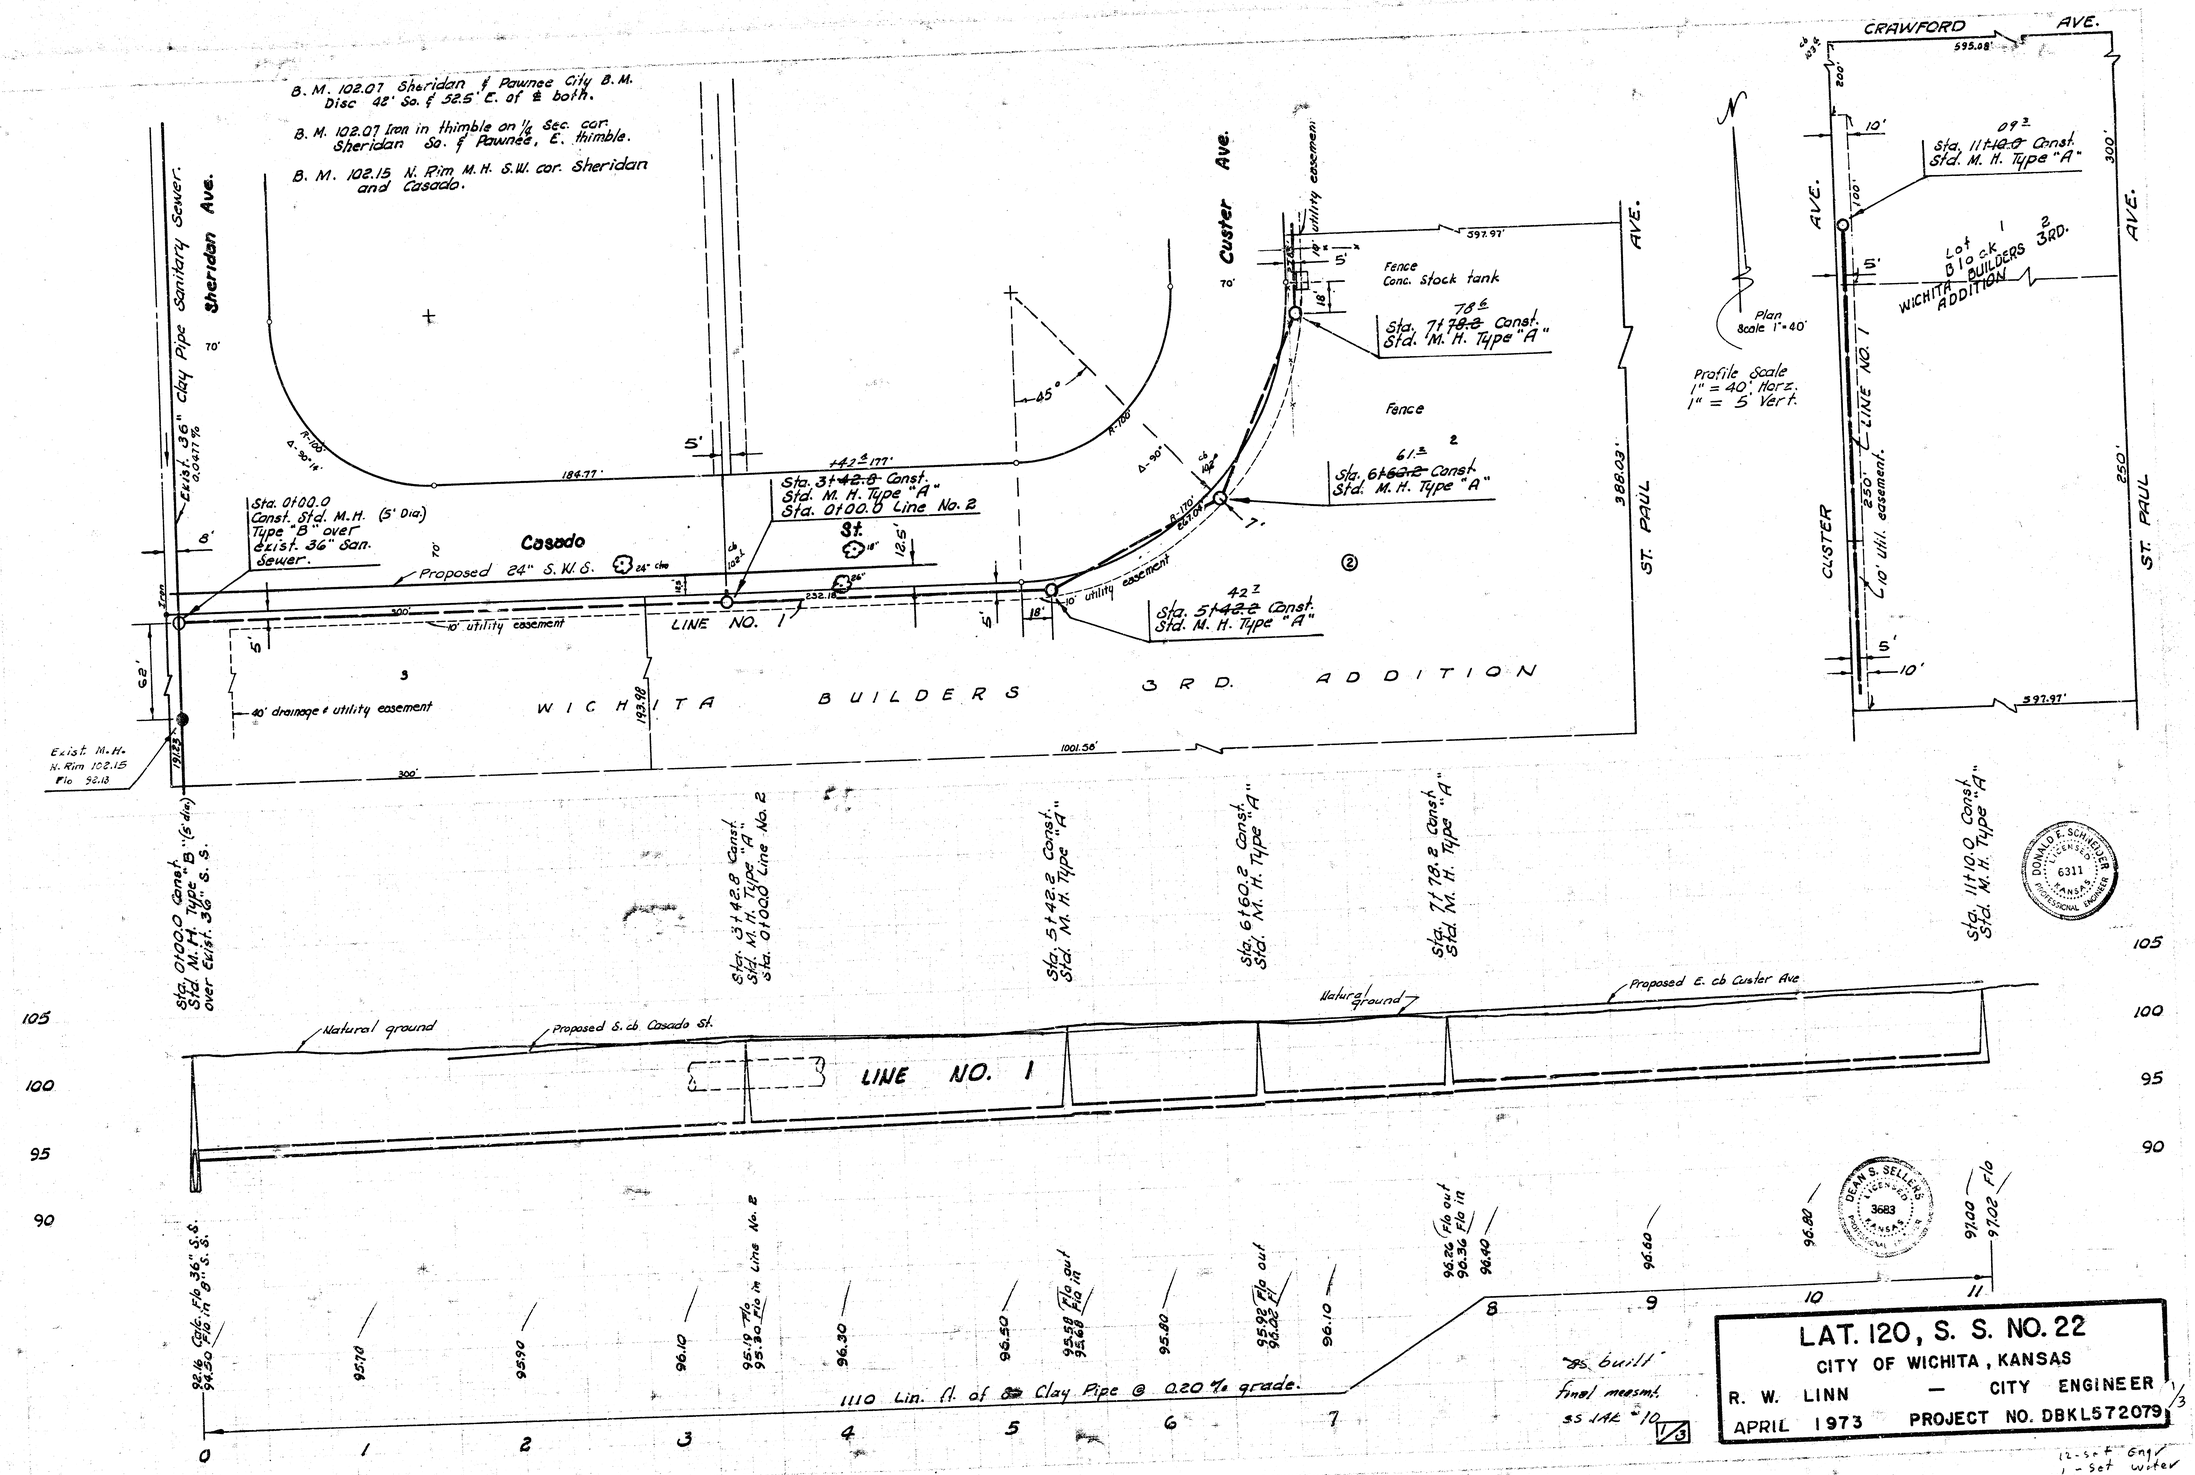

LAT. 120, S. S. NO. 22
CITY OF WICHITA, KANSAS
R. W. LINN — CITY ENGINEER
APRIL 1973 PROJECT NO. DBKL572079

1/3

12-Set Engr
1-Set Water

FILMED FROM THE BEST AVAILABLE COPY....